



Consultant: Please advise.

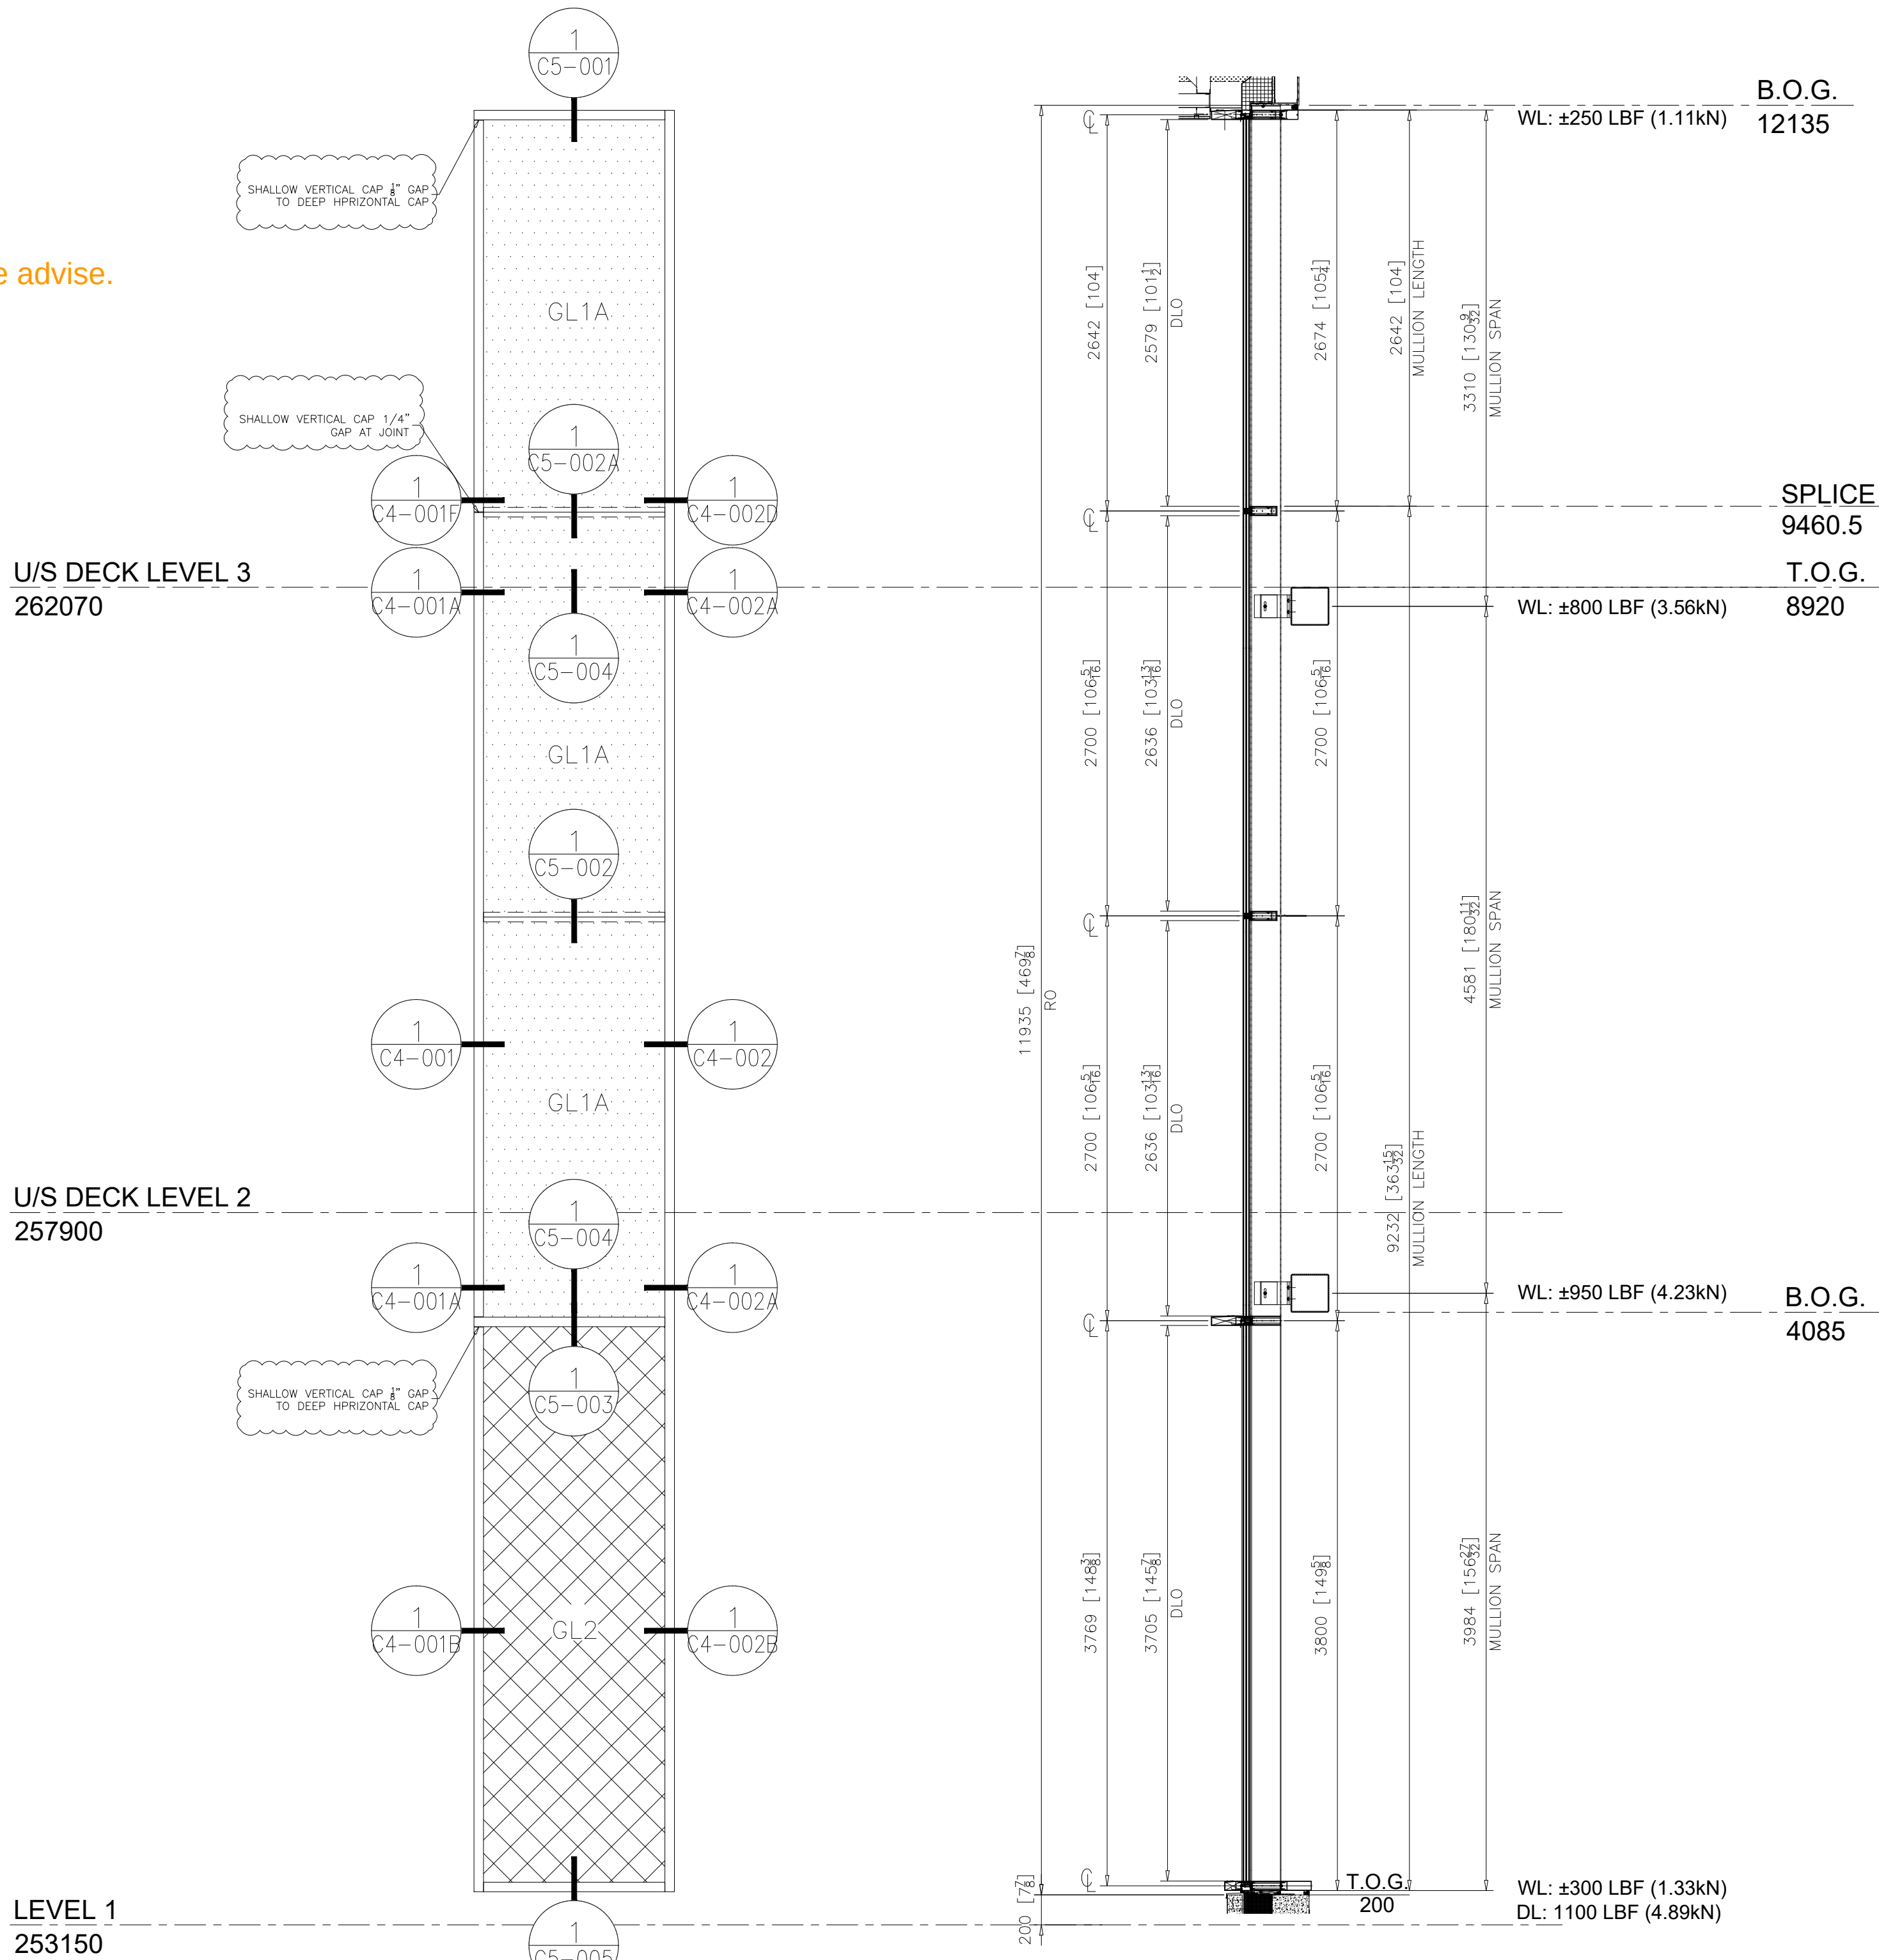

1 EG01A
PARTIAL ELEVATION
ARCH. REF.: 20/A052
QUANTITY:1

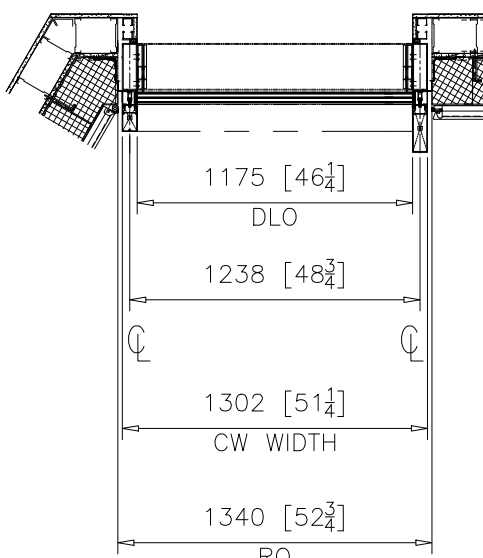


3 EG01A
PARTIAL PLAN
ARCH. REF.: 1/A108

2 EG01A
PARTIAL SECTION
ARCH. REF.: 1/A454

REVISIONS			
No.	Description:	Date:	By:
1	Revised per arch. markups received Feb 11/26	03/03/26	SLR


Project Name:	DOCKSTEADER PRPS
Project Location:	BRAMPTON, ONTARIO
Architect Name:	DIAMOND SCHMITT ARCHITECTS
Customer Name:	BOTHWELL ACCURATE GLAZING

KEY PLAN:

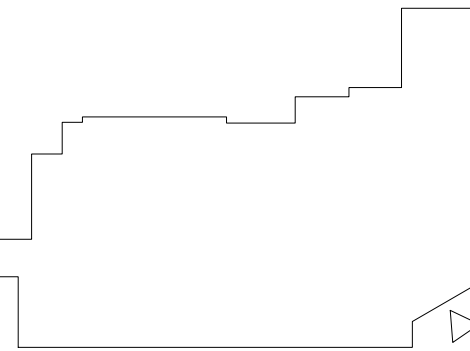


275 Britannia Road East • Mississauga
Ontario • Canada • L4Z2E7
905-890-6970 • oldcastlebe.com

Drawing Name:	
EG01A	
Drawn By:	Checked By:
SR	NP
Drawn Date:	Issue No.:
2026/01/12	1
Scale:	Release Date:
NTS	2026/03/03
Drawing Number:	
C3-001	

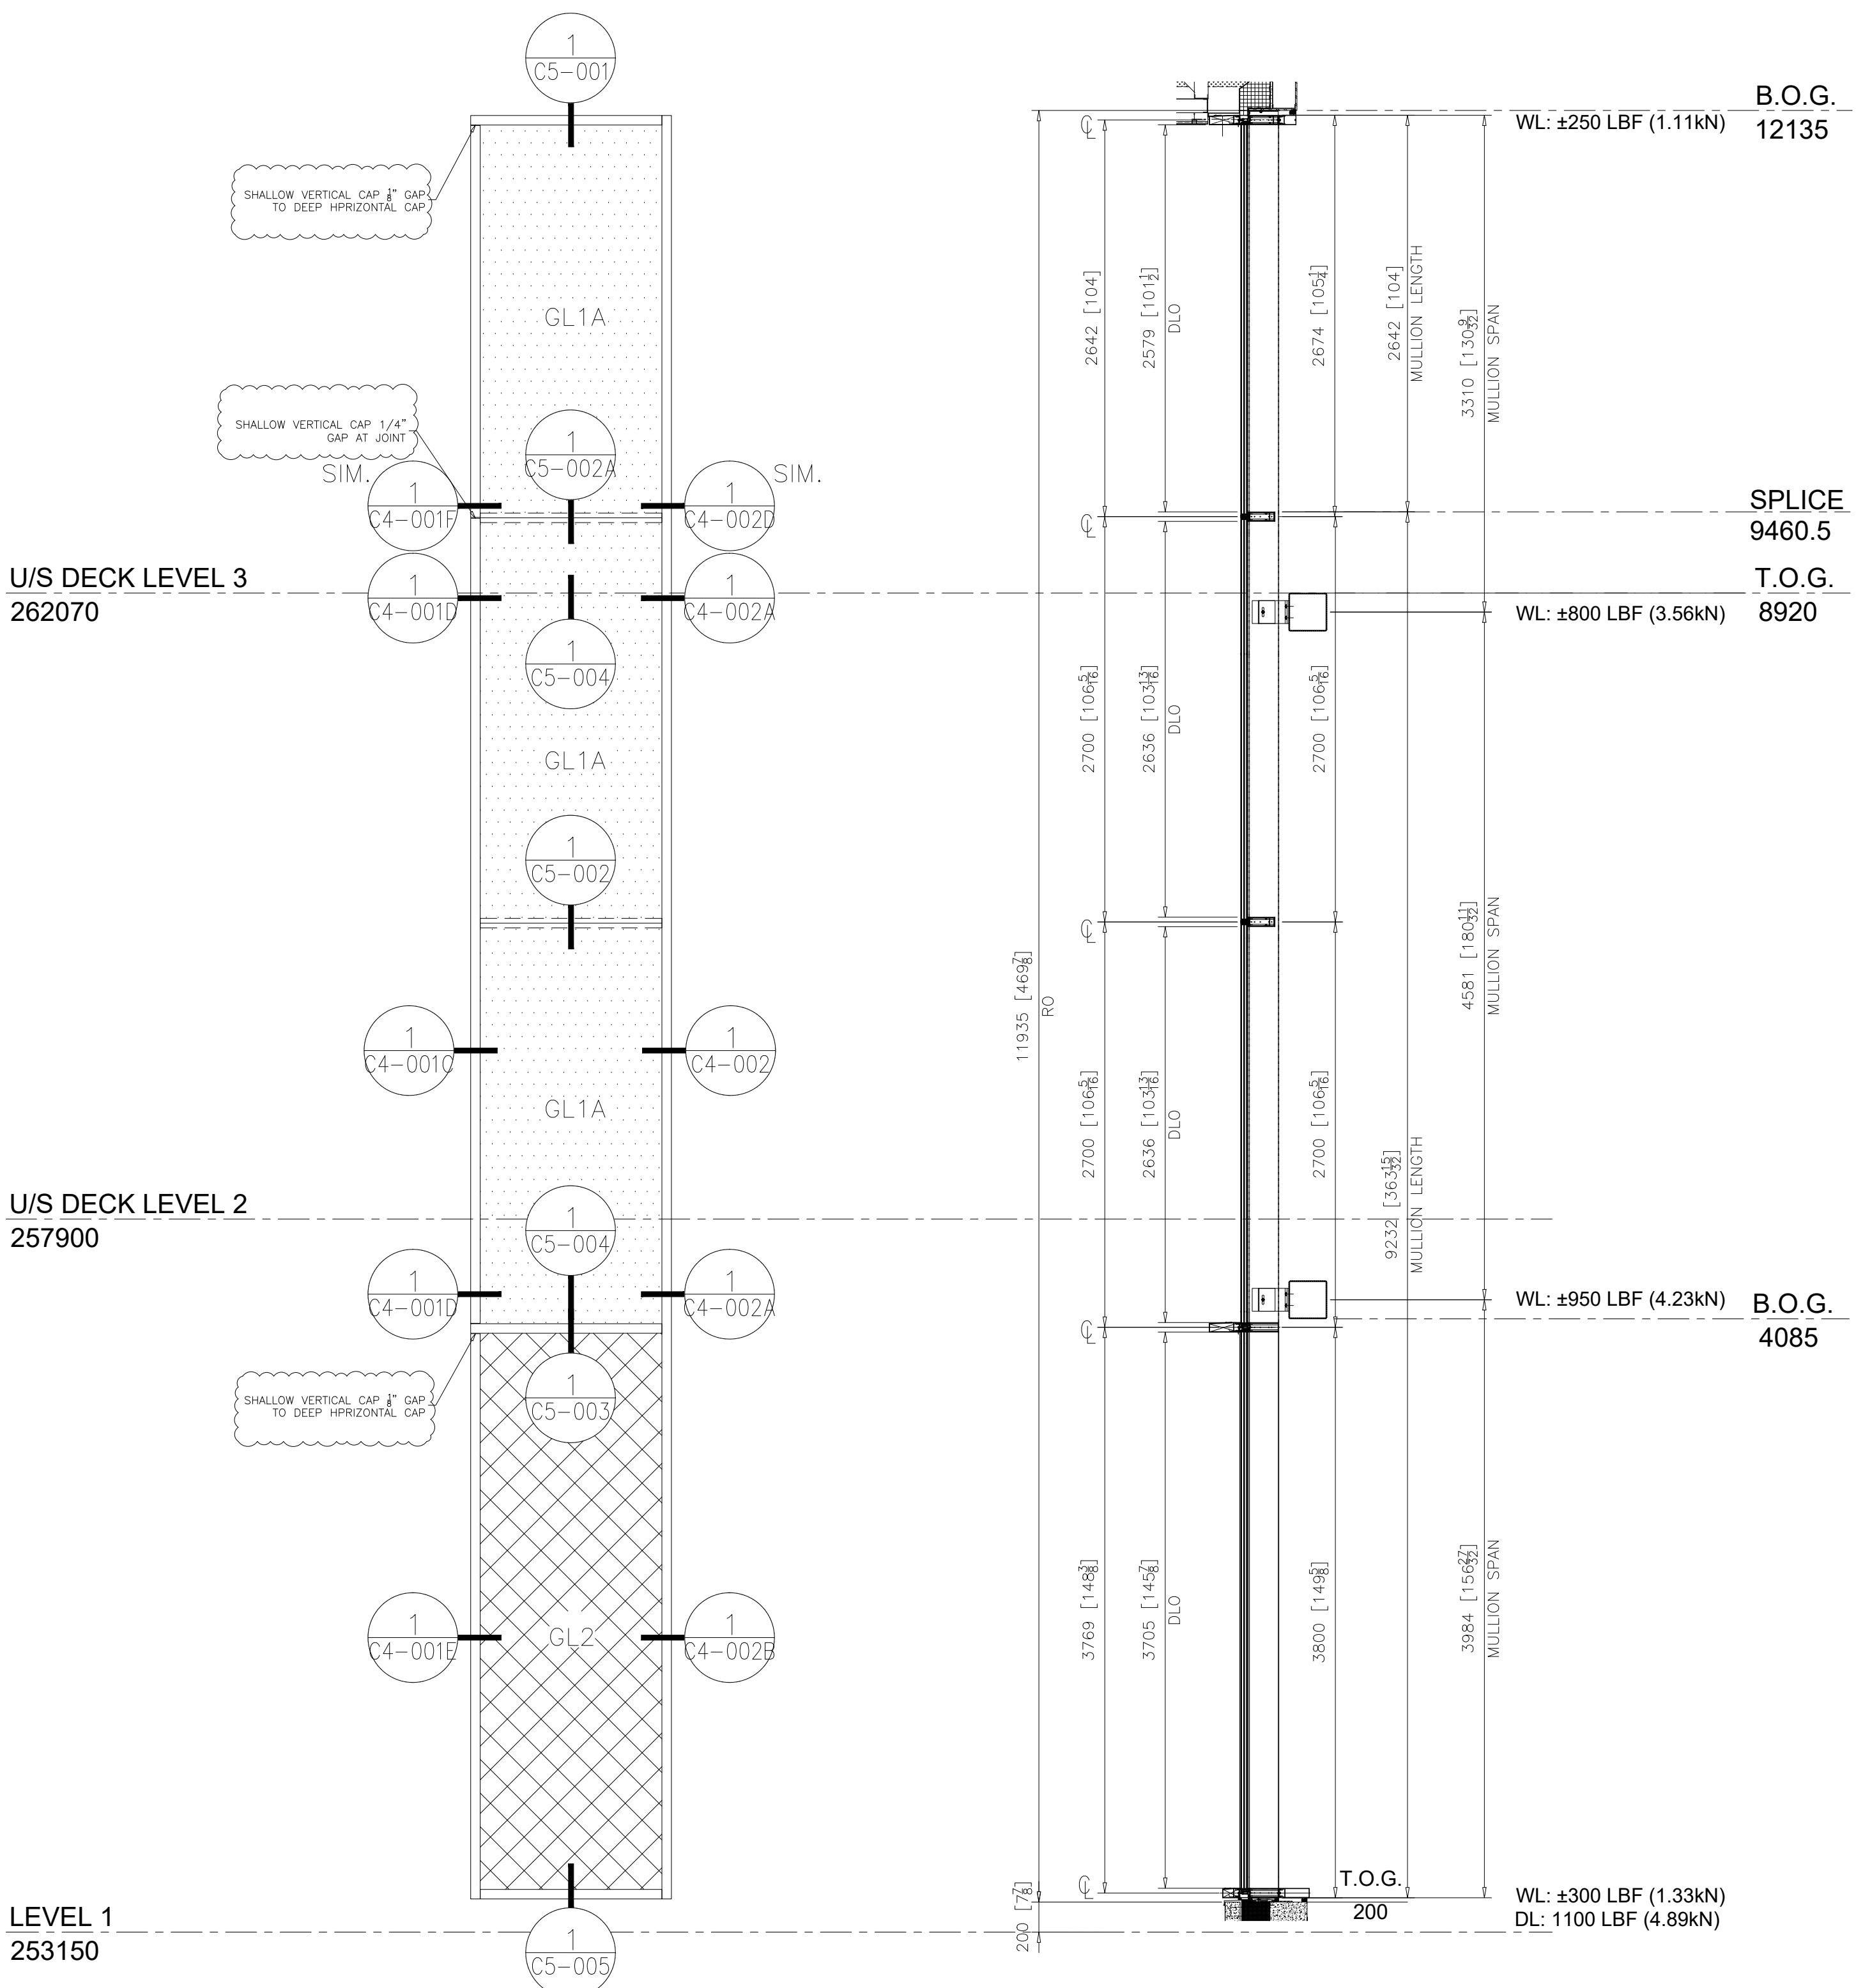

1
C3-002 **EG01B**
PARTIAL ELEVATION
ARCH. REF.: 20/A052
QUANTITY:5


2
C3-002 **EG01B**
PARTIAL SECTION
ARCH. REF.: 1/A454

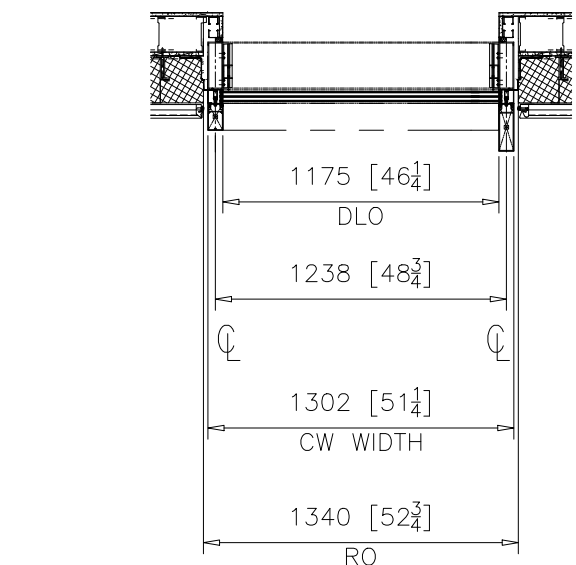

3
C3-002 **EG01B**
PARTIAL PLAN
ARCH. REF.: 1/A108

REVISIONS			
No.	Description:	Date:	By:
1	Revised per arch. markups received Feb 11/26	03/03/26	SLR


Project Name: DOCKSTEADER PRPS	Project Location: BRAMPTON, ONTARIO	Architect Name: DIAMOND SCHMITT ARCHITECTS	Customer Name: BOTHWELL ACCURATE GLAZING
-----------------------------------	--	---	---

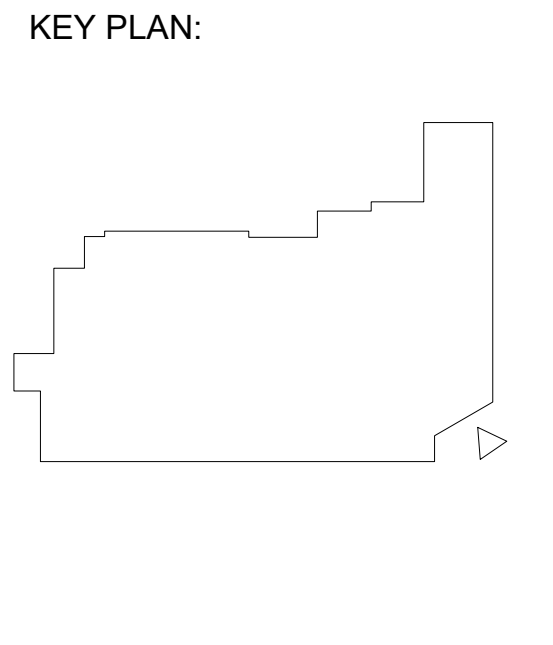




275 Britannia Road East • Mississauga
Ontario • Canada • L4Z2E7
905-890-6970 • oldcastlebe.com

Drawing Name: EG01B	
Drawn By: SR	Checked By: NP
Drawn Date: 2026/01/12	Issue No.: 1
Scale: NTS	Release Date: 2026/03/03
Drawing Number: C3-002	

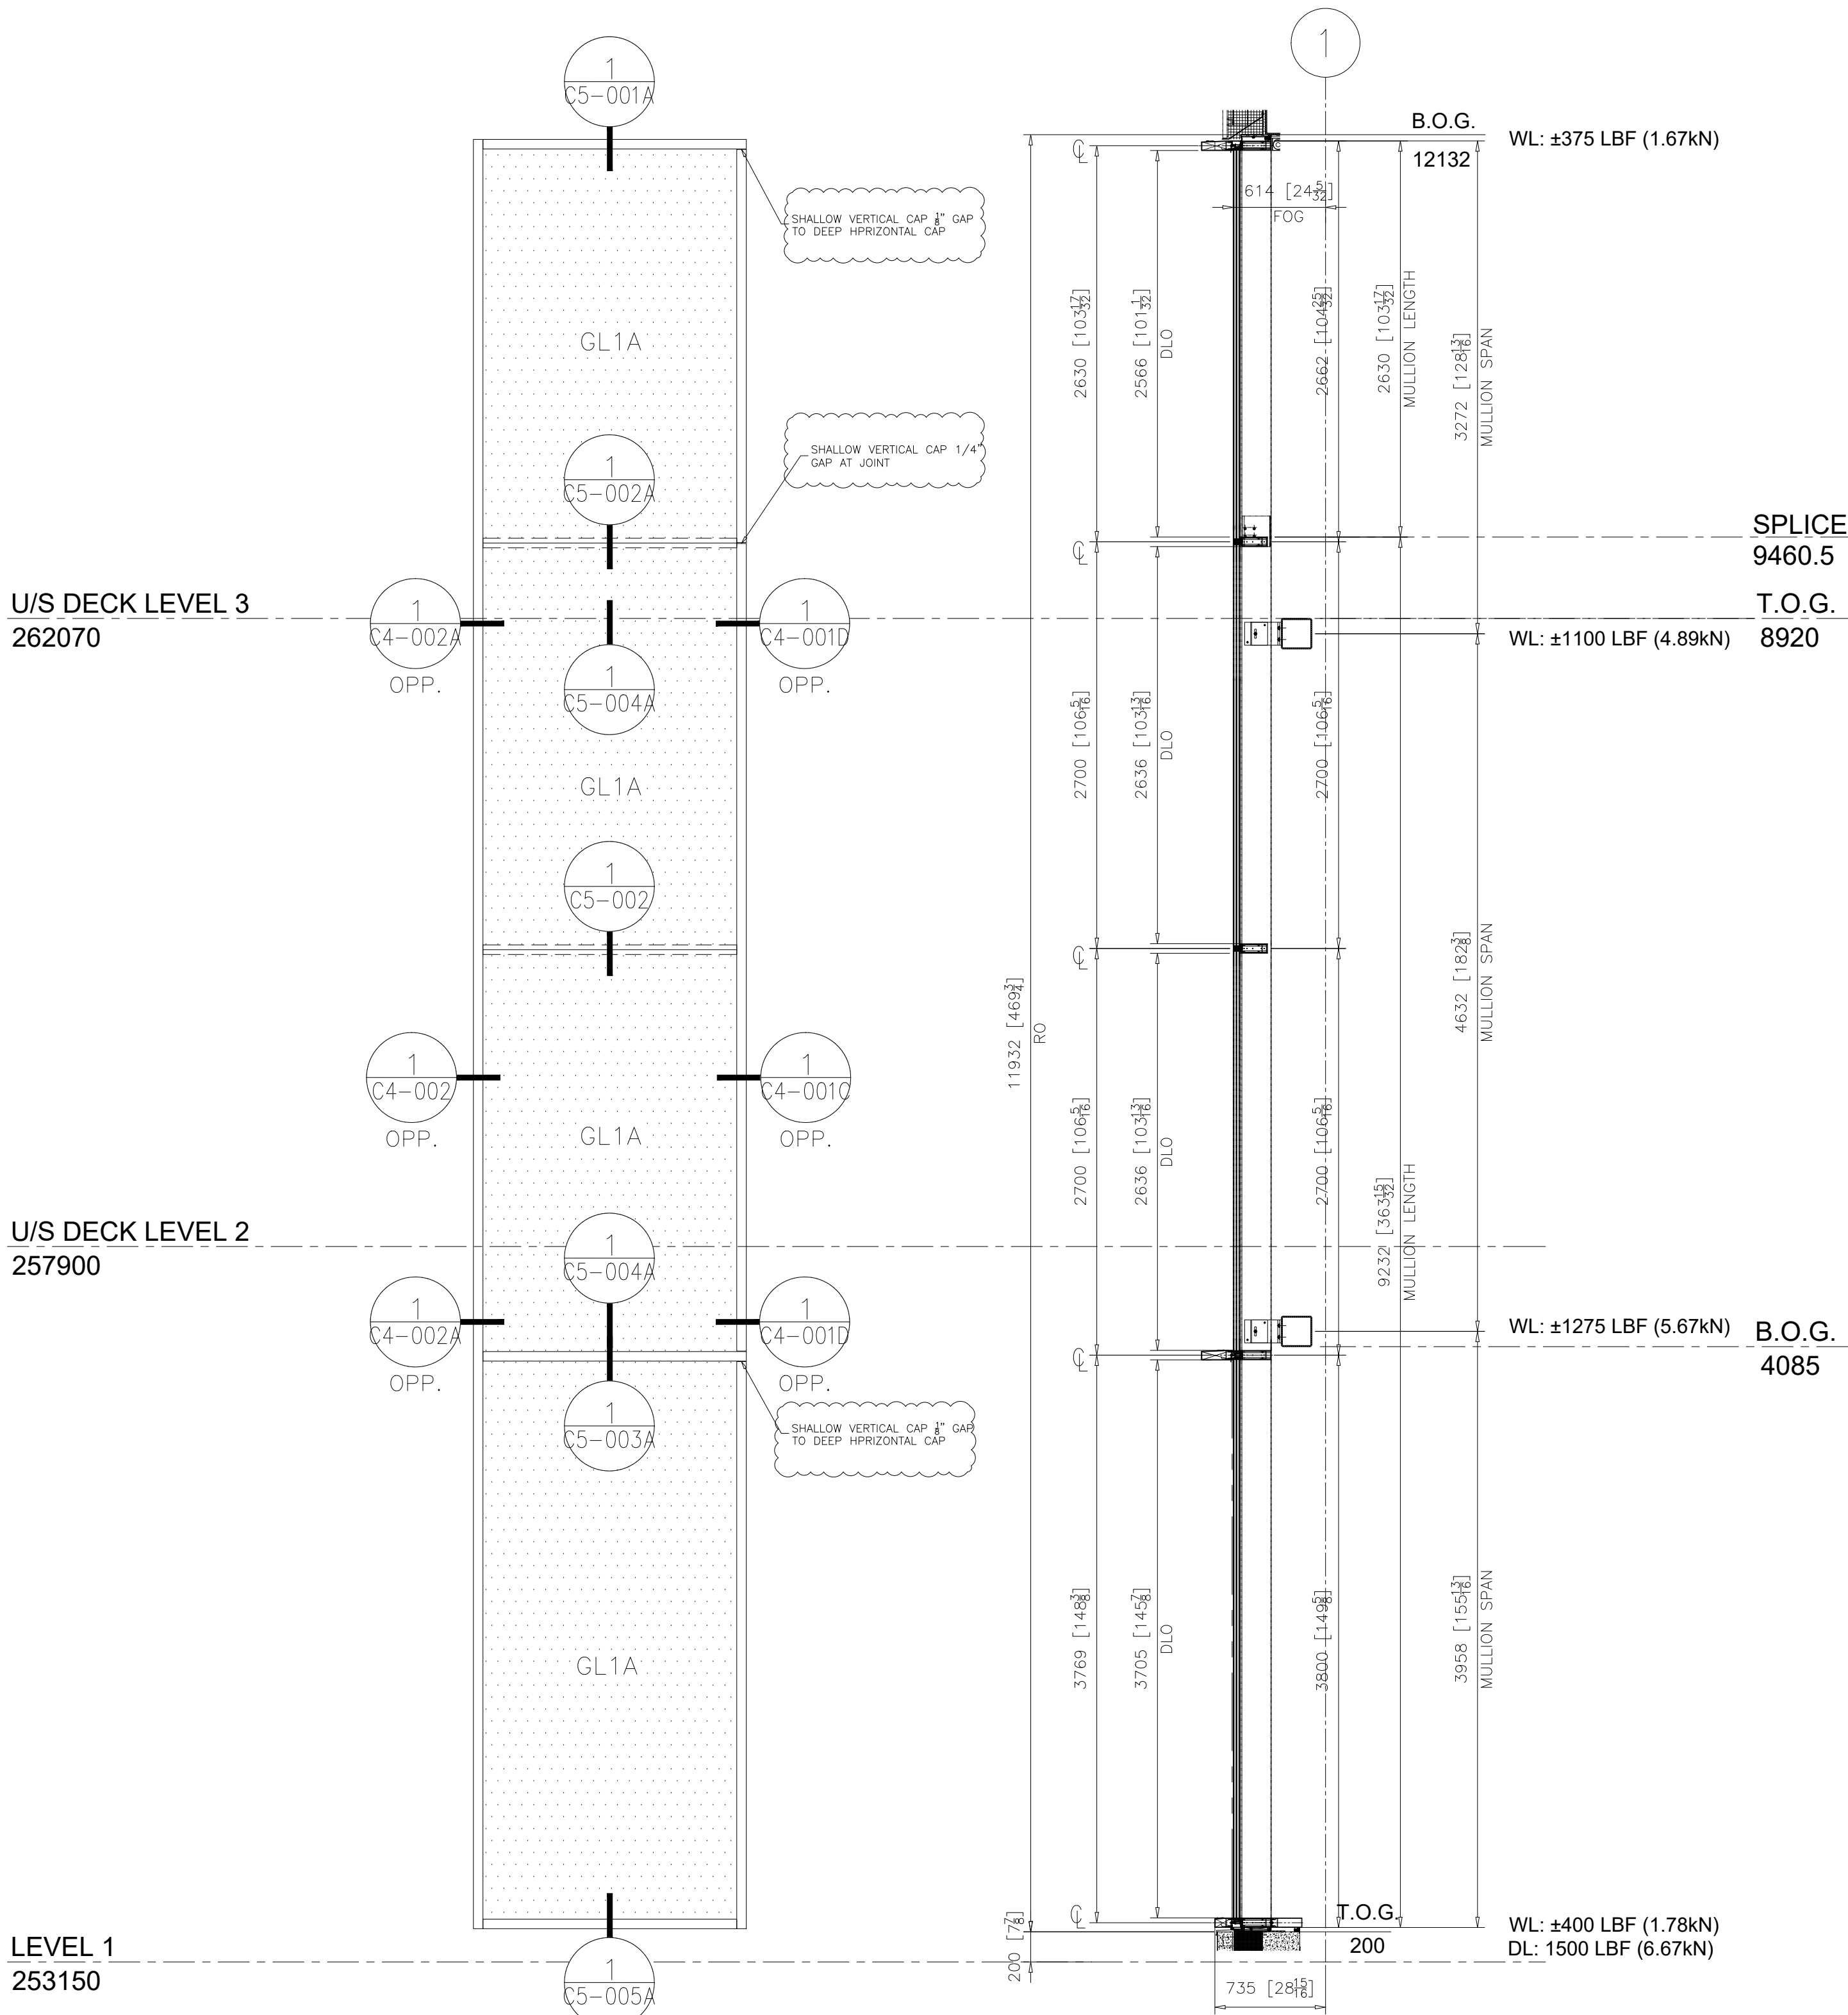

1 EG02BA
C3-003BA PARTIAL ELEVATION
ARCH. REF.: 19/A052

QUANTITY:2

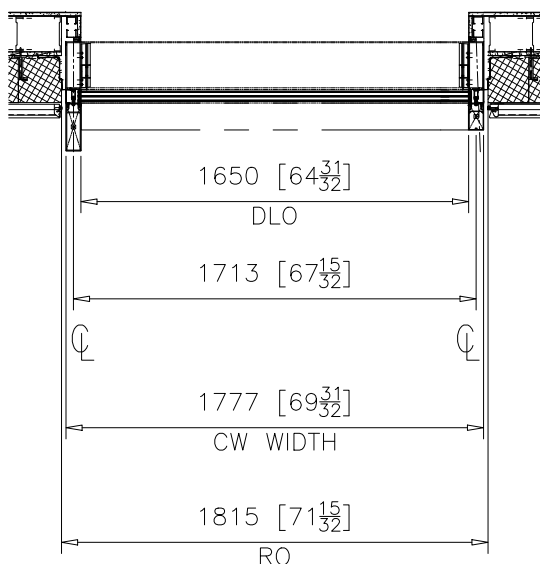


3 EG02BA
C3-003BA PARTIAL PLAN
ARCH. REF.: 1/A108

2 EG02BA
C3-003BA PARTIAL SECTION
ARCH. REF.: 1/A456

REVISIONS			
No.	Description:	Date:	By:
1	Revised per arch. markups received Feb 11/26	03/03/26	SLR


Project Name:	DOCKSTEADER PRPS
Project Location:	BRAMPTON, ONTARIO
Architect Name:	DIAMOND SCHMITT ARCHITECTS
Customer Name:	BOTHWELL ACCURATE GLAZING

KEY PLAN:

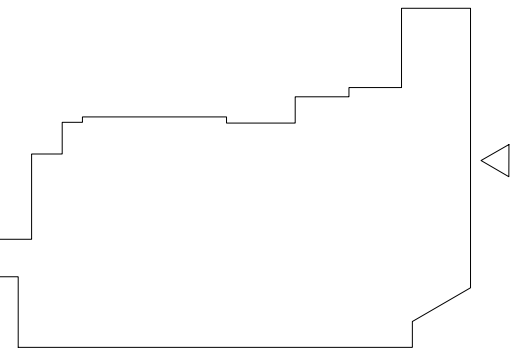


275 Britannia Road East • Mississauga
Ontario • Canada • L4Z2E7
905-890-6970 • oldcastlebe.com

Drawing Name:	
EG02B	
Drawn By:	Checked By:
SR	NP
Drawn Date:	Issue No.:
2026/01/12	1
Scale:	Release Date:
NTS	2026/03/03
Drawing Number:	C3-003BA

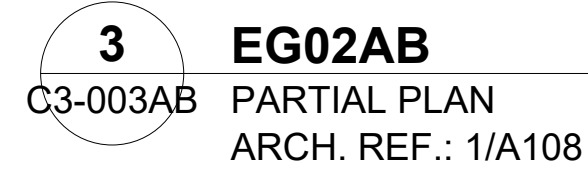

Drawing Name: EG02A	
Drawn By: SR	Checked By: NP
Drawn Date: 2026/01/12	Issue No.: 1
Scale: NTS	Release Date: 2026/03/01
Drawing Number: 000 000 000	


Tr: C3-003AB

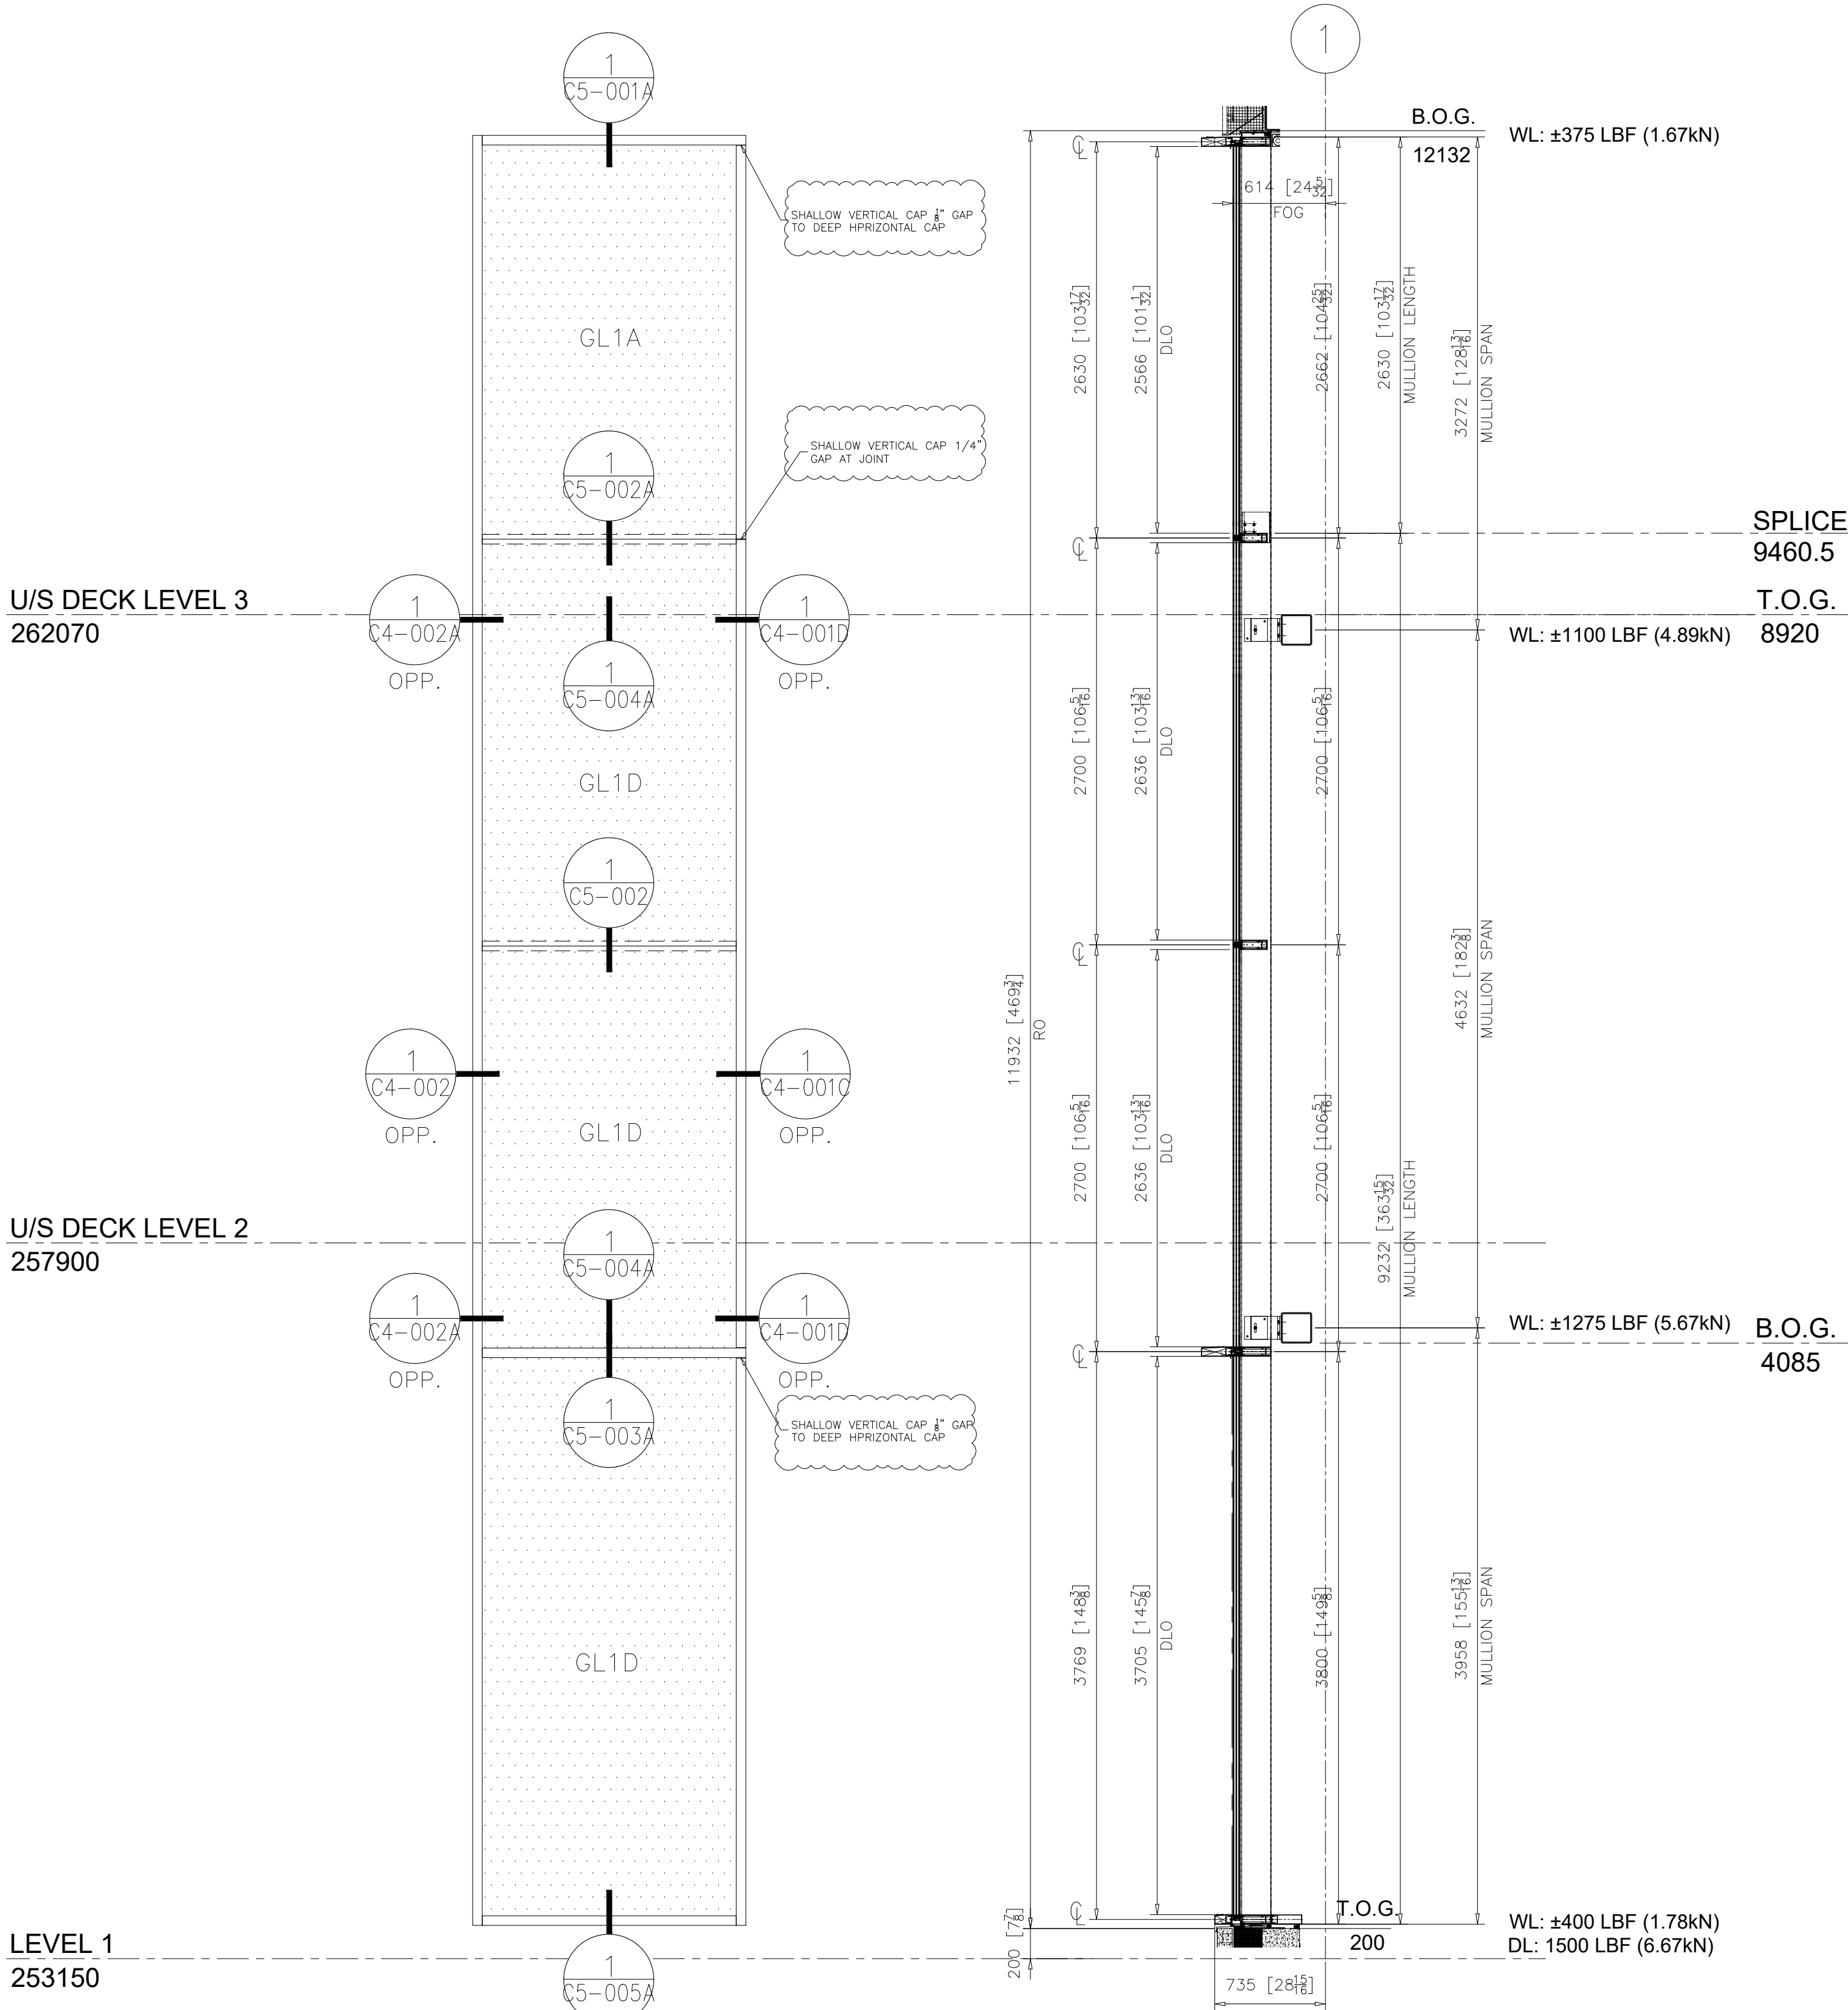

1 EG02BB
C3-003BB PARTIAL ELEVATION
ARCH. REF.: 19/A052

QUANTITY:1

2 EG02BB
C3-003BB PARTIAL SECTION
ARCH. REF.: 1/A456

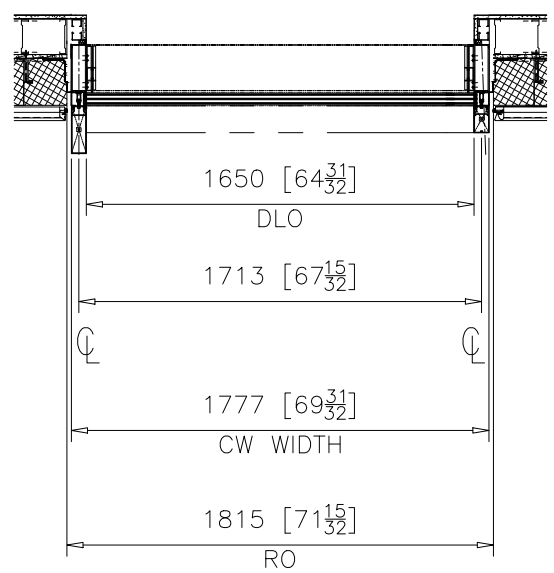


3 EG02BB
C3-003BB PARTIAL PLAN
ARCH. REF.: 1/A108

REVISIONS			
No.	Description:	Date:	By:
1	Revised per arch. markups received Feb 11/26	03/03/26	SLR

Project Name:	DOCKSTEADER PRPS
Project Location:	BRAMPTON, ONTARIO
Architect Name:	DIAMOND SCHMITT ARCHITECTS
Customer Name:	BOTHWELL ACCURATE GLAZING

KEY PLAN:

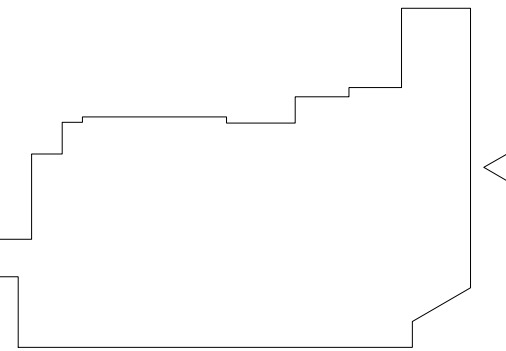

275 Britannia Road East • Mississauga
Ontario • Canada • L4Z2E7
905-890-6970 • oldcastlebe.com

Drawing Name:	
EG02B	
Drawn By:	Checked By:
SR	NP
Drawn Date:	Issue No.:
2026/01/12	1
Scale:	Release Date:
NTS	2026/03/03
Drawing Number:	

C3-003BB

[illegible]

1
C3-004

3
C3-004 **EG03**
PARTIAL PLAN
ARCH. REF.: 1/A108

[illegible]

2 **EG03**
C3-004 PARTIAL SECTION
ARCH. REF.: 1/A455

[illegible]


Project Name:	DOCKSTEADER PRPS
Project Location:	BRAMPTON, ONTARIO
Architect Name:	DIAMOND SCHMITT ARCH
Customer Name:	BOTHWELL ACCURATE

KEY PLAN:



275 Britannia Road East • Mississauga
Ontario • Canada • L4Z2E7
905-890-6970 • oldcastlebe.com


Drawing Name:	
EG03	
Drawn By: SR	Checked By: NP
Drawn Date: 2026/01/12	Issue No.: 1
Scale: NTS	Release Date: 2026/03/01
Drawing Number:	
C3-004	

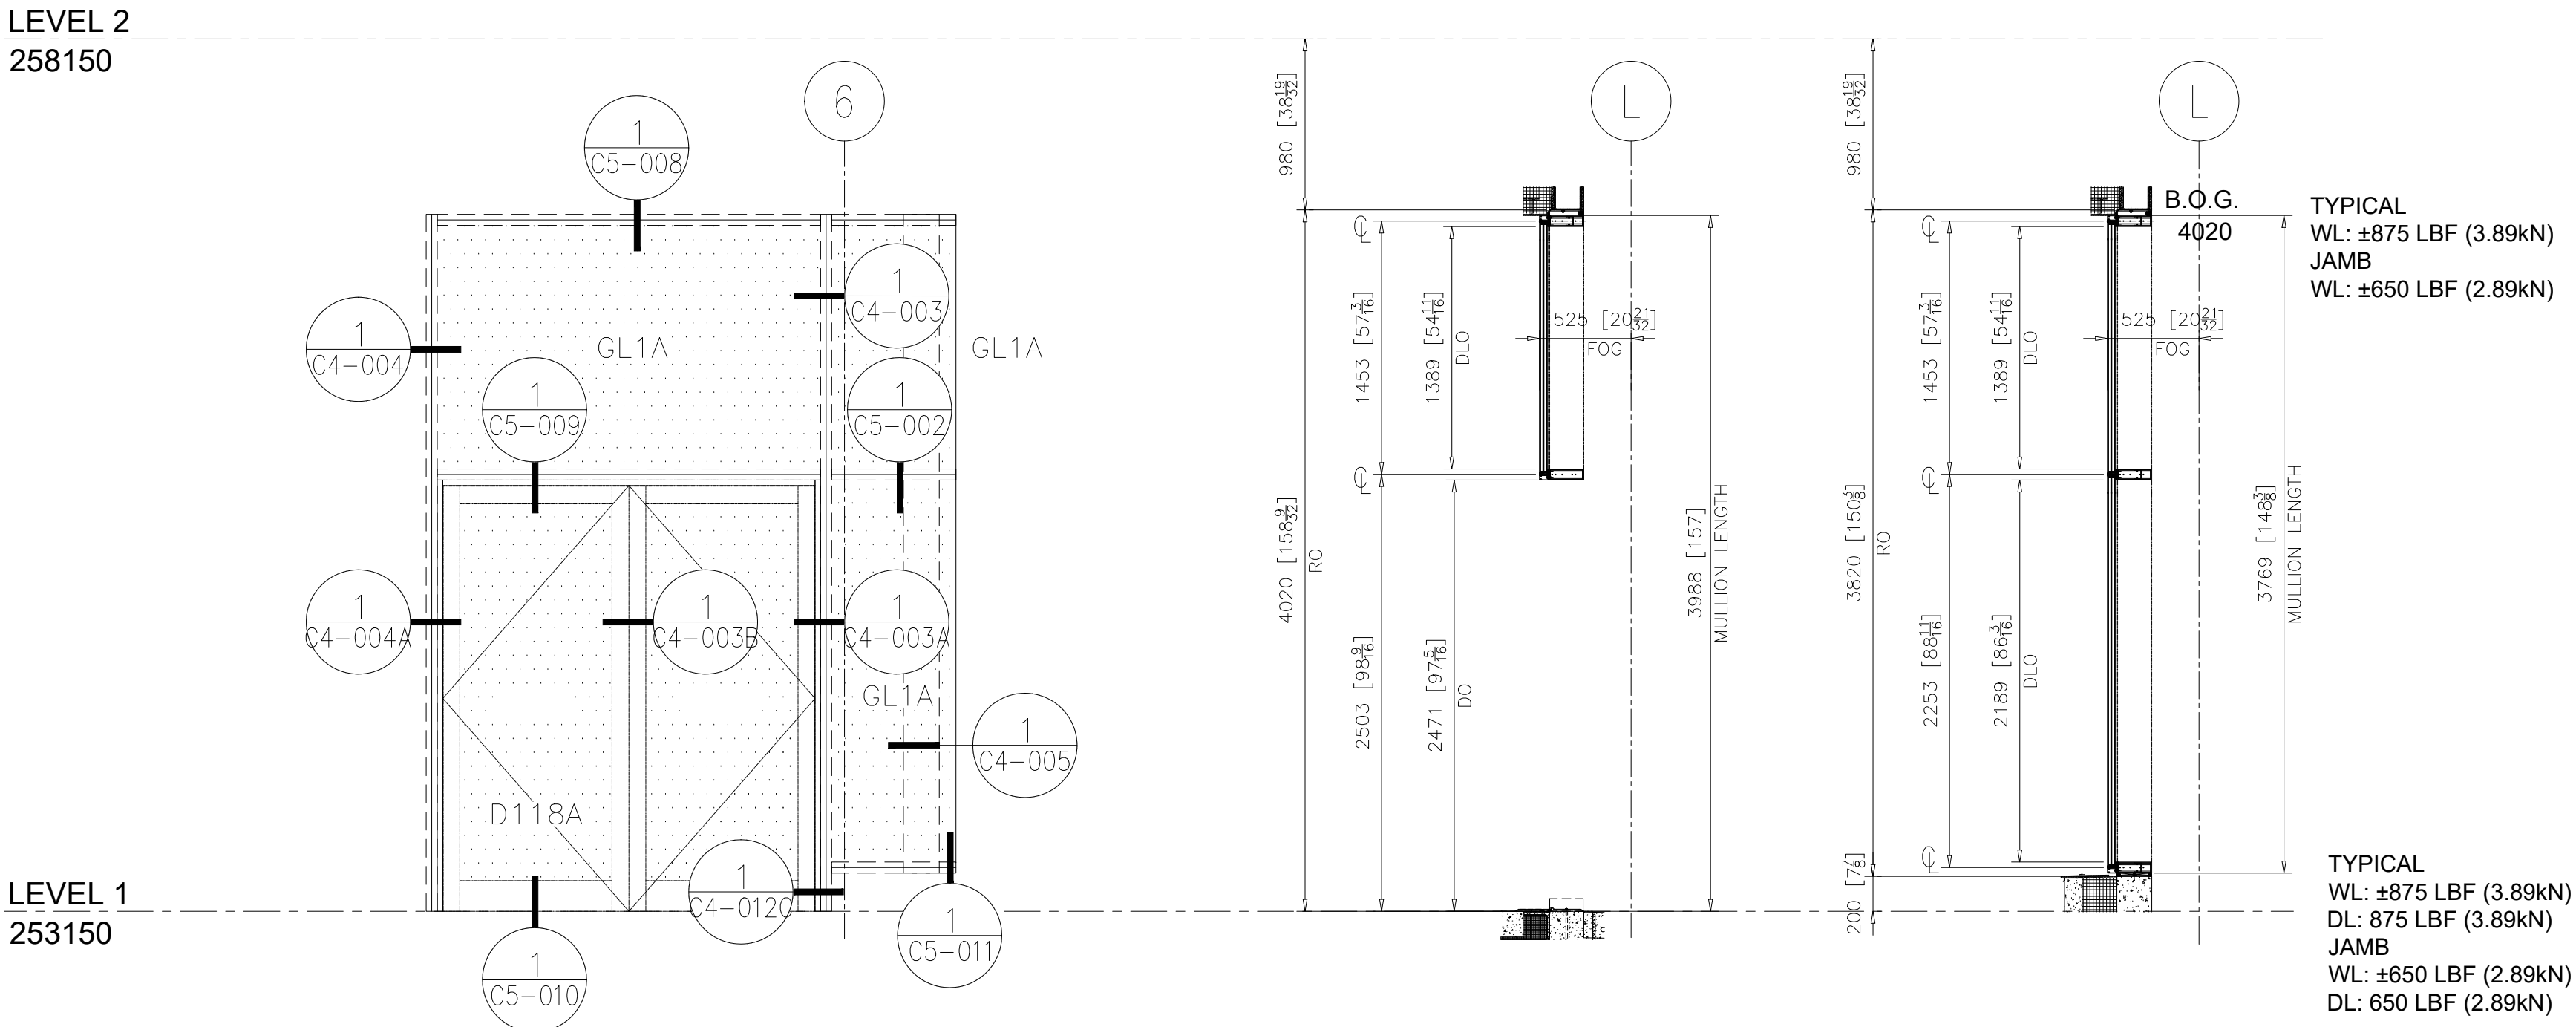


1 EG04
C3-005 PARTIAL ELEVATION
ARCH. REF.: 9/A052
QUANTITY:1

2 EG04
C3-005 PARTIAL SECTION
ARCH. REF.: 4/A458

3 EG04
C3-005 PARTIAL SECTION
ARCH. REF.: 2/A459

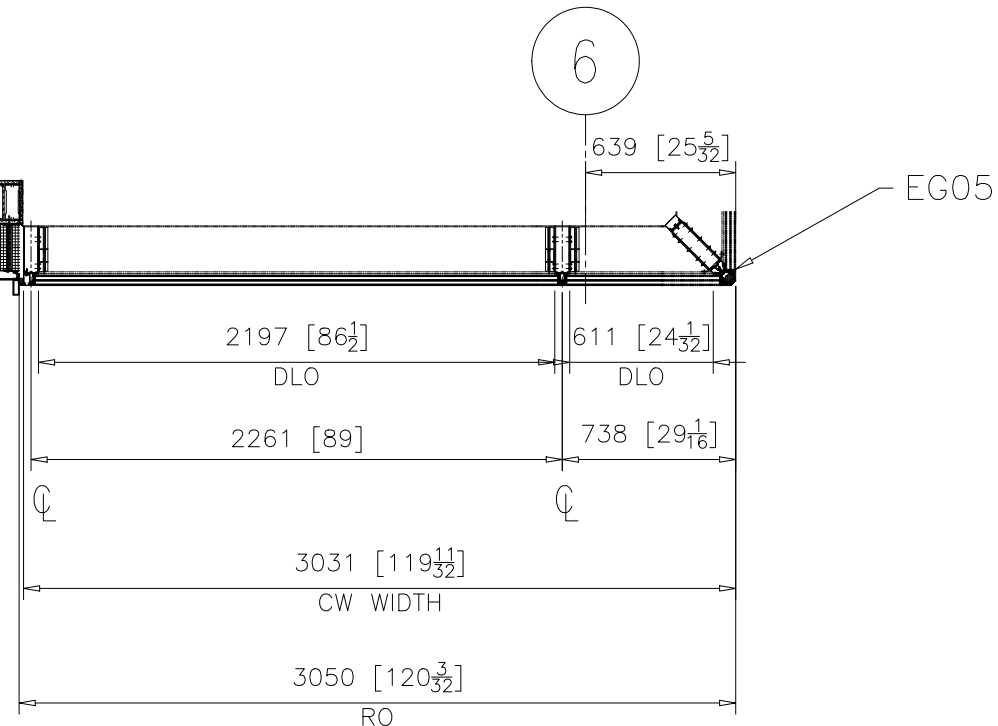

4 EG04
C3-005 PARTIAL PLAN
ARCH. REF.: 1/A108

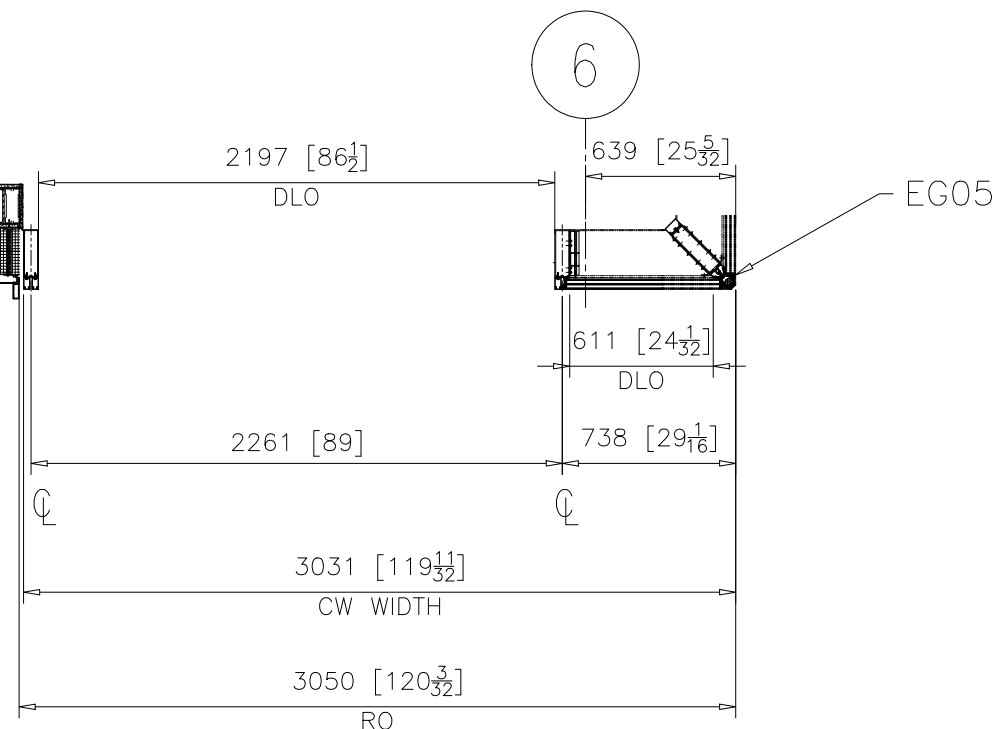


5 EG04
C3-005 PARTIAL PLAN
ARCH. REF.: 1/A108

REVISIONS			
No.	Description:	Date:	By:
1	Revised per arch. markups received Feb 11/26	03/03/26	SLR

Project Name:	DOCKSTEADER PRPS
Project Location:	BRAMPTON, ONTARIO
Architect Name:	DIAMOND SCHMITT ARCHITECTS
Customer Name:	BOTHWELL ACCURATE GLAZING


KEY PLAN:

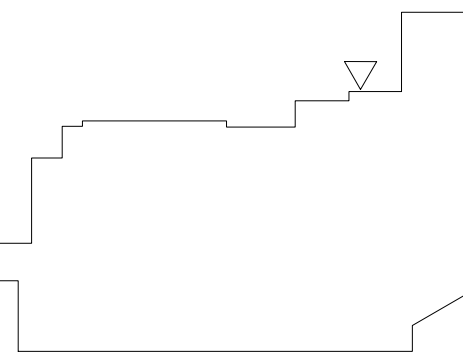




275 Britannia Road East • Mississauga
Ontario • Canada • L4Z2E7
905-890-6970 • oldcastlebe.com

Drawing Name: EG04	
Drawn By: SR	Checked By: NP
Drawn Date: 2026/01/12	Issue No.: 1
Scale: NTS	Release Date: 2026/03/03
Drawing Number: C3-005	

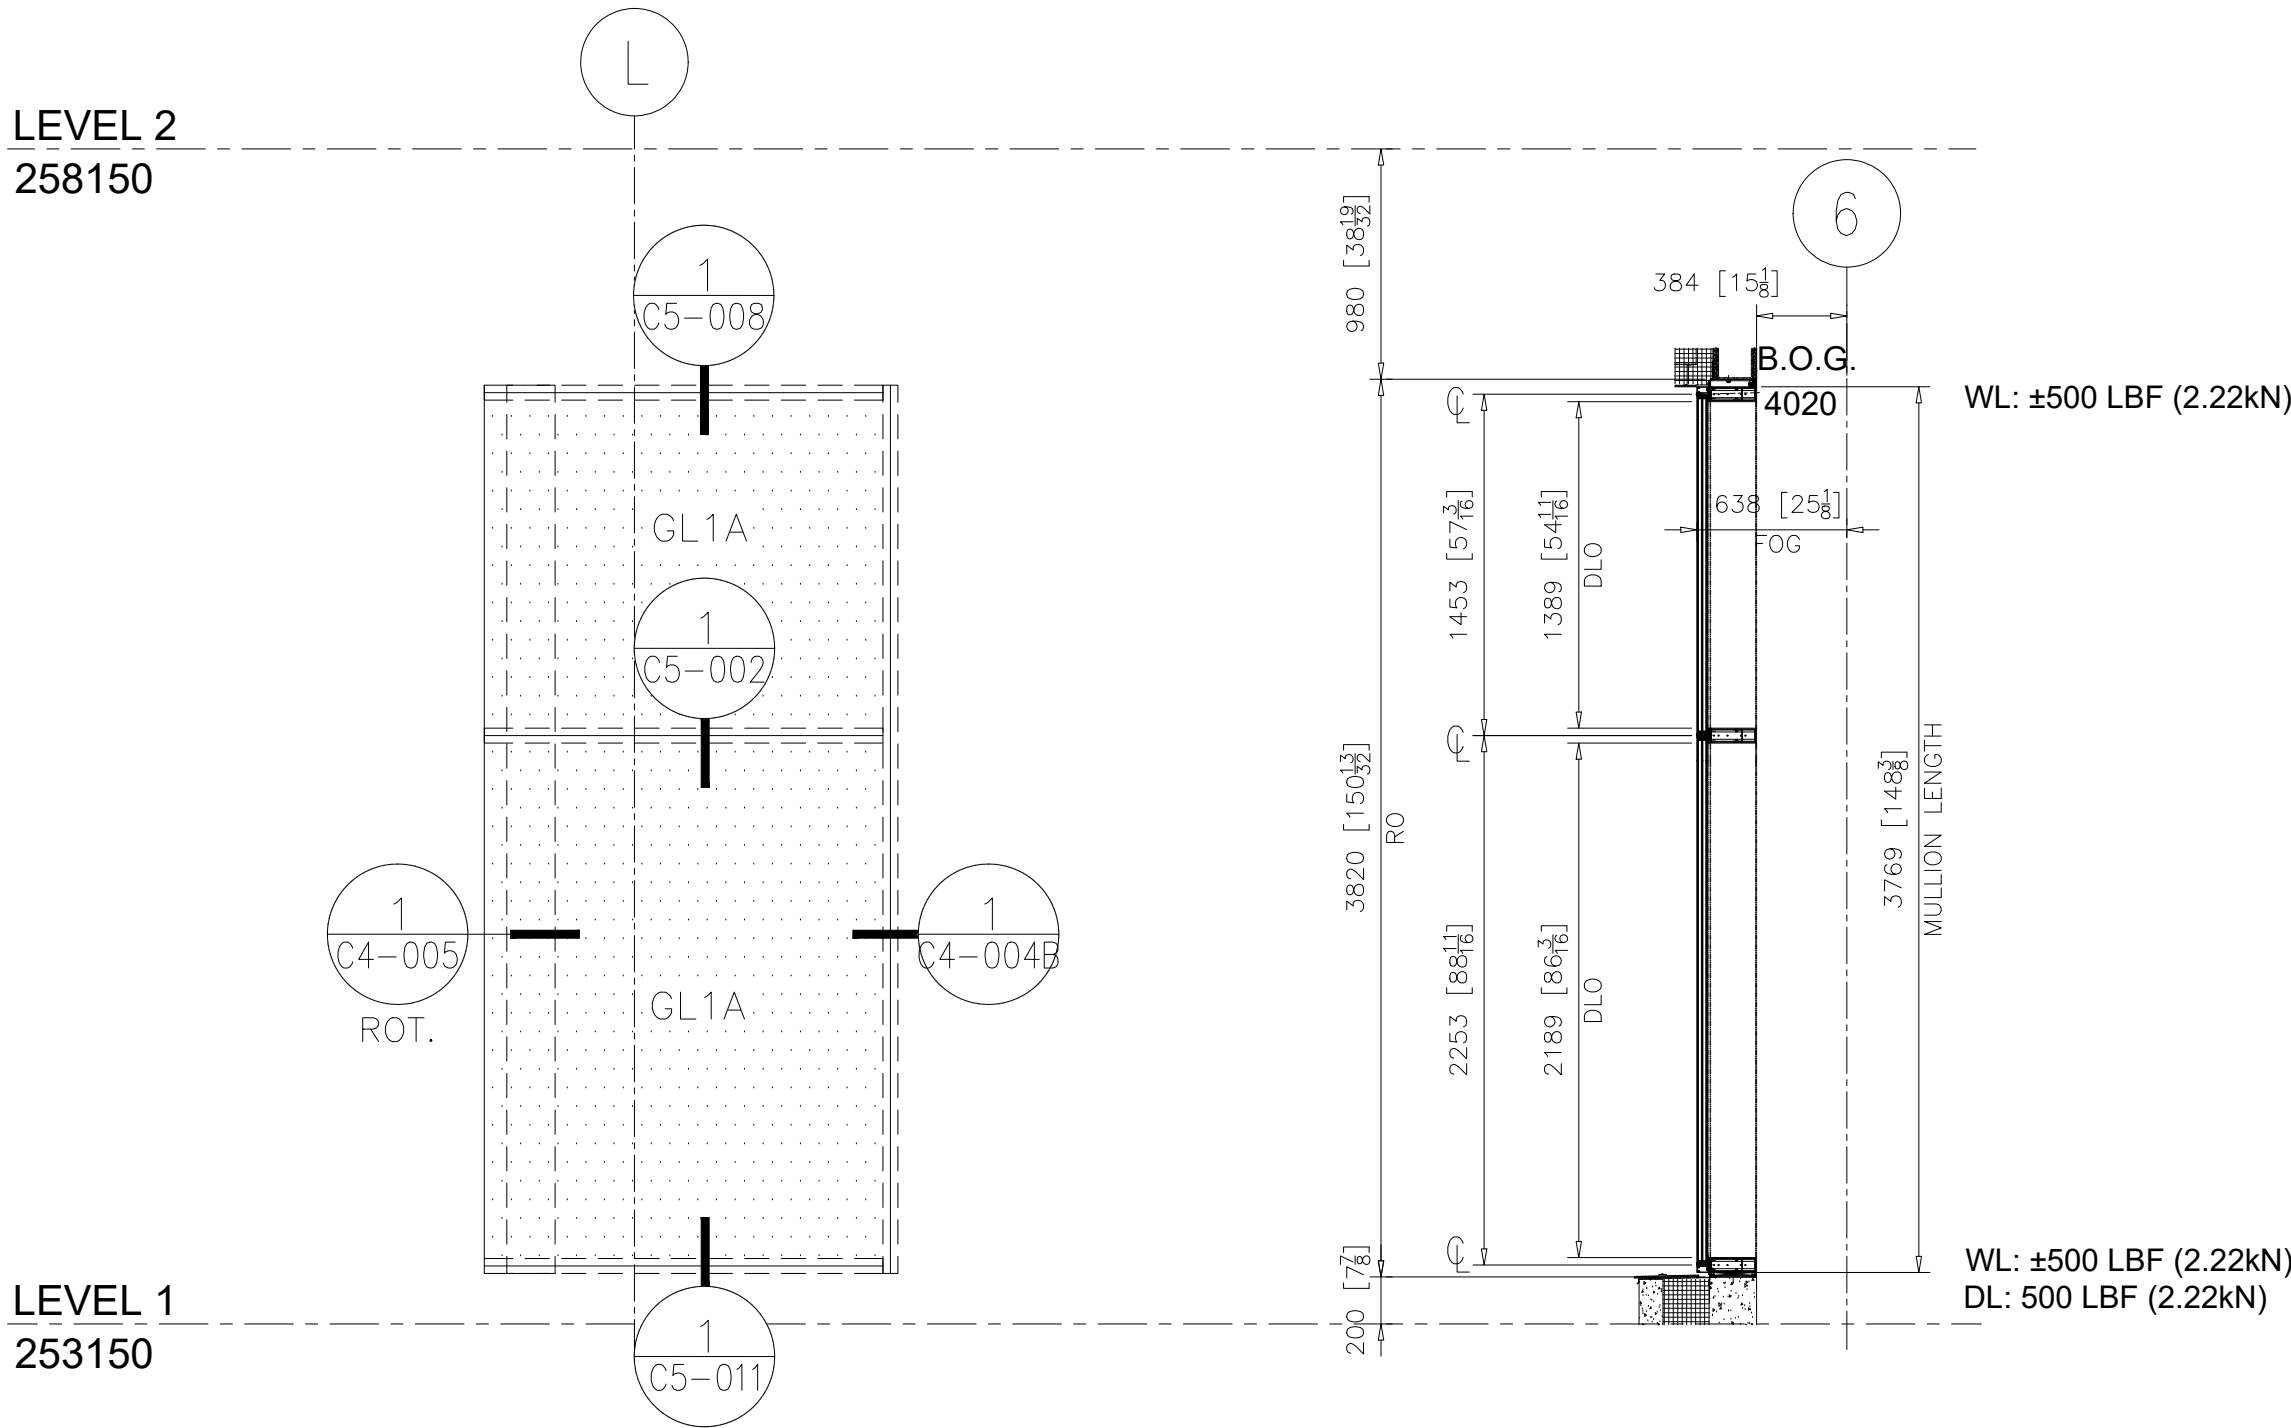

1 EG05
C3-006 PARTIAL ELEVATION
ARCH. REF.: 8/A052
QUANTITY:1

2 EG05
C3-006 PARTIAL SECTION
ARCH. REF.: 2/A459

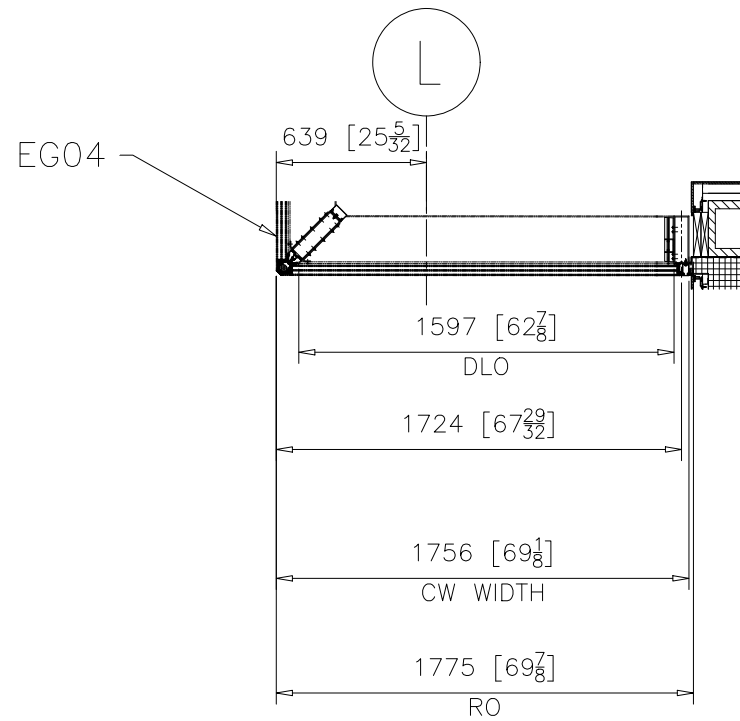


3 EG05
C3-006 PARTIAL PLAN
ARCH. REF.: 1/A108

REVISIONS			
No.	Description:	Date:	By:
1	Revised per arch. markups received Feb 11/26	03/03/26	SLR

Project Name:	DOCKSTEADER PRPS
Project Location:	BRAMPTON, ONTARIO
Architect Name:	DIAMOND SCHMITT ARCHITECTS
Customer Name:	BOTHWELL ACCURATE GLAZING


KEY PLAN:

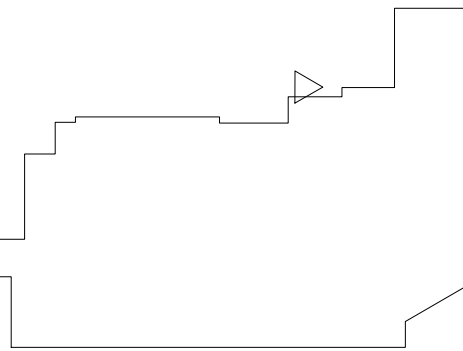

275 Britannia Road East • Mississauga
Ontario • Canada • L4Z2E7
905-890-6970 • oldcastlebe.com


Drawing Name:
EG05

Drawn By:	Checked By:
SR	NP
Drawn Date:	Issue No.:
2026/01/12	1
Scale:	Release Date:
NTS	2026/03/03
Drawing Number:	C3-006

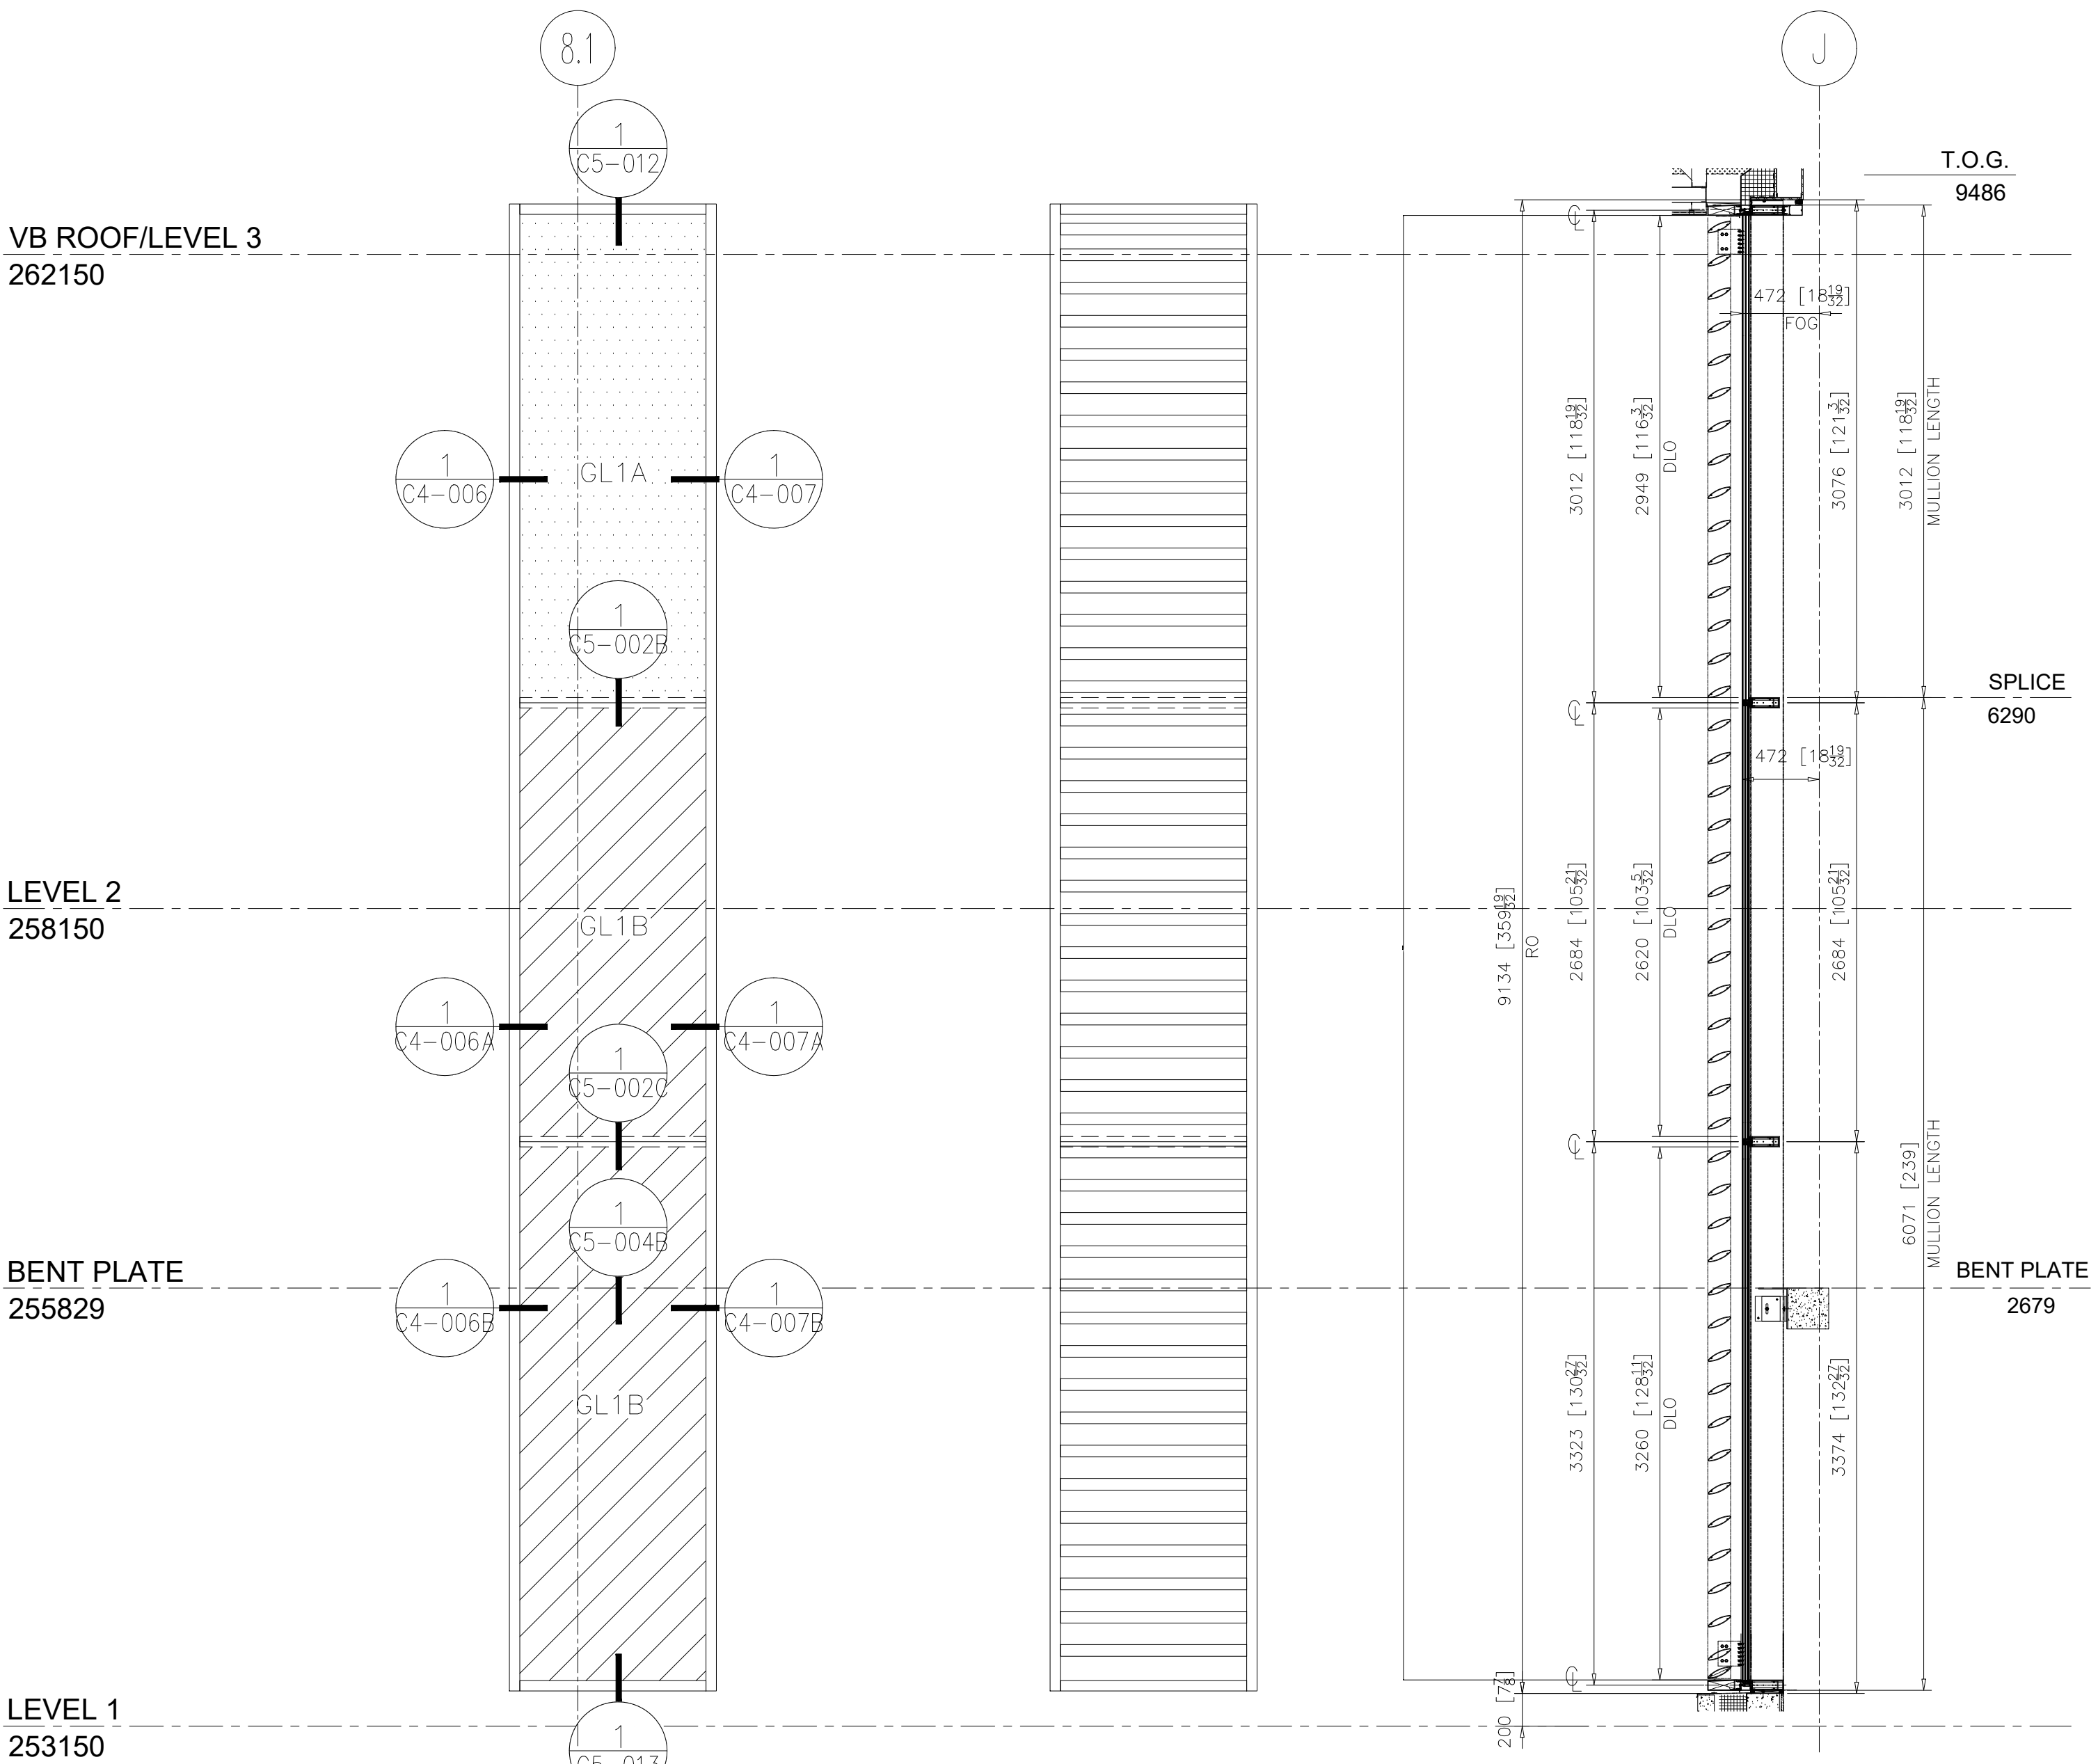

1 EG06
C3-007 PARTIAL ELEVATION
ARCH. REF.: 20/A052
QUANTITY:1

2 EG06
C3-007 PARTIAL SECTION
ARCH. REF.: 1/A454

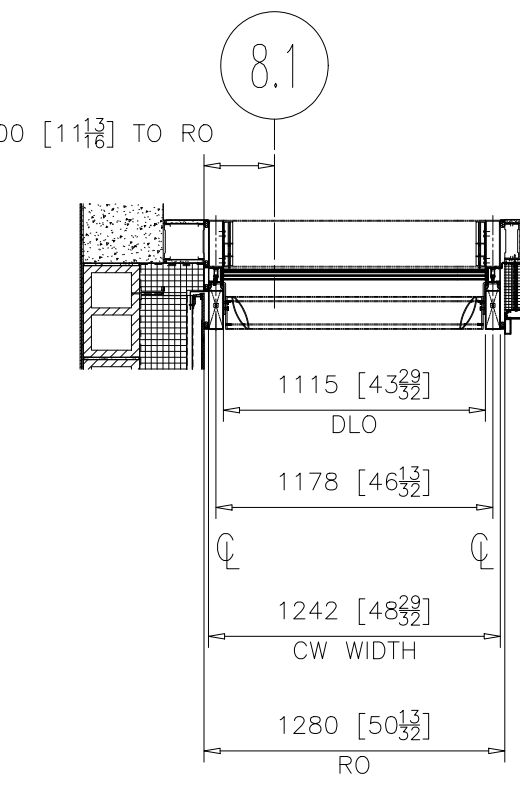

3 EG06
C3-007 PARTIAL PLAN
ARCH. REF.: 1/A105

REVISIONS

No.	Description:	Date:	By:
1	Revised per arch. markups received Feb 11/26	03/03/26	SLR

Project Name:
DOCKSTEADER PRPS

Project Location:
BRAMPTON, ONTARIO

Architect Name:
DIAMOND SCHMITT ARCHITECTS

Customer Name:
BOTHWELL ACCURATE GLAZING

KEY PLAN:

275 Britannia Road East • Mississauga
Ontario • Canada • L4Z2E7
905-890-6970 • oldcastlebe.com

Drawing Name:
EG06

Drawn By:
SR

Checked By:
NP


Drawn Date:
2026/01/12

Issue No.:
1

Scale:
NTS


Release Date:
2026/03/03

Drawing Number:
C3-007

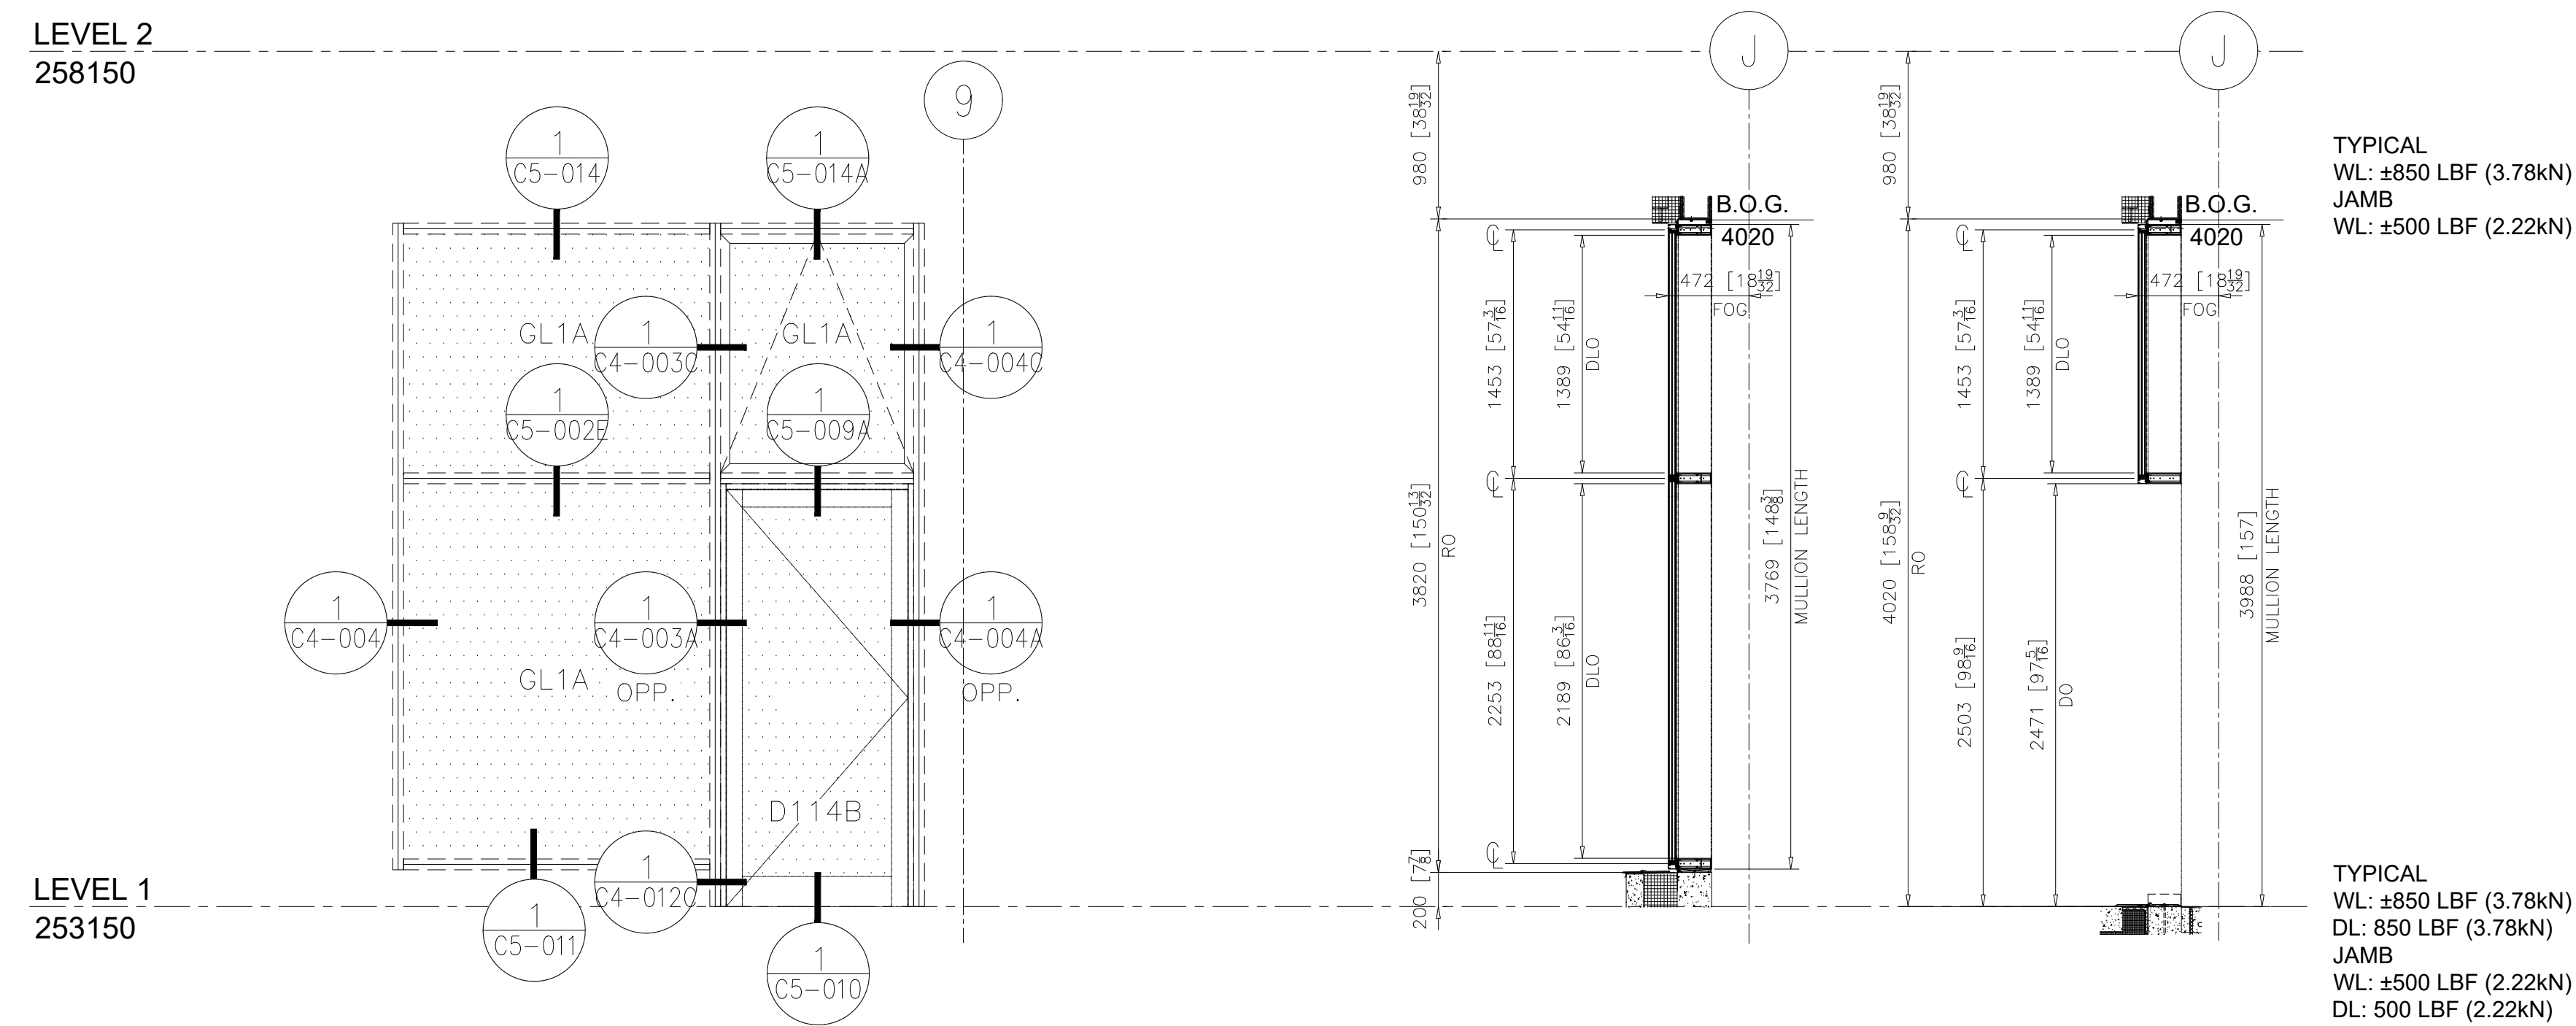


1
C3-008

QUANTITY:1

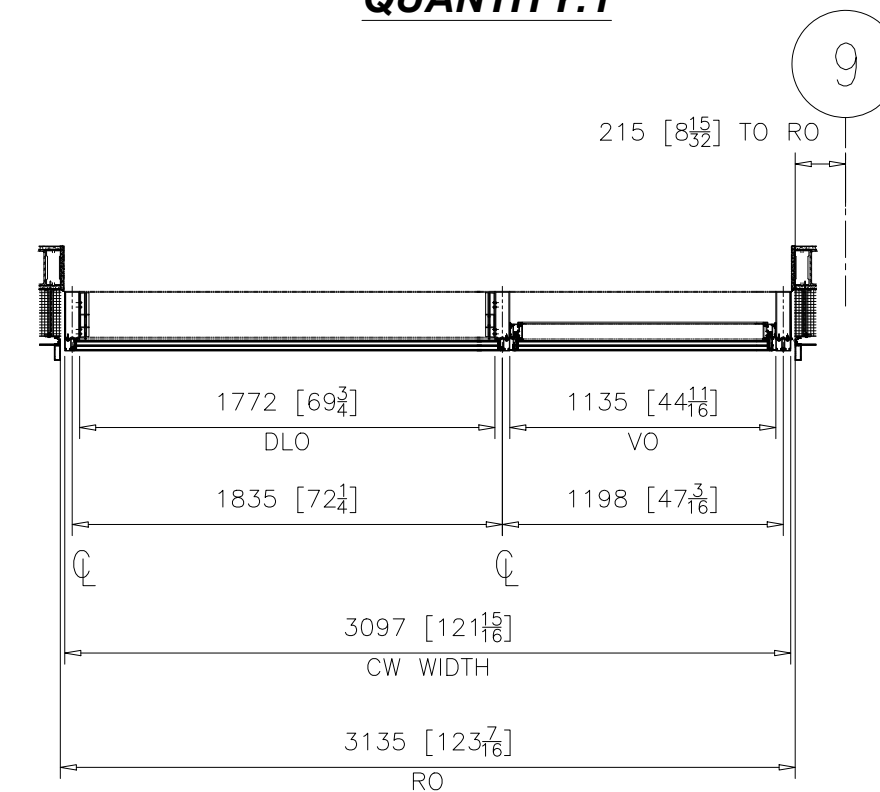

4
C3-008

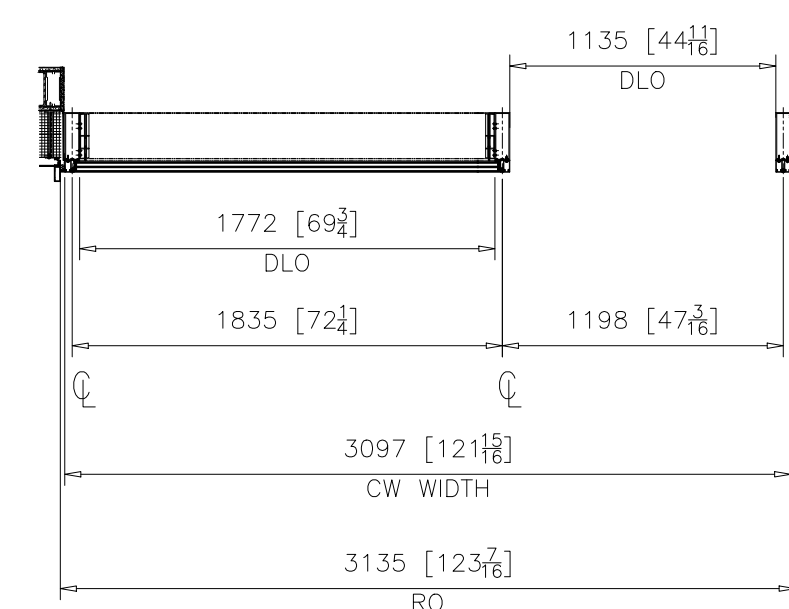

5
C3-008

2
C3-008

3
C3-008

REVISIONS			
No.	Description:	Date:	By:
1	Revised per arch. markups received Feb 11/26	03/03/26	SLR


Project Name:
DOCKSTEADER PRPS

Project Location:
BRAMPTON, ONTARIO

Architect Name: DIAMOND SCHMITT ARCHITECTS

Customer Name: BOTHWELL ACCURATE GLAZING

KEY PLAN:

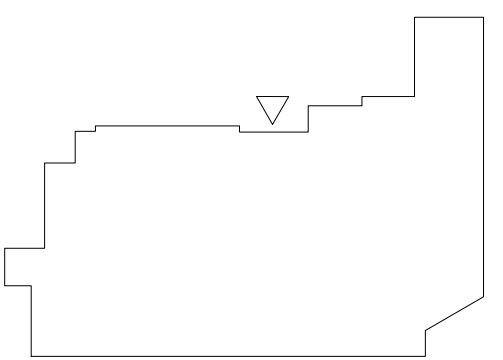


275 Britannia Road East • Mississauga
Ontario • Canada • L4Z2E7
905-890-6970 • oldcastlebe.com

Drawing Name: EG07


Drawn By: SR	Checked By: NP
Drawn Date: 2026/01/12	Issue No.: 1
Scale: NTS	Release Date: 2026/03/03
Drawing Number: 00 000	

C3-008

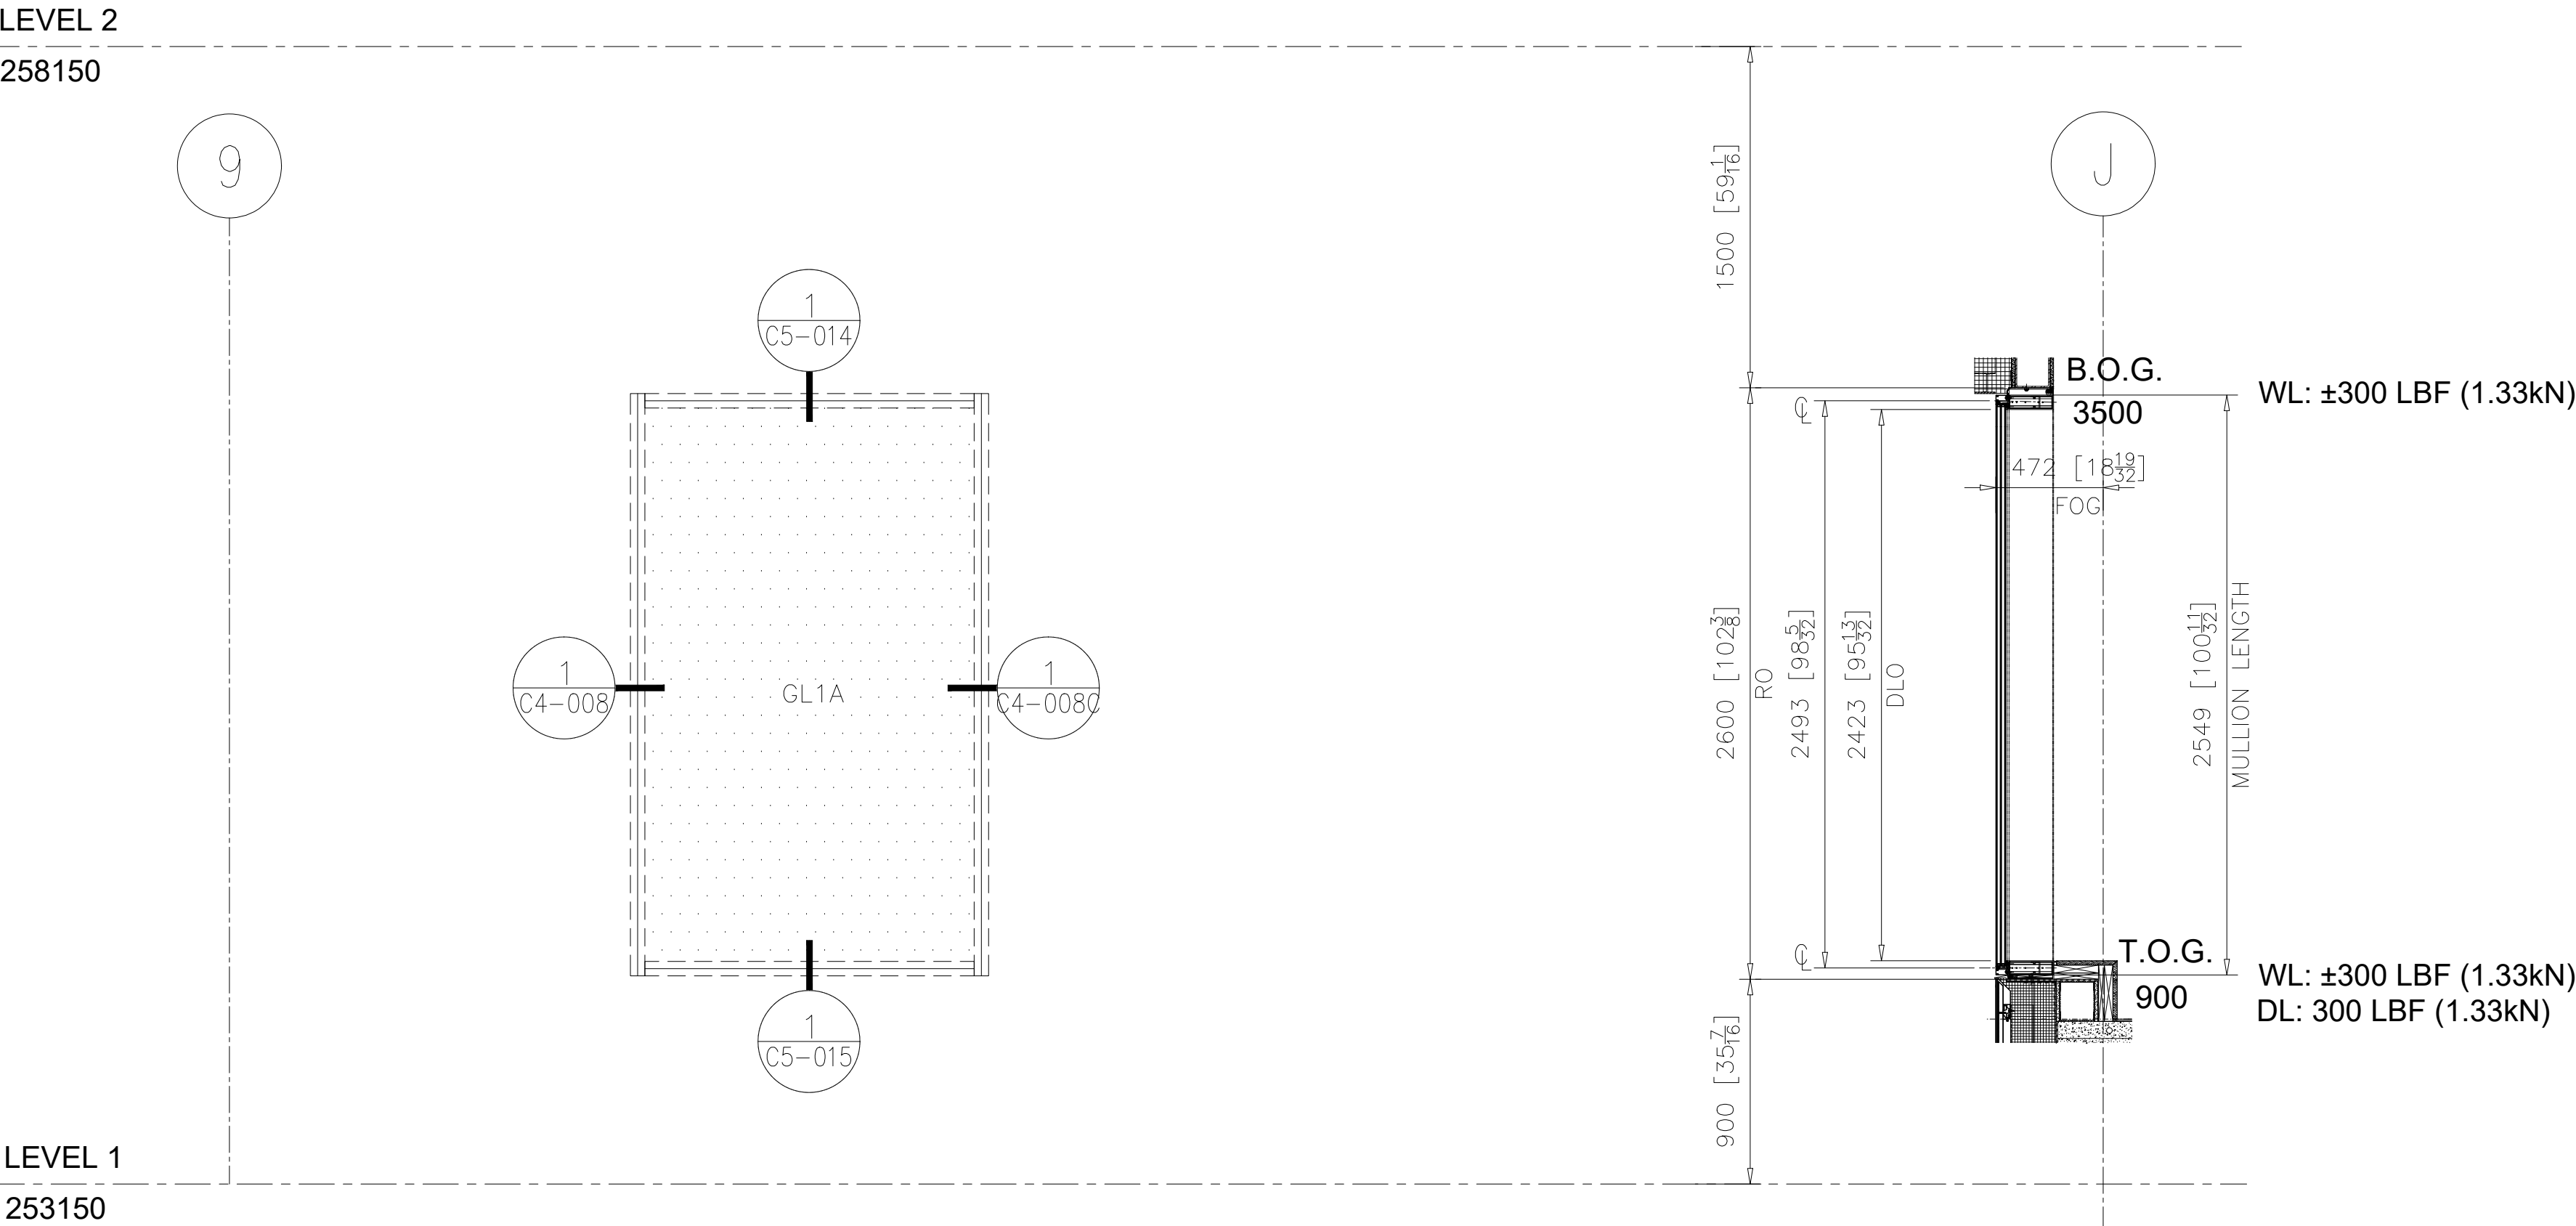

1
C3-009

EG08A-1
PARTIAL ELEVATION
ARCH. REF.: 16/A052
QUANTITY:1

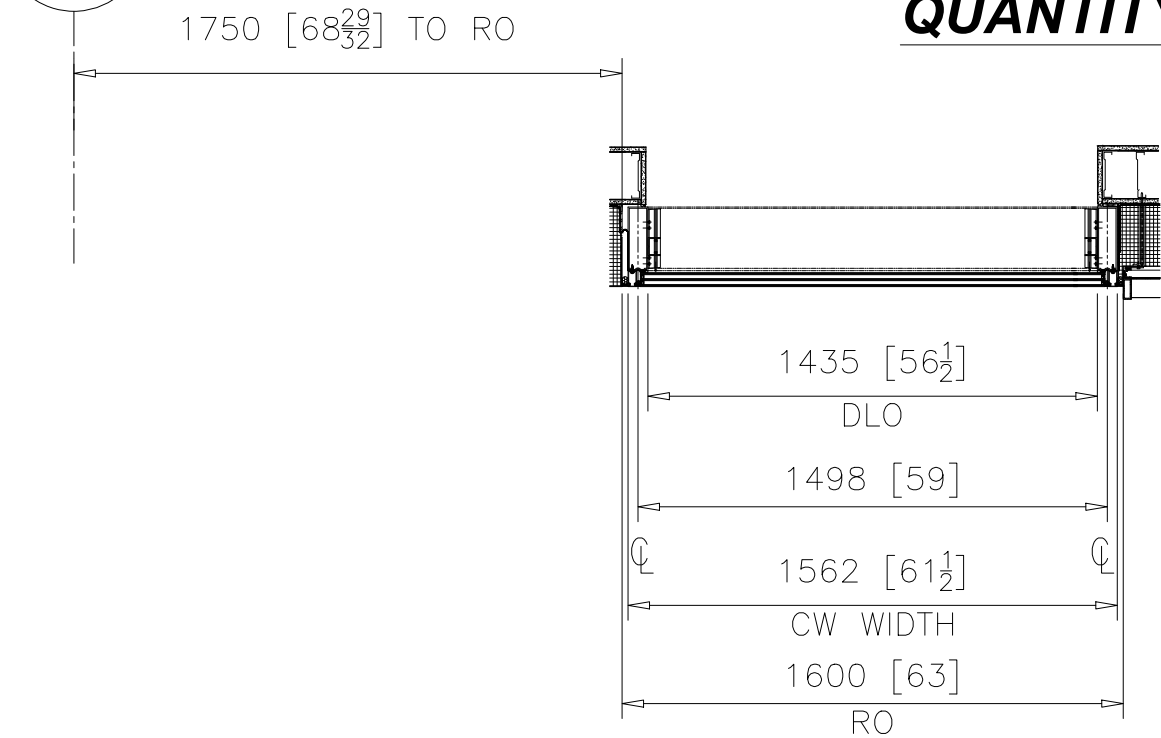

3
C3-009

EG08A-1
PARTIAL PLAN
ARCH. REF.: 1/A105

2
C3-009


EG08A-1
PARTIAL SECTION
ARCH. REF.: N/A

1+

REVISIONS			
No.	Description:	Date:	By:
1	Revised per arch. markups received Feb 11/26	03/03/26	SLR

Project Name:	DOCKSTEADER PRPS
Project Location:	BRAMPTON, ONTARIO
Architect Name:	DIAMOND SCHMITT ARCHITECTS
Customer Name:	BOTHWELL ACCURATE GLAZING

KEY PLAN:

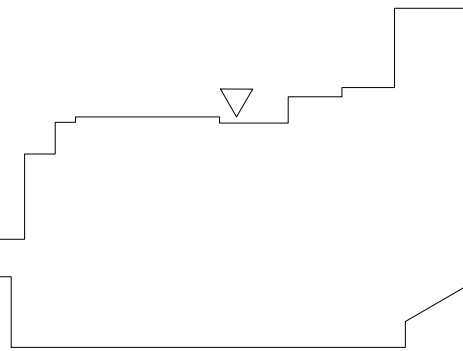


275 Britannia Road East • Mississauga
Ontario • Canada • L4Z2E7
905-890-6970 • oldcastlebe.com

Drawing Name:
EG08A-1

Drawn By:	Checked By:
SR	NP
Drawn Date:	Issue No.:
2026/01/12	1
Scale:	Release Date:
NTS	2026/03/03
Drawing Number:	

C3-009


LEVEL 2
258150

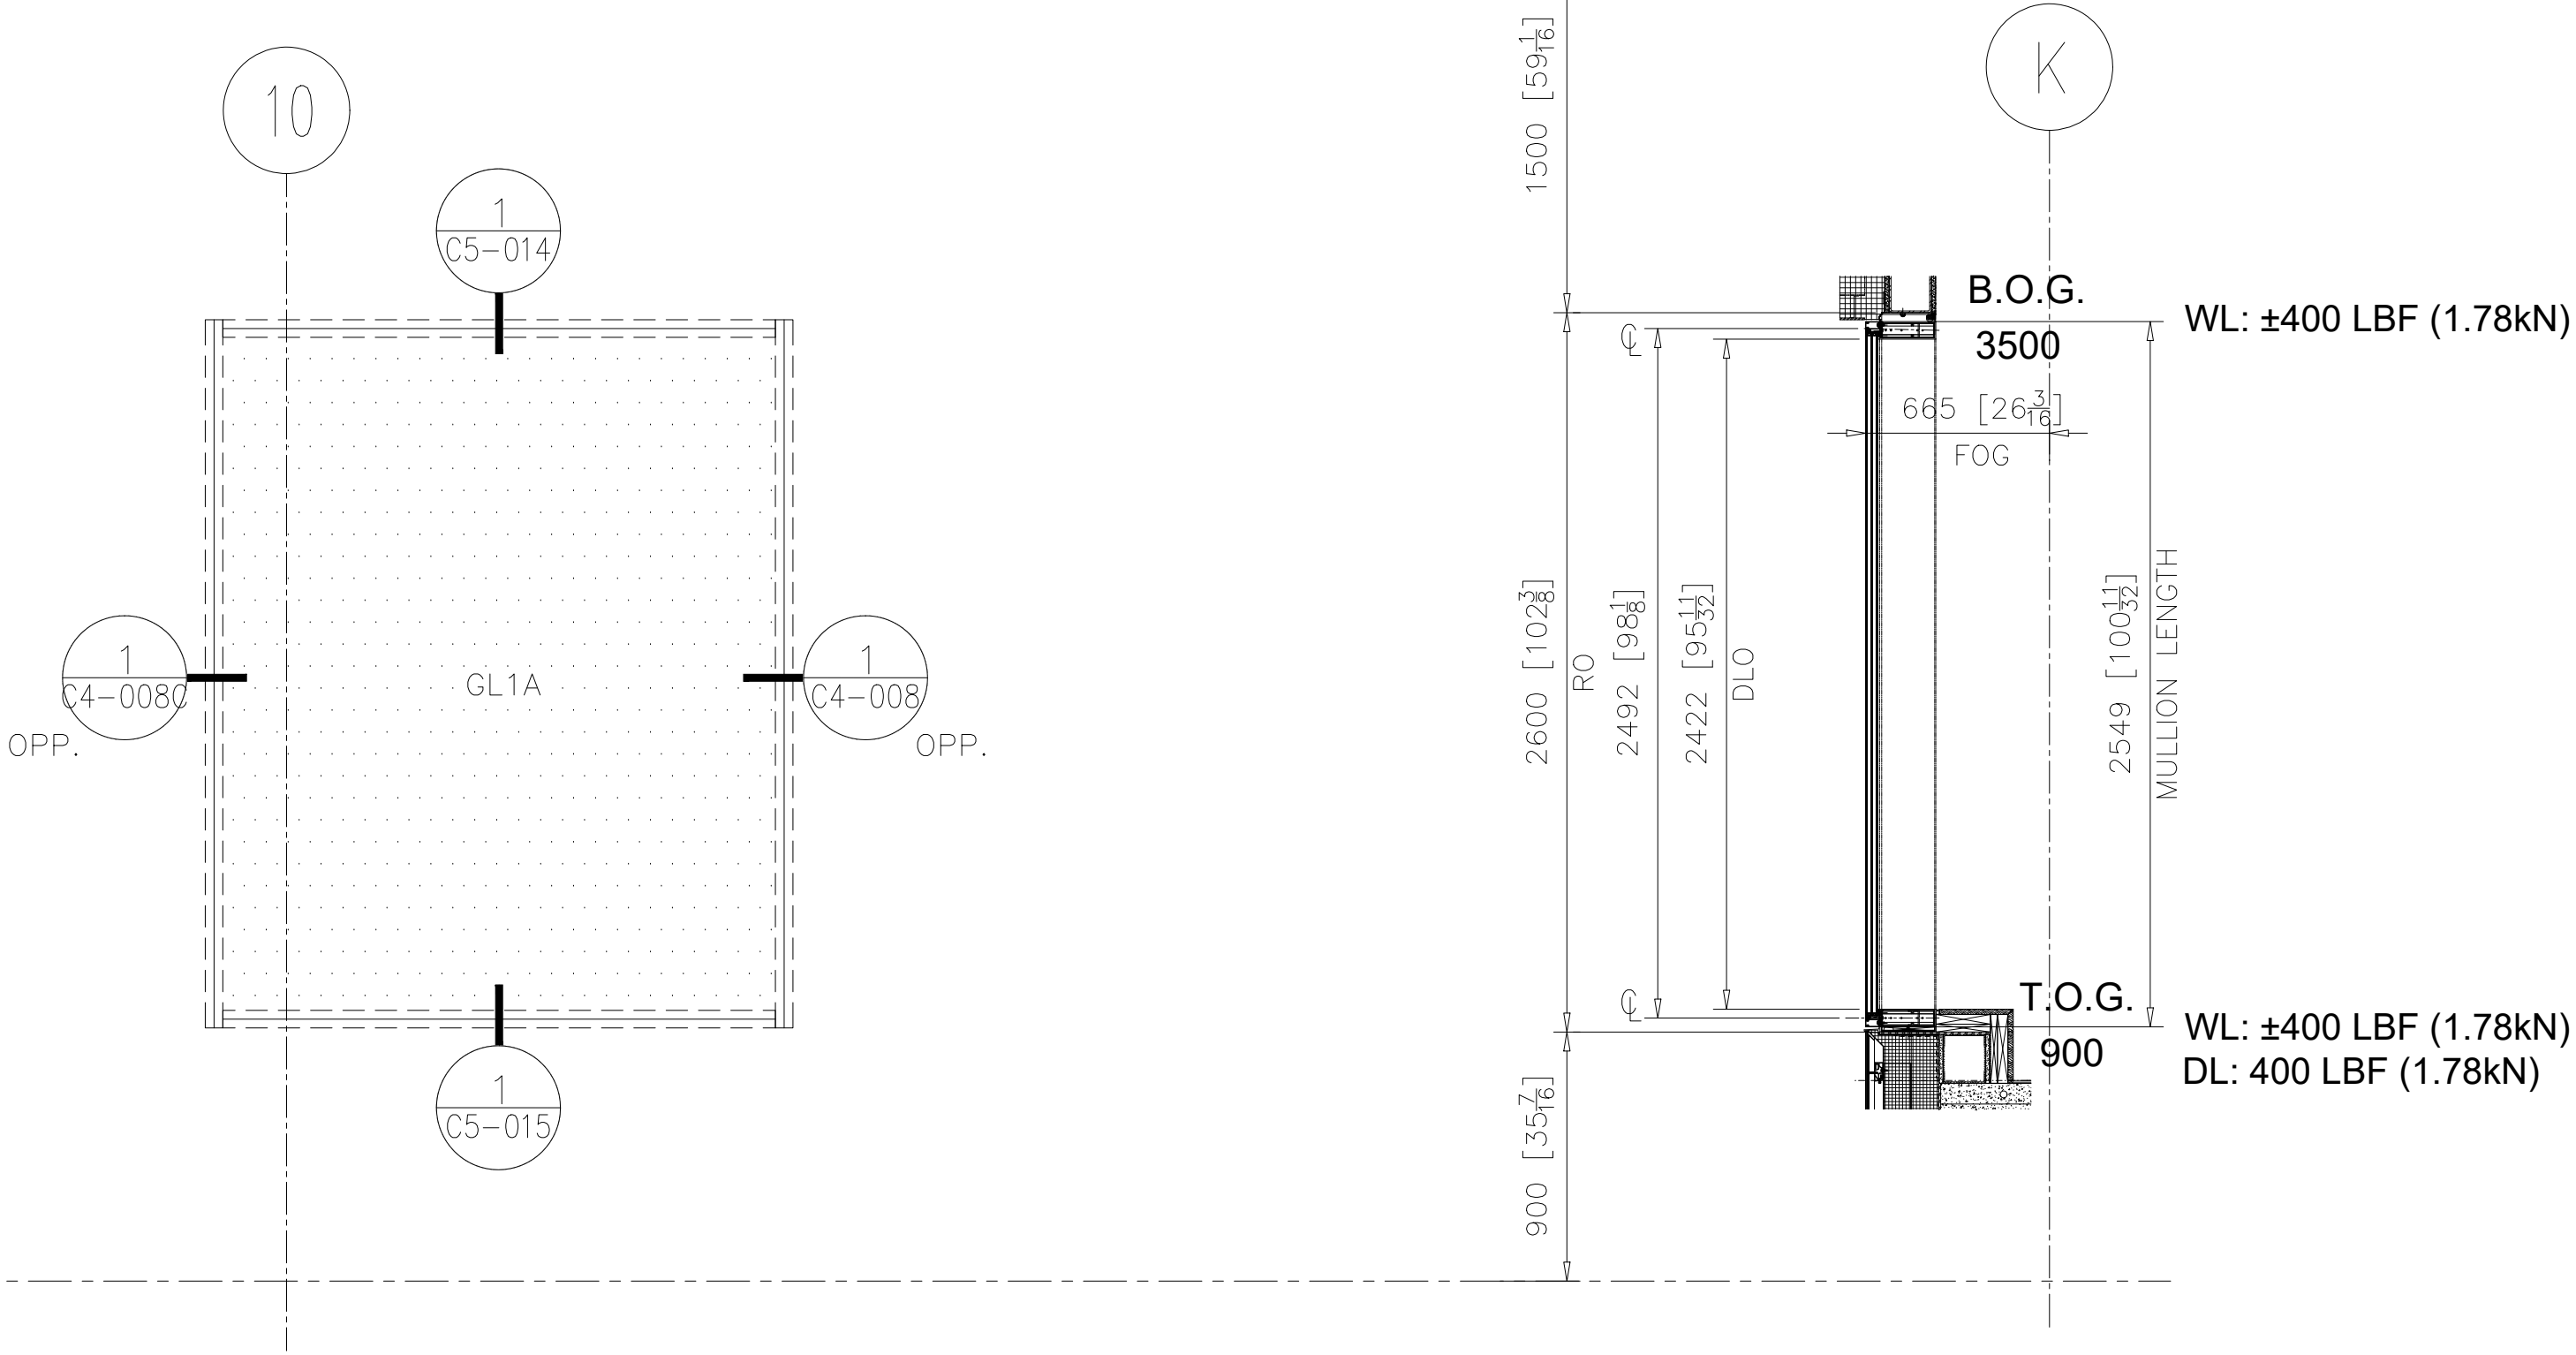

LEVEL 1
253150

1
C3-010 **EG08A-2**
PARTIAL ELEVATION
ARCH. REF.: 16/A052

QUANTITY: 1

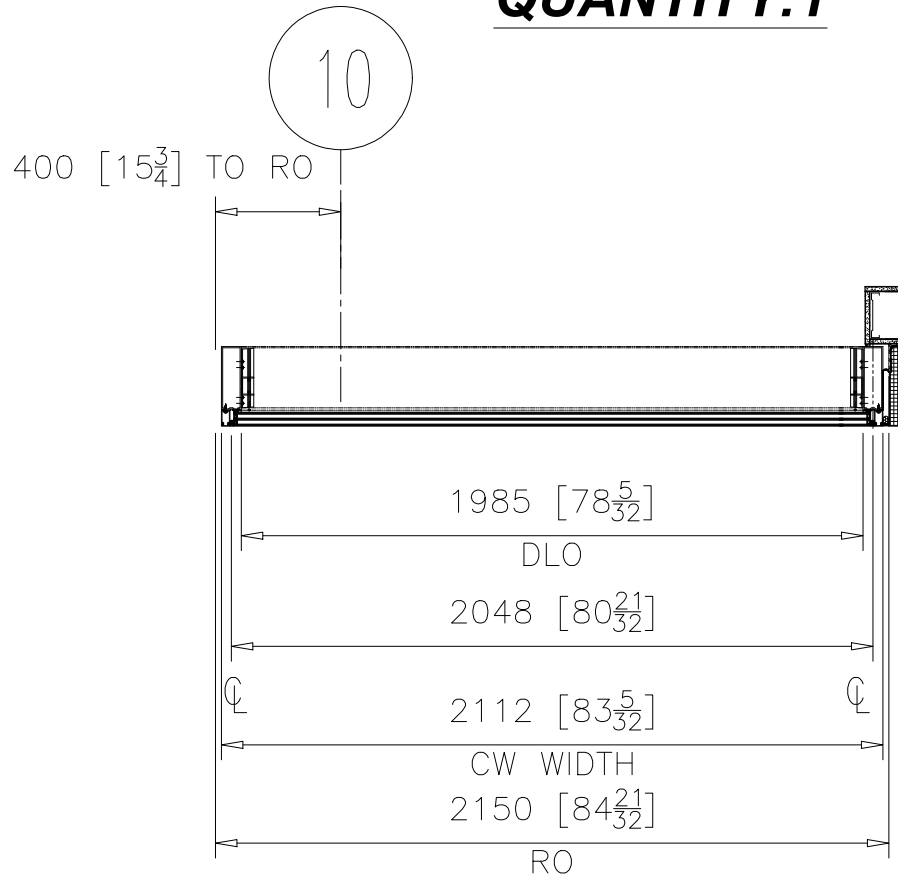


3
C3-010 **EG08A-2**
PARTIAL PLAN
ARCH. REF.: 1/A105

2
C3-010 **EG08A-2**
PARTIAL SECTION
ARCH. REF.: N/A

REVISIONS			
No.	Description:	Date:	By:
1	Revised per arch. markups received Feb 11/26	03/03/26	SLR

Project Name: DOCKSTEADER PRPS
Project Location: BRAMPTON, ONTARIO
Architect Name: DIAMOND SCHMITT ARCHITECTS
Customer Name: BOTHWELL ACCURATE GLAZING

KEY PLAN:

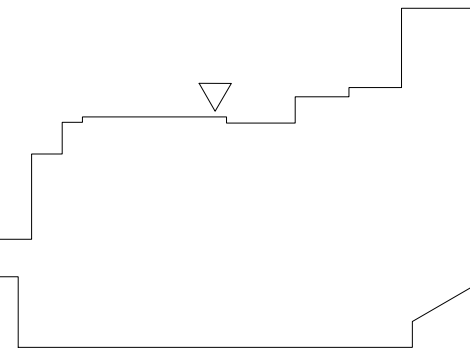



275 Britannia Road East • Mississauga
Ontario • Canada • L4Z2E7
905-890-6970 • oldcastlebe.com

Drawing Name:
EG08A-2

Drawn By: SR	Checked By: NP
Drawn Date: 2026/01/12	Issue No.: 1
Scale: NTS	Release Date: 2026/03/03
Drawing Number:	


C3-010

LEVEL 2
258150

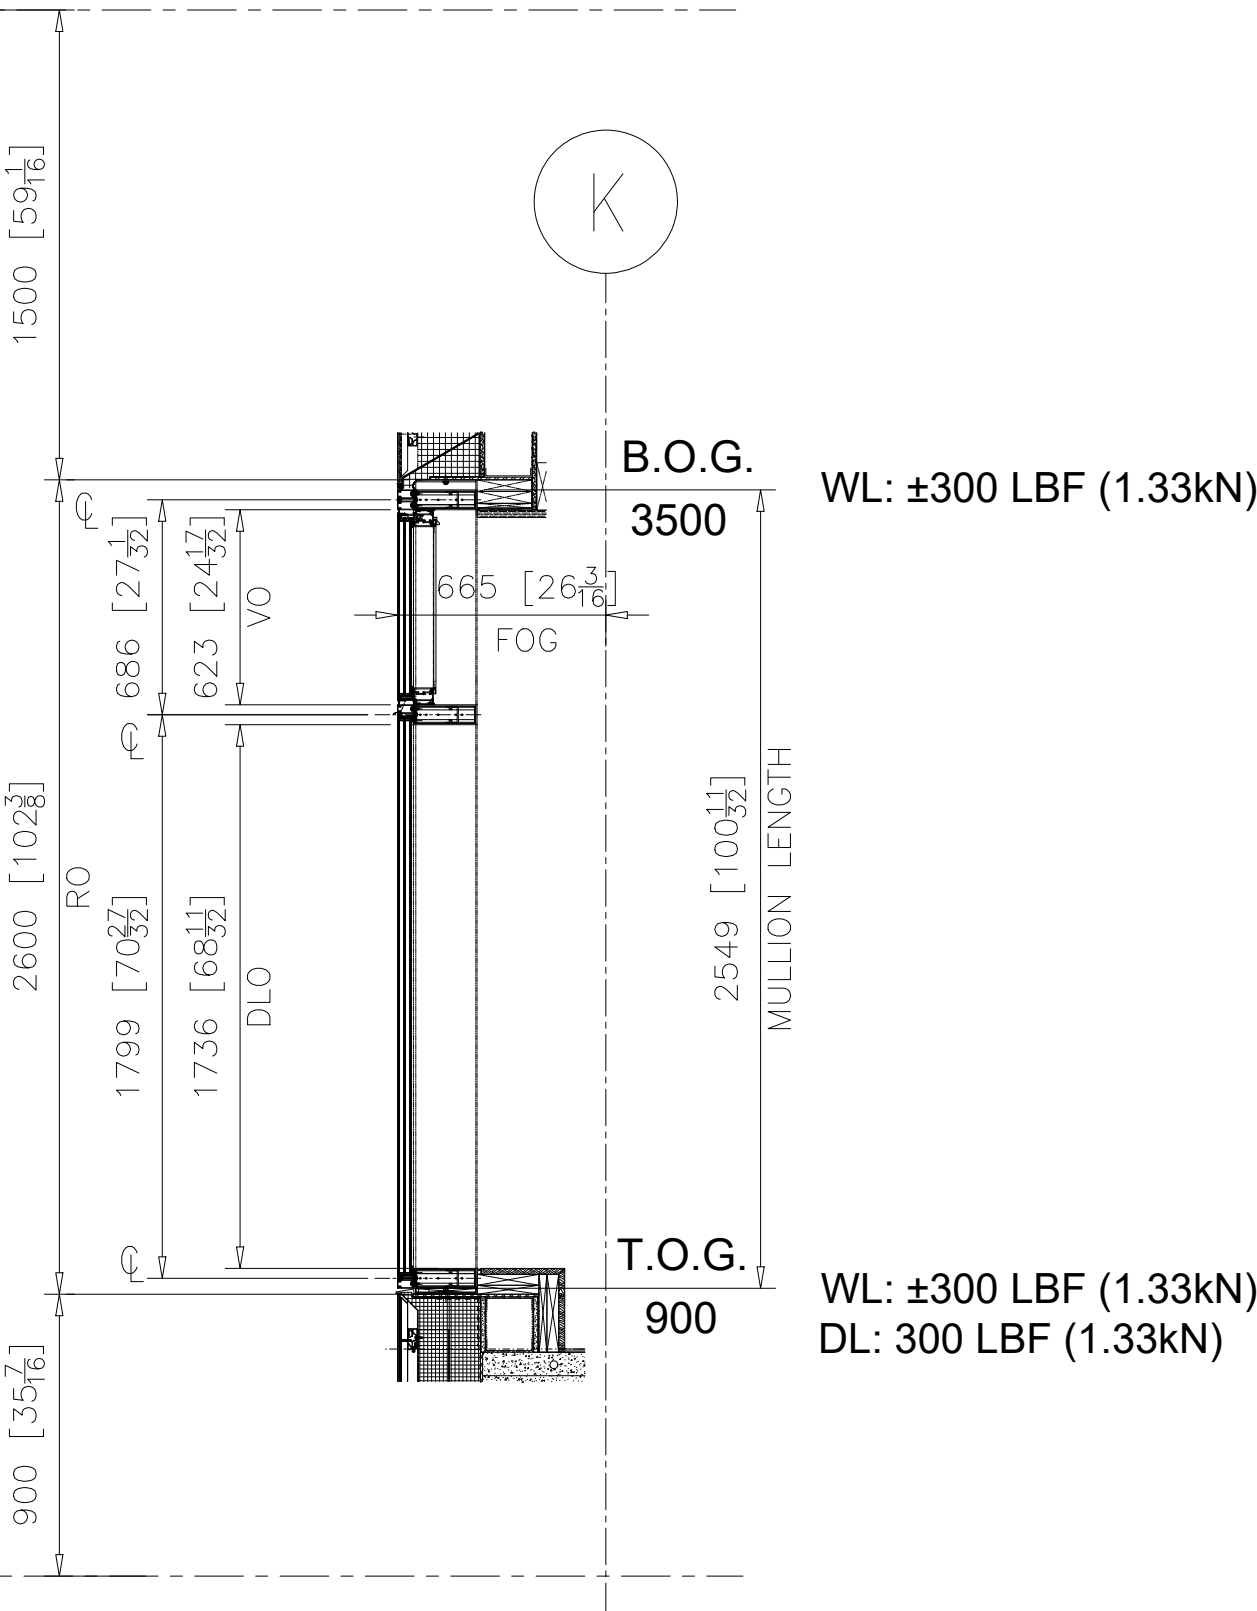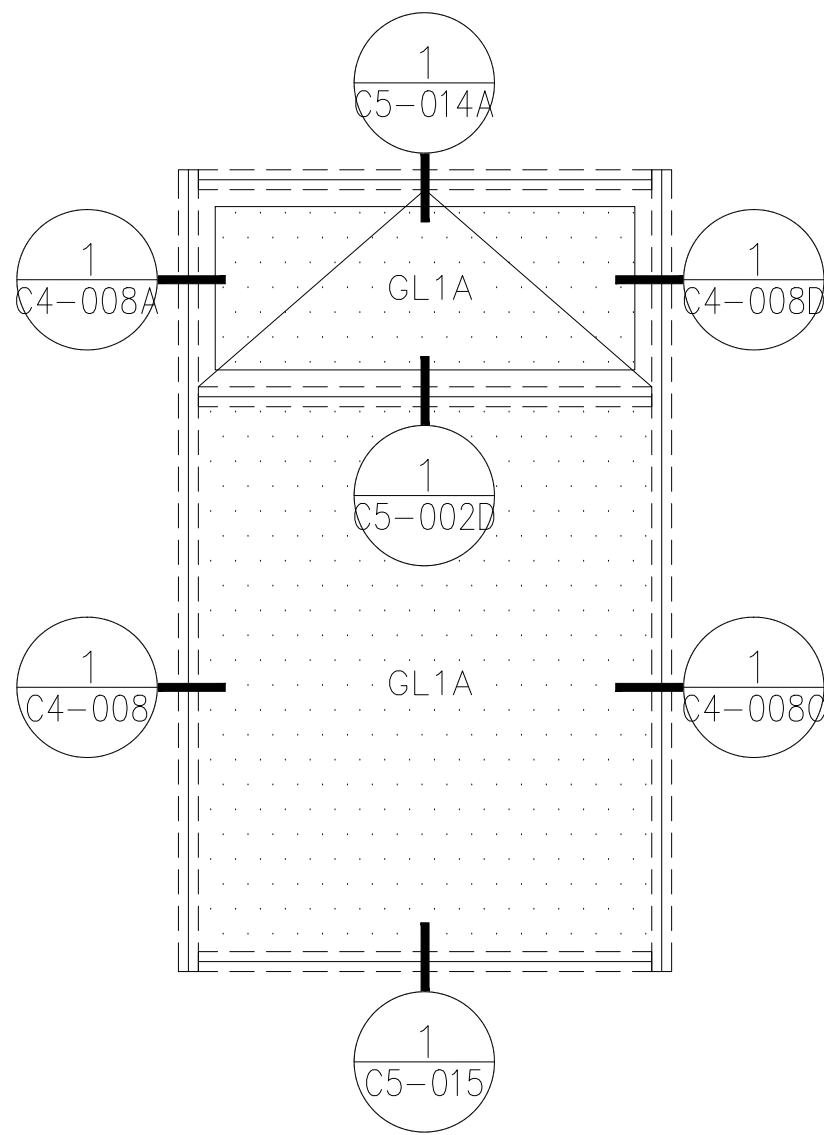

LEVEL 1
253150

1
C3-011 **EG08B**
PARTIAL ELEVATION
ARCH. REF.: 16/A052
QUANTITY:6

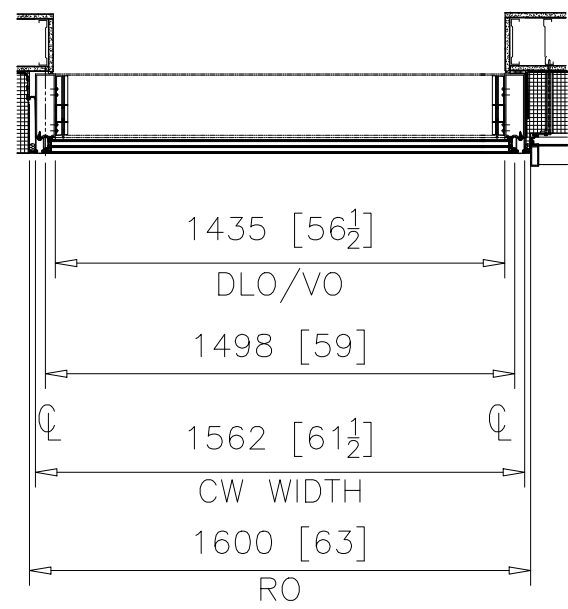


3
C3-011 **EG08B**
PARTIAL PLAN
ARCH. REF.: 1/A105

2
C3-011 **EG08B**
PARTIAL SECTION
ARCH. REF.: 1/A451

REVISIONS			
No.	Description:	Date:	By:
1	Revised per arch. markups received Feb 11/26	03/03/26	SLR

Project Name:	DOCKSTEADER PRPS
Project Location:	BRAMPTON, ONTARIO
Architect Name:	DIAMOND SCHMITT ARCHITECTS
Customer Name:	BOTHWELL ACCURATE GLAZING

KEY PLAN:

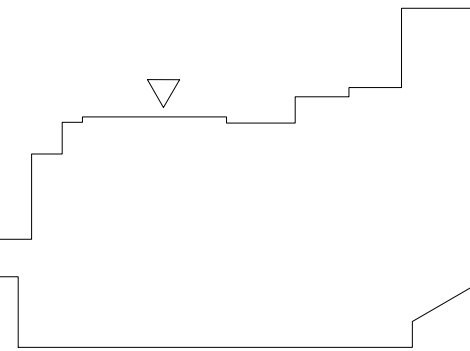


275 Britannia Road East • Mississauga
Ontario • Canada • L4Z2E7
905-890-6970 • oldcastlebe.com

Drawing Name: EG08B	
Drawn By: SR	Checked By: NP
Drawn Date: 2026/01/12	Issue No.: 1
Scale: NTS	Release Date: 2026/03/03
Drawing Number: C3-011	


VB ROOF/ LEVEL 3
262150

LEVEL 2
258150

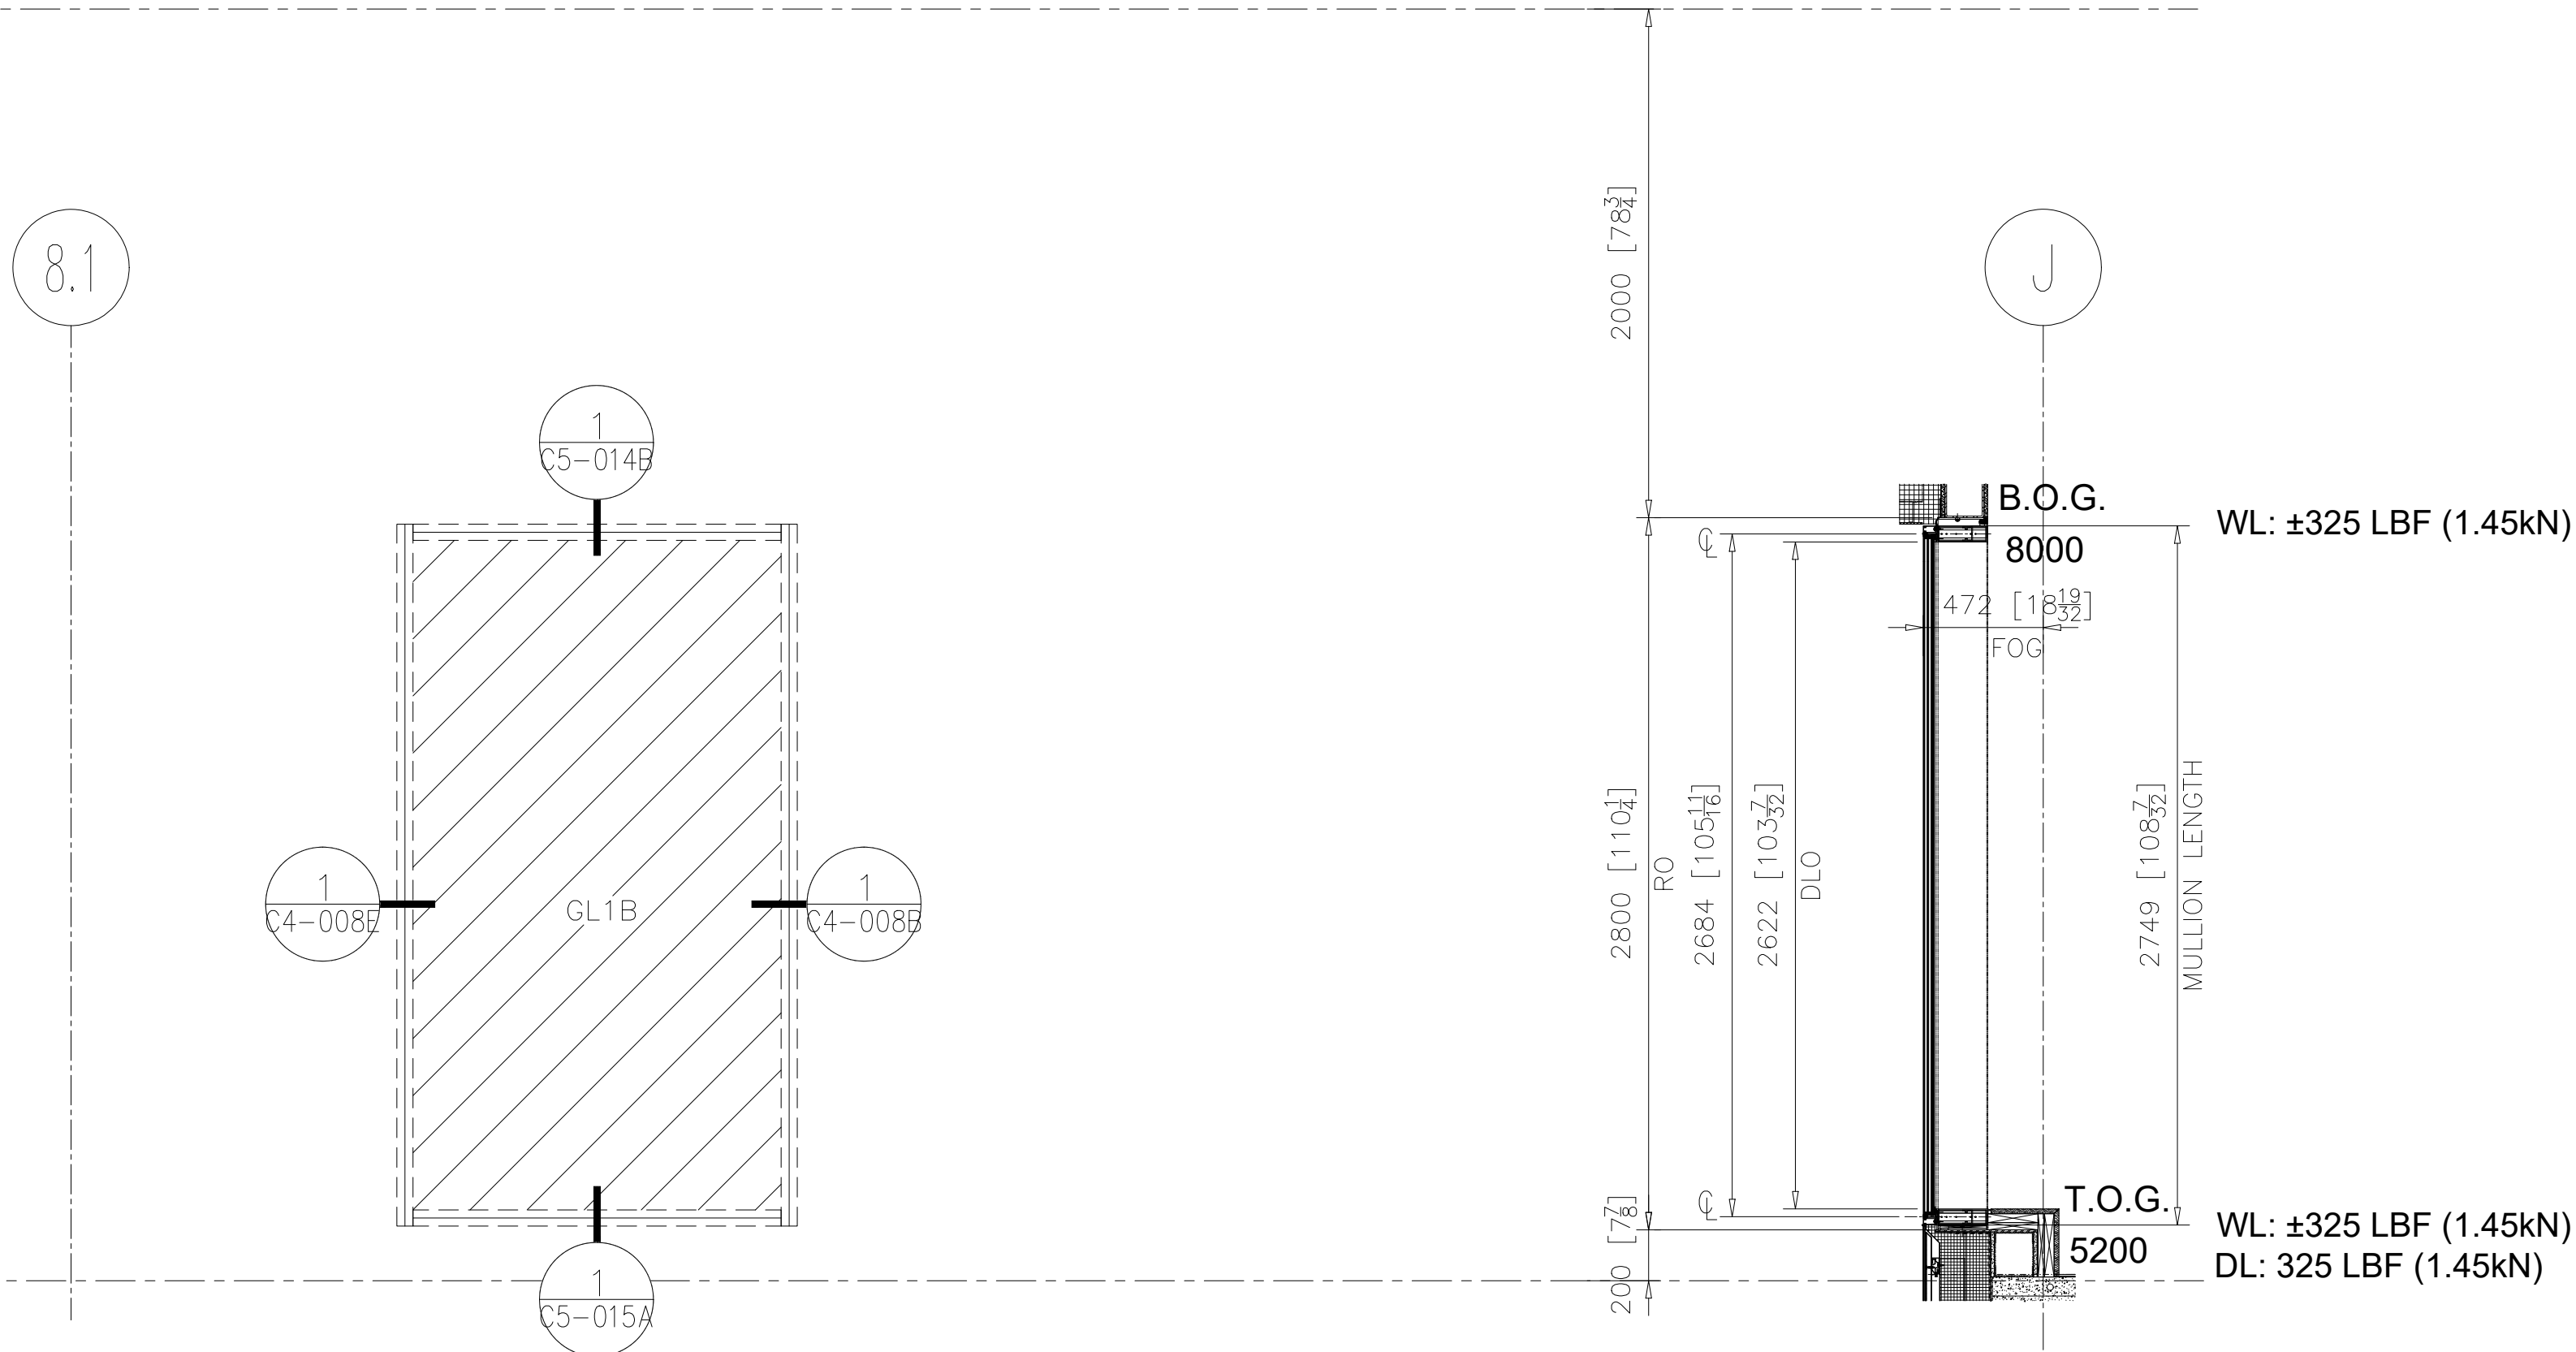

1
C3-012 **EG09A-1**
PARTIAL ELEVATION
ARCH. REF.: 16/A052

2
C3-012 **EG09A-1**
PARTIAL SECTION
ARCH. REF.: N/A

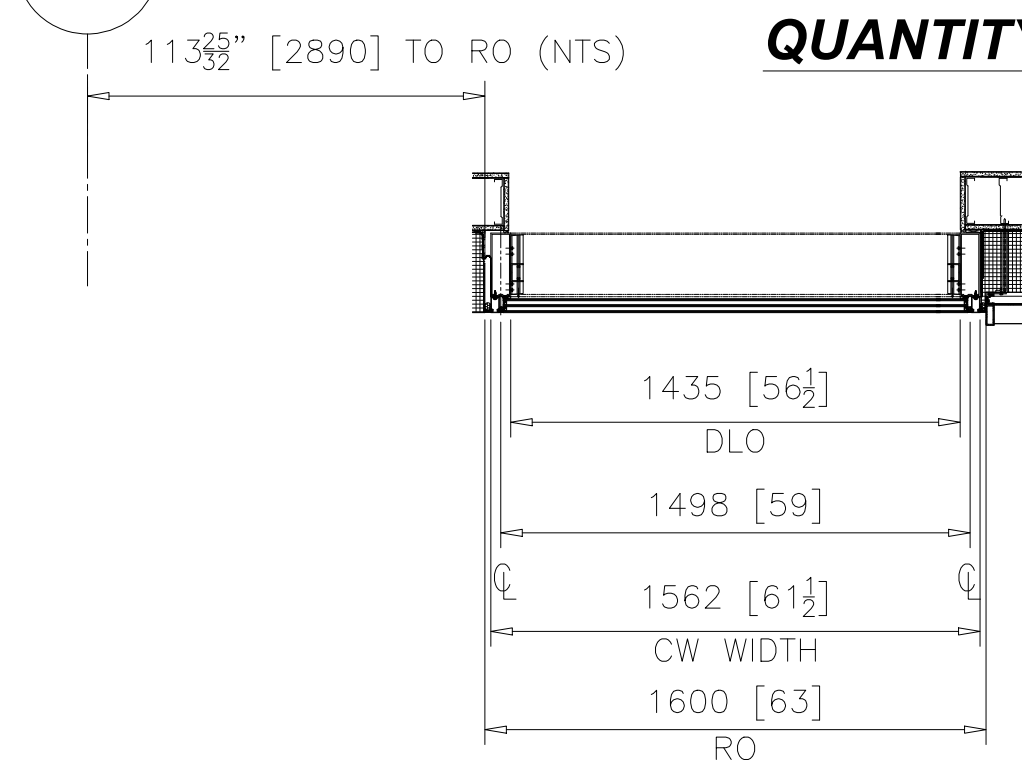


3
C3-012 **EG09A-1**
PARTIAL PLAN
ARCH. REF.: 1/A106

QUANTITY: 1

REVISIONS			
No.	Description:	Date:	By:
1	Revised per arch. markups received Feb 11/26	03/03/26	SLR

Project Name:	DOCKSTEADER PRPS
Project Location:	BRAMPTON, ONTARIO
Architect Name:	DIAMOND SCHMITT ARCHITECTS
Customer Name:	BOTHWELL ACCURATE GLAZING

KEY PLAN:

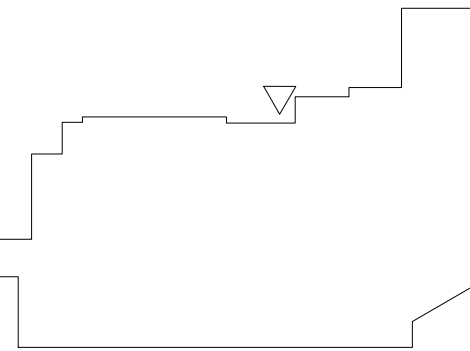


275 Britannia Road East • Mississauga
Ontario • Canada • L4Z2E7
905-890-6970 • oldcastlebe.com

Drawing Name: EG09A-1	
Drawn By: SR	Checked By: NP
Drawn Date: 2026/01/12	Issue No.: 1
Scale: NTS	Release Date: 2026/03/03
Drawing Number: C3-012	

VB ROOF/ LEVEL 3
262150


LEVEL 2
258150

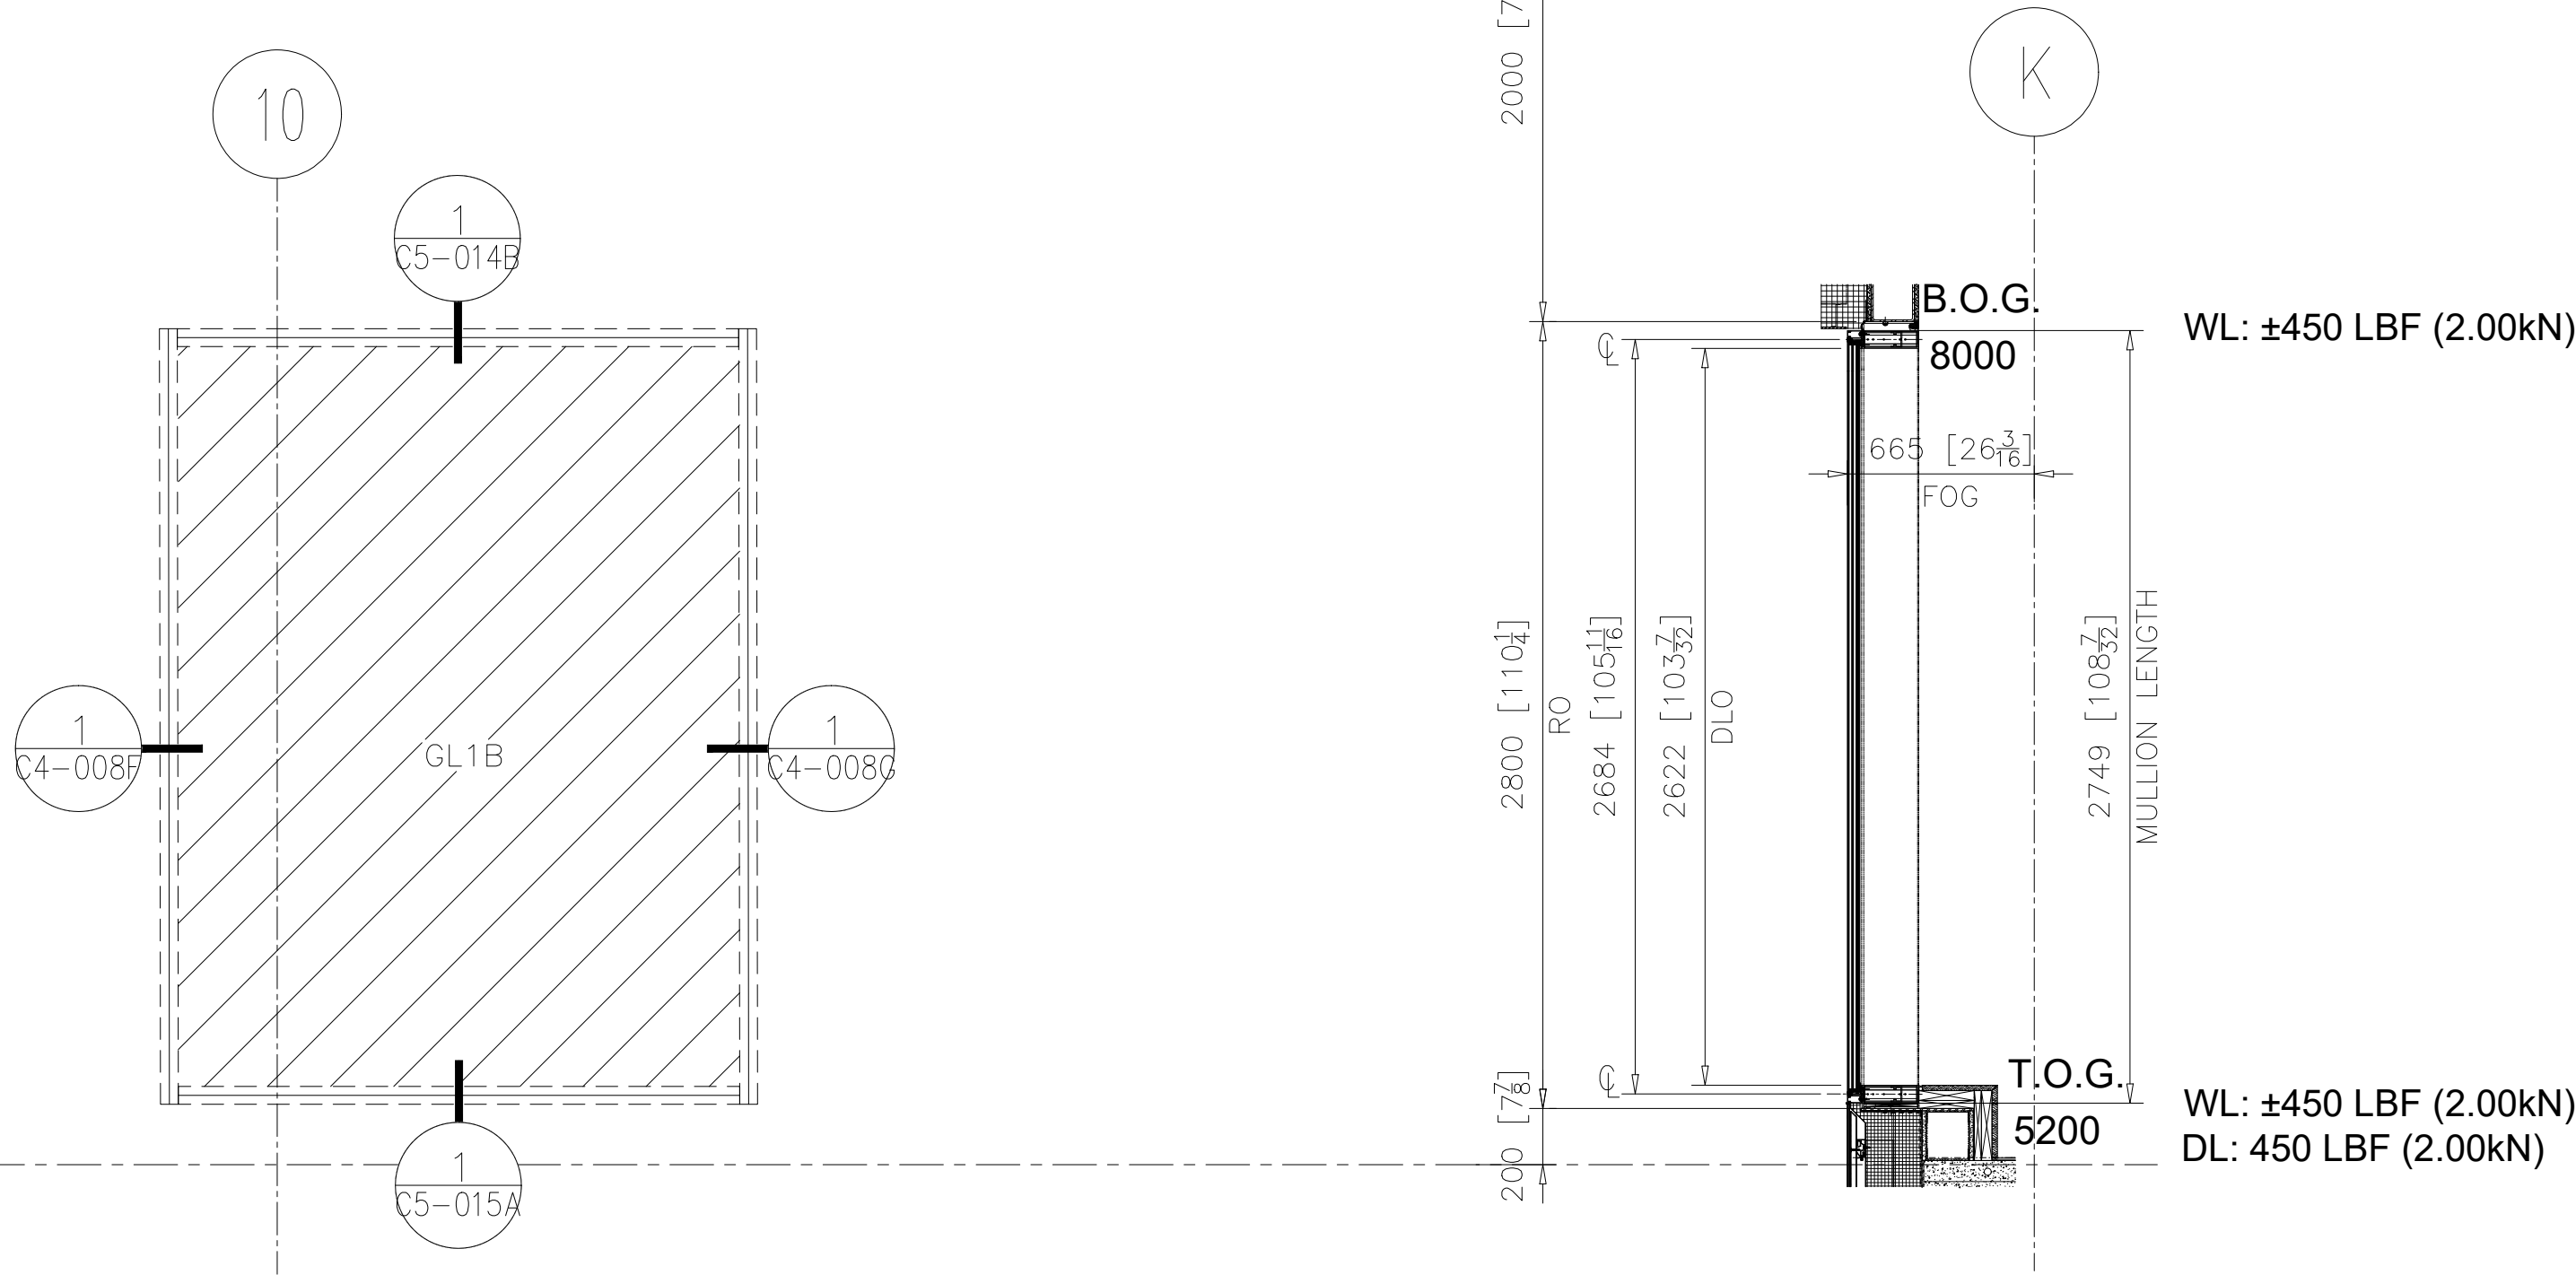

1
C3-013 **EG09A-2**
PARTIAL ELEVATION
ARCH. REF.: 16/A052

2
C3-013 **EG09A-2**
PARTIAL SECTION
ARCH. REF.: N/A

QUANTITY:1

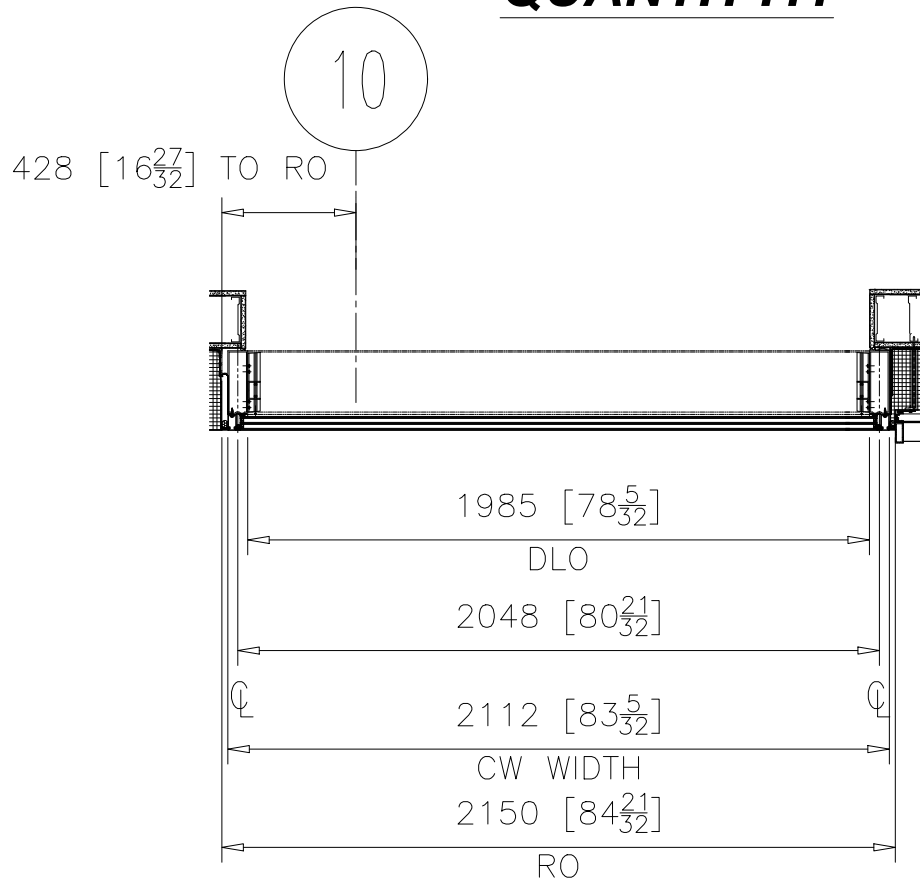


3
C3-013 **EG09A-2**
PARTIAL PLAN
ARCH. REF.: 1/A106

REVISIONS			
No.	Description:	Date:	By:
1	Revised per arch. markups received Feb 11/26	03/03/26	SLR

Project Name:	DOCKSTEADER PRPS
Project Location:	BRAMPTON, ONTARIO
Architect Name:	DIAMOND SCHMITT ARCHITECTS
Customer Name:	BOTHWELL ACCURATE GLAZING

KEY PLAN:


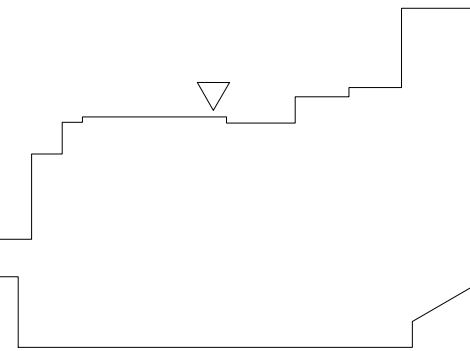


275 Britannia Road East • Mississauga
Ontario • Canada • L4Z2E7
905-890-6970 • oldcastlebe.com

Drawing Name:	
EG09A-2	
Drawn By:	Checked By:
SR	NP
Drawn Date:	Issue No.:
2026/01/12	1
Scale:	Release Date:
NTS	2026/03/03
Drawing Number:	C3-013


VB ROOF/ LEVEL 3
262150

LEVEL 2
258150

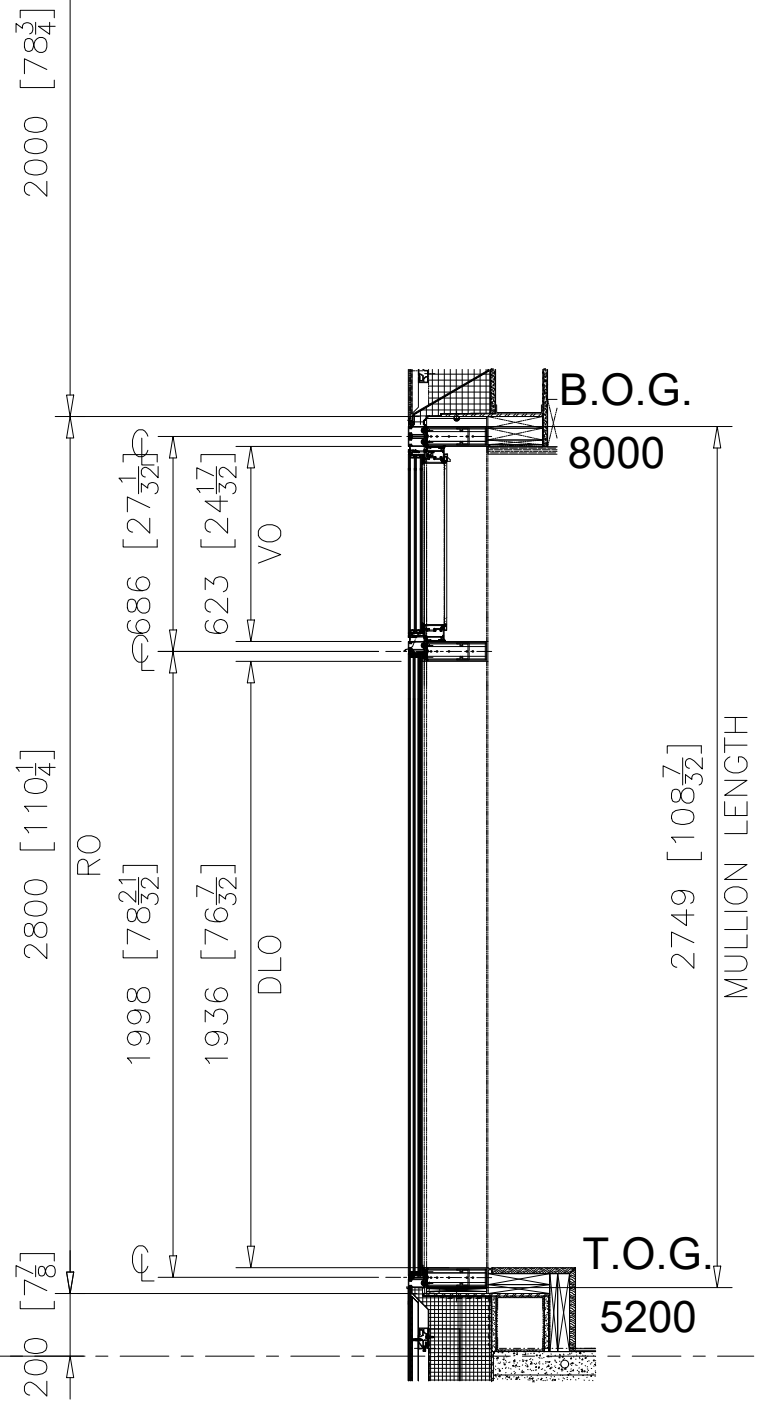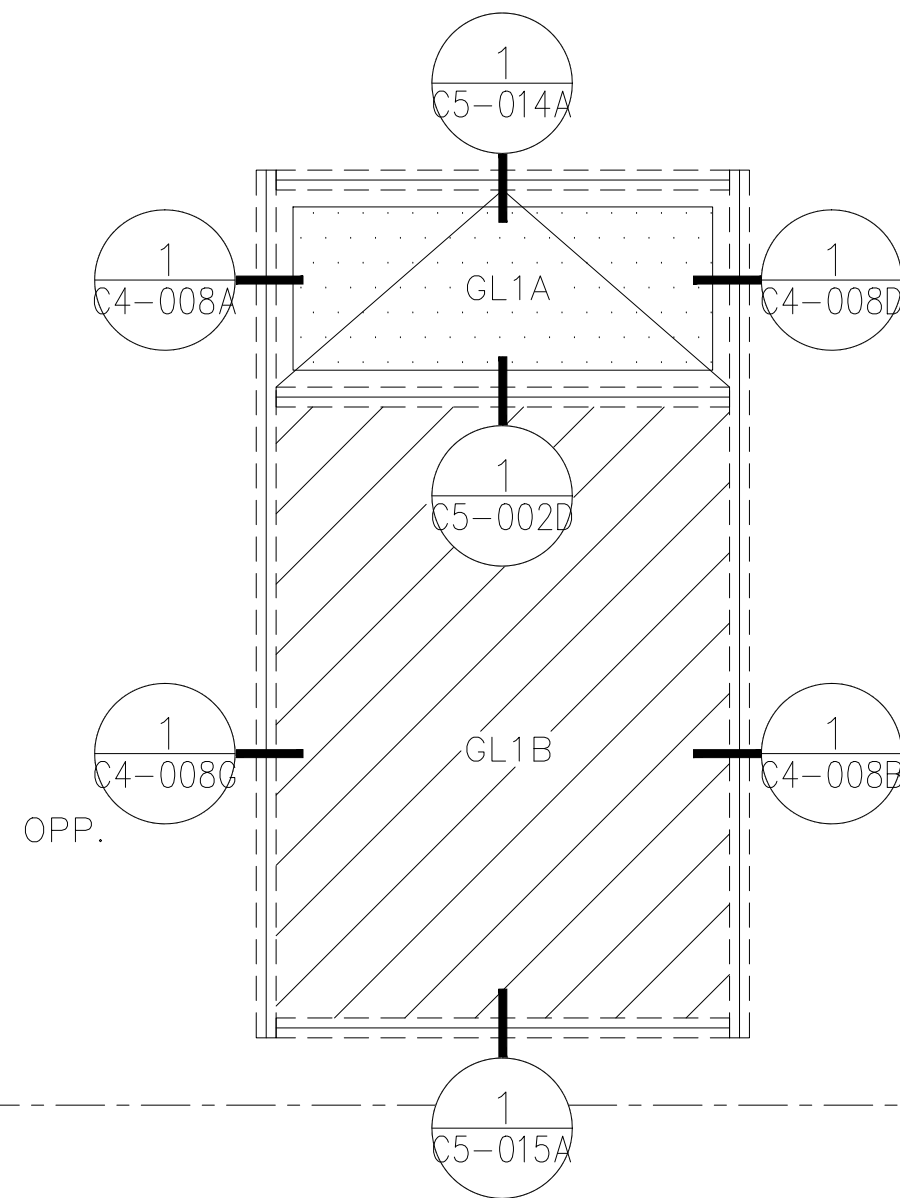

1
C3-014 **EG09B-1**
PARTIAL ELEVATION
ARCH. REF.: 16/A052
QUANTITY:10

2
C3-014 **EG09B-1**
PARTIAL SECTION
ARCH. REF.: 1/A451

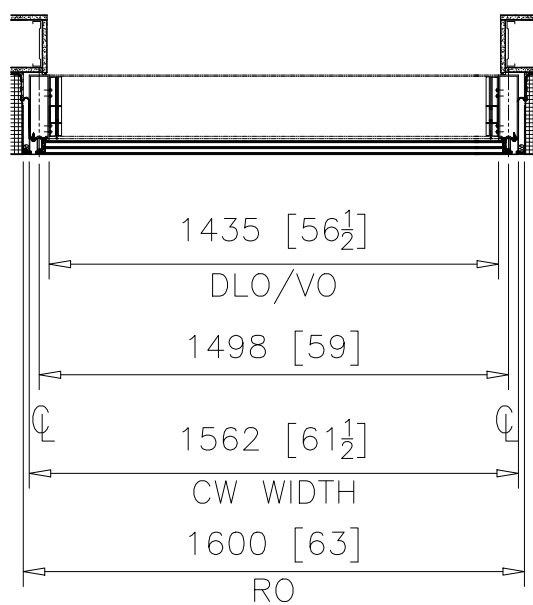


3
C3-014 **EG09B-1**
PARTIAL PLAN
ARCH. REF.: 1/A106

REVISIONS			
No.	Description:	Date:	By:
1	Revised per arch. markups received Feb 11/26	03/03/26	SLR

Project Name: DOCKSTEADER PRPS	Project Location: BRAMPTON, ONTARIO	Architect Name: DIAMOND SCHMITT ARCHITECTS	Customer Name: BOTHWELL ACCURATE GLAZING
-----------------------------------	--	---	---

KEY PLAN:

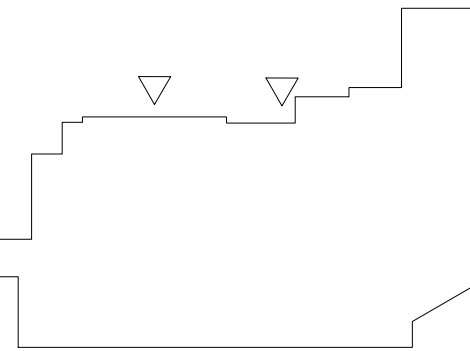


275 Britannia Road East • Mississauga
Ontario • Canada • L4Z2E7
905-890-6970 • oldcastlebe.com


Drawing Name: EG09B-1	
Drawn By: SR	Checked By: NP
Drawn Date: 2026/01/12	Issue No.: 1
Scale: NTS	Release Date: 2026/03/03
Drawing Number: C3-014	

VB ROOF/ LEVEL 3

262150

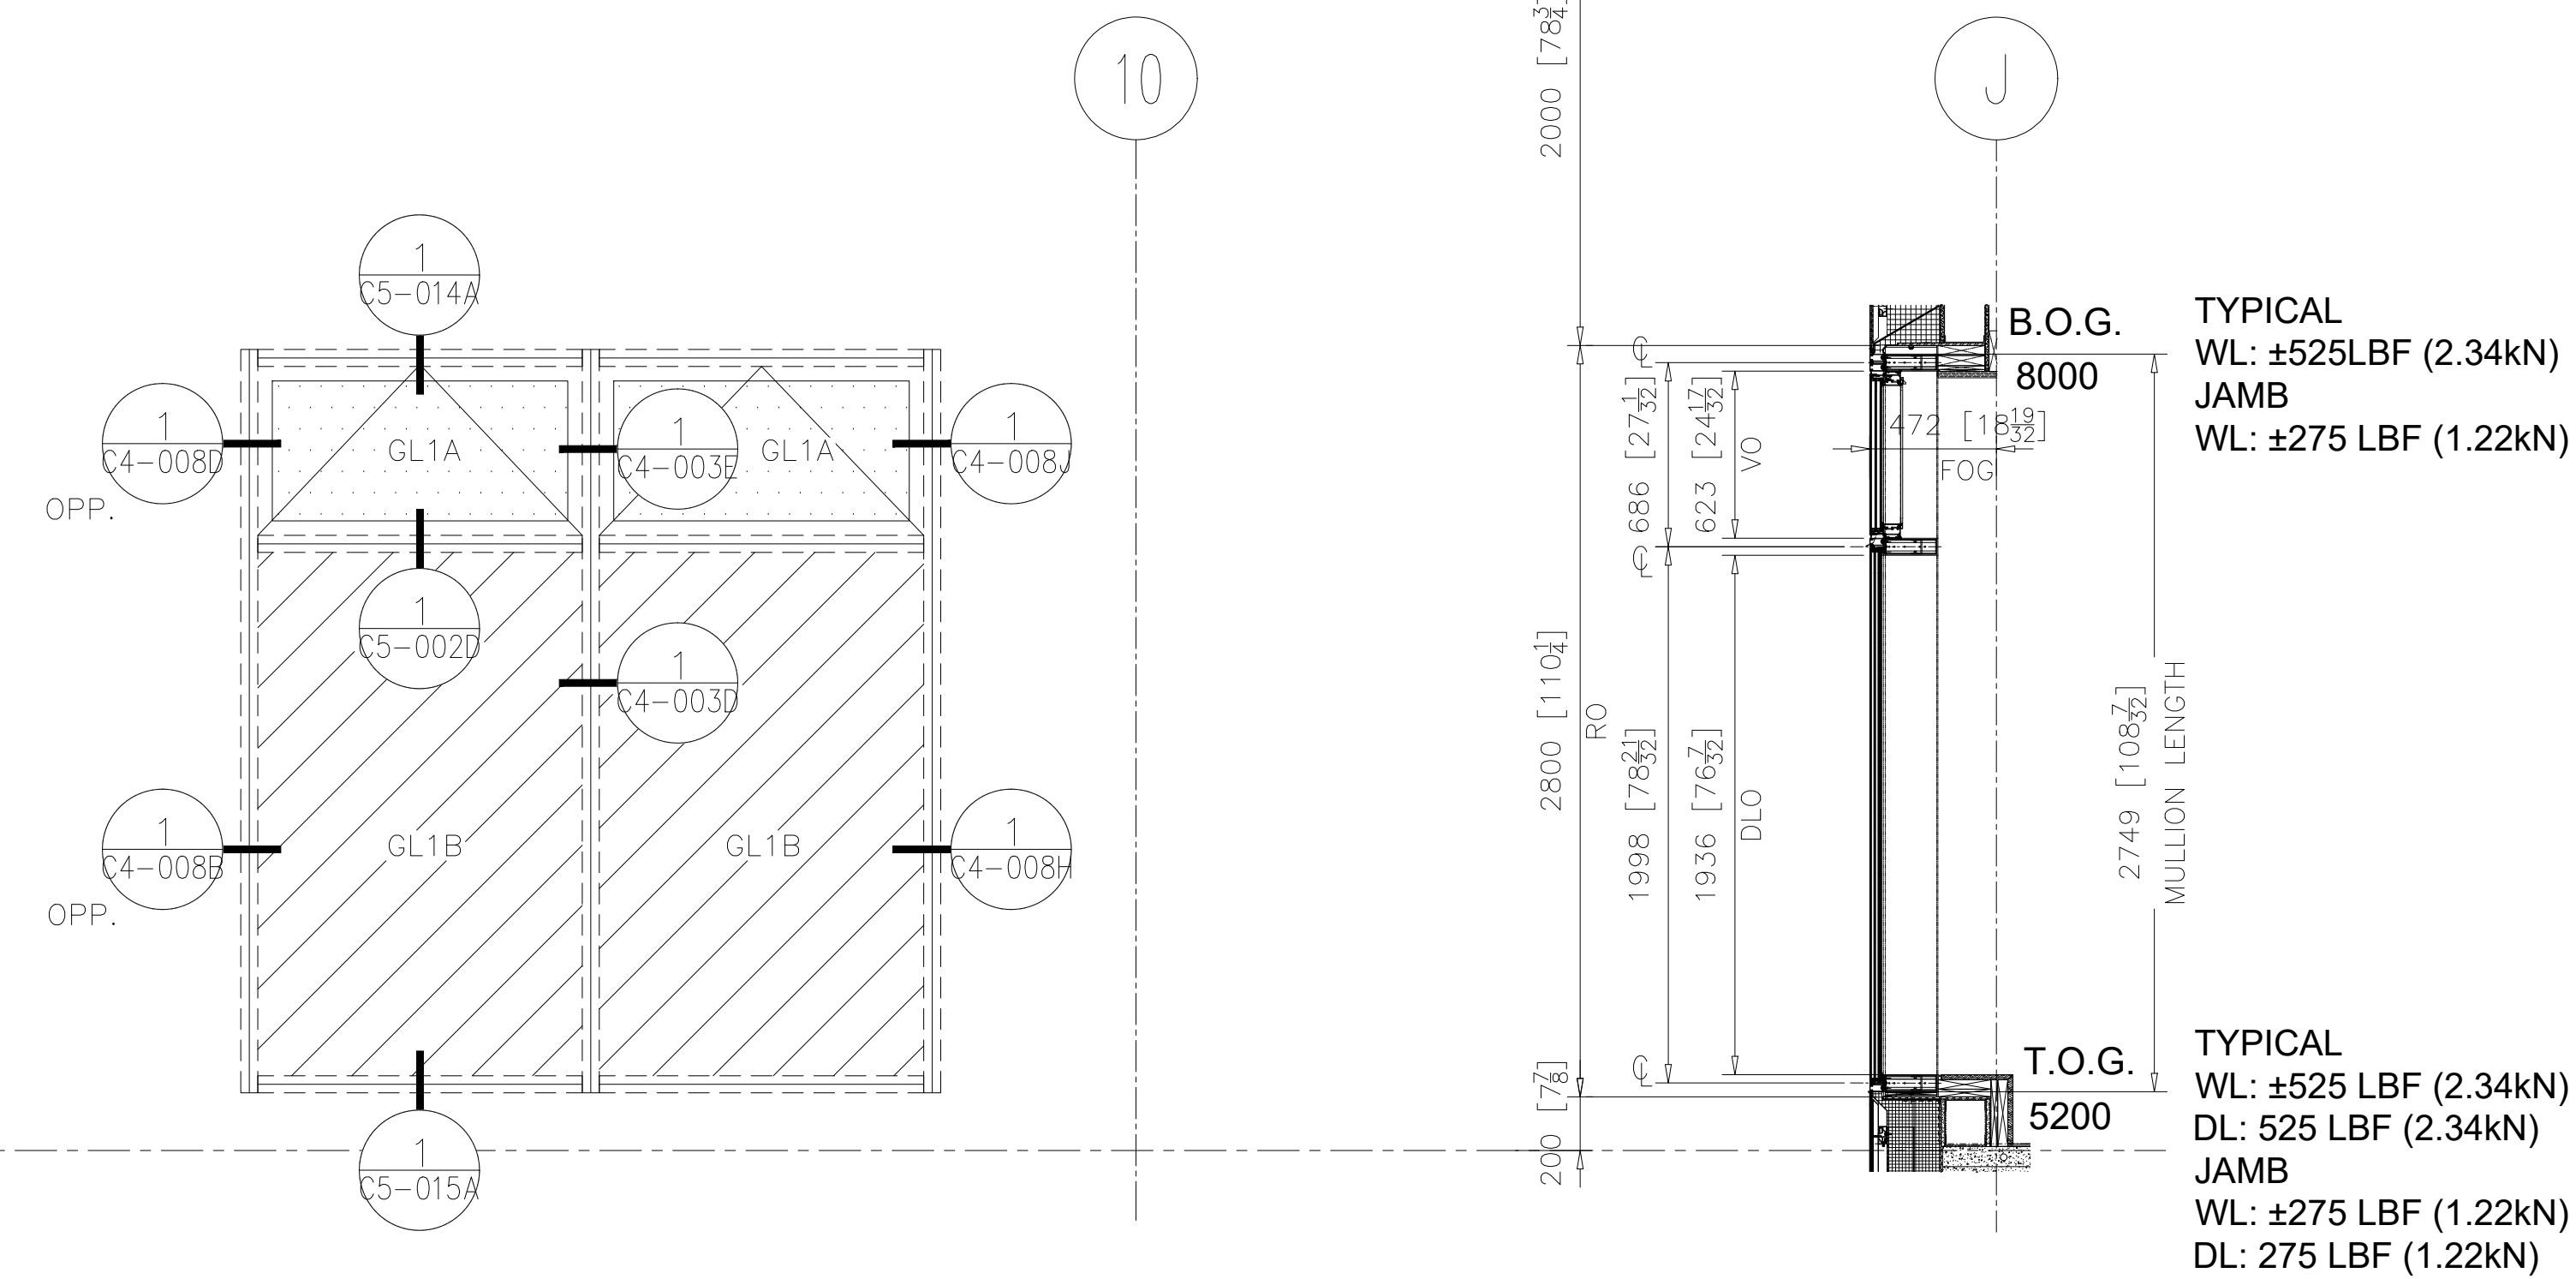

1
C3-015 **EG09B-2**
PARTIAL ELEVATION
ARCH. REF.: 16/A052
QUANTITY:1

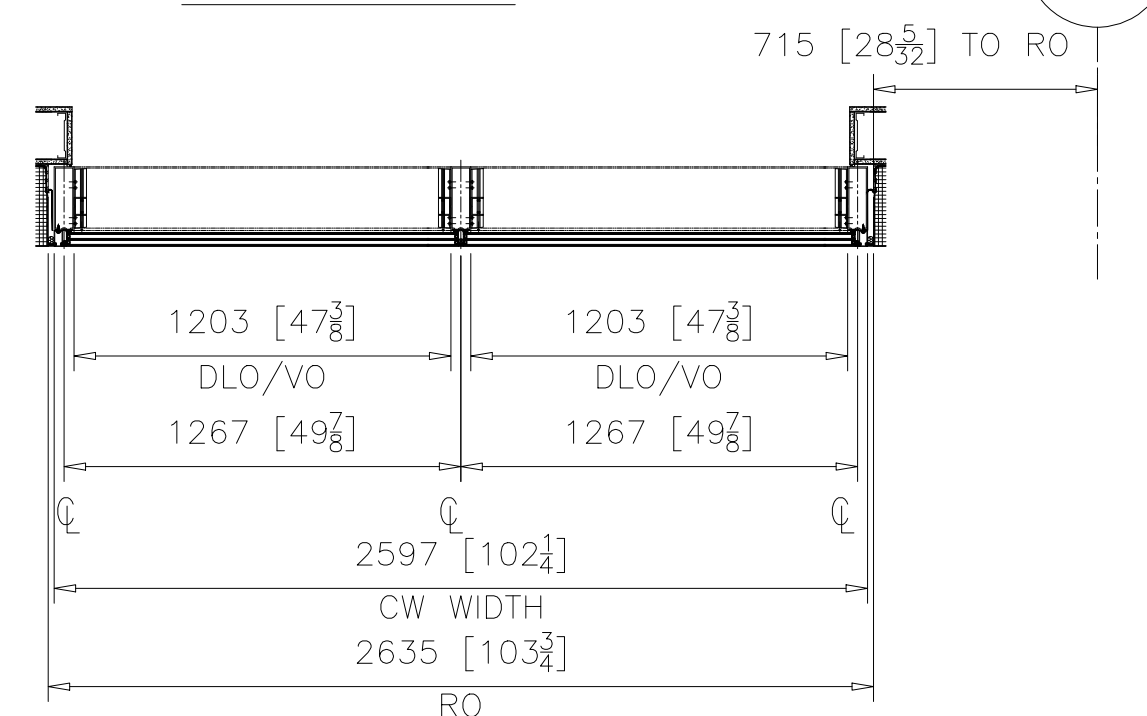

3
C3-015

2
C3-015

REVISIONS

[illegible]


Project Name:
DOCKSTEADER PRPS

Project Location:
BRAMPTON, ONTARIO

Architect Name:
DIAMOND SCHMITT ARCHITECTS

Customer Name: BOTHWELL ACCURATE GLAZING

KEY PLAN:

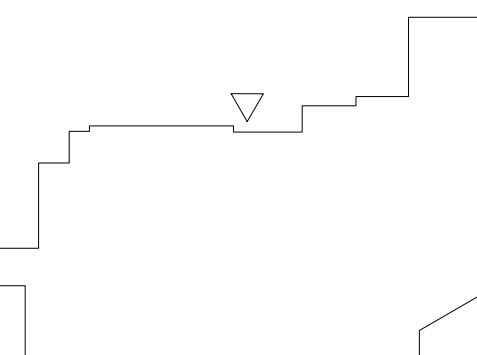

275 Britannia Road East • Mississauga
Ontario • Canada • L4Z2E7
905-890-6970 • oldcastlebe.com

Drawing Name:

EG09B-2

Drawn By:

Checked By:

SR

NP
Issue No:

Drawn Date:
2026/01/12


Issue No.:
1

Scale:
NTS


Release Date	2026/02
--------------	---------

Drawing Number:

2020/03/0
r: C3-015

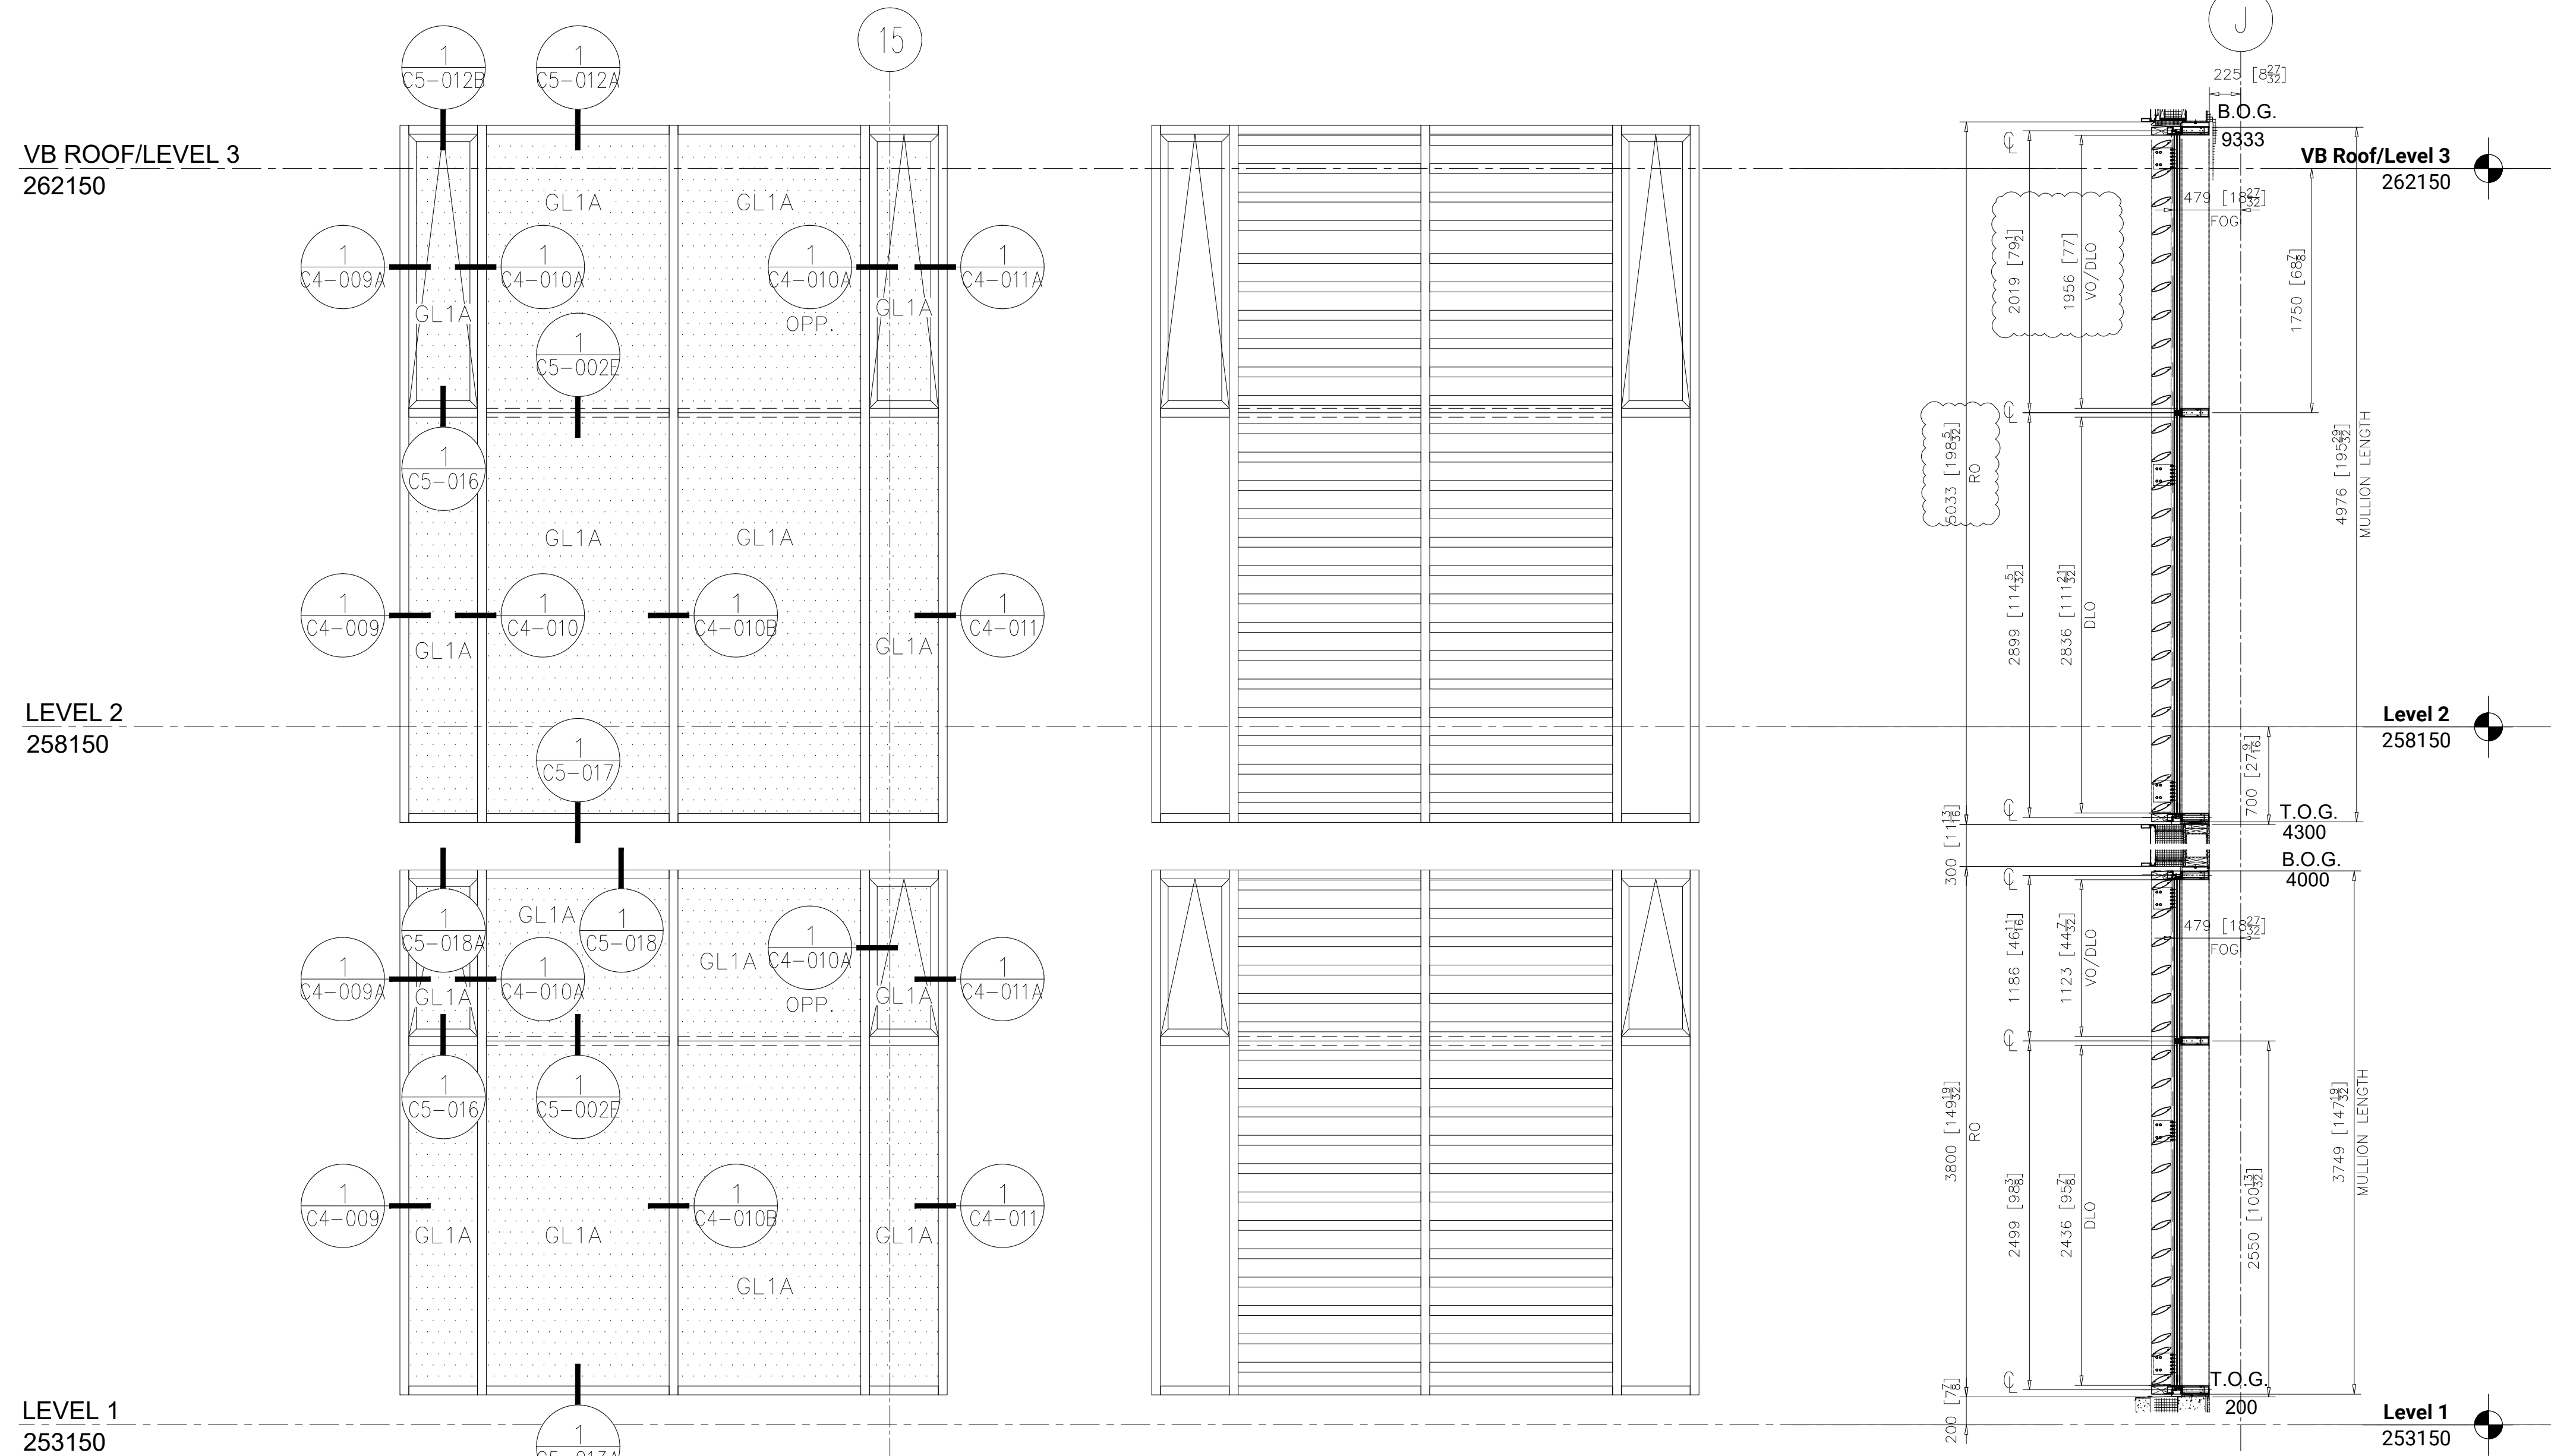

1 EG10A/11A
C3-016 PARTIAL ELEVATION
ARCH. REF.: 13/A052
QUANTITY:1

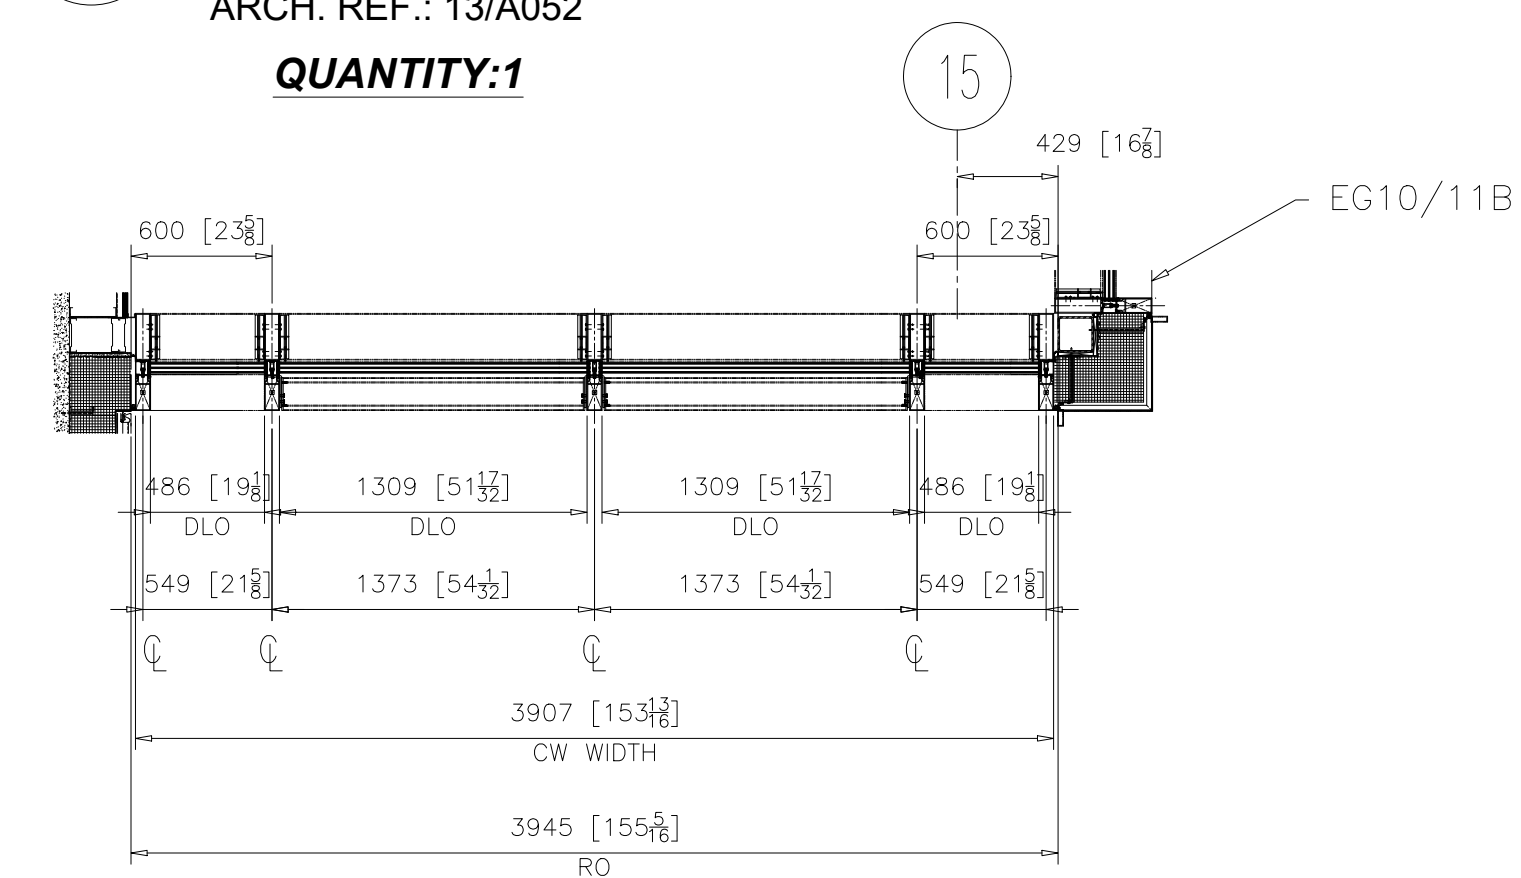


3 EG10/11A
C3-016 PARTIAL PLAN
ARCH. REF.: 1/A105/6

2 EG10/11A
C3-016 PARTIAL SECTION
ARCH. REF.: 1/A458

REVISIONS			
No.	Description:	Date:	By:
1	Revised per arch. markups received Feb 11/26	03/03/26	SLR


Project Name:	DOCKSTEADER PRPS
Project Location:	BRAMPTON, ONTARIO
Architect Name:	DIAMOND SCHMITT ARCHITECTS
Customer Name:	BOTHWELL ACCURATE GLAZING

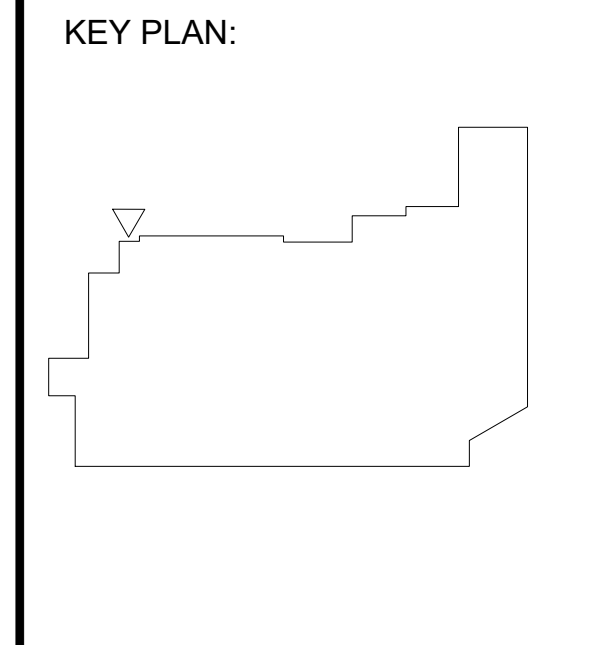




275 Britannia Road East • Mississauga
Ontario • Canada • L4Z2E7
905-890-6970 • oldcastlebe.com

Drawing Name:	
EG10/11A	
Drawn By:	Checked By:
SR	NP
Drawn Date:	Issue No.:
2026/01/12	1
Scale:	Release Date:
NTS	2026/03/03
Drawing Number:	C3-016

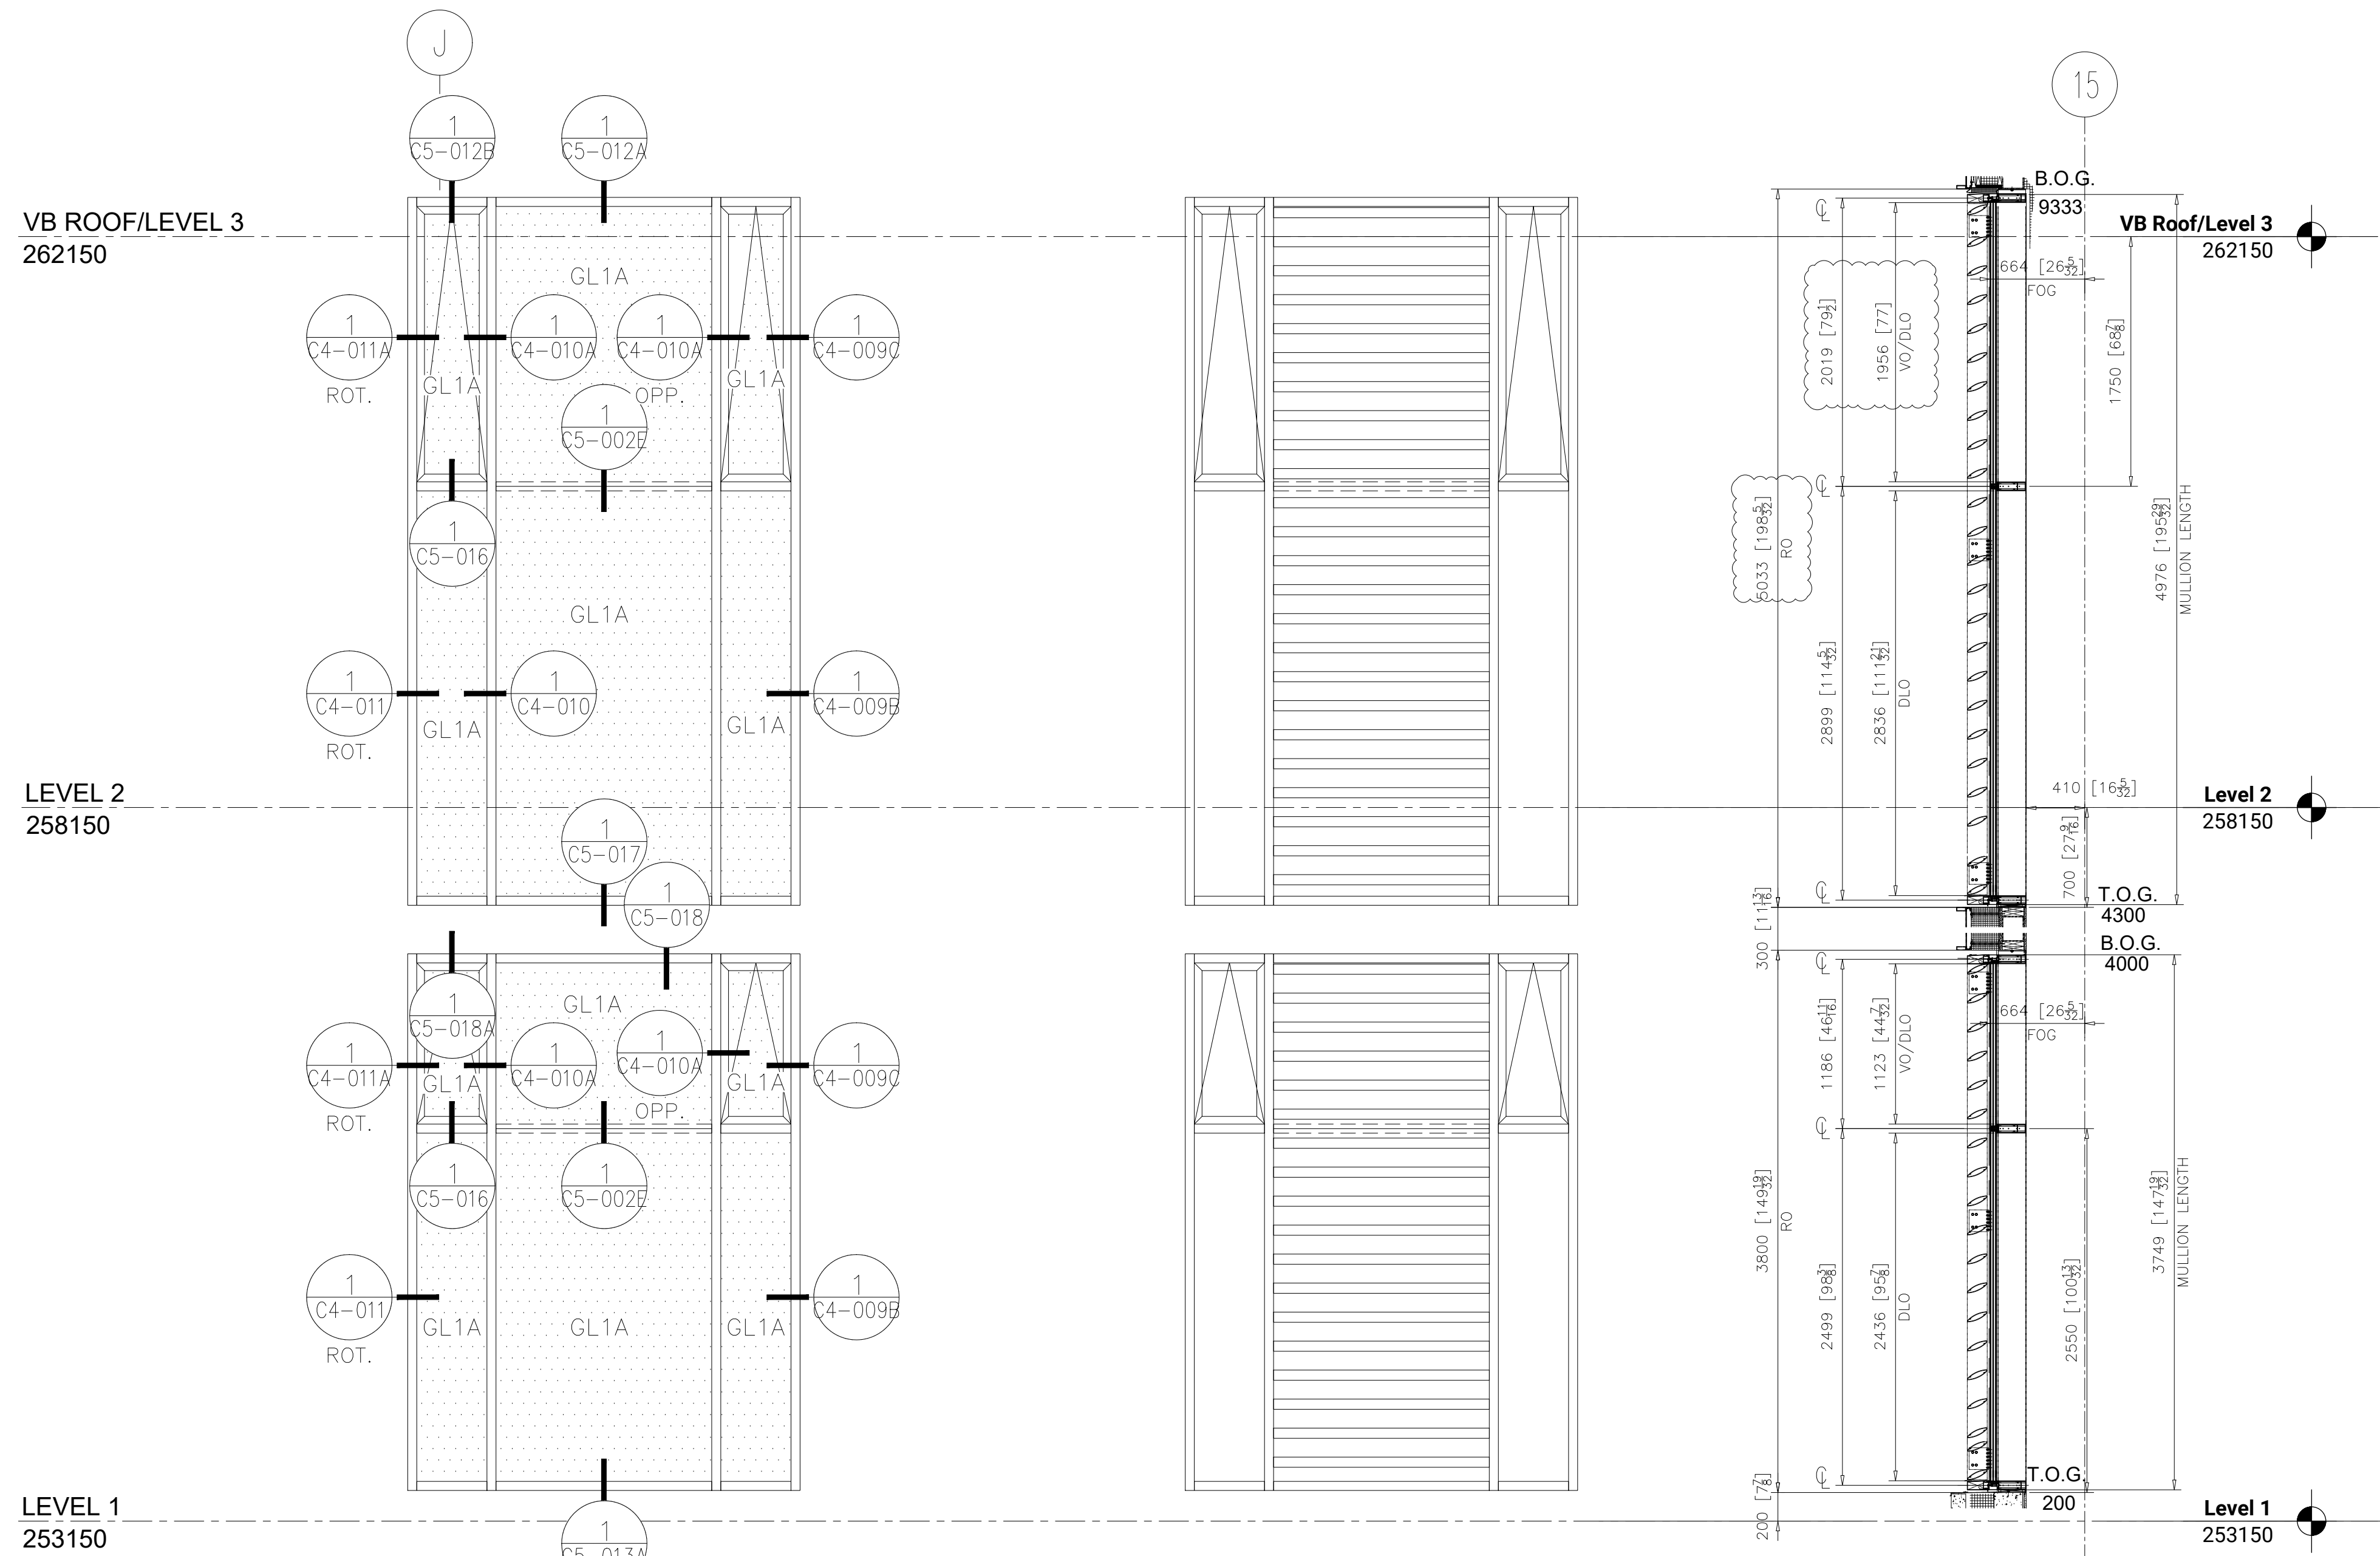

1 EG10B/11B
PARTIAL ELEVATION
ARCH. REF.: 13/A052
QUANTITY:1

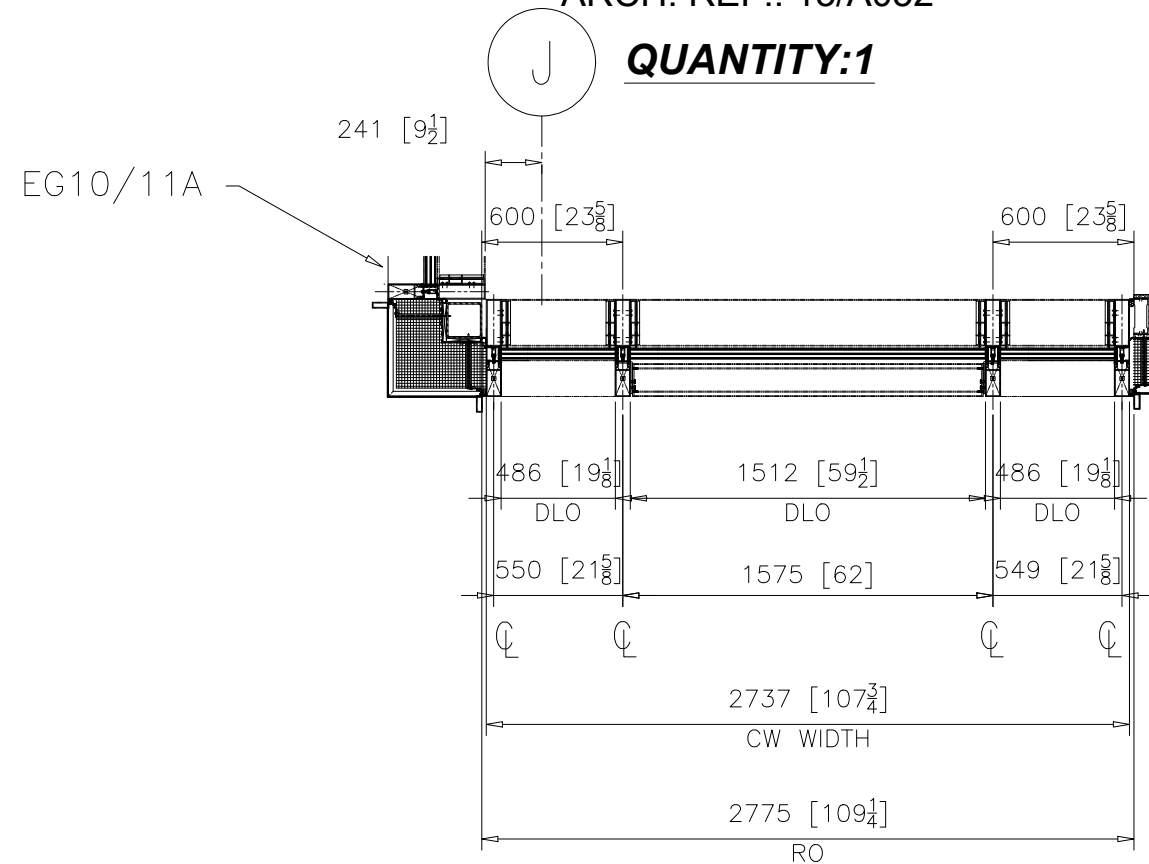


3 EG10/11B
PARTIAL PLAN
ARCH. REF.: 1/A105/6

2 EG10/11B
PARTIAL SECTION
ARCH. REF.: 1/A458

REVISIONS			
No.	Description:	Date:	By:
1	Revised per arch. markups received Feb 11/26	03/03/26	SLR

Project Name:	DOCKSTEADER PRPS
Project Location:	BRAMPTON, ONTARIO
Architect Name:	DIAMOND SCHMITT ARCHITECTS
Customer Name:	BOTHWELL ACCURATE GLAZING

KEY PLAN:

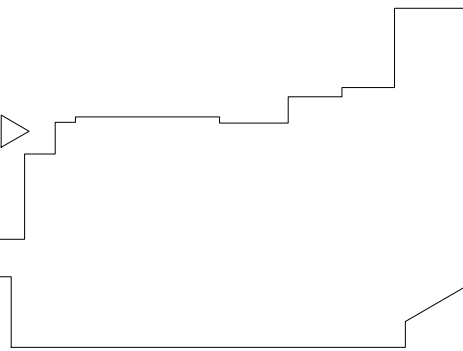



275 Britannia Road East • Mississauga
Ontario • Canada • L4Z2E7
905-890-6970 • oldcastlebe.com

Drawing Name: EG10/11B	
Drawn By: SR	Checked By: NP
Drawn Date: 2026/01/12	Issue No.: 1
Scale: NTS	Release Date: 2026/03/03
Drawing Number: C3-017	