



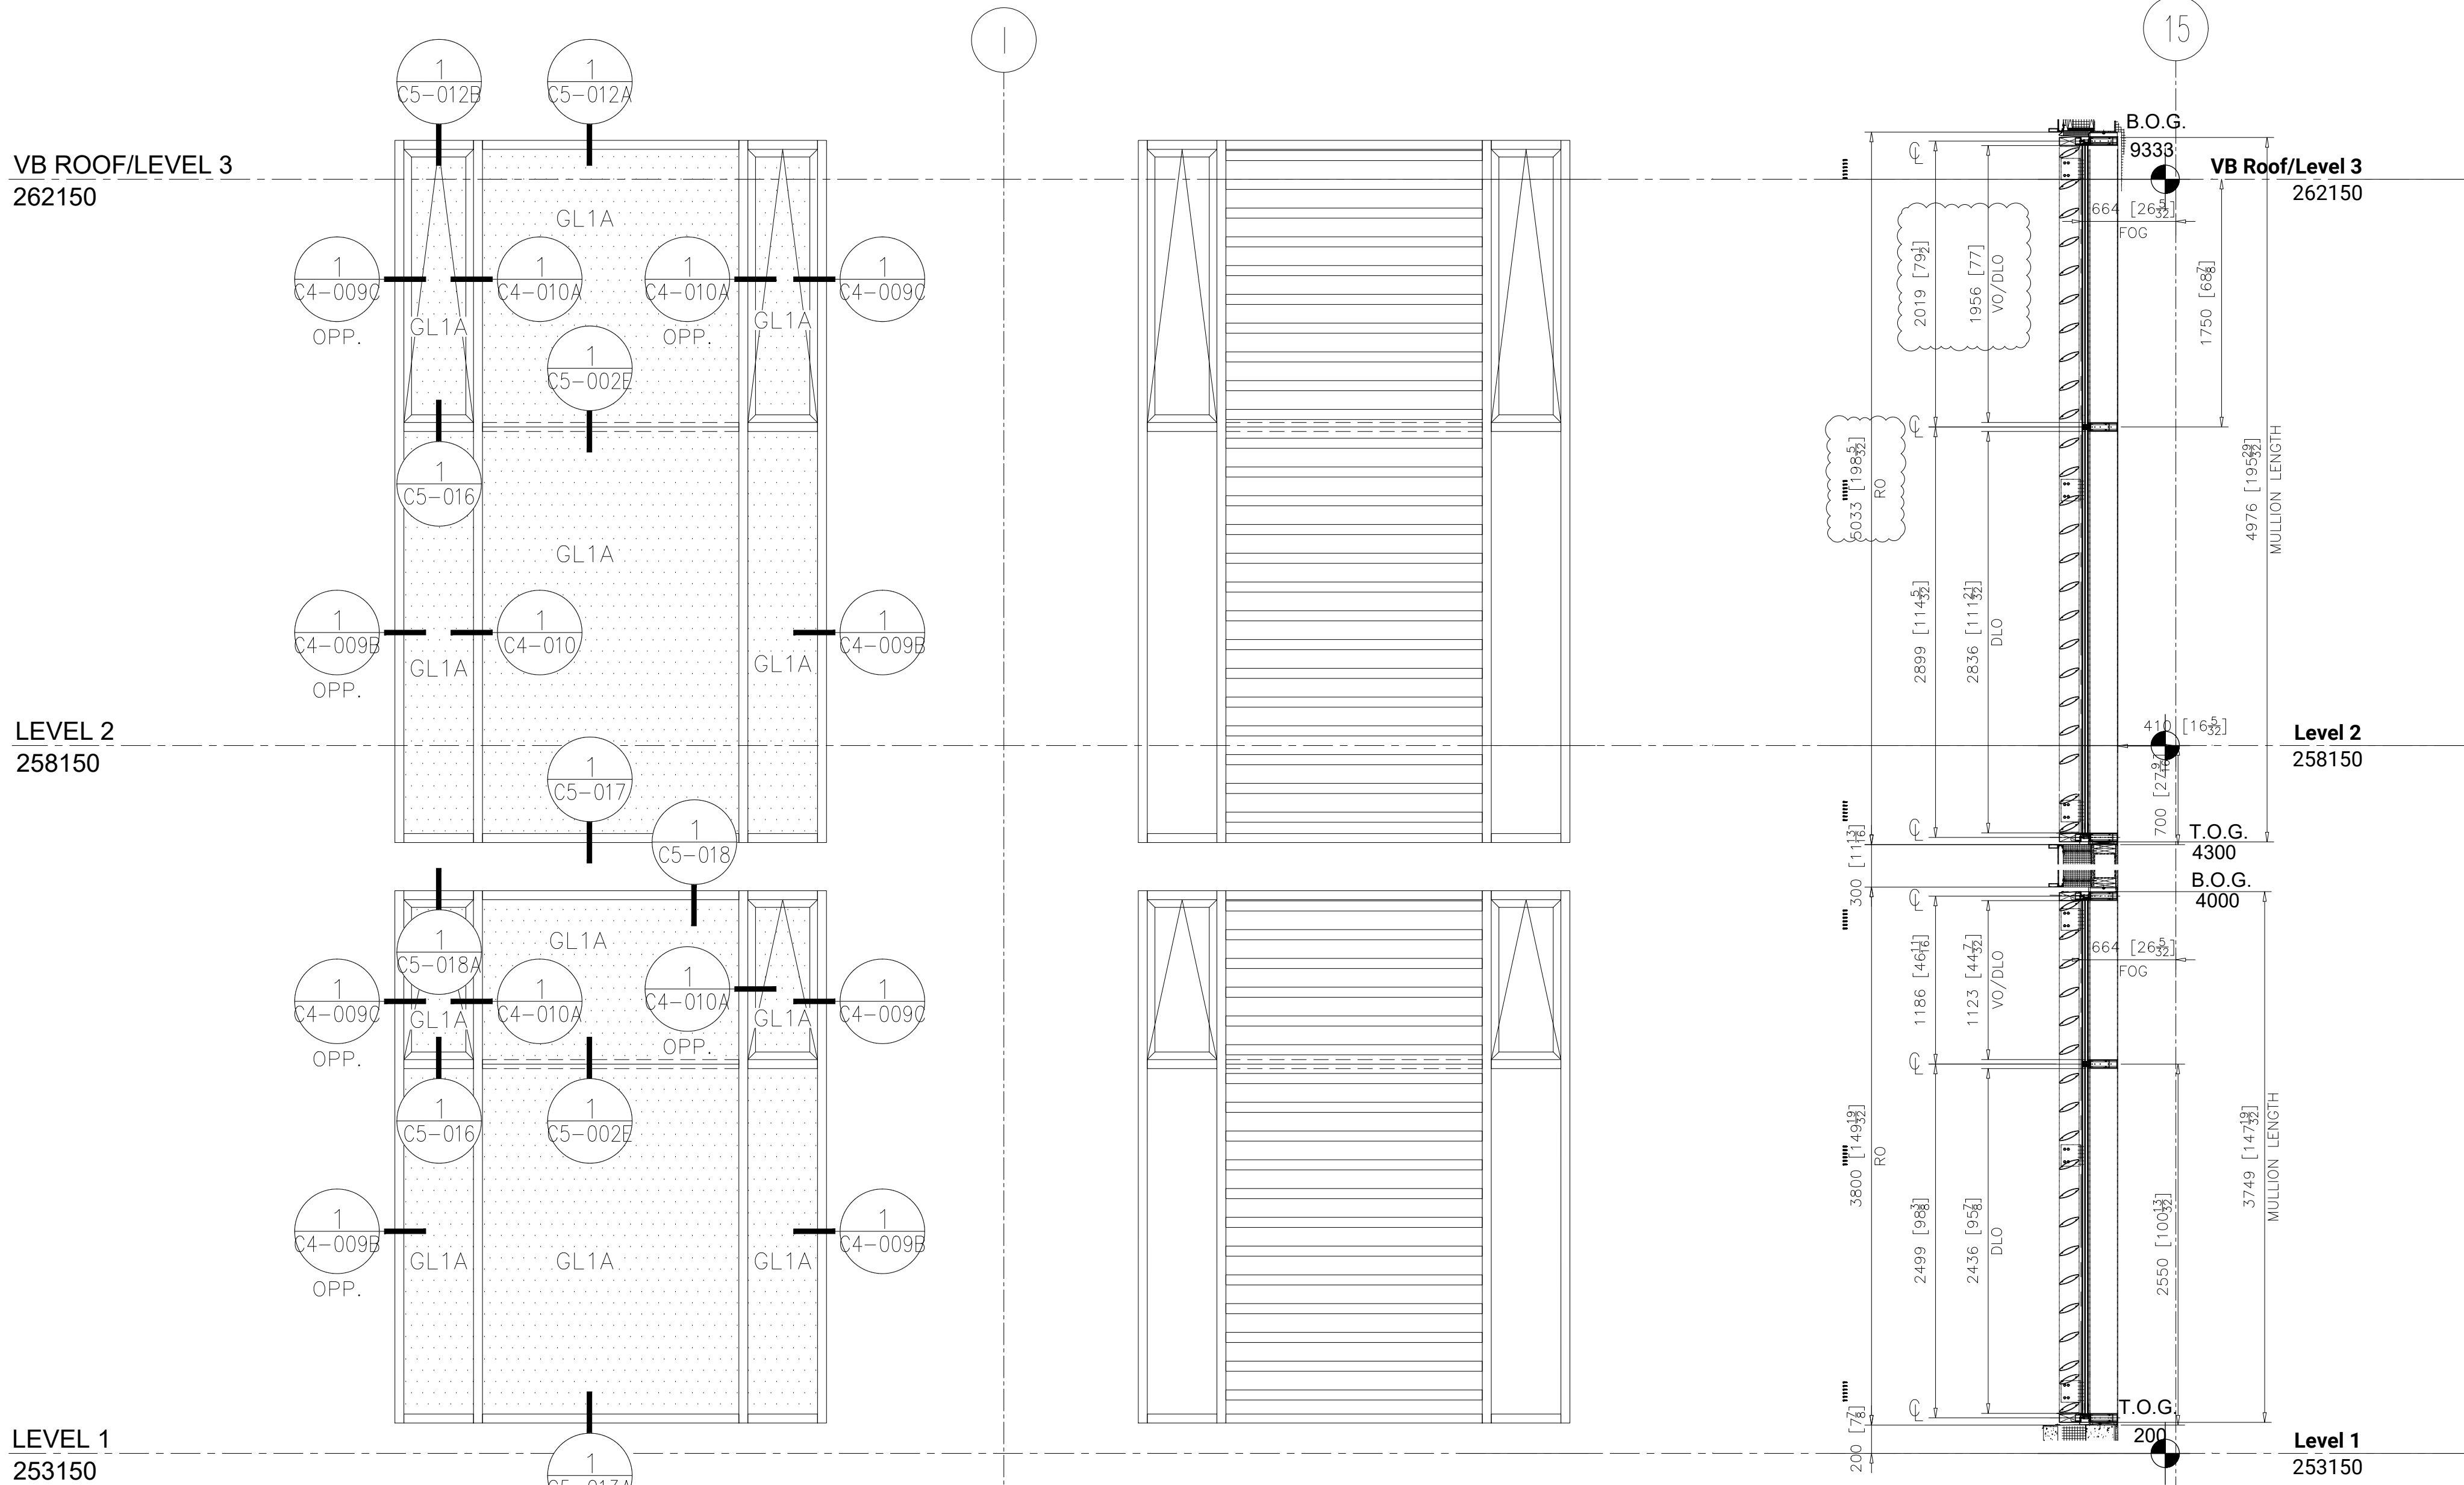

1 EG10C/11C
C3-018 PARTIAL ELEVATION
ARCH. REF.: 13/A052
QUANTITY:1

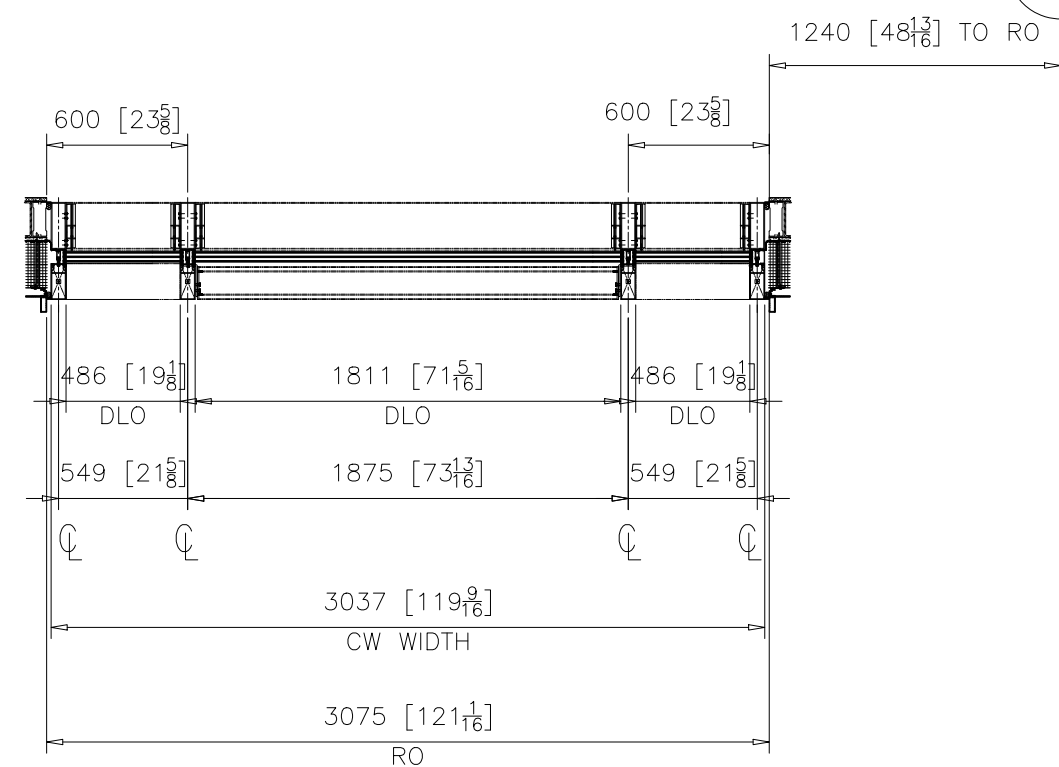


3 EG10/11C
C3-018 PARTIAL PLAN
ARCH. REF.: 1/A105/6

2 EG10/11C
C3-018 PARTIAL SECTION
ARCH. REF.: 1/A458

REVISIONS			
No.	Description:	Date:	By:
1	Revised per arch. markups received Feb 11/26	03/03/26	SLR

Project Name:	DOCKSTEADER PRPS
Project Location:	BRAMPTON, ONTARIO
Architect Name:	DIAMOND SCHMITT ARCHITECTS
Customer Name:	BOTHWELL ACCURATE GLAZING


KEY PLAN:

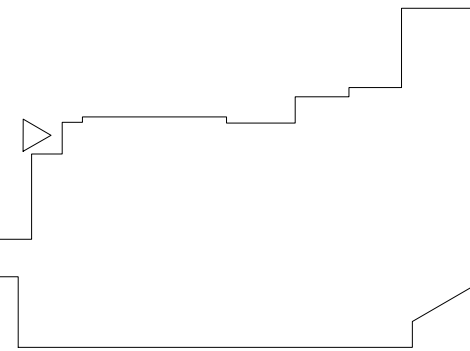

275 Britannia Road East • Mississauga
Ontario • Canada • L4Z2E7
905-890-6970 • oldcastlebe.com

Drawing Name:	
EG10/11C	
Drawn By:	Checked By:
SR	NP
Drawn Date:	Issue No.:
2026/01/12	1
Scale:	Release Date:
NTS	2026/03/03
Drawing Number:	C3-018


C3-019

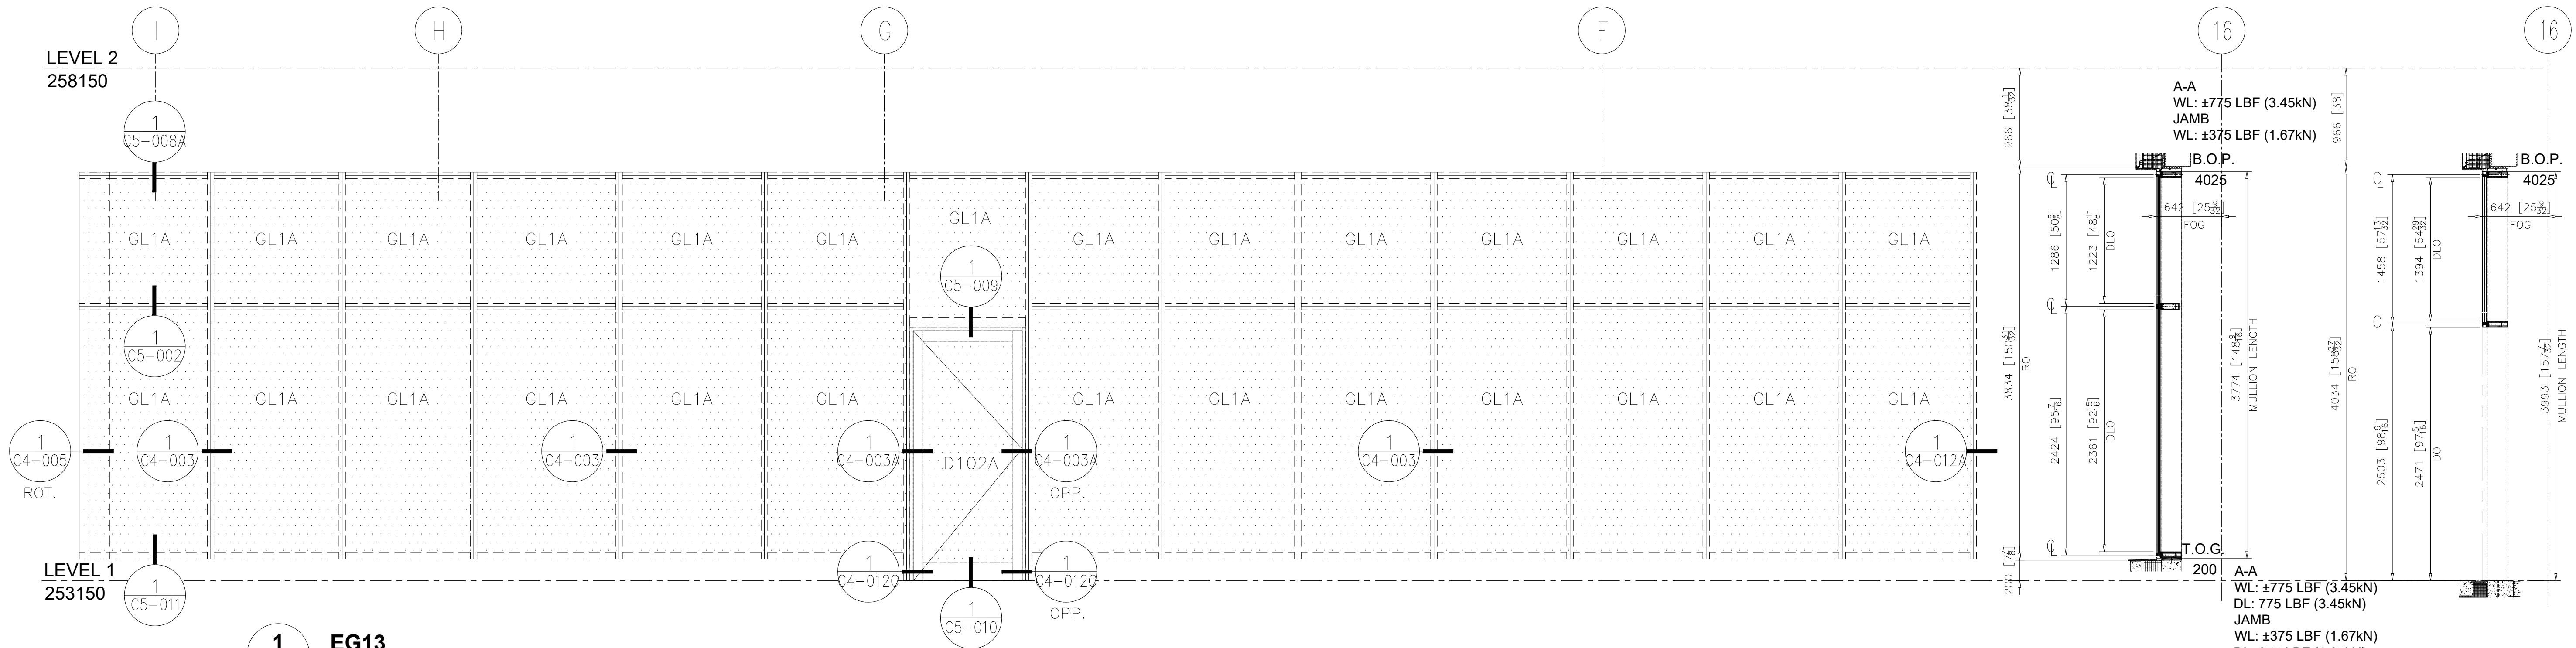

1
C3-020 **EG13**
PARTIAL ELEVATION
ARCH. REF.: 12/A052
QUANTITY:1

2
C3-020 **EG13**
PARTIAL SECTION
ARCH. REF.: 1/A457

3
C3-020 **EG13**
PARTIAL SECTION
ARCH. REF.: 1/A457 SIM

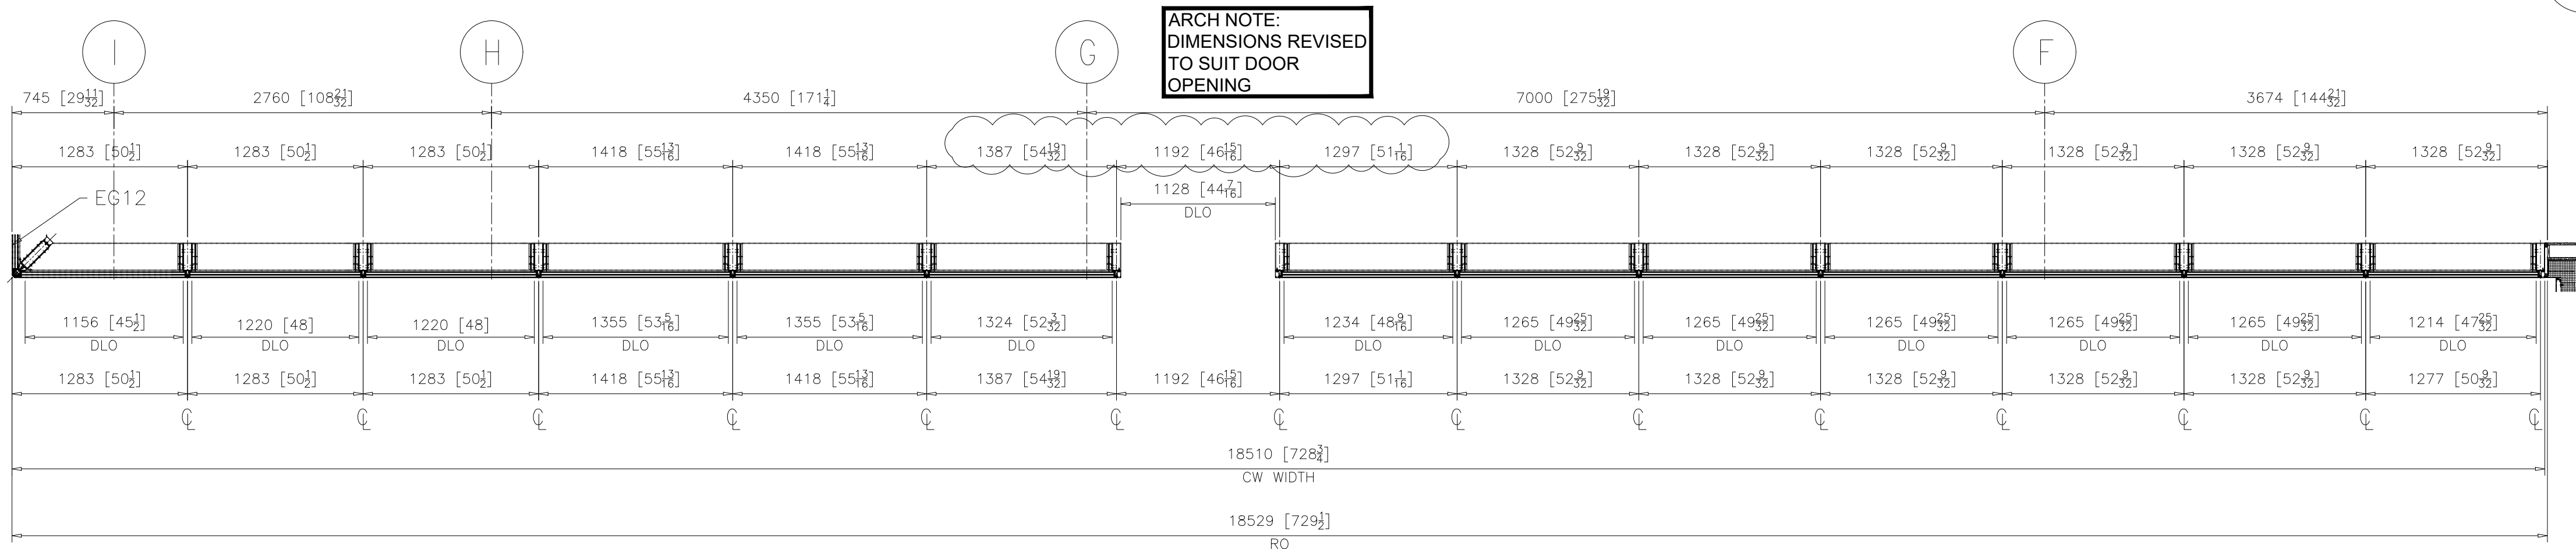


4
C3-020 **EG13**
PARTIAL PLAN
ARCH. REF.: 1/A105

REVISIONS			
No.	Description:	Date:	By:
1	Revised per arch. markups received Feb 11/26	03/03/26	SLR

Project Name: DOCKSTEADER PRPS	Project Location: BRAMPTON, ONTARIO	Architect Name: DIAMOND SCHMITT ARCHITECTS	Customer Name: BOTHWELL ACCURATE GLAZING
-----------------------------------	--	---	---

KEY PLAN:


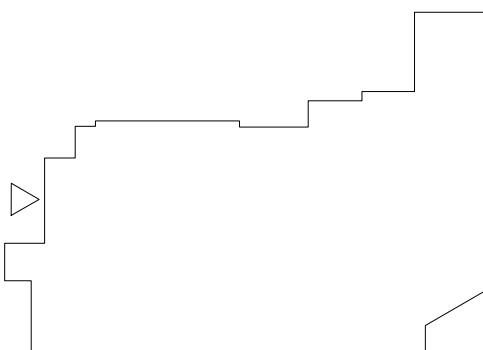


275 Britannia Road East • Mississauga
Ontario • Canada • L4Z2E7
905-890-6970 • oldcastlebc.com

Drawing Name: EG13	
Drawn By: SR	Checked By: NP
Drawn Date: 2026/01/12	Issue No.: 1
Scale: NTS	Release Date: 2026/03/03
Drawing Number: C3-020	

LEVEL 2
258150


LEVEL 1
253150

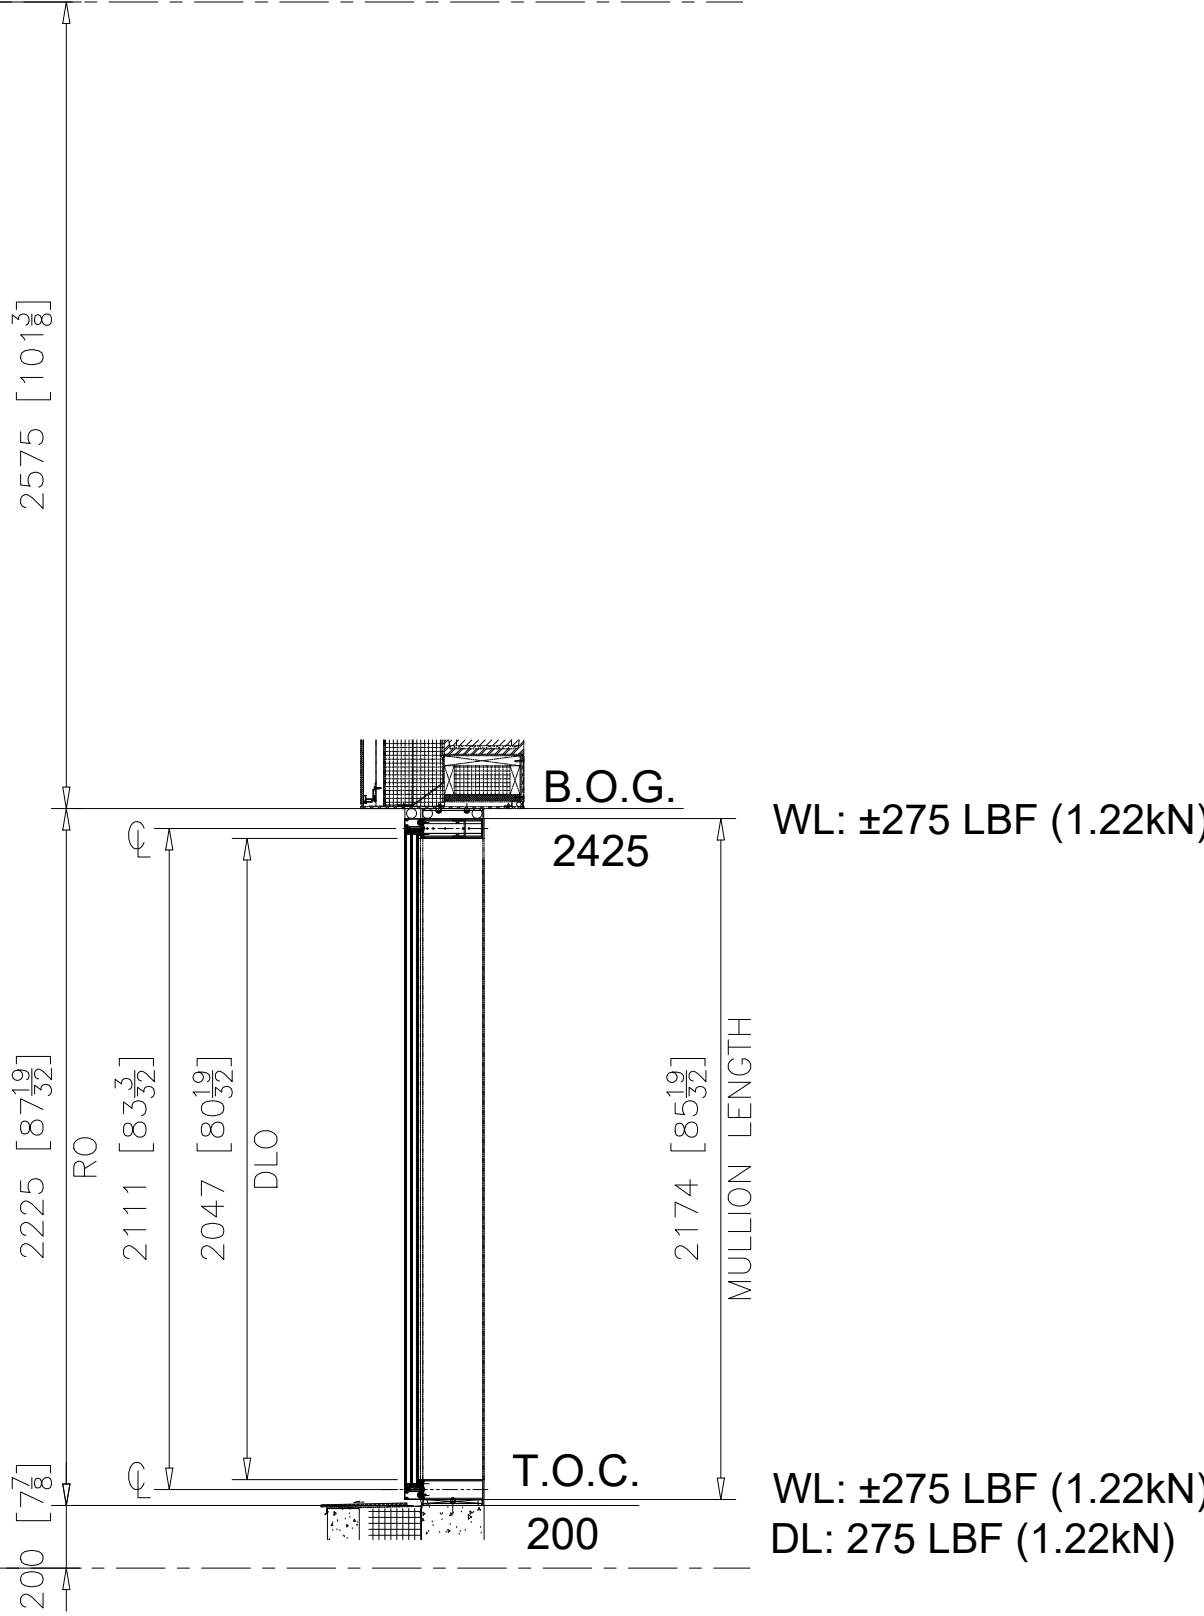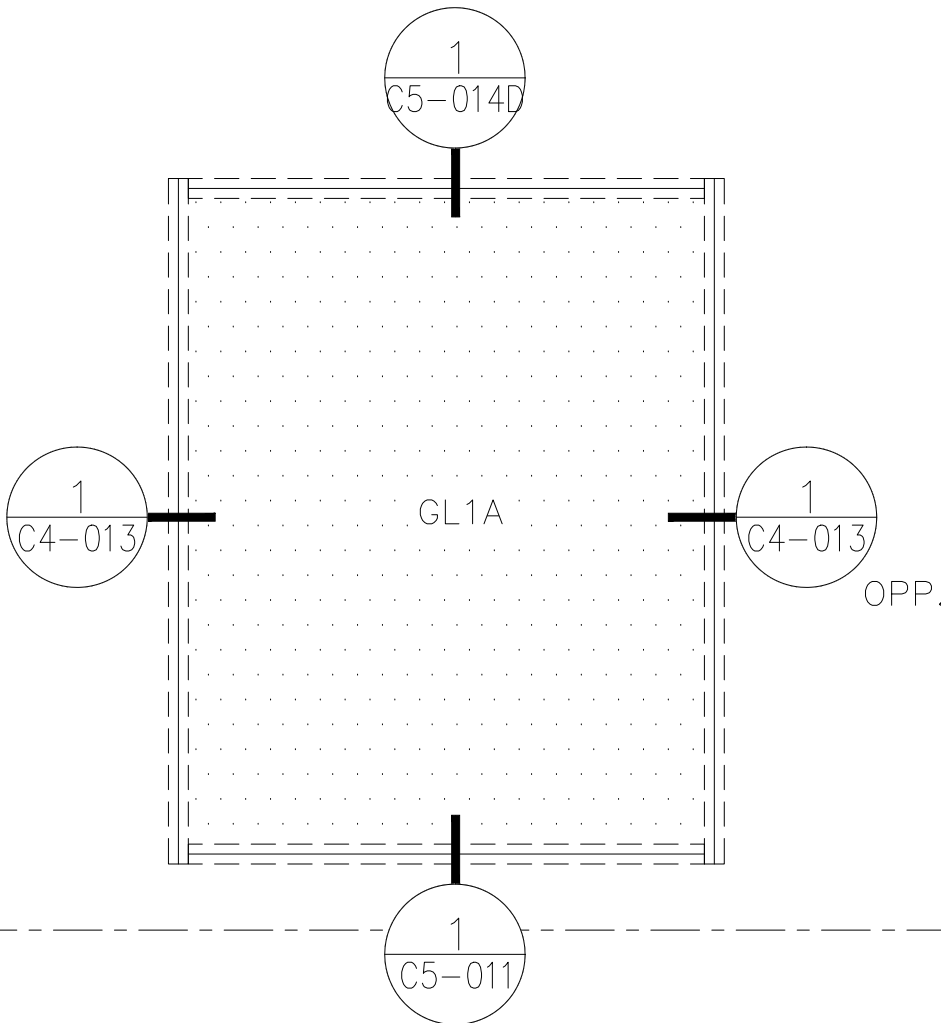

1
C3-021 **EG14**
PARTIAL ELEVATION
ARCH. REF.: 10/A052

2
C3-021 **EG14**
PARTIAL SECTION
ARCH. REF.: N/A

QUANTITY:2

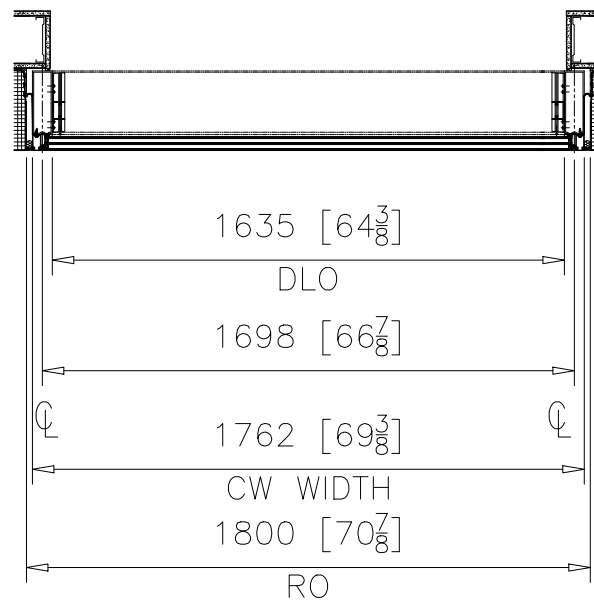


3
C3-021 **EG14**
PARTIAL PLAN
ARCH. REF.: 1/A105

REVISIONS			
No.	Description:	Date:	By:
1	Revised per arch. markups received Feb 11/26	03/03/26	SLR

Project Name: DOCKSTEADER PRPS	Project Location: BRAMPTON, ONTARIO	Architect Name: DIAMOND SCHMITT ARCHITECTS	Customer Name: BOTHWELL ACCURATE GLAZING
-----------------------------------	--	---	---


KEY PLAN:

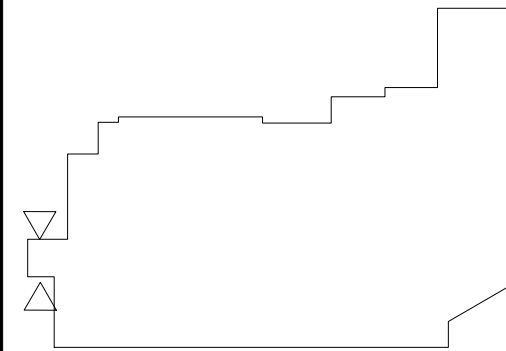



275 Britannia Road East • Mississauga
Ontario • Canada • L4Z2E7
905-890-6970 • oldcastlebe.com

Drawing Name:
EG14

Drawn By: SR	Checked By: NP
Drawn Date: 2026/01/12	Issue No.: 1
Scale: NTS	Release Date: 2026/03/03
Drawing Number: C3-021	

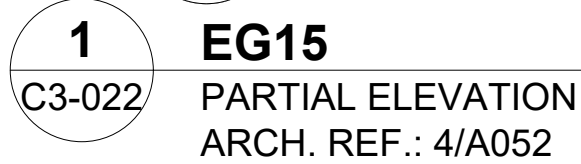[illegible]

3
C3-022

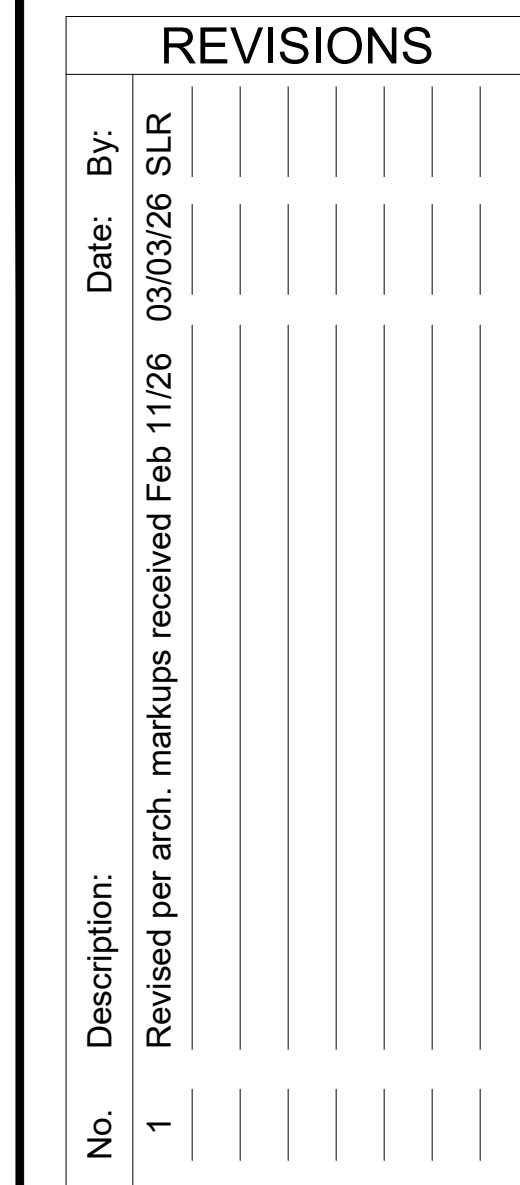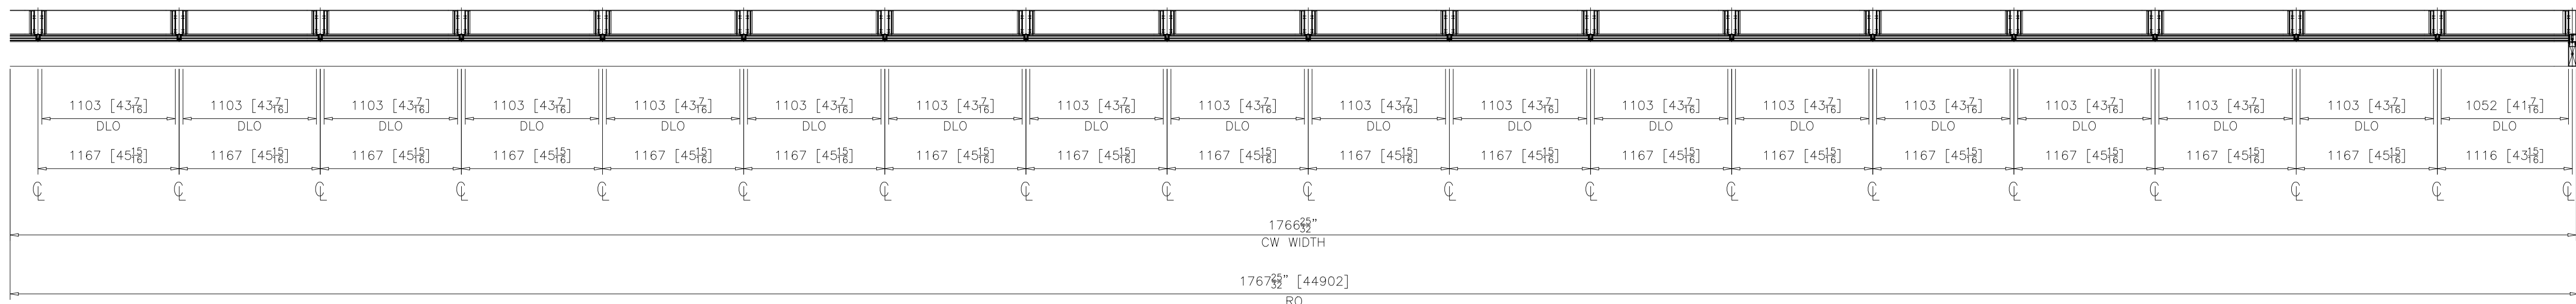


Project Name:

Project Location:

Architect Name:

Customer Name:

KEY PLAN:

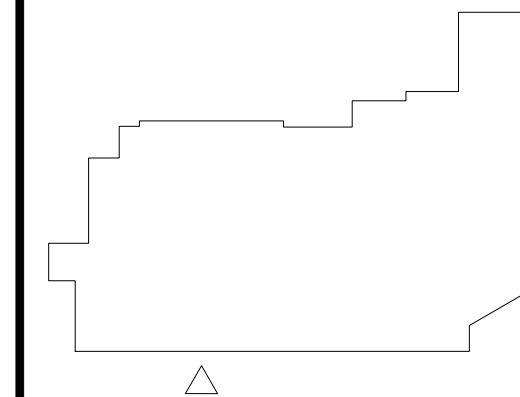

275 Britannia Road East • Mississauga
Ontario • Canada • L4Z2E7
905-890-6970 • oldcastlebe.com

Drawing Name:

EG15

Drawn By:

Checked By:

SR
Drawn Date:




Issue No. :

Scale:

1	Release Date
---	--------------

NTS

er: C3-022

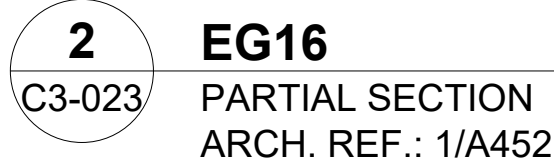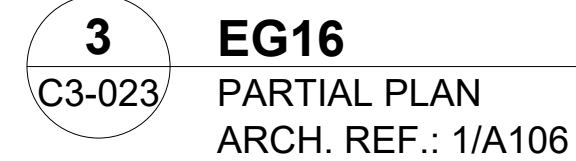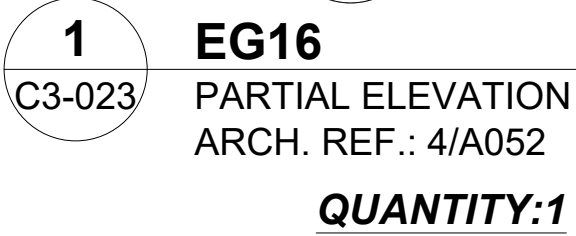

Project Name:	DOCKSTEADER PRPS
Project Location:	BRAMPTON, ONTARIO
Architect Name:	DIAMOND SCHMITT ARCHITECTS
Customer Name:	BOTHWELL ACCURATE GLAZING



Oldcastle
BuildingEnvelope®

275 Britannia Road East • Mississauga
Ontario • Canada • L4Z2E7
905-890-8970 • oldcastlebe.com


Drawing Name: EG16	
Drawn By: SR	Checked By: NP
Drawn Date: 2026/01/12	Issue No.: 1
Scale: NTS	Release Date: 2026/03/03
Drawing Number: C3-023	

REVISIONS

No.	Description:	Date:	By:
1	Revised per arch. markups received Feb 11/26	03/03/26	SLR

Project Name:	DOCKSTEADER PRPS
Project Location:	BRAMPTON, ONTARIO
Architect Name:	DIAMOND SCHMITT ARCHITECTS
Customer Name:	BOTHWELL ACCURATE GLAZING

KEY PLAN:

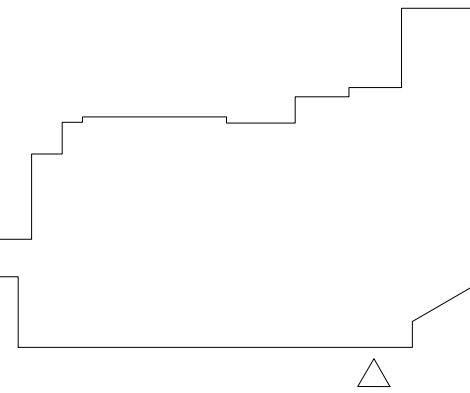

275 Britannia Road East • Mississauga
Ontario • Canada • L4Z2E7
905-890-6970 • oldcastlebe.com

Drawing Name:

EG17

Drawn By:

SR

Checked By:

NP

Drawn Date:

2026/01/12

Issue No.:

1

Scale:


NTS

Release Date:

2026/03/03


Drawing Number:

C3-024

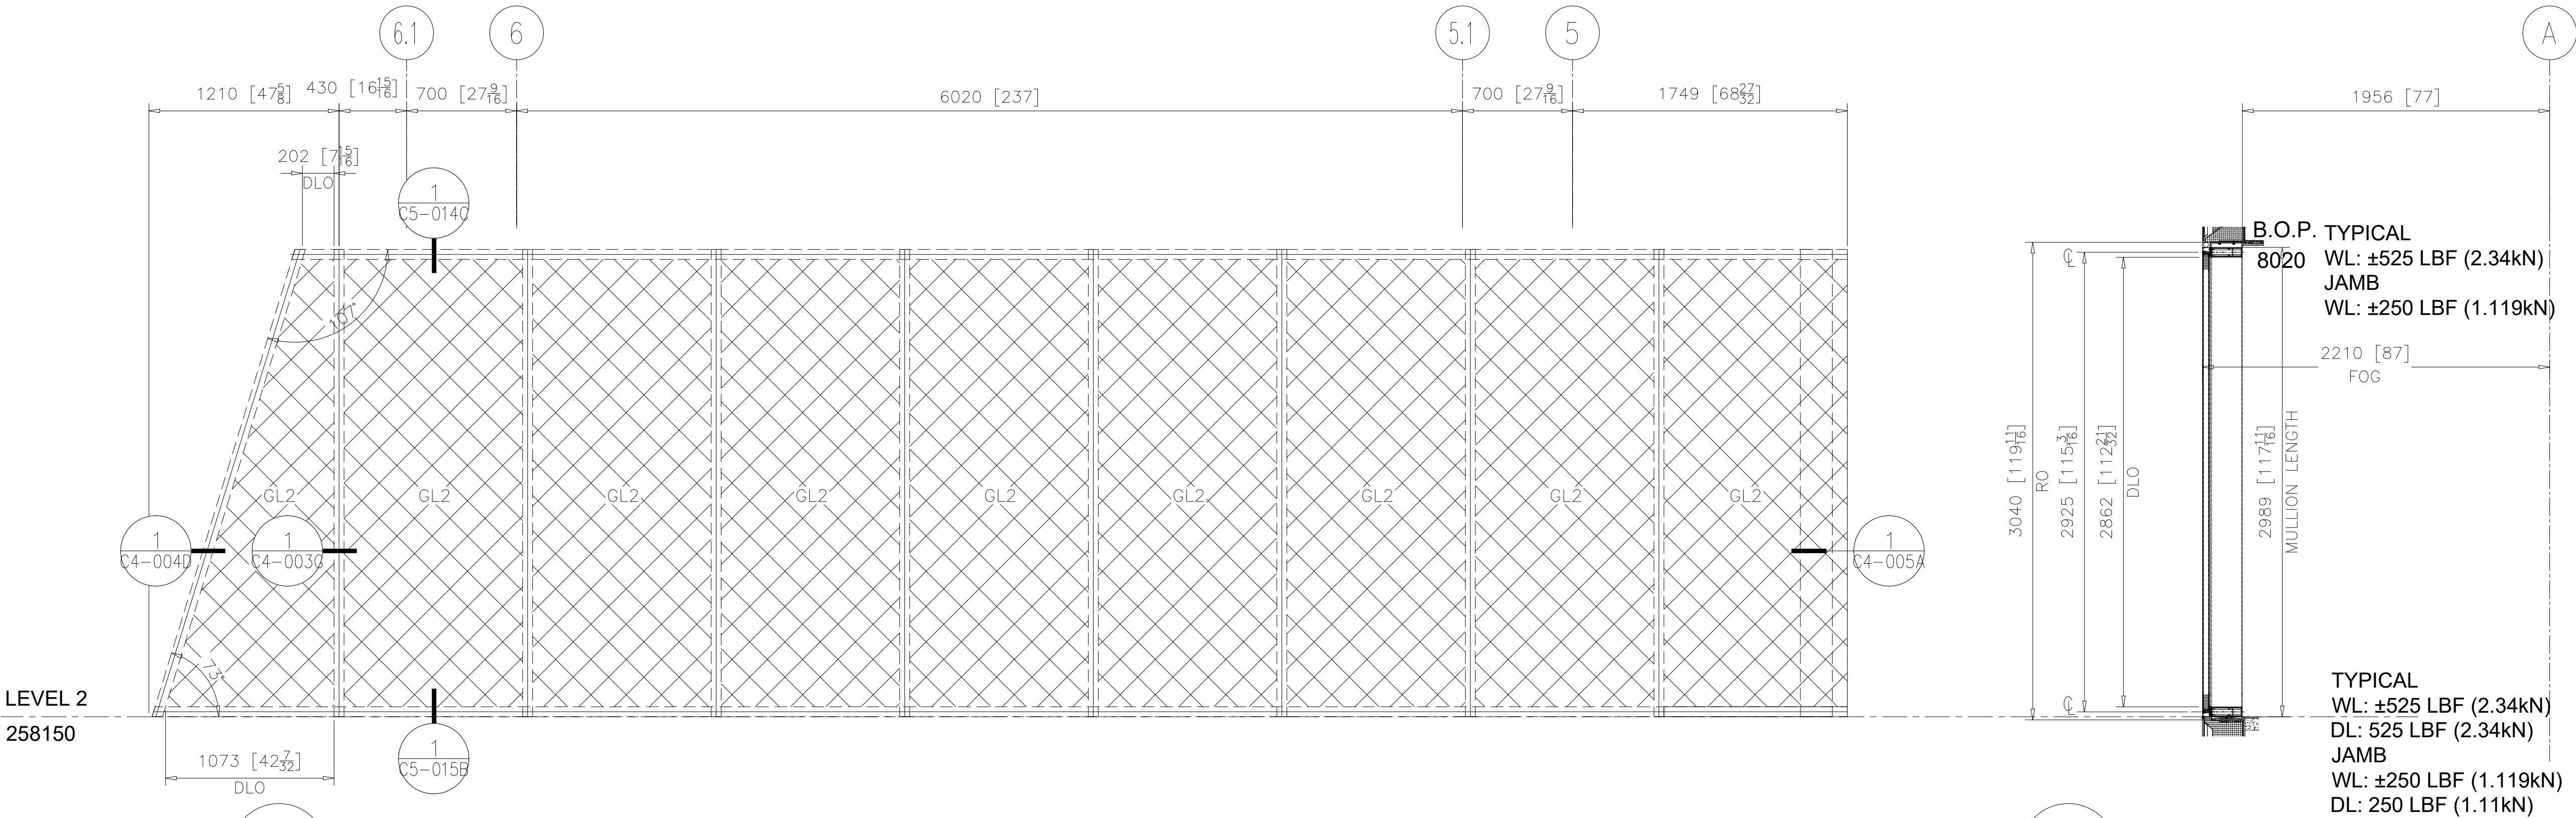


1 **EG17**
C3-024 PARTIAL ELEVATION
ARCH. REF.: 5/A052
QUANTITY:1

2 **EG17**
C3-024 PARTIAL SECTION
ARCH. REF.: 2/A453

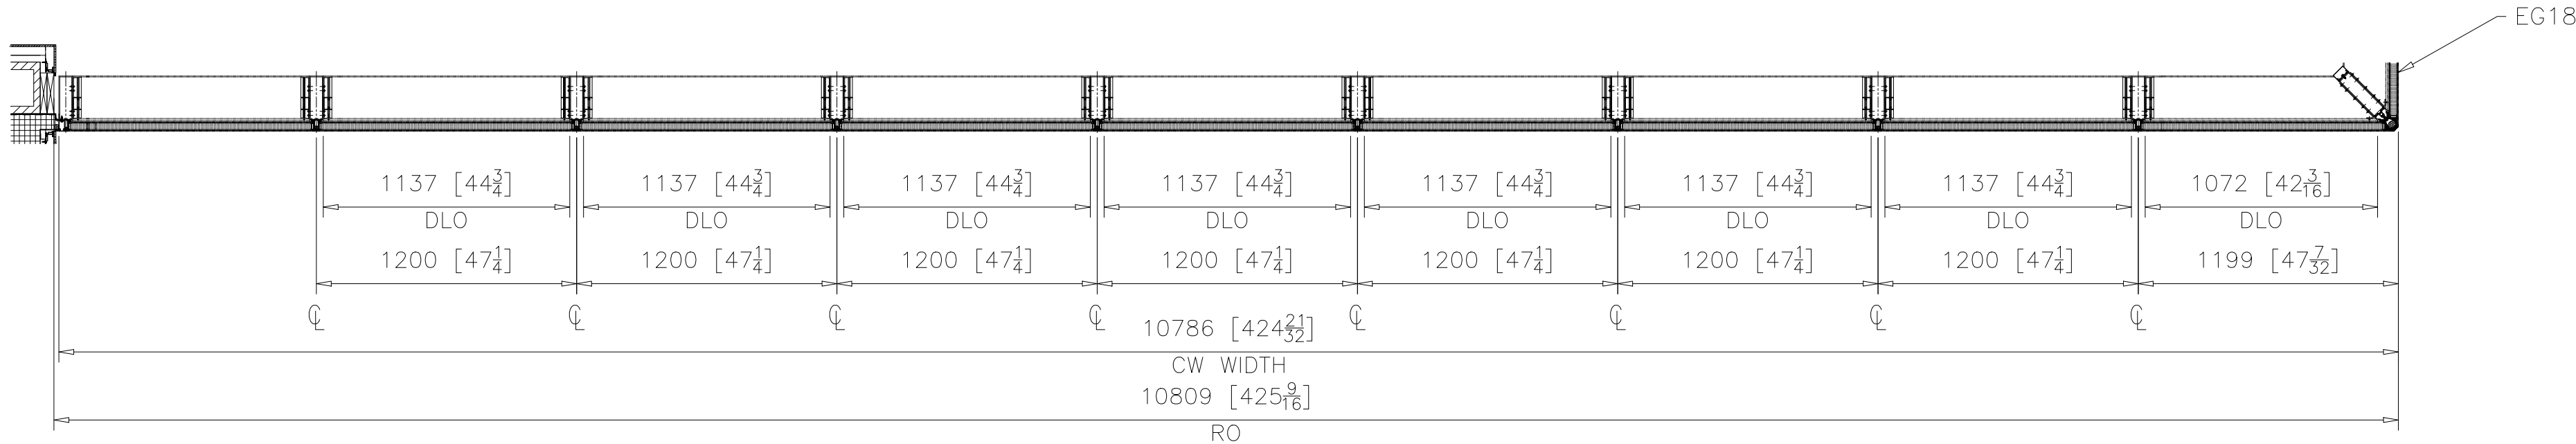


3 **EG17**
C3-024 PARTIAL PLAN
ARCH. REF.: 1/A106

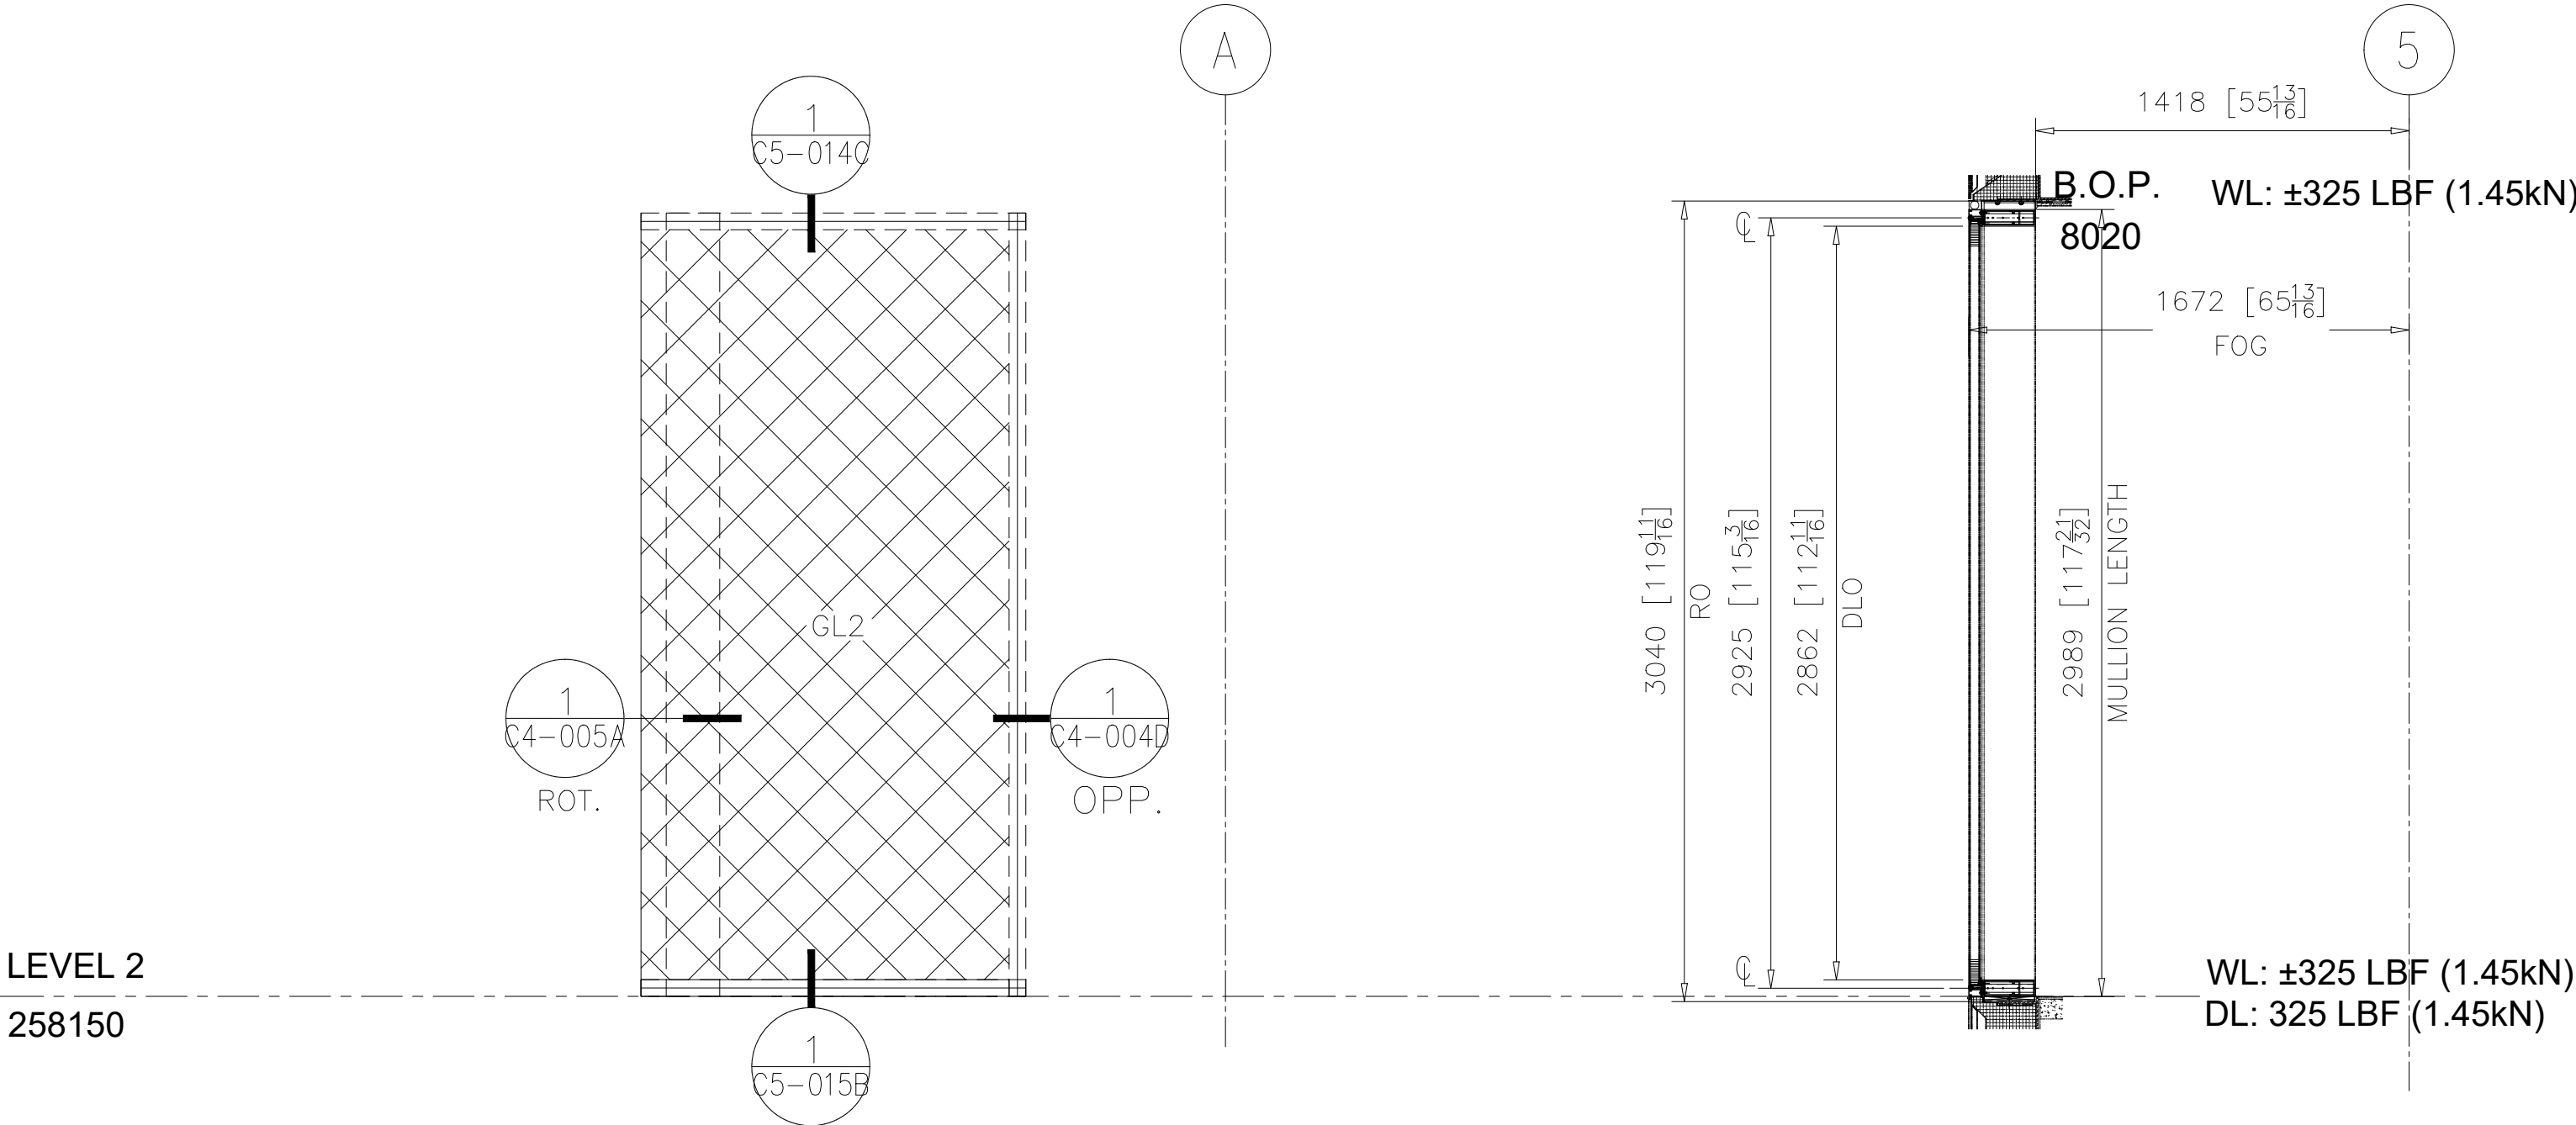

1
C3-025 **EG18**
PARTIAL ELEVATION
ARCH. REF.: 5/A052
QUANTITY:1


2
C3-025 **EG18**
PARTIAL SECTION
ARCH. REF.: 2/A453

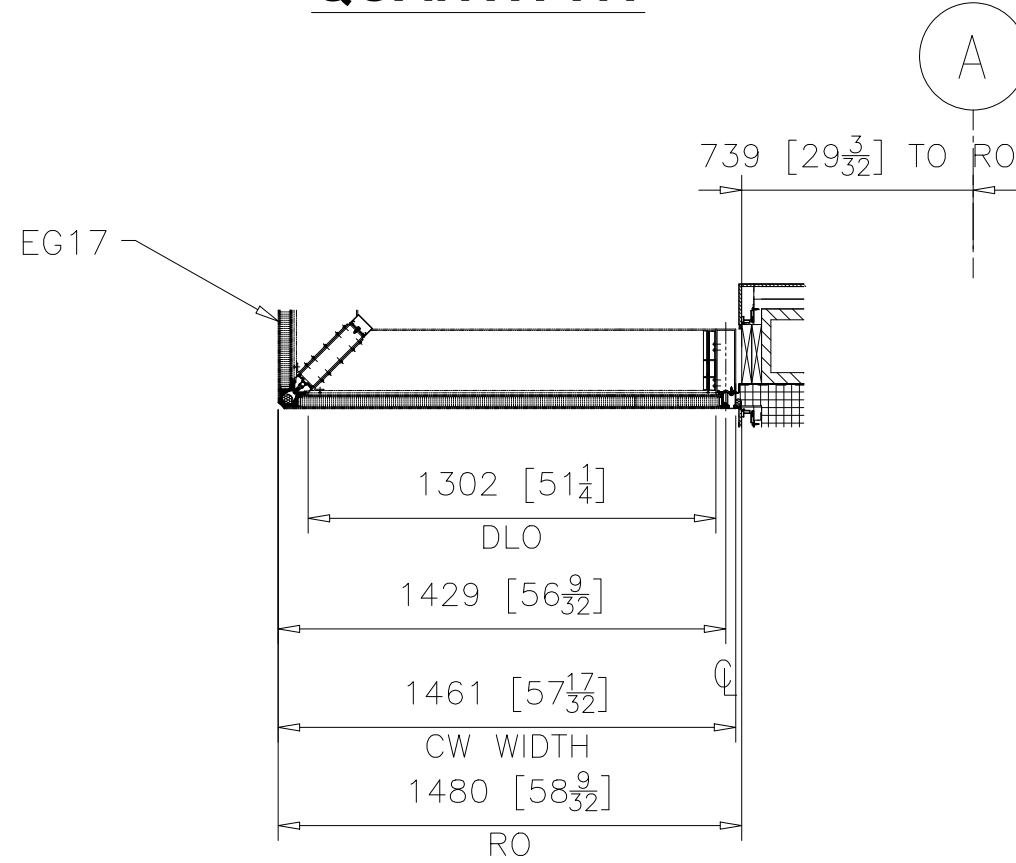

3
C3-025 **EG18**
PARTIAL PLAN
ARCH. REF.: 1/A106

REVISIONS			
No.	Description:	Date:	By:
1	Revised per arch. markups received Feb 11/26	03/03/26	SLR


Project Name:	DOCKSTEADER PRPS
Project Location:	BRAMPTON, ONTARIO
Architect Name:	DIAMOND SCHMITT ARCHITECTS
Customer Name:	BOTHWELL ACCURATE GLAZING

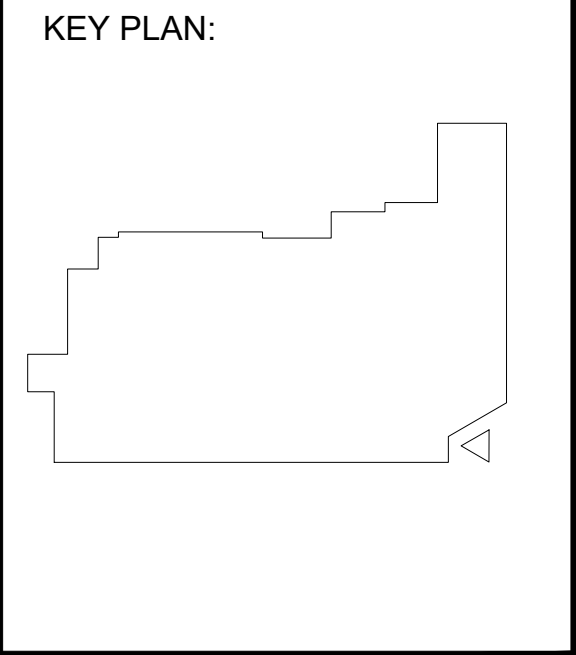




275 Britannia Road East • Mississauga
Ontario • Canada • L4Z2E7
905-890-6970 • oldcastlebe.com

Drawing Name:	
EG18	
Drawn By:	Checked By:
SR	NP
Drawn Date:	Issue No.:
2026/01/12	1
Scale:	Release Date:
NTS	2026/03/03
Drawing Number:	
C3-025	

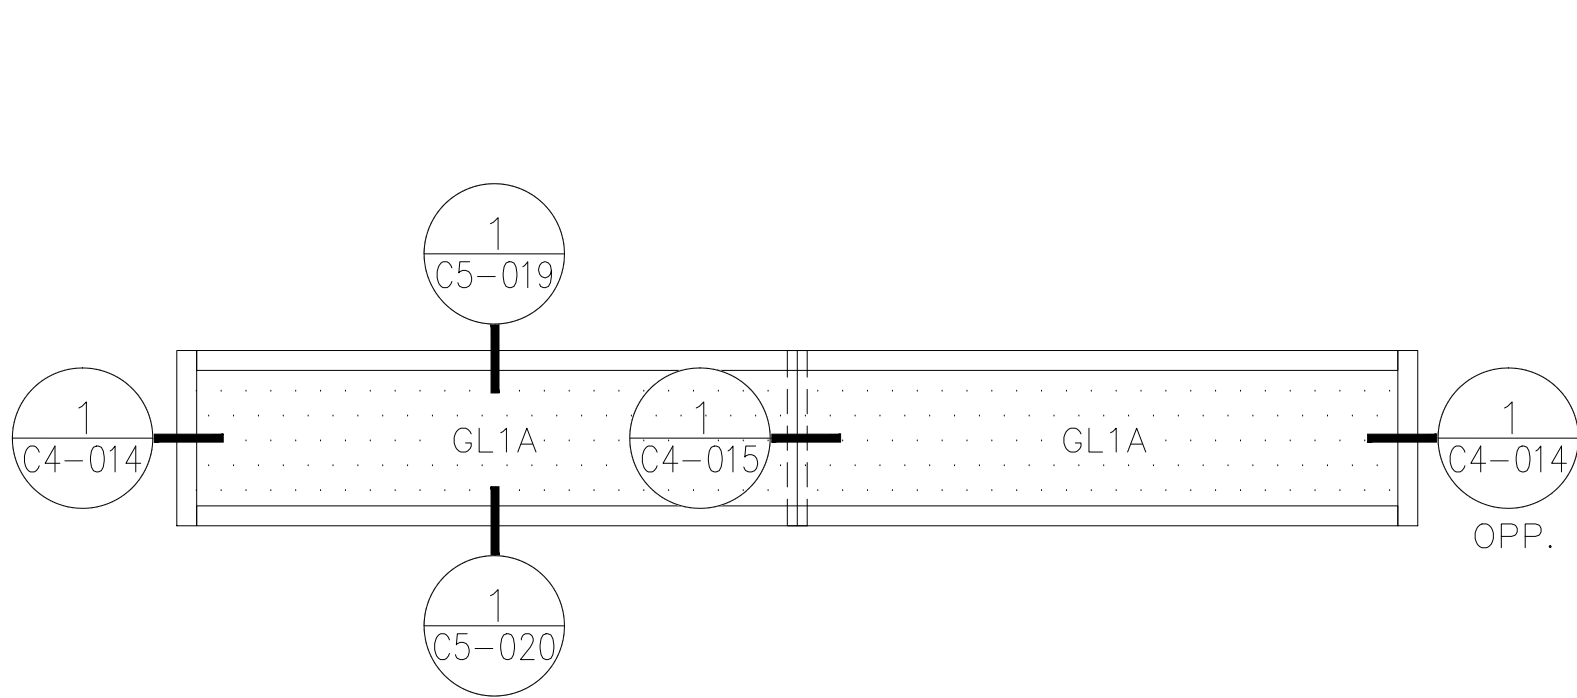


VB ROOF/LEVEL 3
262150

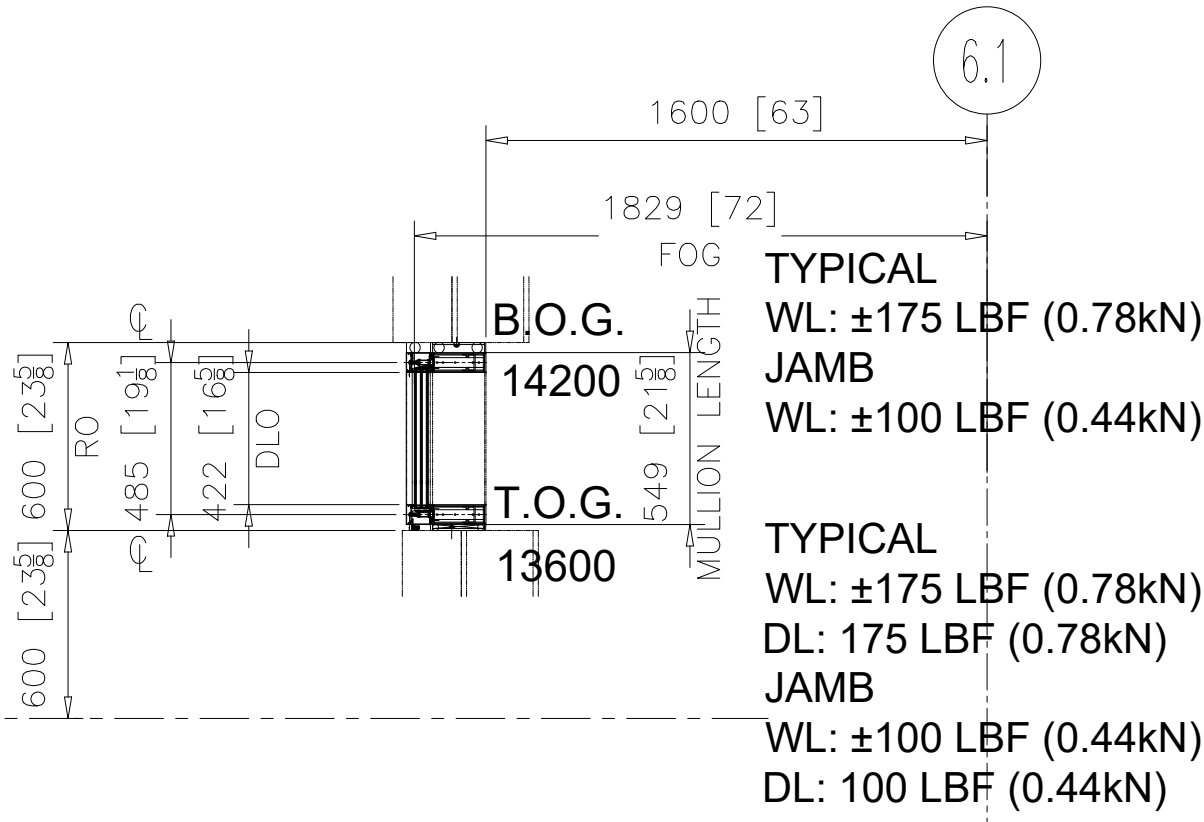

1 **EG19**
C3-026 PARTIAL ELEVATION
ARCH. REF.: 2/A052
QUANTITY:3

2 **EG19**
C3-026 PARTIAL SECTION
ARCH. REF.: 1/A459, 3/A553

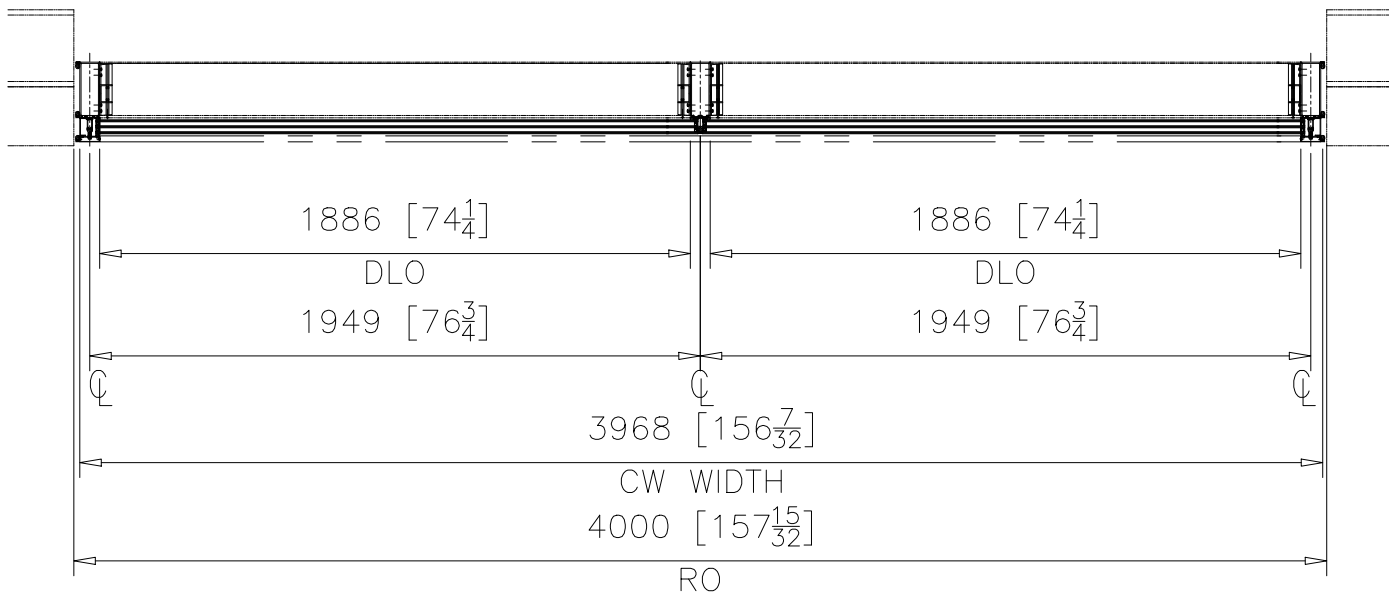


3 **EG19**
C3-026 PARTIAL PLAN
ARCH. REF.: 1/A107

REVISIONS			
No.	Description:	Date:	By:
1	Revised per arch. markups received Feb 11/26	03/03/26	SLR

Project Name:	DOCKSTEADER PRPS
Project Location:	BRAMPTON, ONTARIO
Architect Name:	DIAMOND SCHMITT ARCHITECTS
Customer Name:	BOTHWELL ACCURATE GLAZING

KEY PLAN:


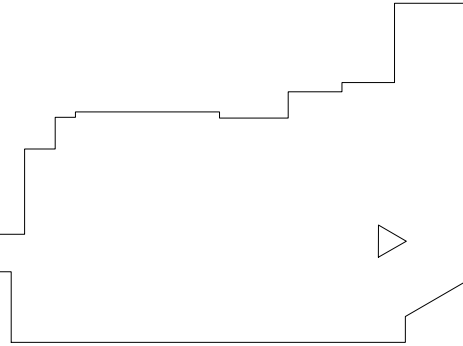


275 Britannia Road East • Mississauga
Ontario • Canada • L4Z2E7
905-890-6970 • oldcastlebe.com

Drawing Name:
EG19


Drawn By:	Checked By:
SR	NP
Drawn Date:	Issue No.:
2026/01/12	1
Scale:	Release Date:
NTS	2026/03/03
Drawing Number:	

C3-026

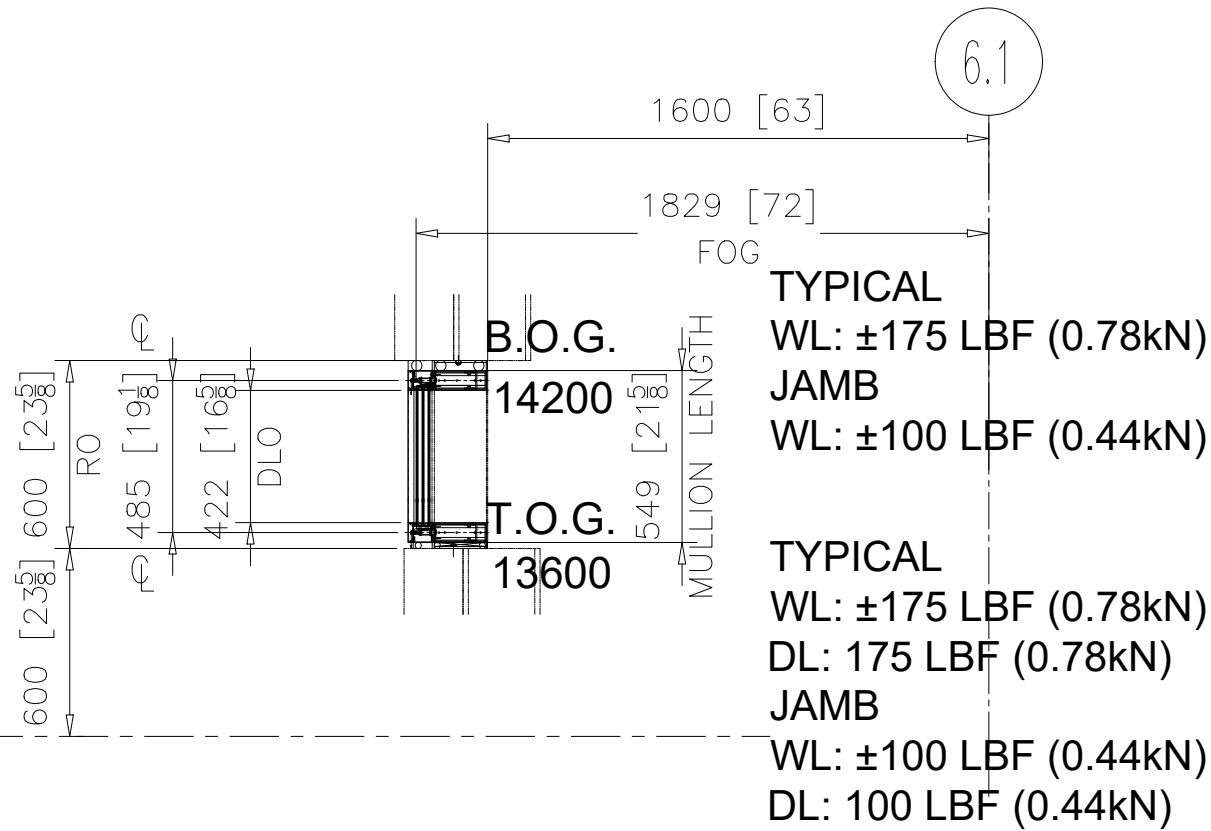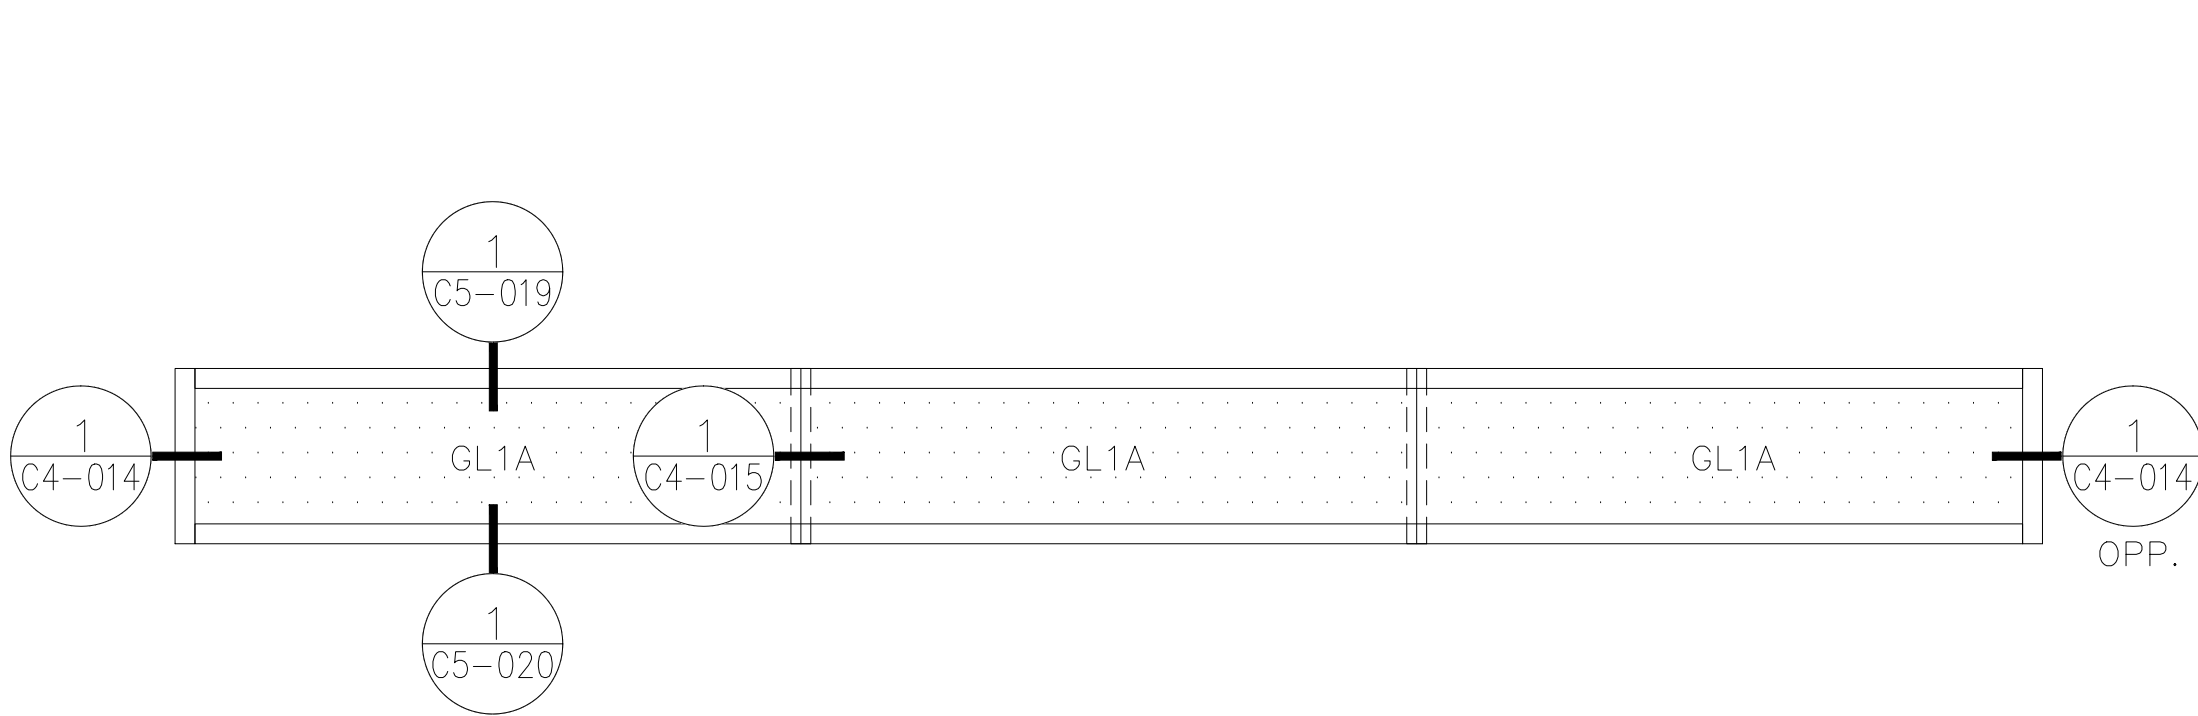

1
C3-027 **EG20**
PARTIAL ELEVATION
ARCH. REF.: 2/A052
QUANTITY: 2

2
C3-027 **EG20**
PARTIAL SECTION
ARCH. REF.: 1/A459, 3/A553

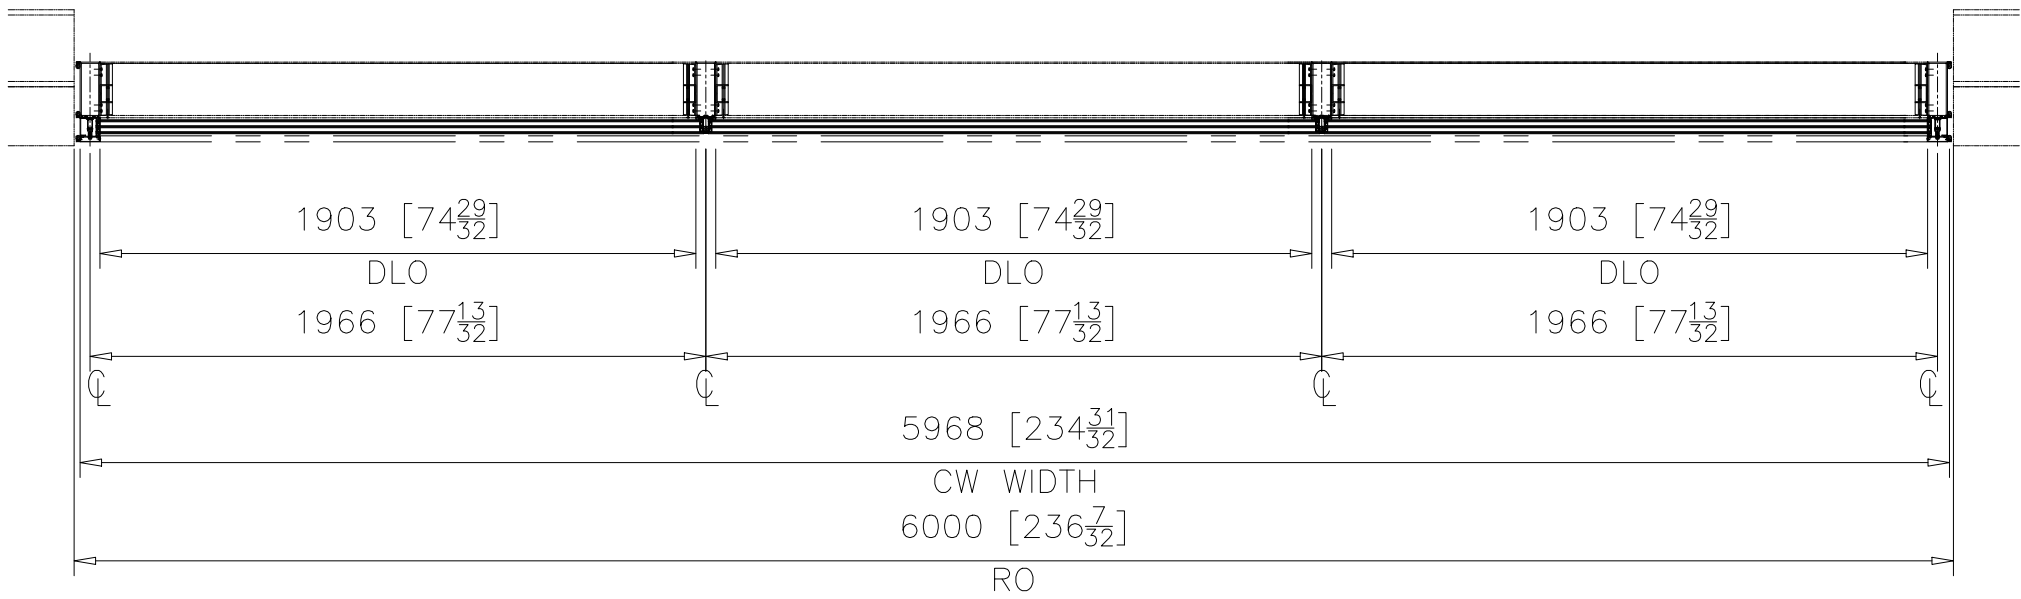


3
C3-027 **EG20**
PARTIAL PLAN
ARCH. REF.: 1/A107

REVISIONS			
No.	Description:	Date:	By:
1	Revised per arch. markups received Feb 11/26	03/03/26	SLR

Project Name:	DOCKSTEADER PRPS
Project Location:	BRAMPTON, ONTARIO
Architect Name:	DIAMOND SCHMITT ARCHITECTS
Customer Name:	BOTHWELL ACCURATE GLAZING

KEY PLAN:

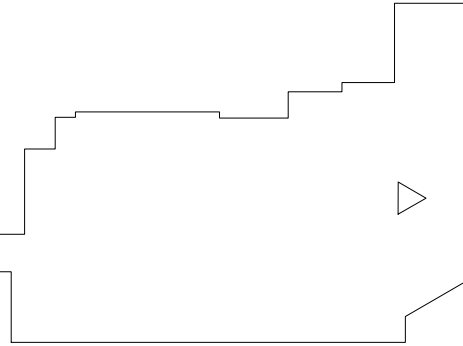


275 Britannia Road East • Mississauga
Ontario • Canada • L4Z2E7
905-890-6970 • oldcastlebe.com


Drawing Name:
EG20

Drawn By:	Checked By:
SR	NP
Drawn Date:	Issue No.:
2026/01/12	1
Scale:	Release Date:
NTS	2026/03/03
Drawing Number:	C3-027


VB ROOF/LEVEL 3
262150

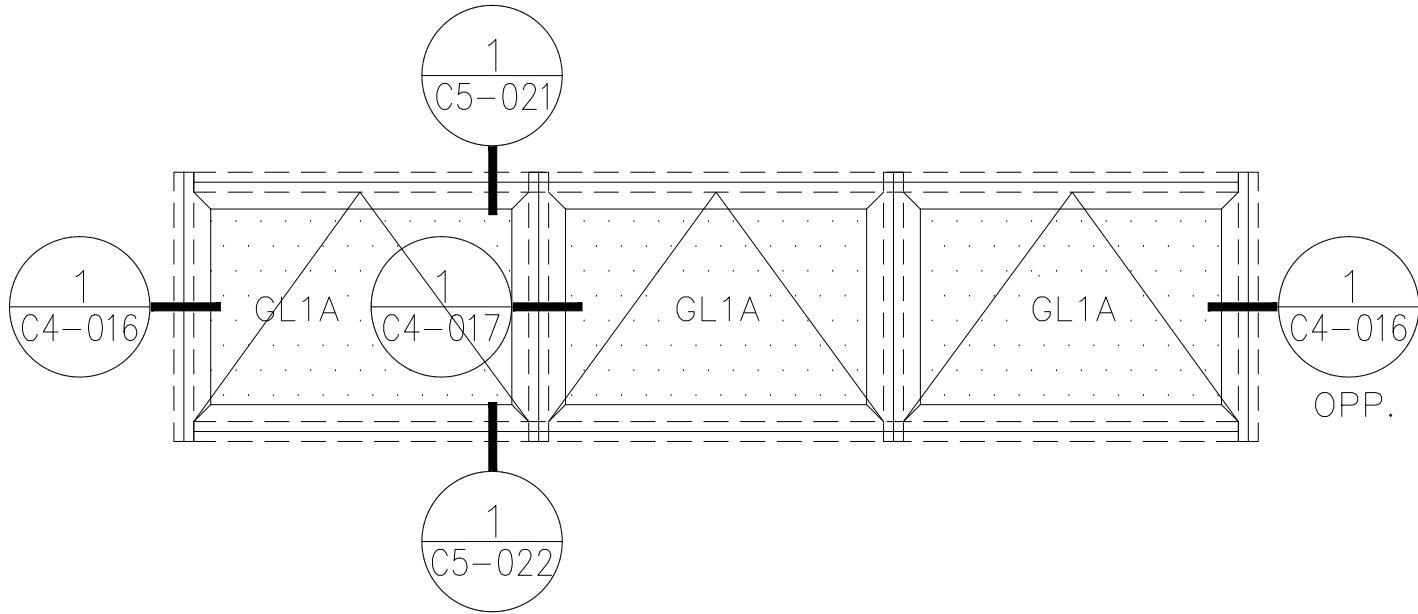

1
C3-028 **EG21**
PARTIAL ELEVATION
ARCH. REF.: 15/A052
QUANTITY:5

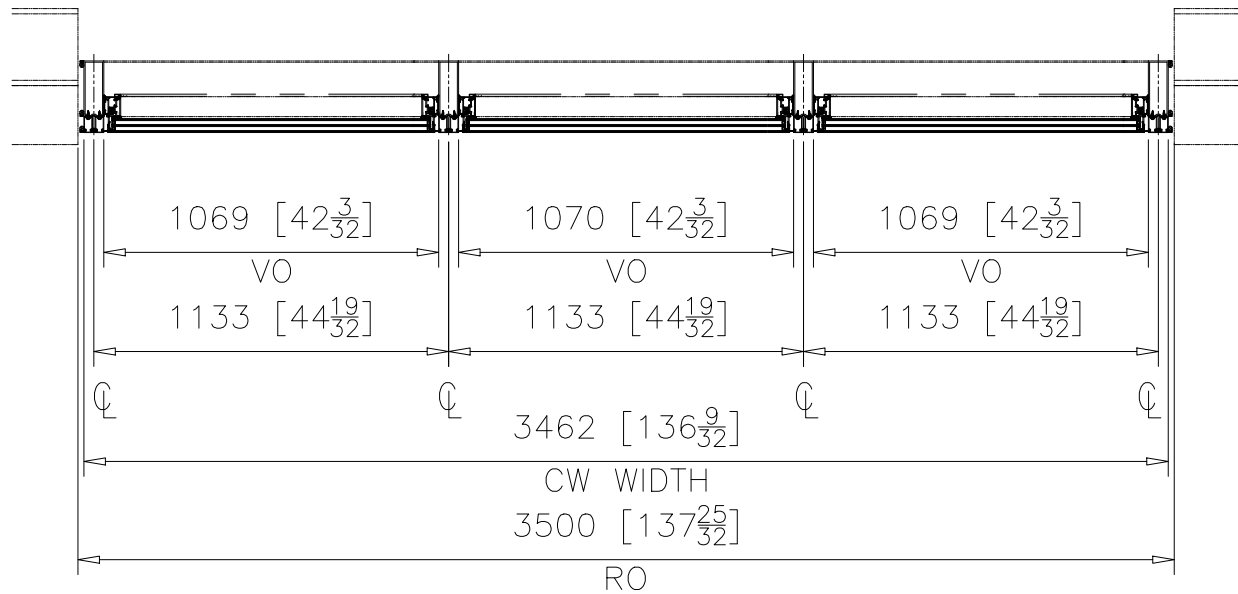

3
C3-028 **EG21**
PARTIAL PLAN
ARCH. REF.: 1/A107

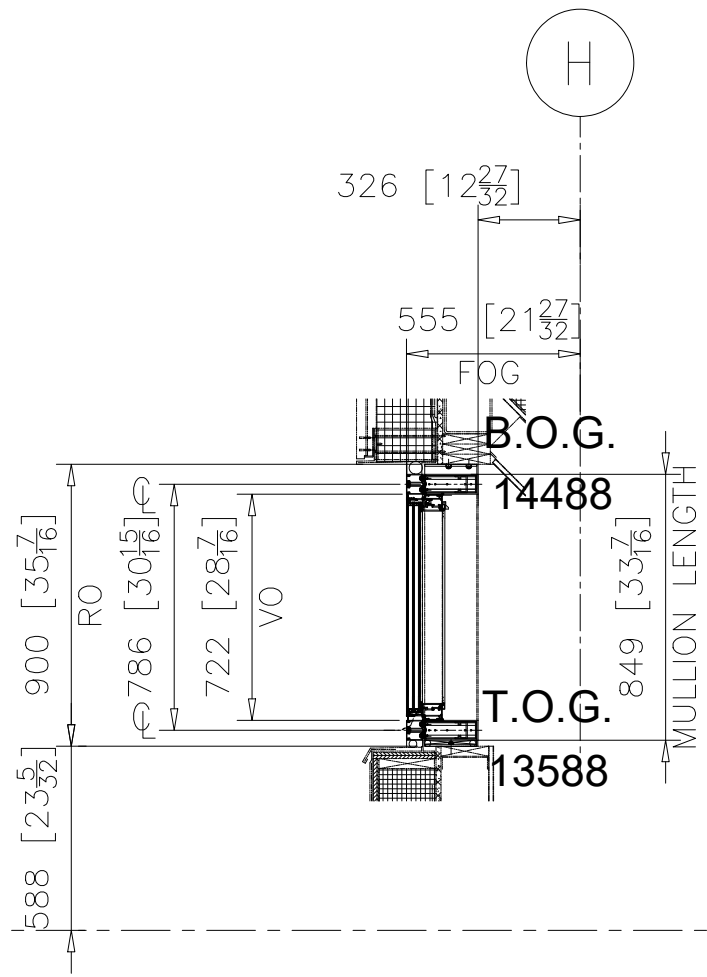

TYPICAL
WL: ±150 LBF (0.67kN)
JAMB
WL: ±75 LBF (0.33kN)


TYPICAL
WL: ±150 LBF (0.67kN)
DL: 150 LBF (0.67kN)
JAMB
WL: ±75 LBF (0.33kN)
DL: 75 LBF (0.33kN)

2
C3-028 **EG21**
PARTIAL SECTION
ARCH. REF.: 3/A552

REVISIONS			
No.	Description:	Date:	By:
1	Revised per arch. markups received Feb 11/26	03/03/26	SLR

Project Name:	DOCKSTEADER PRPS
Project Location:	BRAMPTON, ONTARIO
Architect Name:	DIAMOND SCHMITT ARCHITECTS
Customer Name:	BOTHWELL ACCURATE GLAZING


KEY PLAN:

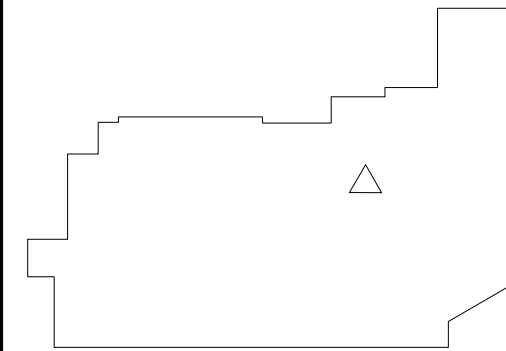



275 Britannia Road East • Mississauga
Ontario • Canada • L4Z2E7
905-890-6970 • oldcastlebe.com

Drawing Name: EG21	
Drawn By: SR	Checked By: NP
Drawn Date: 2026/01/12	Issue No.: 1
Scale: NTS	Release Date: 2026/03/03
Drawing Number: C3-028	

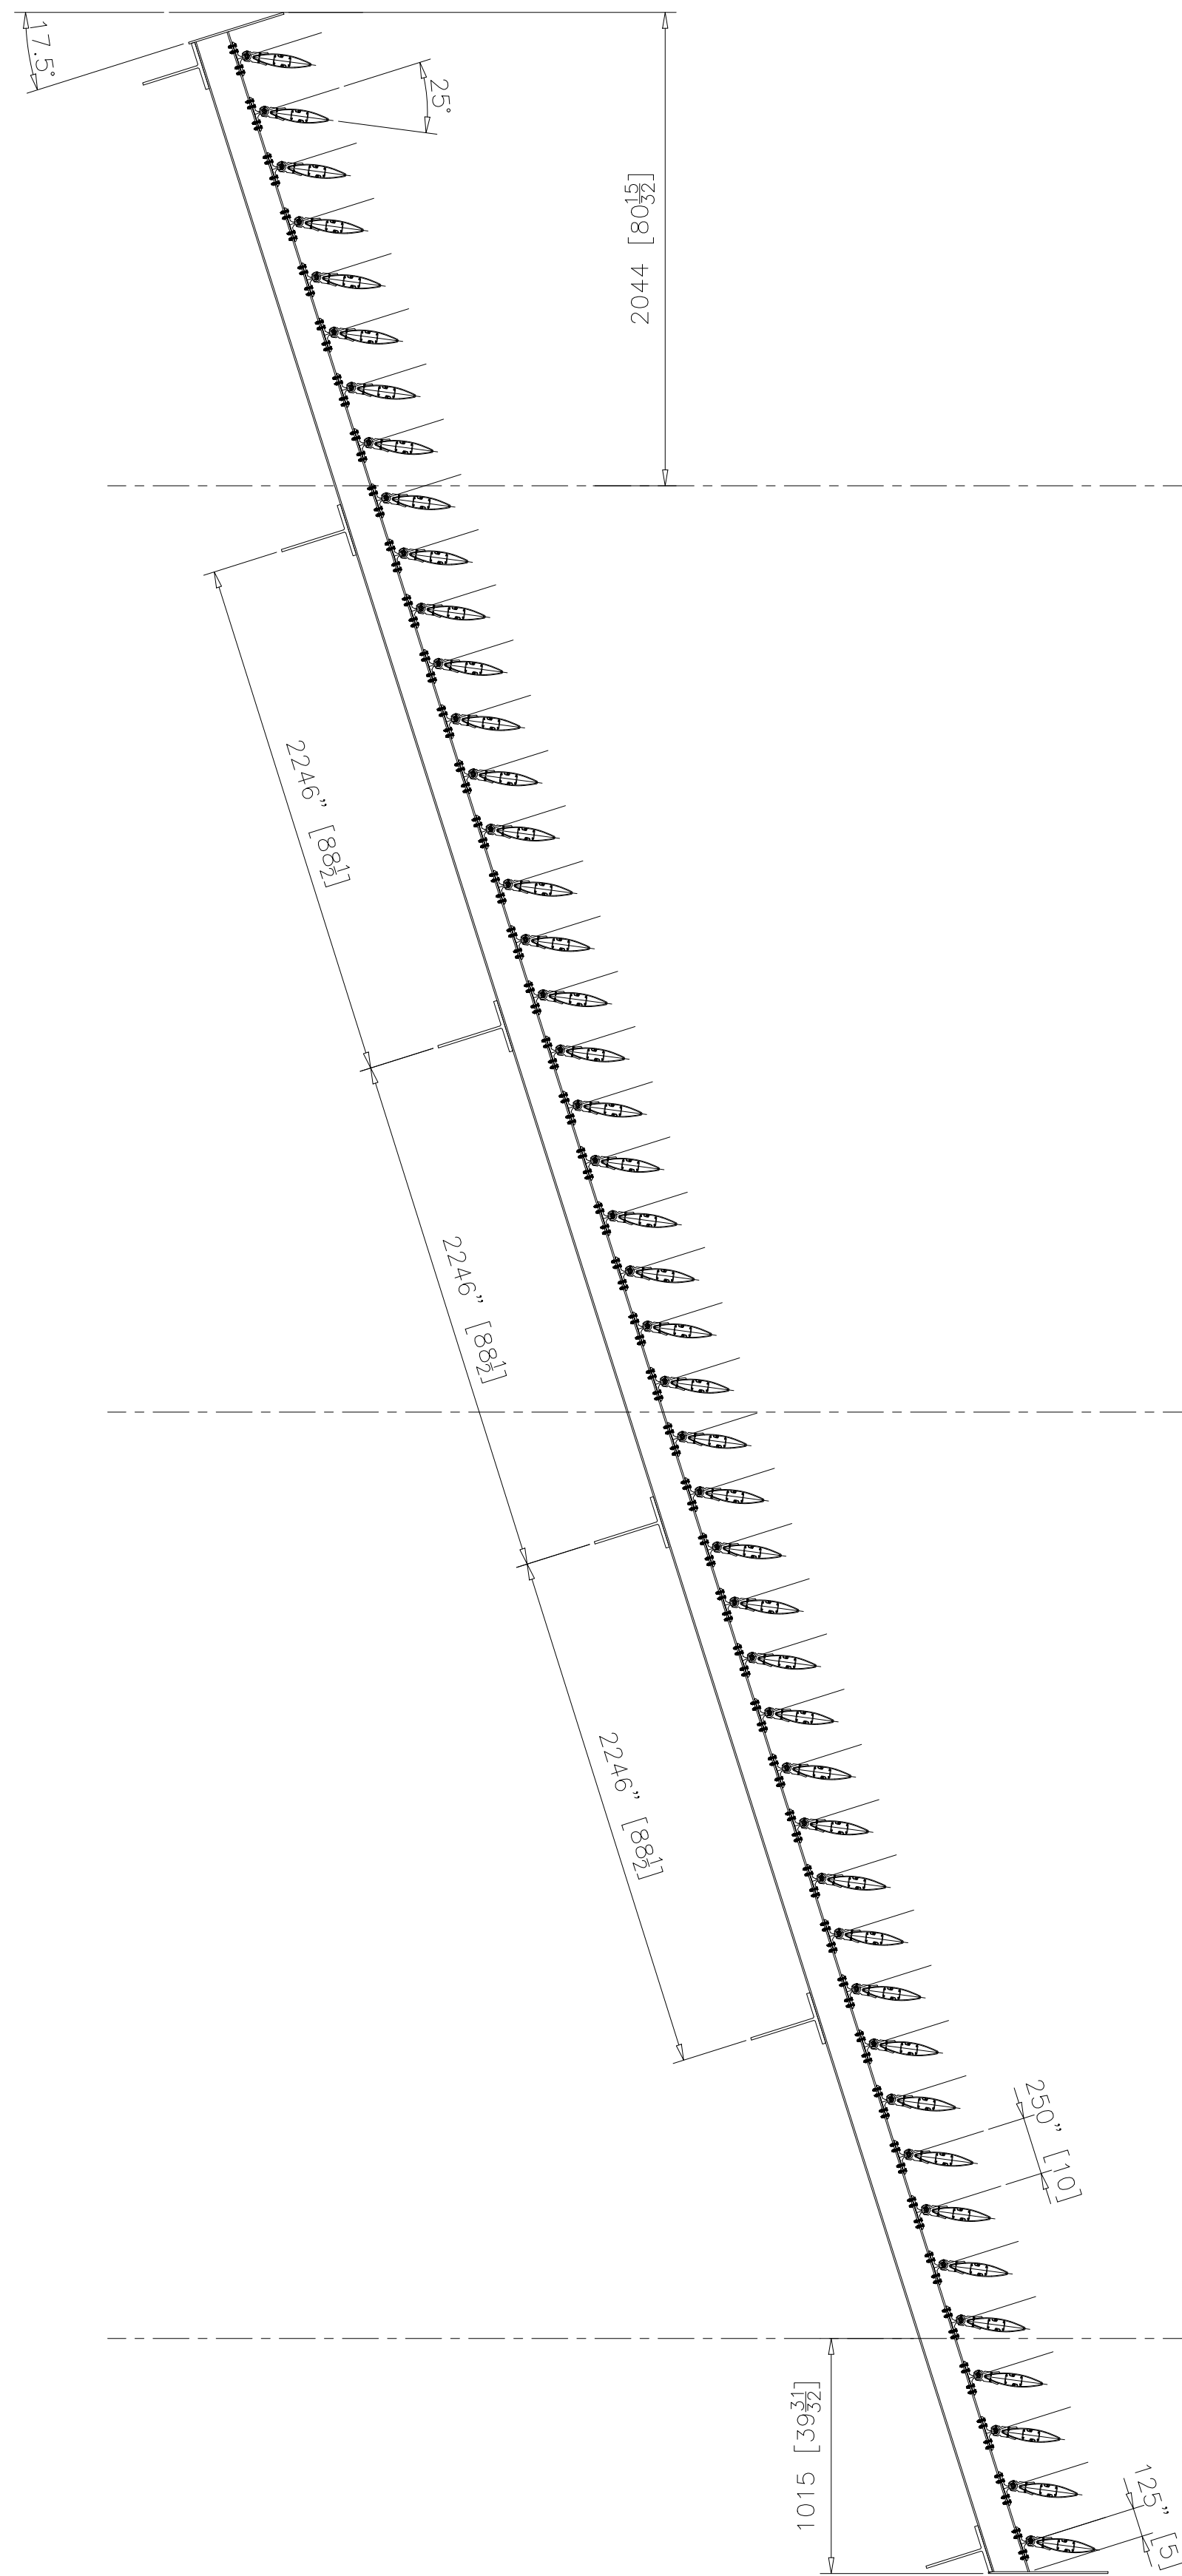


2
C3-029 **SS04**
PARTIAL SECTION
ARCH. REF.: 3/A054

WAREHOUSES/L3 ROOF
266150

VB ROOF/LEVEL 3
262150

LEVEL 2
258150

1
C3-029 **SS04**
PARTIAL ELEVATION
ARCH. REF.: 1/A054
QUANTITY:2

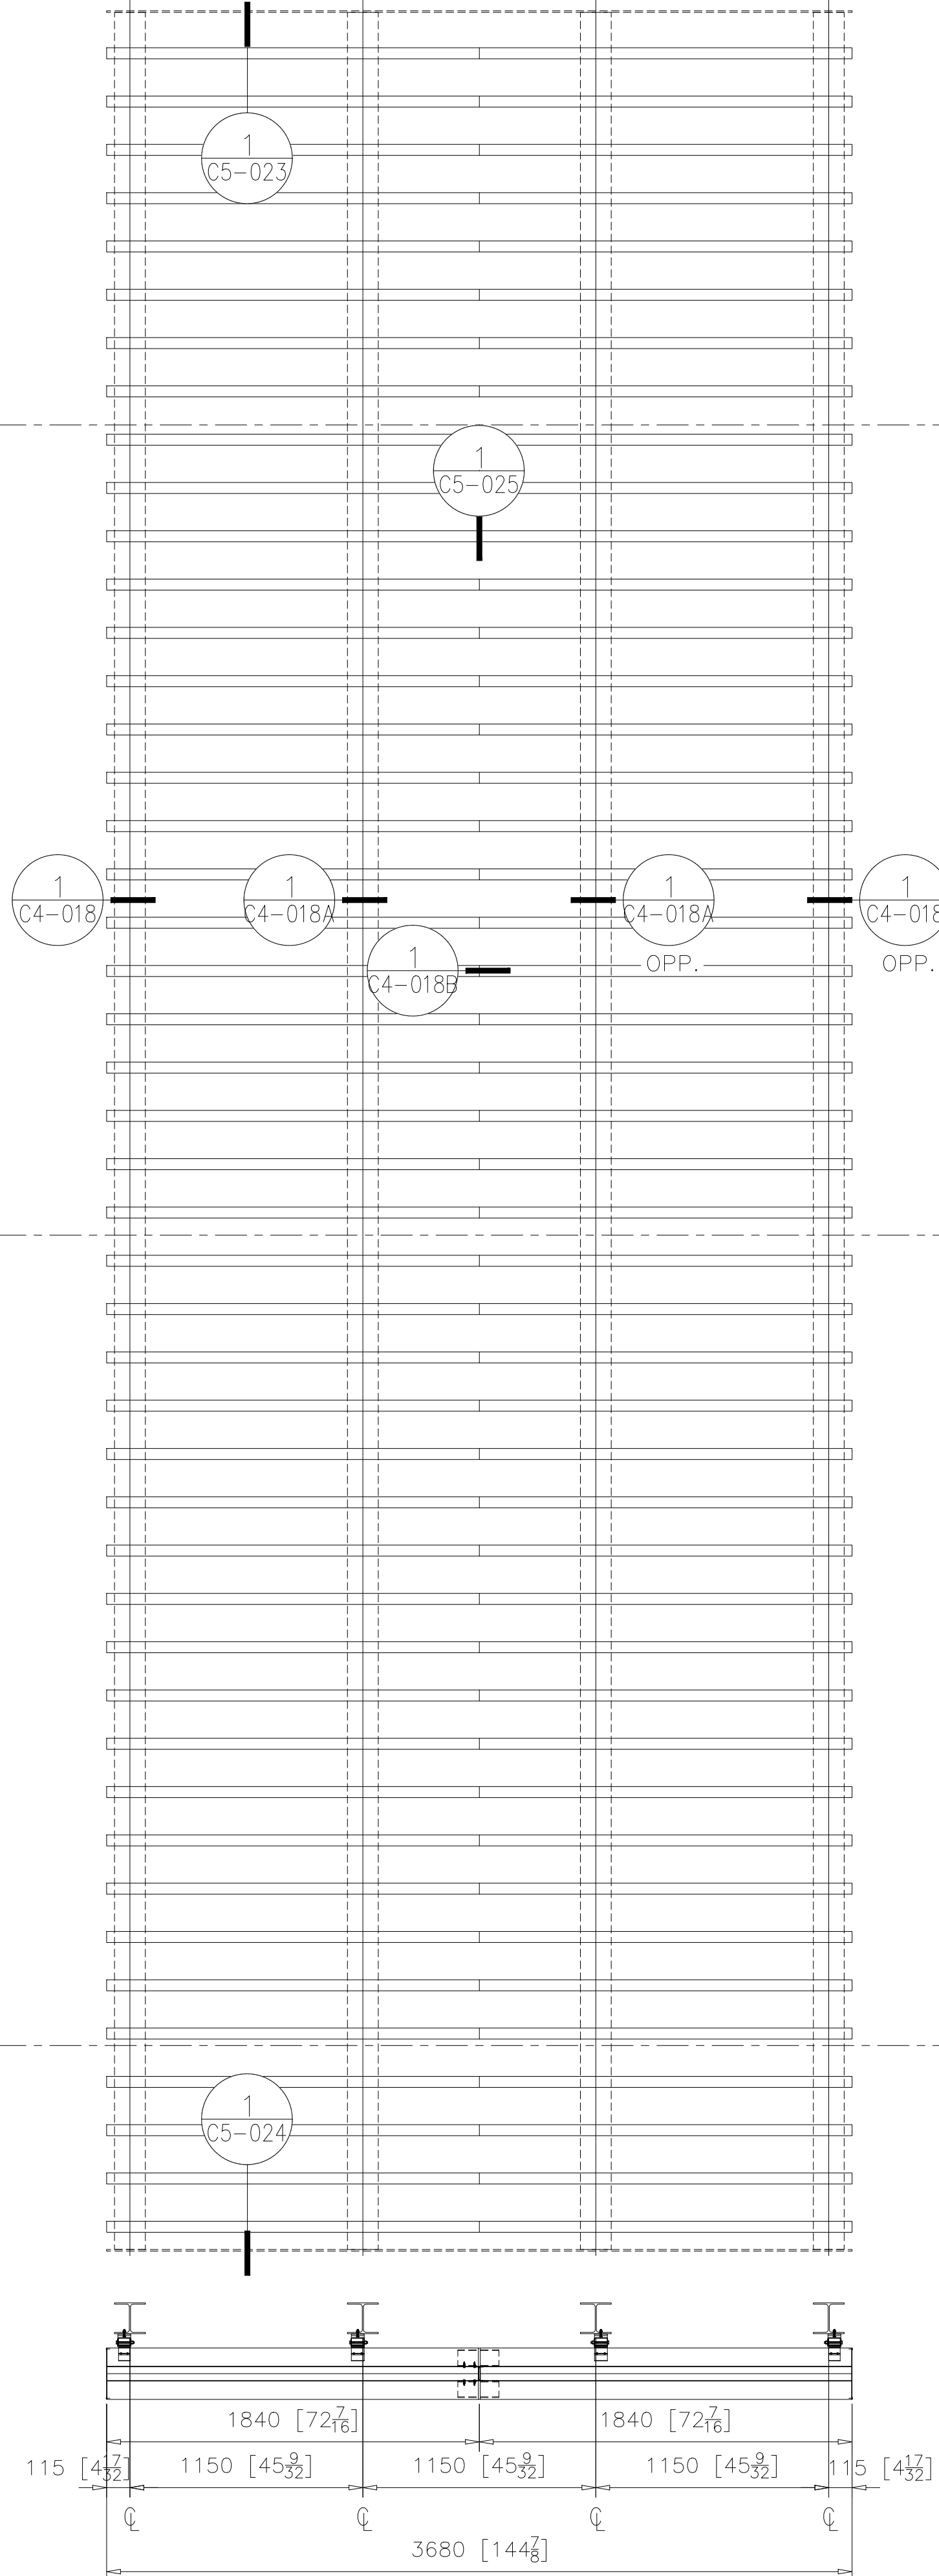


3
C3-029 **SS04**
PARTIAL PLAN
ARCH. REF.: N/A

Note: Refer to Submittal 10 71 13-01-R0-10 inch Aluminum Sunshades PDS (SS04) for Product Data Sheets

REVISIONS			
No.	Description:	Date:	By:
1	Revised per arch. markups received Feb 11/26	03/03/26	SLR

Project Name:	DOCKSTEADER PRPS
Project Location:	BRAMPTON, ONTARIO
Architect Name:	DIAMOND SCHMITT ARCHITECTS
Customer Name:	BOTHWELL ACCURATE GLAZING


KEY PLAN:

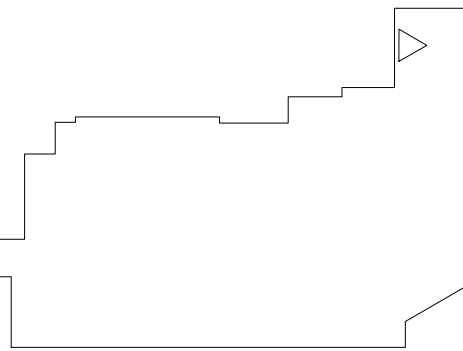

275 Britannia Road East • Mississauga
Ontario • Canada • L4Z2E7
905-890-6970 • oldcastlebe.com


Drawing Name:
SS04

Drawn By:	SR	Checked By:	NP
Drawn Date:	2026/01/12	Issue No.:	1
Scale:	NTS	Release Date:	2026/03/03
Drawing Number:	C3-029		

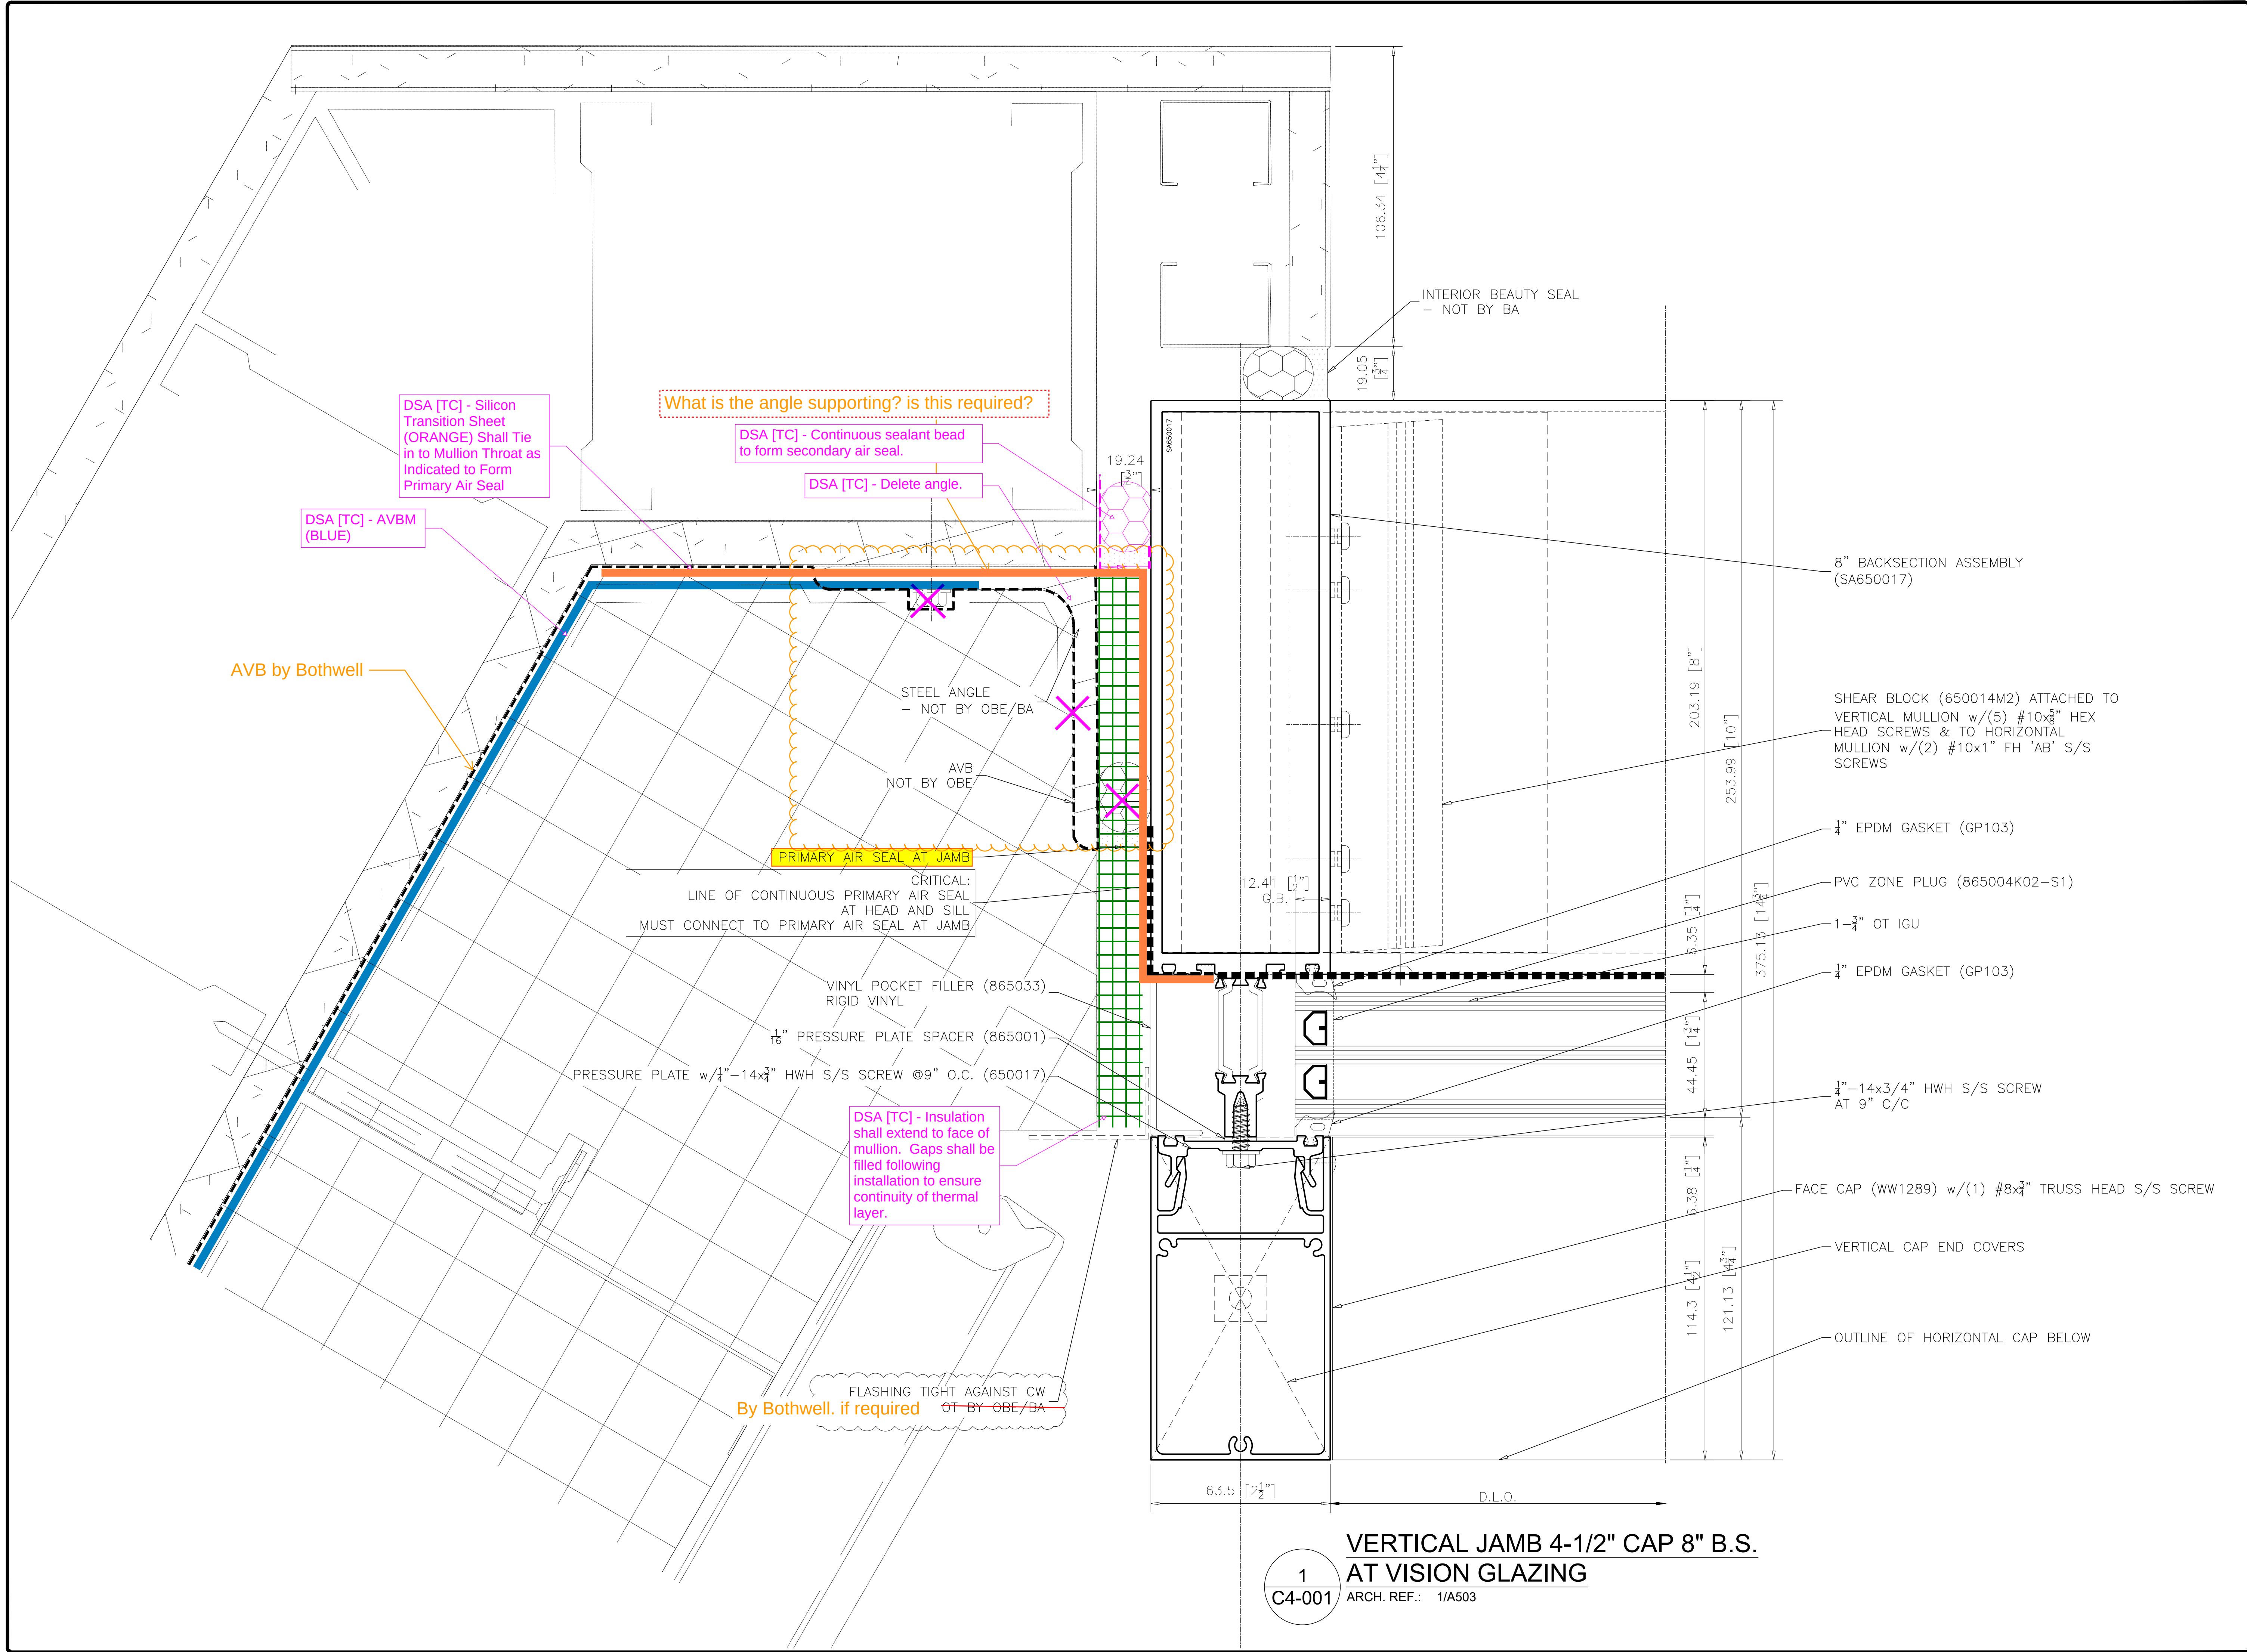

REVISIONS			
No.	Description:	Date:	By:
1	Revised per arch. markups received Feb 11/26	03/03/26	SLR


Project Name:	DOCKSTEADER PRPS
Project Location:	BRAMPTON, ONTARIO
Architect Name:	DIAMOND SCHMITT ARCHITECTS
Customer Name:	BOTHWELL ACCURATE GLAZING

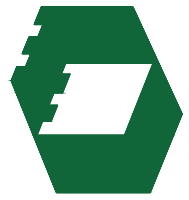

Oldcastle BuildingEnvelope®

275 Britannia Road East • Mississauga • Ontario • Canada • L4Z2E7
905-890-6970 • oldcastlebe.com

Drawing Name:	
PLAN DETAIL	
Drawn By:	Checked By:
SR	NP
Drawn Date:	Issue No.:
2026/01/12	1
Scale:	Release Date:
1"=1"	2026/03/03
Drawing Number:	C4-001

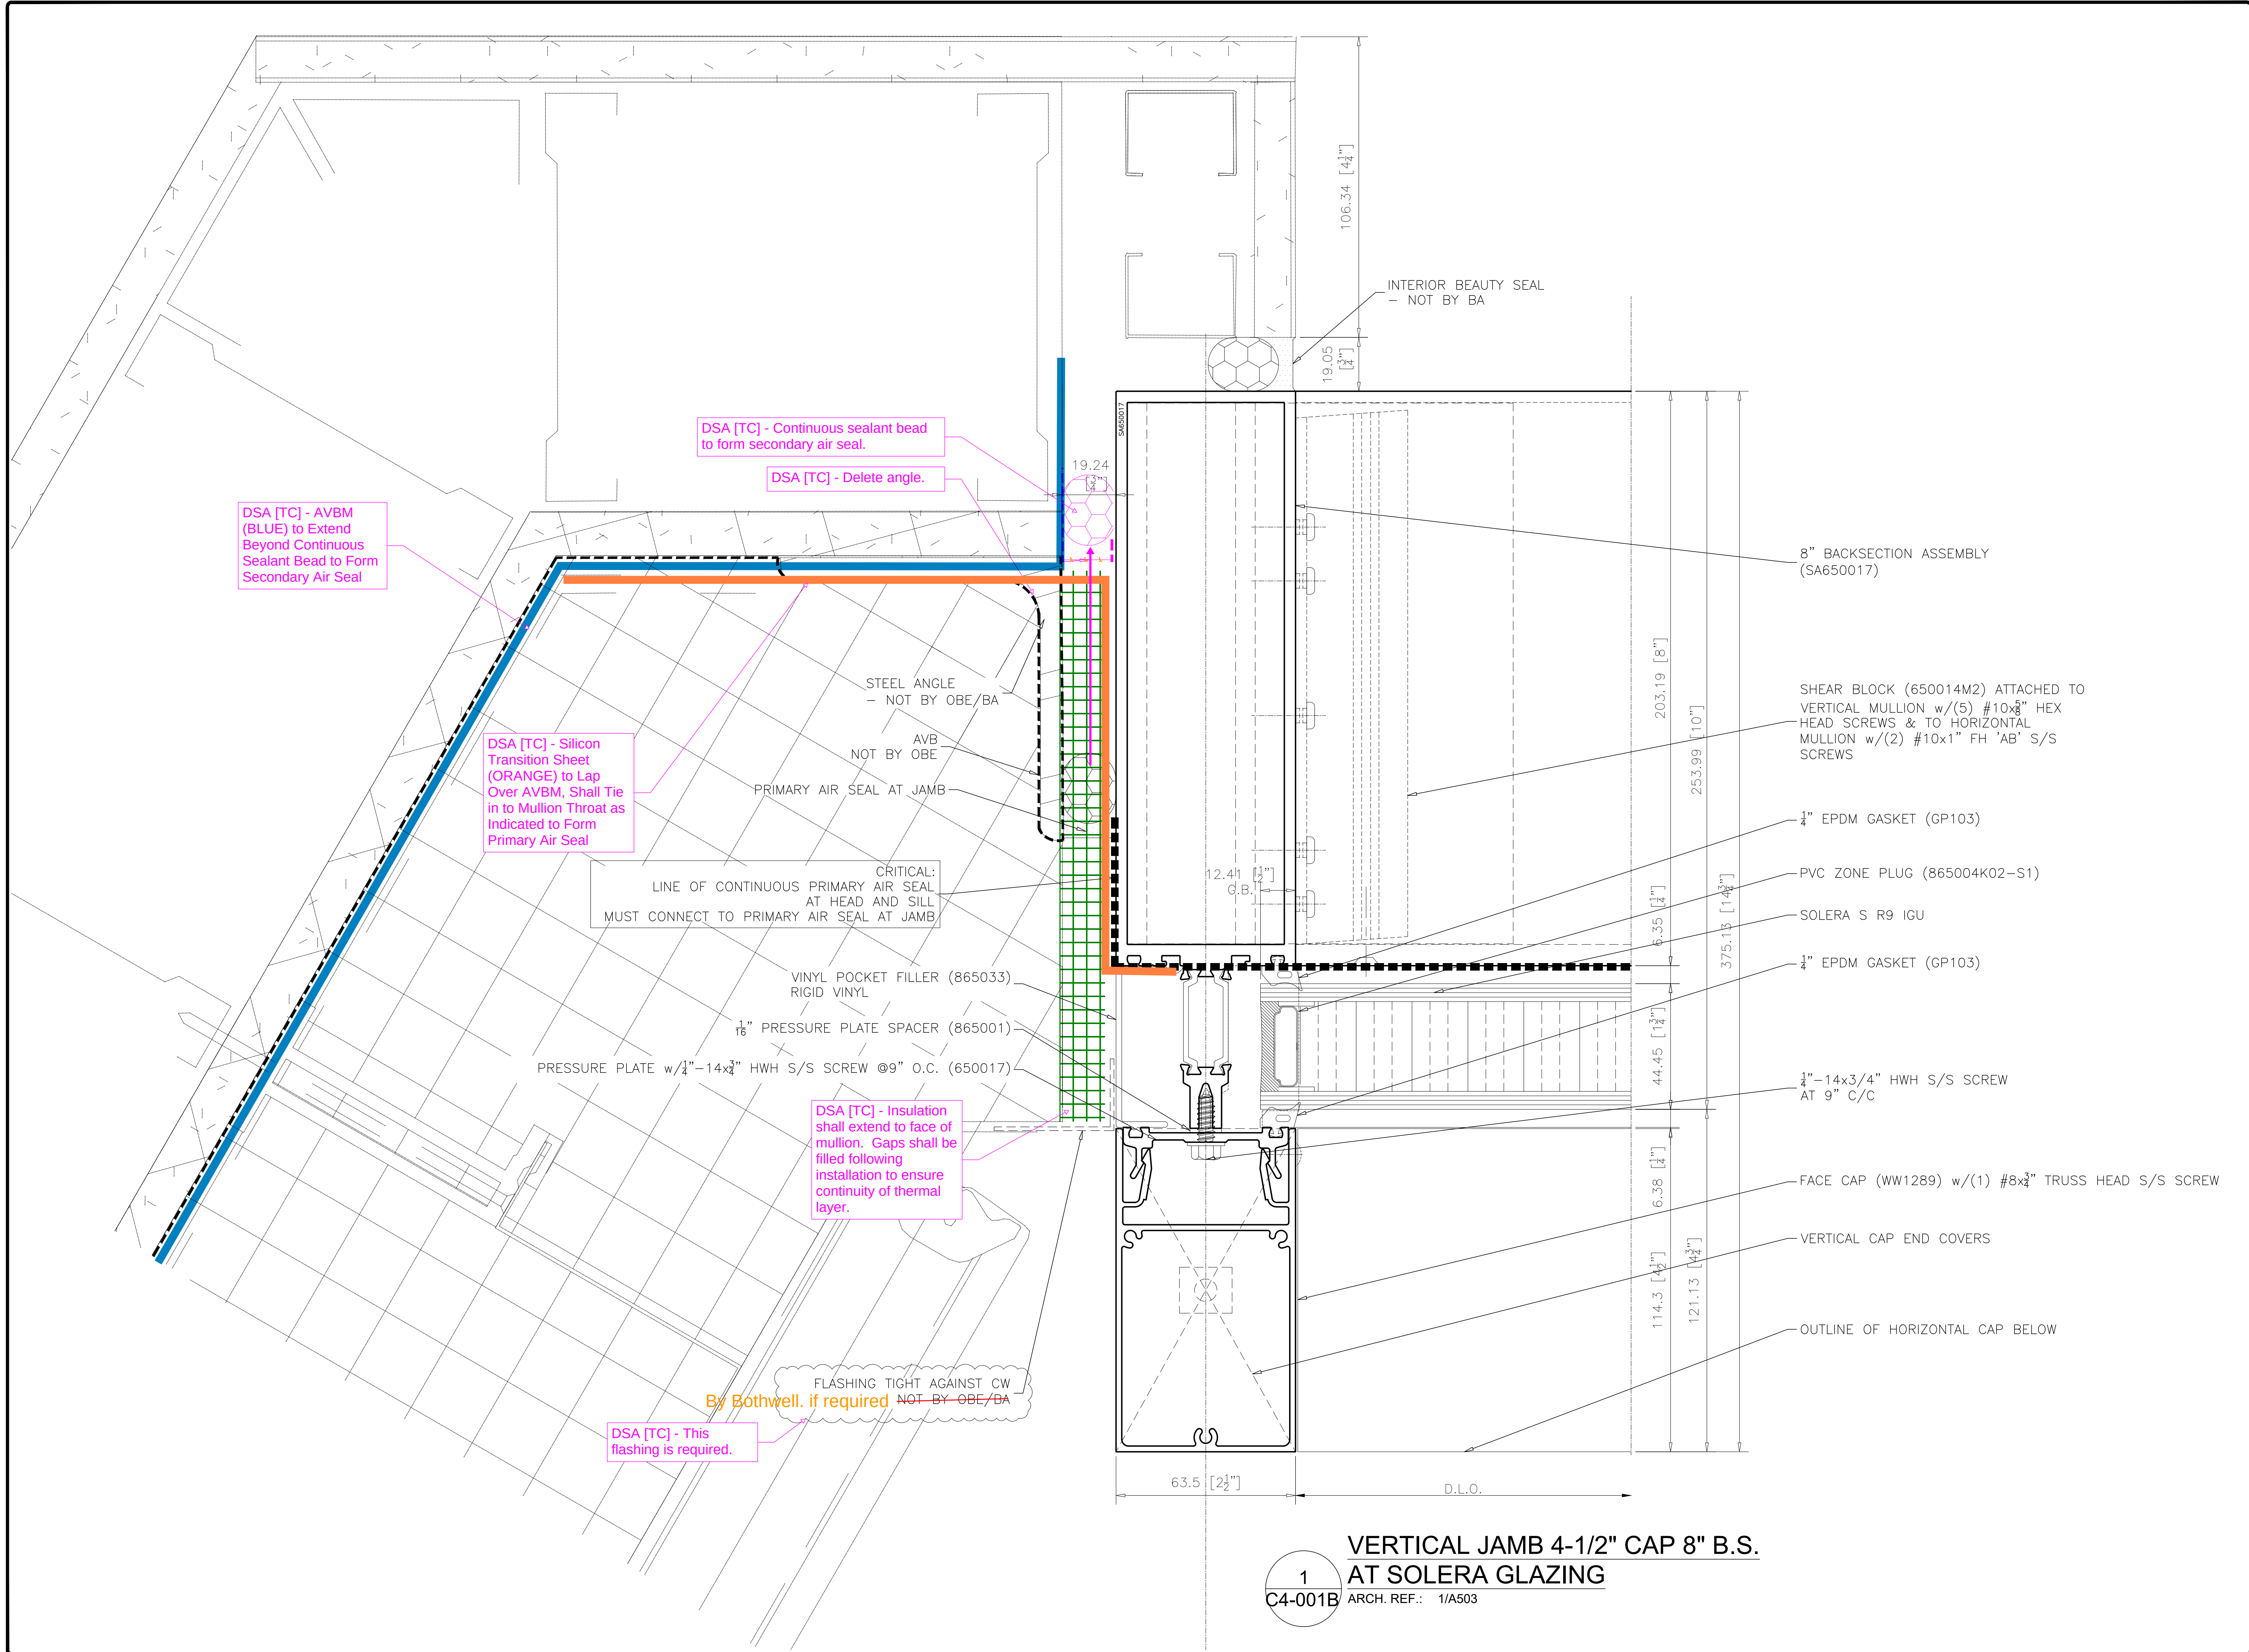


1
C4-001B

VERTICAL JAMB 4-1/2" CAP 8" B.S.
AT SOLERA GLAZING

ARCH. REF.: 1/A503

REVISIONS			
No.	Description:	Date:	By:
1	Revised per arch. markups received Feb 11/26	03/03/26	SLR

Project Name: DOCKSTEADER PRPS		Project Location: BRAMPTON, ONTARIO	
Architect Name: DIAMOND SCHMITT ARCHITECTS		Customer Name: BOTHWELL ACCURATE GLAZING	

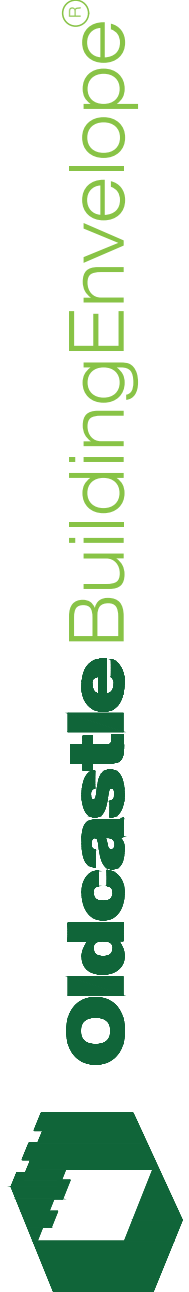

275 Britannia Road East • Mississauga • Ontario • Canada • L4Z2E7
905-890-6970 • oldcastlebe.com

Drawing Name: PLAN DETAIL	
Drawn By: SR	Checked By: NP
Drawn Date: 2026/01/12	Issue No.: 1
Scale: 1"=1"	Release Date: 2026/03/03
Drawing Number: C4-001B	

DSA [TC] - AVBM (BLUE) to Extend Beyond Continuous Sealant Bead to Form Secondary Air Seal

DSA [TC] - Continuous sealant bead to form secondary air seal.

DSA [TC] - Delete angle.

DSA [TC] - Silicon Transition Sheet (ORANGE) to Lap Over AVBM, Shall Tie in to Mullion Throat as Indicated to Form Primary Air Seal

CRITICAL: LINE OF CONTINUOUS PRIMARY AIR SEAL AT HEAD AND SILL MUST CONNECT TO PRIMARY AIR SEAL AT JAMB

VINYL POCKET FILLER (865033) RIGID VINYL

1/8" PRESSURE PLATE SPACER (865001)

PRESSURE PLATE w/ 1/4"-14x3/4" HWH S/S SCREW @9" O.C. (650017)

DSA [TC] - Insulation shall extend to face of mullion. Gaps shall be filled following installation to ensure continuity of thermal layer.

DSA [TC] - This flashing is required.

FLASHING TIGHT AGAINST CW By Bothwell. NOT BY OBE/BA

STEEL ANGLE - NOT BY OBE/BA

AVB NOT BY OBE

PRIMARY AIR SEAL AT JAMB

106.39 [4 1/4"]

19.05 [3/4"]

INTERIOR BEAUTY SEAL - NOT BY BA

19.24 [3/4"]

8" BACKSECTION ASSEMBLY (SA650017)

SHEAR BLOCK (650014M2) ATTACHED TO VERTICAL MULLION w/(5) #10x3/8" HEX HEAD SCREWS & TO HORIZONTAL MULLION w/(2) #10x1" FH 'AB' S/S SCREWS

1/4" EPDM GASKET (GP103)

PVC ZONE PLUG (865004K02-S1)

1-3/4" OT IGU

1/4" EPDM GASKET (GP103)

1/4"-14x3/4" HWH S/S SCREW AT 9" C/C

FACE CAP (WW1289) w/(1) #8x3/4" TRUSS HEAD S/S SCREW

VERTICAL CAP END COVERS

OUTLINE OF HORIZONTAL CAP BELOW

203.19 [8"]

253.99 [10"]

6.35 [1/4"]

375.13 [14 3/4"]

44.45 [1 3/4"]

6.38 [1/4"]

114.3 [4 1/2"]

121.13 [4 3/4"]

63.5 [2 1/2"]

D.L.O.

613.57 [24 1/4"] FOG TO GL-1

VERTICAL JAMB 4-1/2" CAP 8" B.S. AT VISION GLAZING

1
C4-001C

ARCH. REF.: 2/A501

REVISIONS

No.	Description:	Date:	By:
1	Revised per arch. markups received Feb 11/26	03/03/26	SLR

Project Name:
DOCKSTEADER PRPS

Project Location:
BRAMPTON, ONTARIO

Architect Name:
DIAMOND SCHMITT ARCHITECTS

Customer Name:
BOTHWELL ACCURATE GLAZING



275 Britannia Road East • Mississauga • Ontario • Canada • L4Z2E7
905-890-6970 • oldcastlebe.com

Drawing Name:

PLAN DETAIL

Drawn By:

SR

Drawn Date:

2026/01/12

Scale:

1"=1"

Drawing Number:

Checked By:

NP


Issue No.:

1

Release Date:

2026/03/03

C4-001C

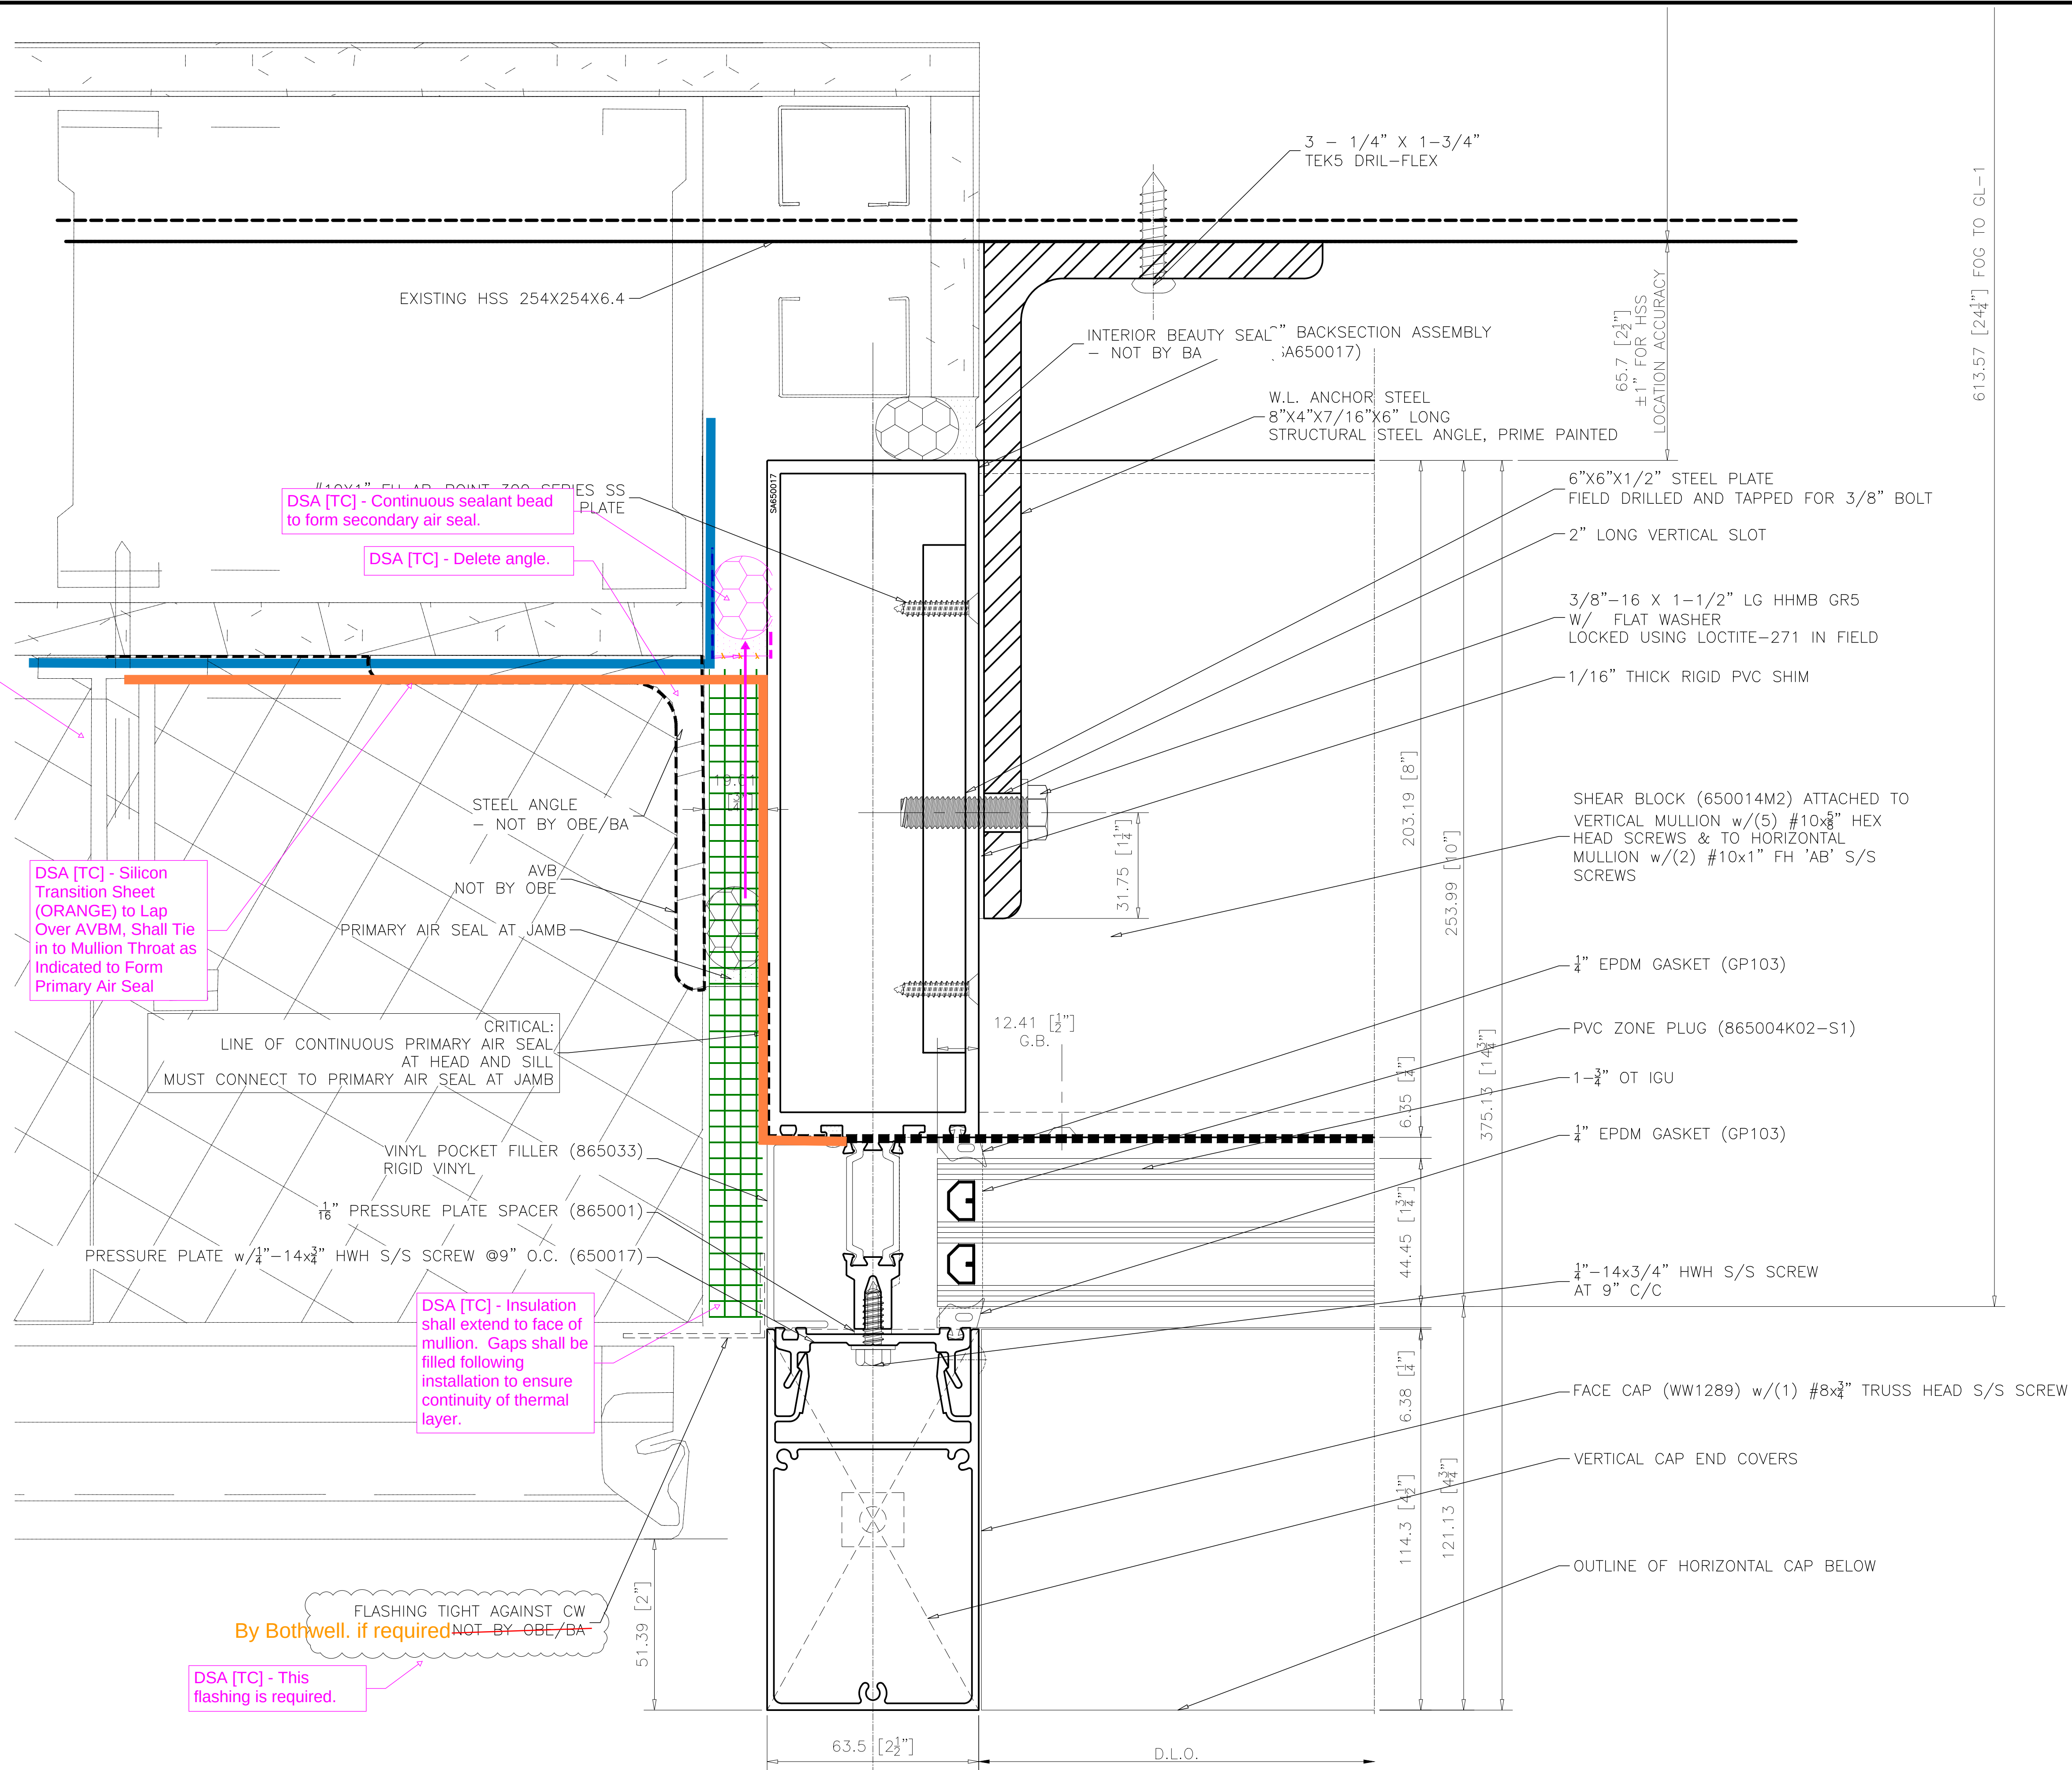

VERTICAL JAMB 4-1/2" CAP 8" B.S.
AT VISION GLAZING AT ANCHOR

1
C4-001D

ARCH. REF.: 2/A501

REVISIONS

No.	Description:	Date:	By:
1	Revised per arch. markups received Feb 11/26	03/03/26	SLR

Project Name:
DOCKSTEADER PRPS

Project Location:
BRAMPTON, ONTARIO

Architect Name:
DIAMOND SCHMITT ARCHITECTS

Customer Name:
BOTHWELL ACCURATE GLAZING




275 Britannia Road East • Mississauga • Ontario • Canada • L4Z2E7
905-890-6970 • oldcastlebe.com

Drawing Name:
PLAN DETAIL

Drawn By: SR	Checked By: NP
Drawn Date: 2026/01/12	Issue No.: 1
Scale: 1"=1"	Release Date: 2026/03/03

Drawing Number:
C4-001D

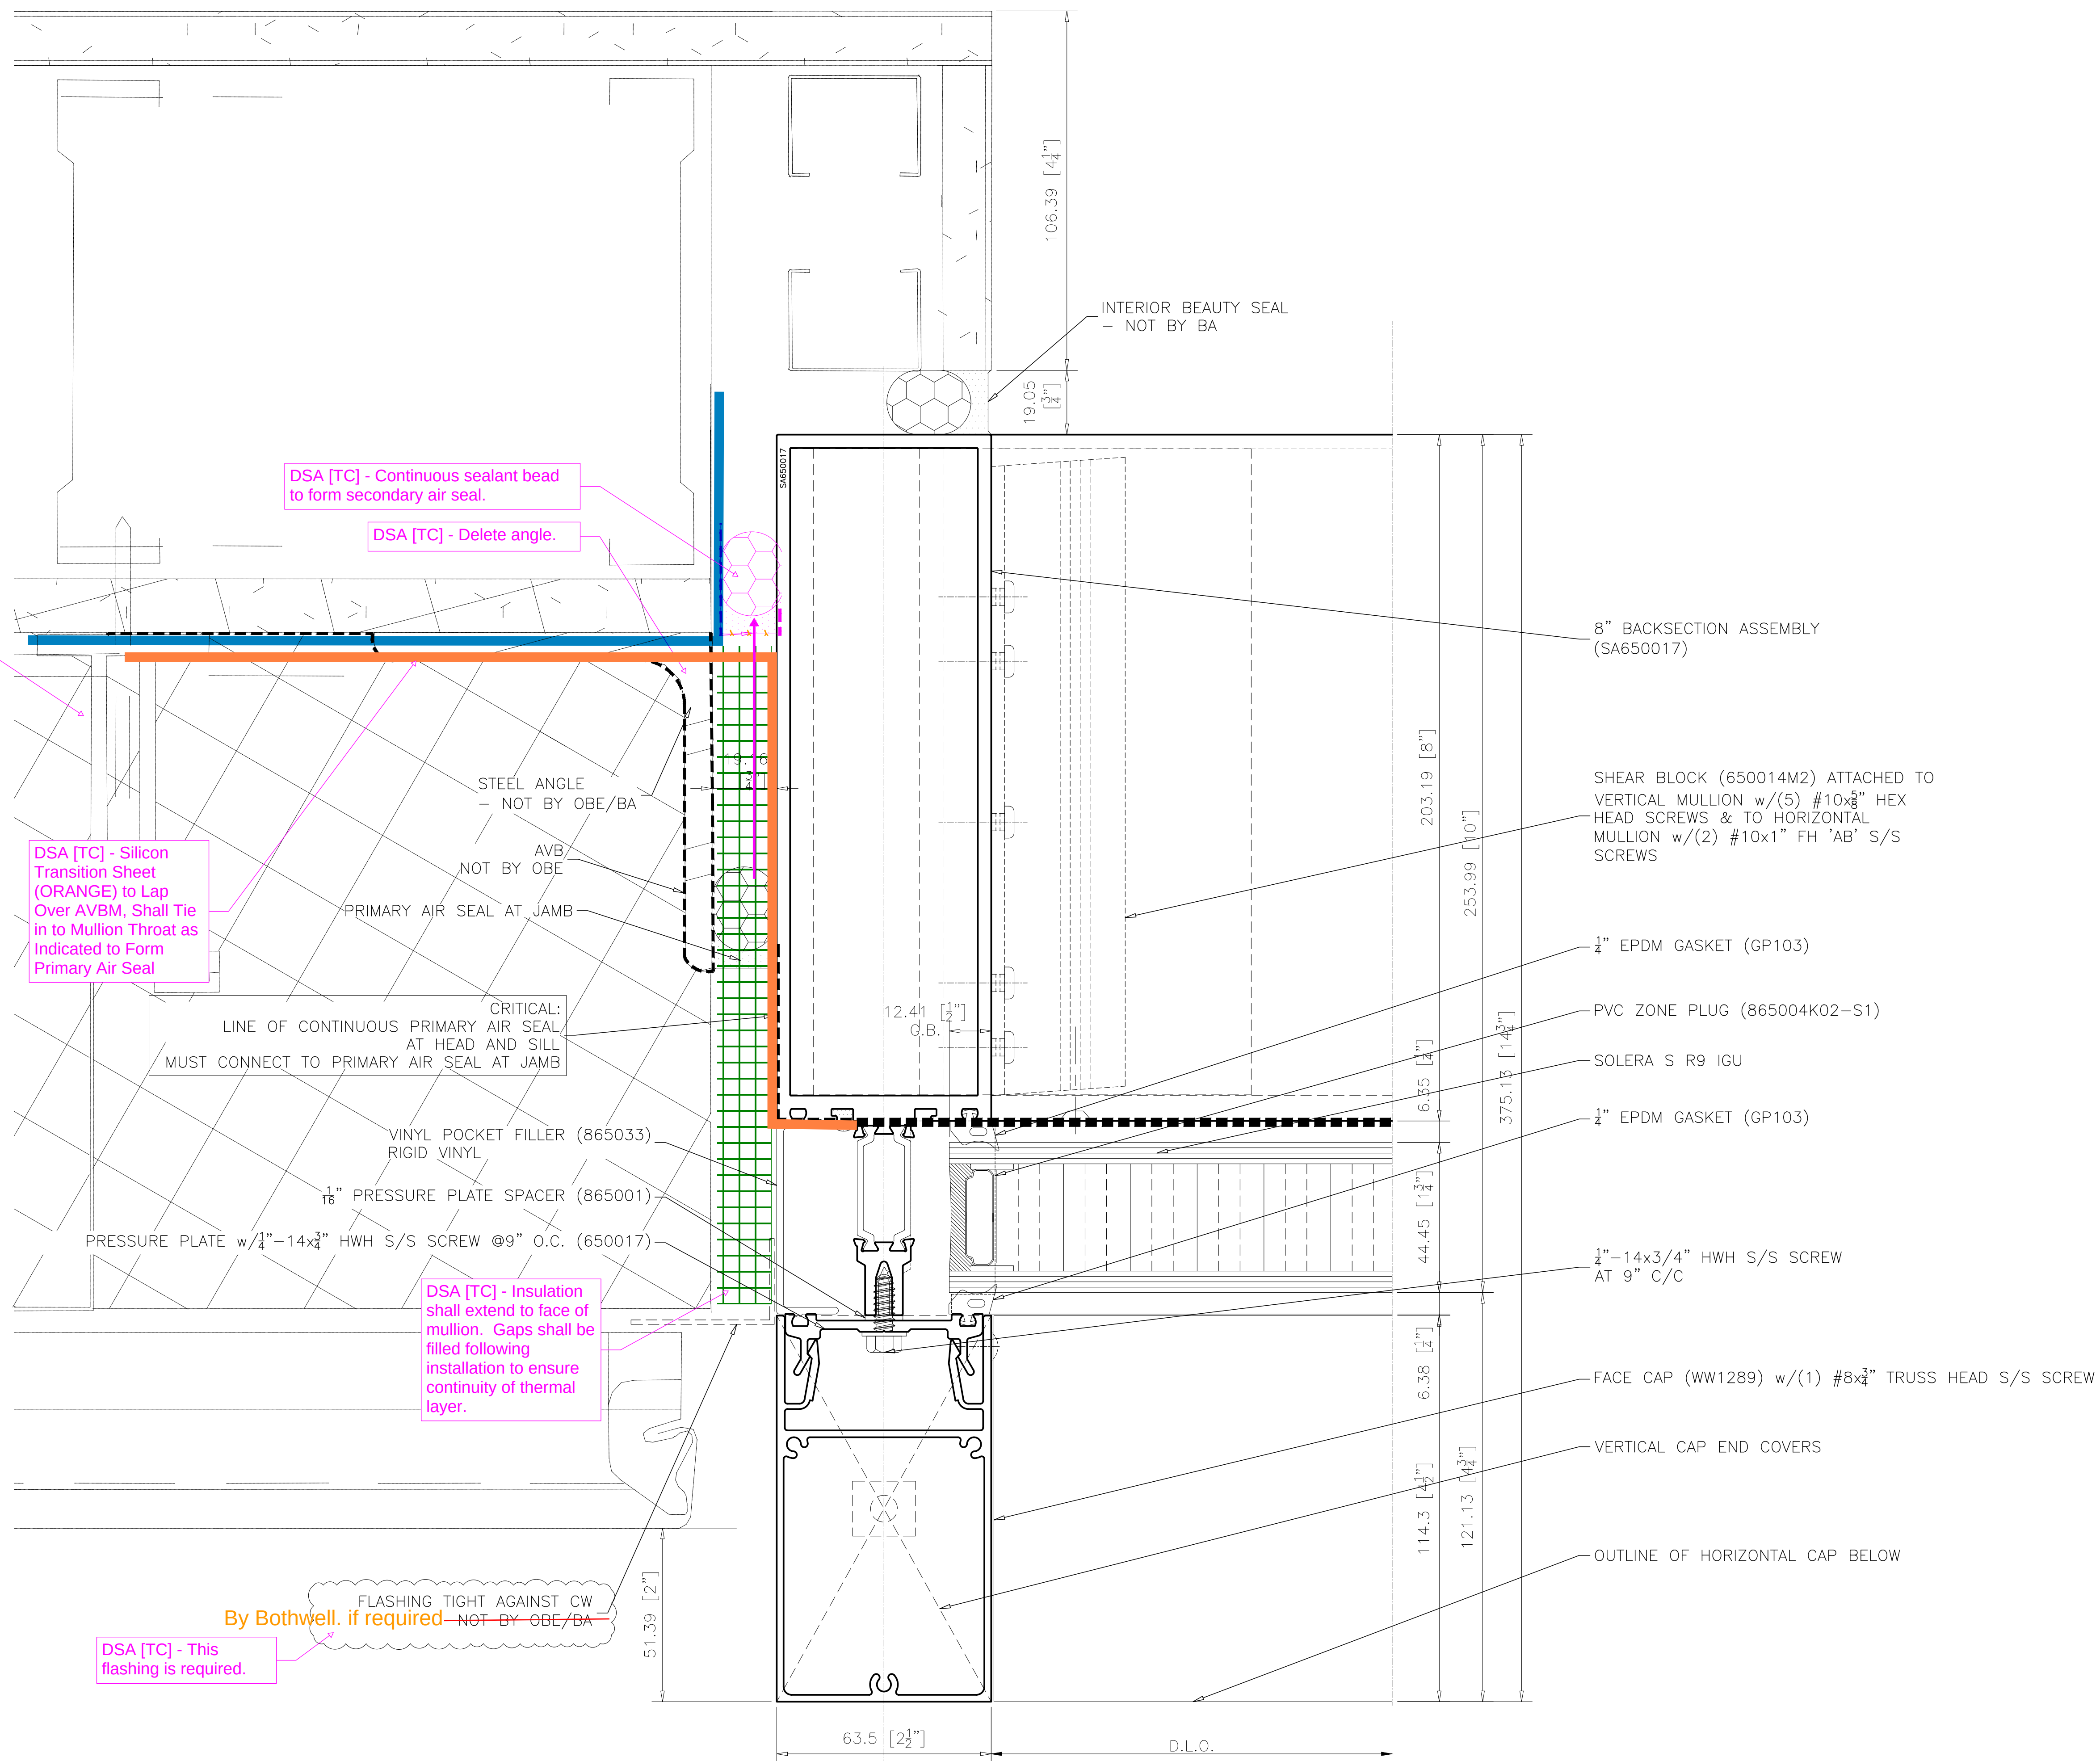[illegible]


Project Name:	DOCKSTEADER PRPS
Project Location:	BRAMPTON, ONTARIO
Architect Name:	DIAMOND SCHMITT ARCHITECTS
Customer Name:	BOTHWELL ACCURATE GLAZING



oldcastle BuildingEnvelope®

275 Britannia Road East • Mississauga • Ontario • Canada • L4Z2E7
905-890-6970 • oldcastlebe.com

Drawing Name: PLAN DETAIL	
Drawn By: SR	Checked By: NP
Drawn Date: 2026/01/12	Issue No.: 1
Scale: 1"=1"	Release Date: 2026/03/03
Drawing Number: C4-001E	

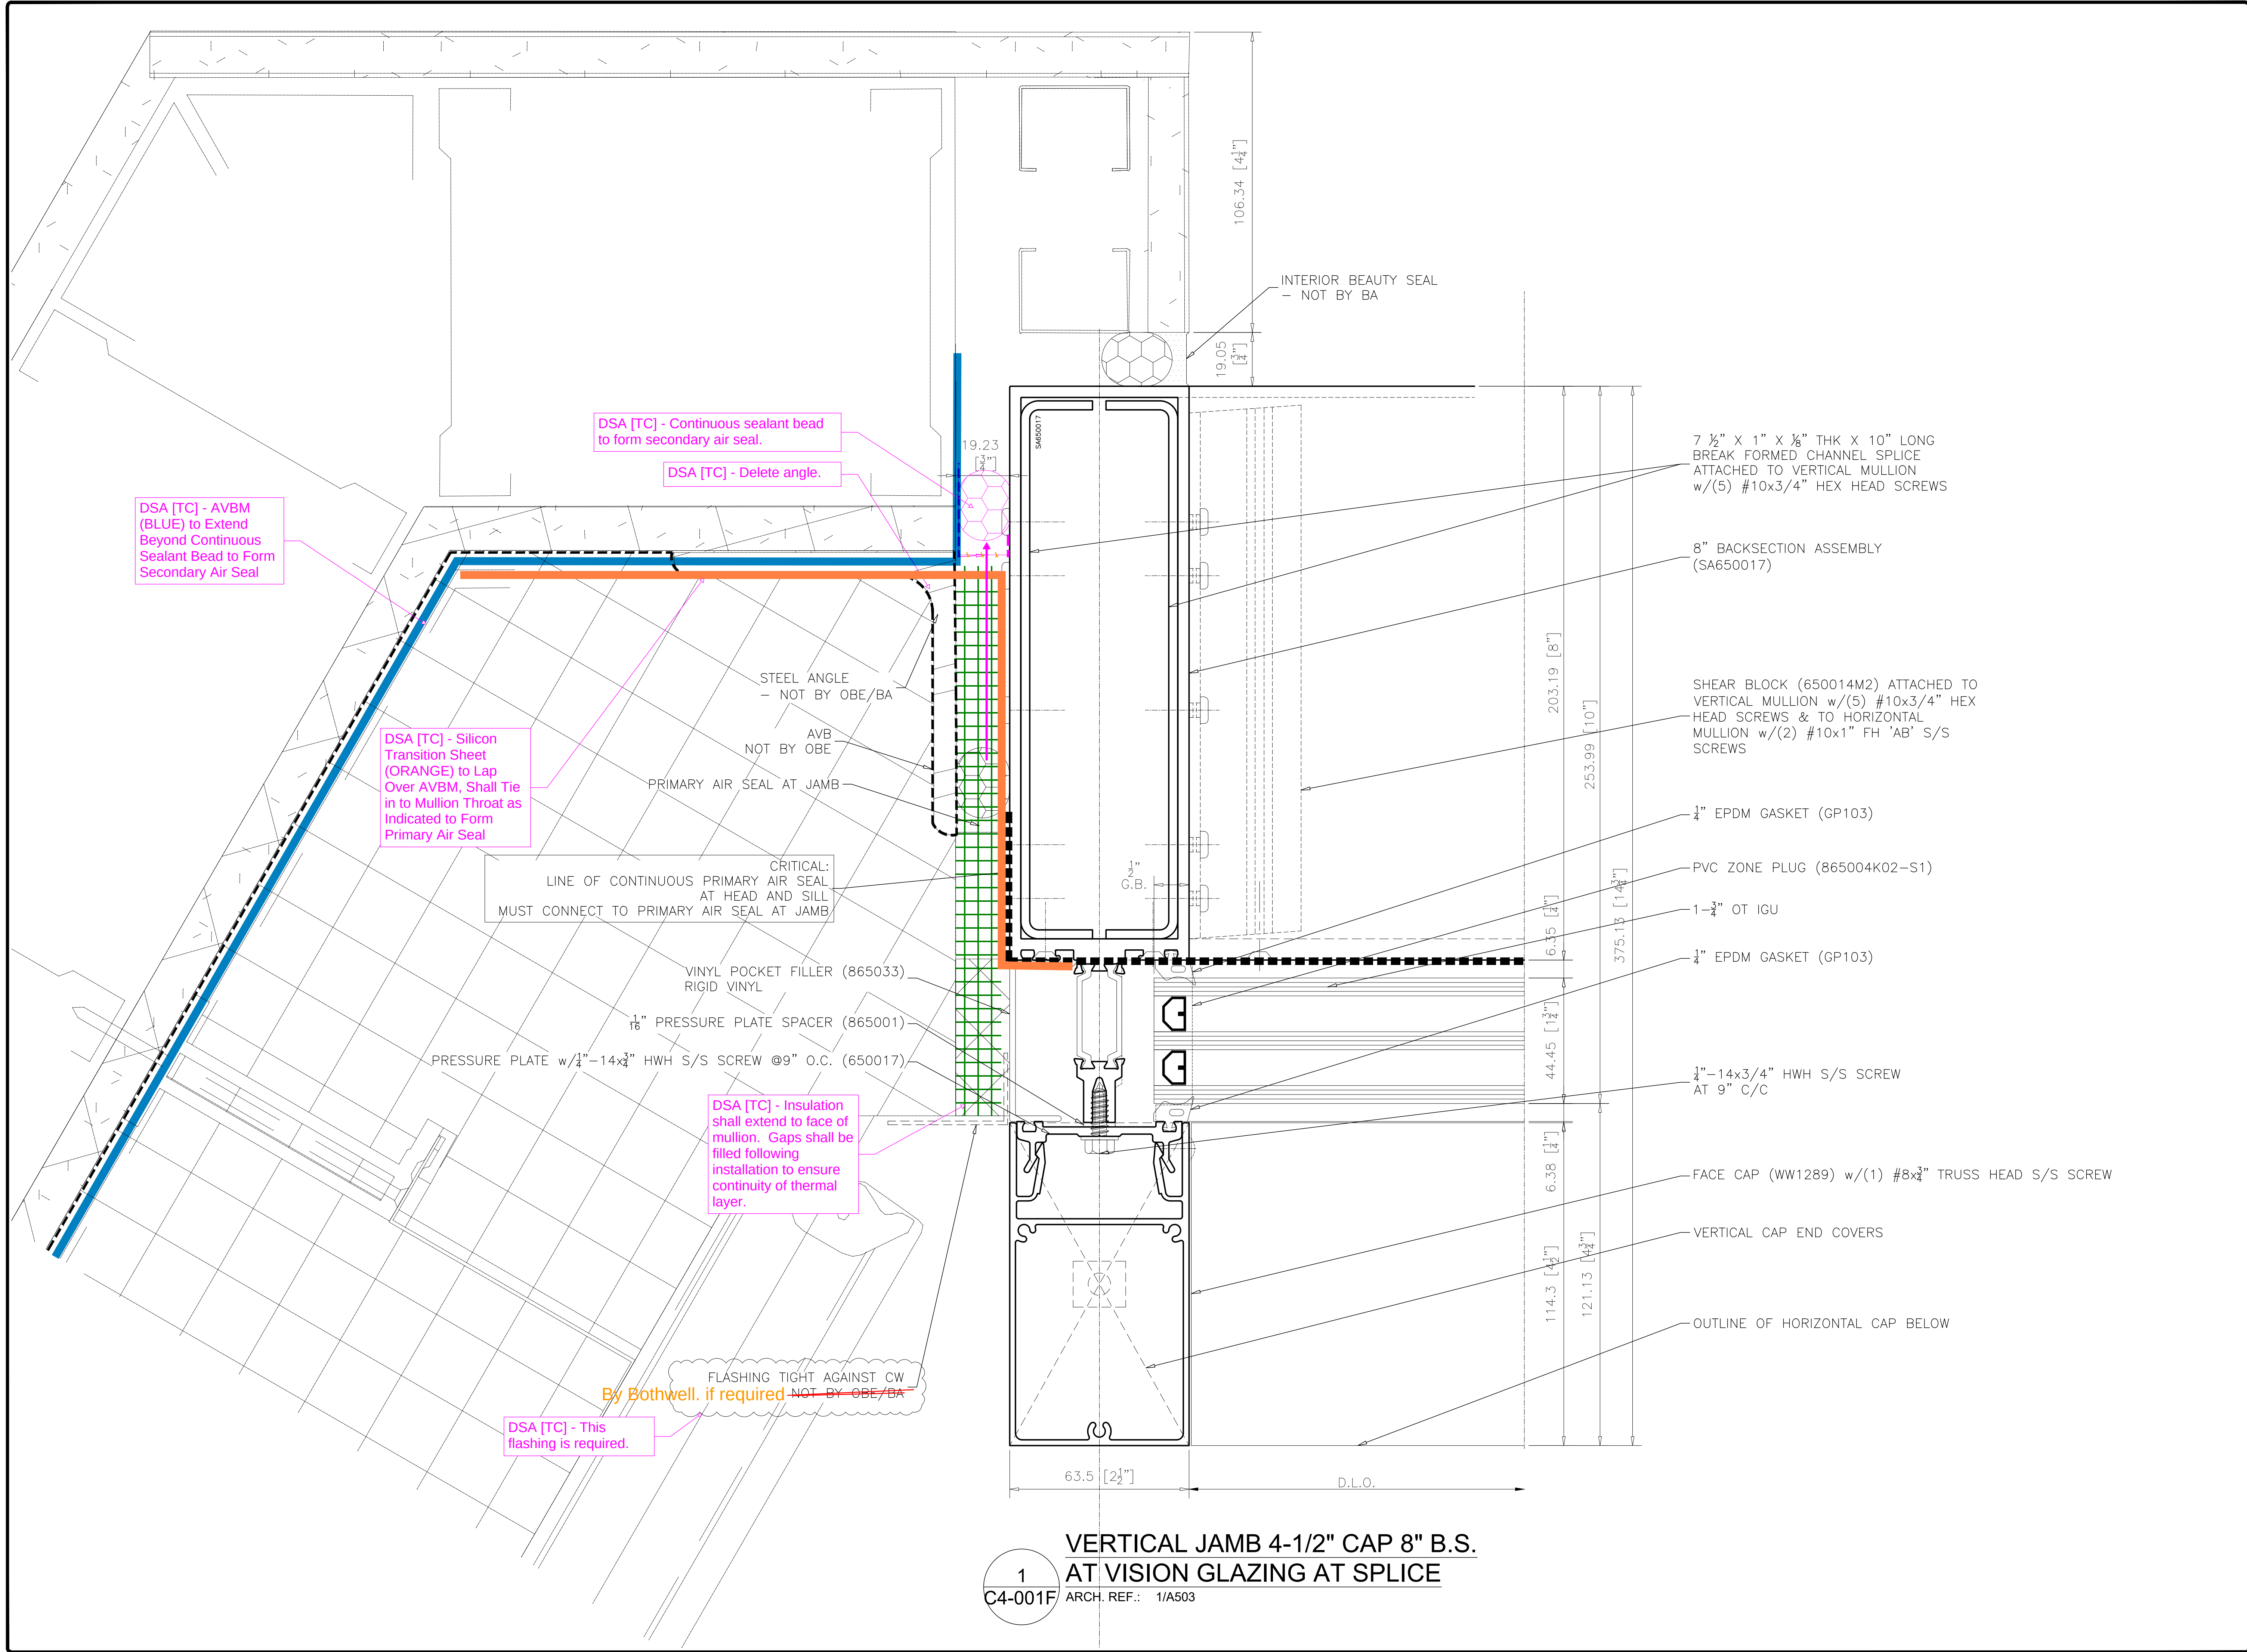


1
C4-001F

VERTICAL JAMB 4-1/2" CAP 8" B.S.
AT VISION GLAZING AT SPLICE

ARCH. REF.: 1/A503

REVISIONS			
No.	Description:	Date:	By:
1	Revised per arch. markups received Feb 11/26	03/03/26	SLR

Project Name: DOCKSTEADER PRPS	Project Location: BRAMPTON, ONTARIO	Architect Name: DIAMOND SCHMITT ARCHITECTS	Customer Name: BOTHWELL ACCURATE GLAZING
-----------------------------------	--	---	---

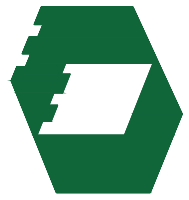


Oldcastle BuildingEnvelope®

275 Britannia Road East • Mississauga • Ontario • Canada • L4Z2E7
905-890-6970 • oldcastlebe.com

Drawing Name:
PLAN DETAIL

Drawn By: SR	Checked By: NP
Drawn Date: 2026/01/12	Issue No.: 1
Scale: 1"=1"	Release Date: 2026/03/03

Drawing Number:
C4-001F

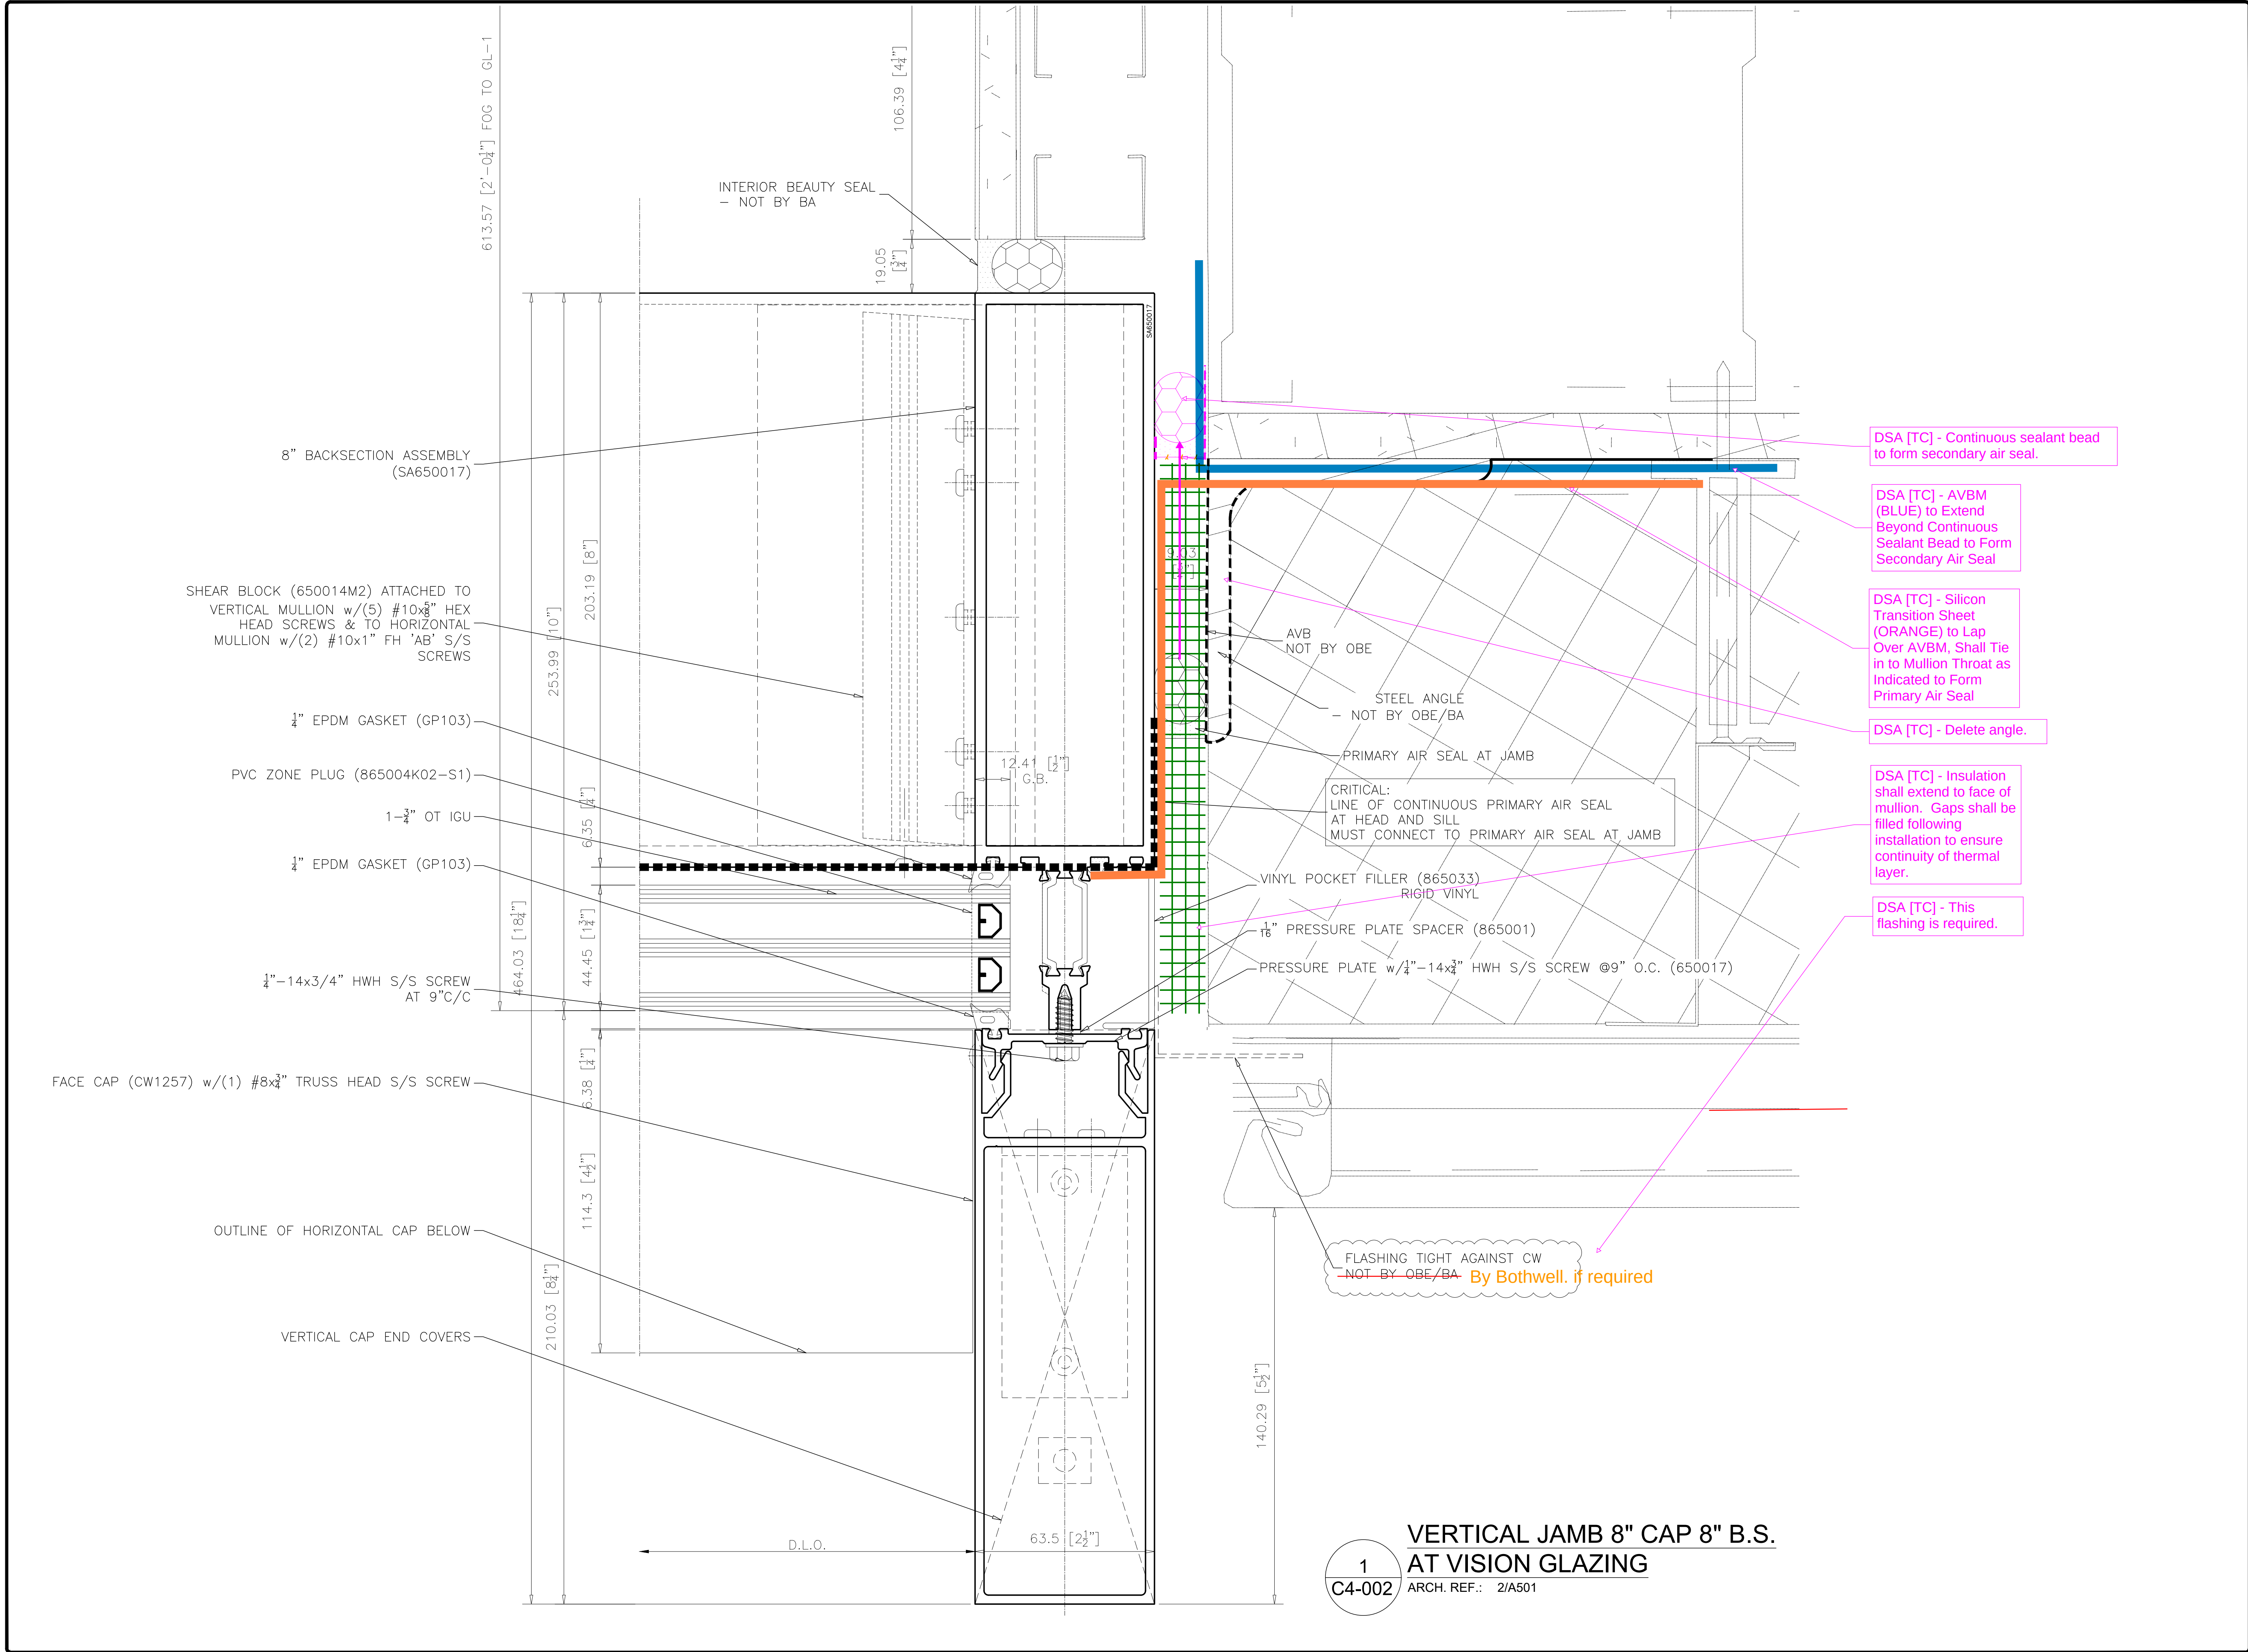

1
C4-002

VERTICAL JAMB 8" CAP 8" B.S.
AT VISION GLAZING

ARCH. REF.: 2/A501

REVISIONS			
No.	Description:	Date:	By:
1	Revised per arch. markups received Feb 11/26	03/03/26	SLR

Project Name: DOCKSTEADER PRPS	Project Location: BRAMPTON, ONTARIO	Architect Name: DIAMOND SCHMITT ARCHITECTS	Customer Name: BOTHWELL ACCURATE GLAZING
-----------------------------------	--	---	---

Oldcastle BuildingEnvelope®

2775 Britannia Road East • Mississauga • Ontario • Canada • L4Z2E7
905-890-6970 • oldcastlebe.com

Drawing Name: PLAN DETAIL	
Drawn By: SR	Checked By: NP
Drawn Date: 2026/01/12	Issue No.: 1
Scale: 1"=1'	Release Date: 2026/03/03
Drawing Number: C4-002	