


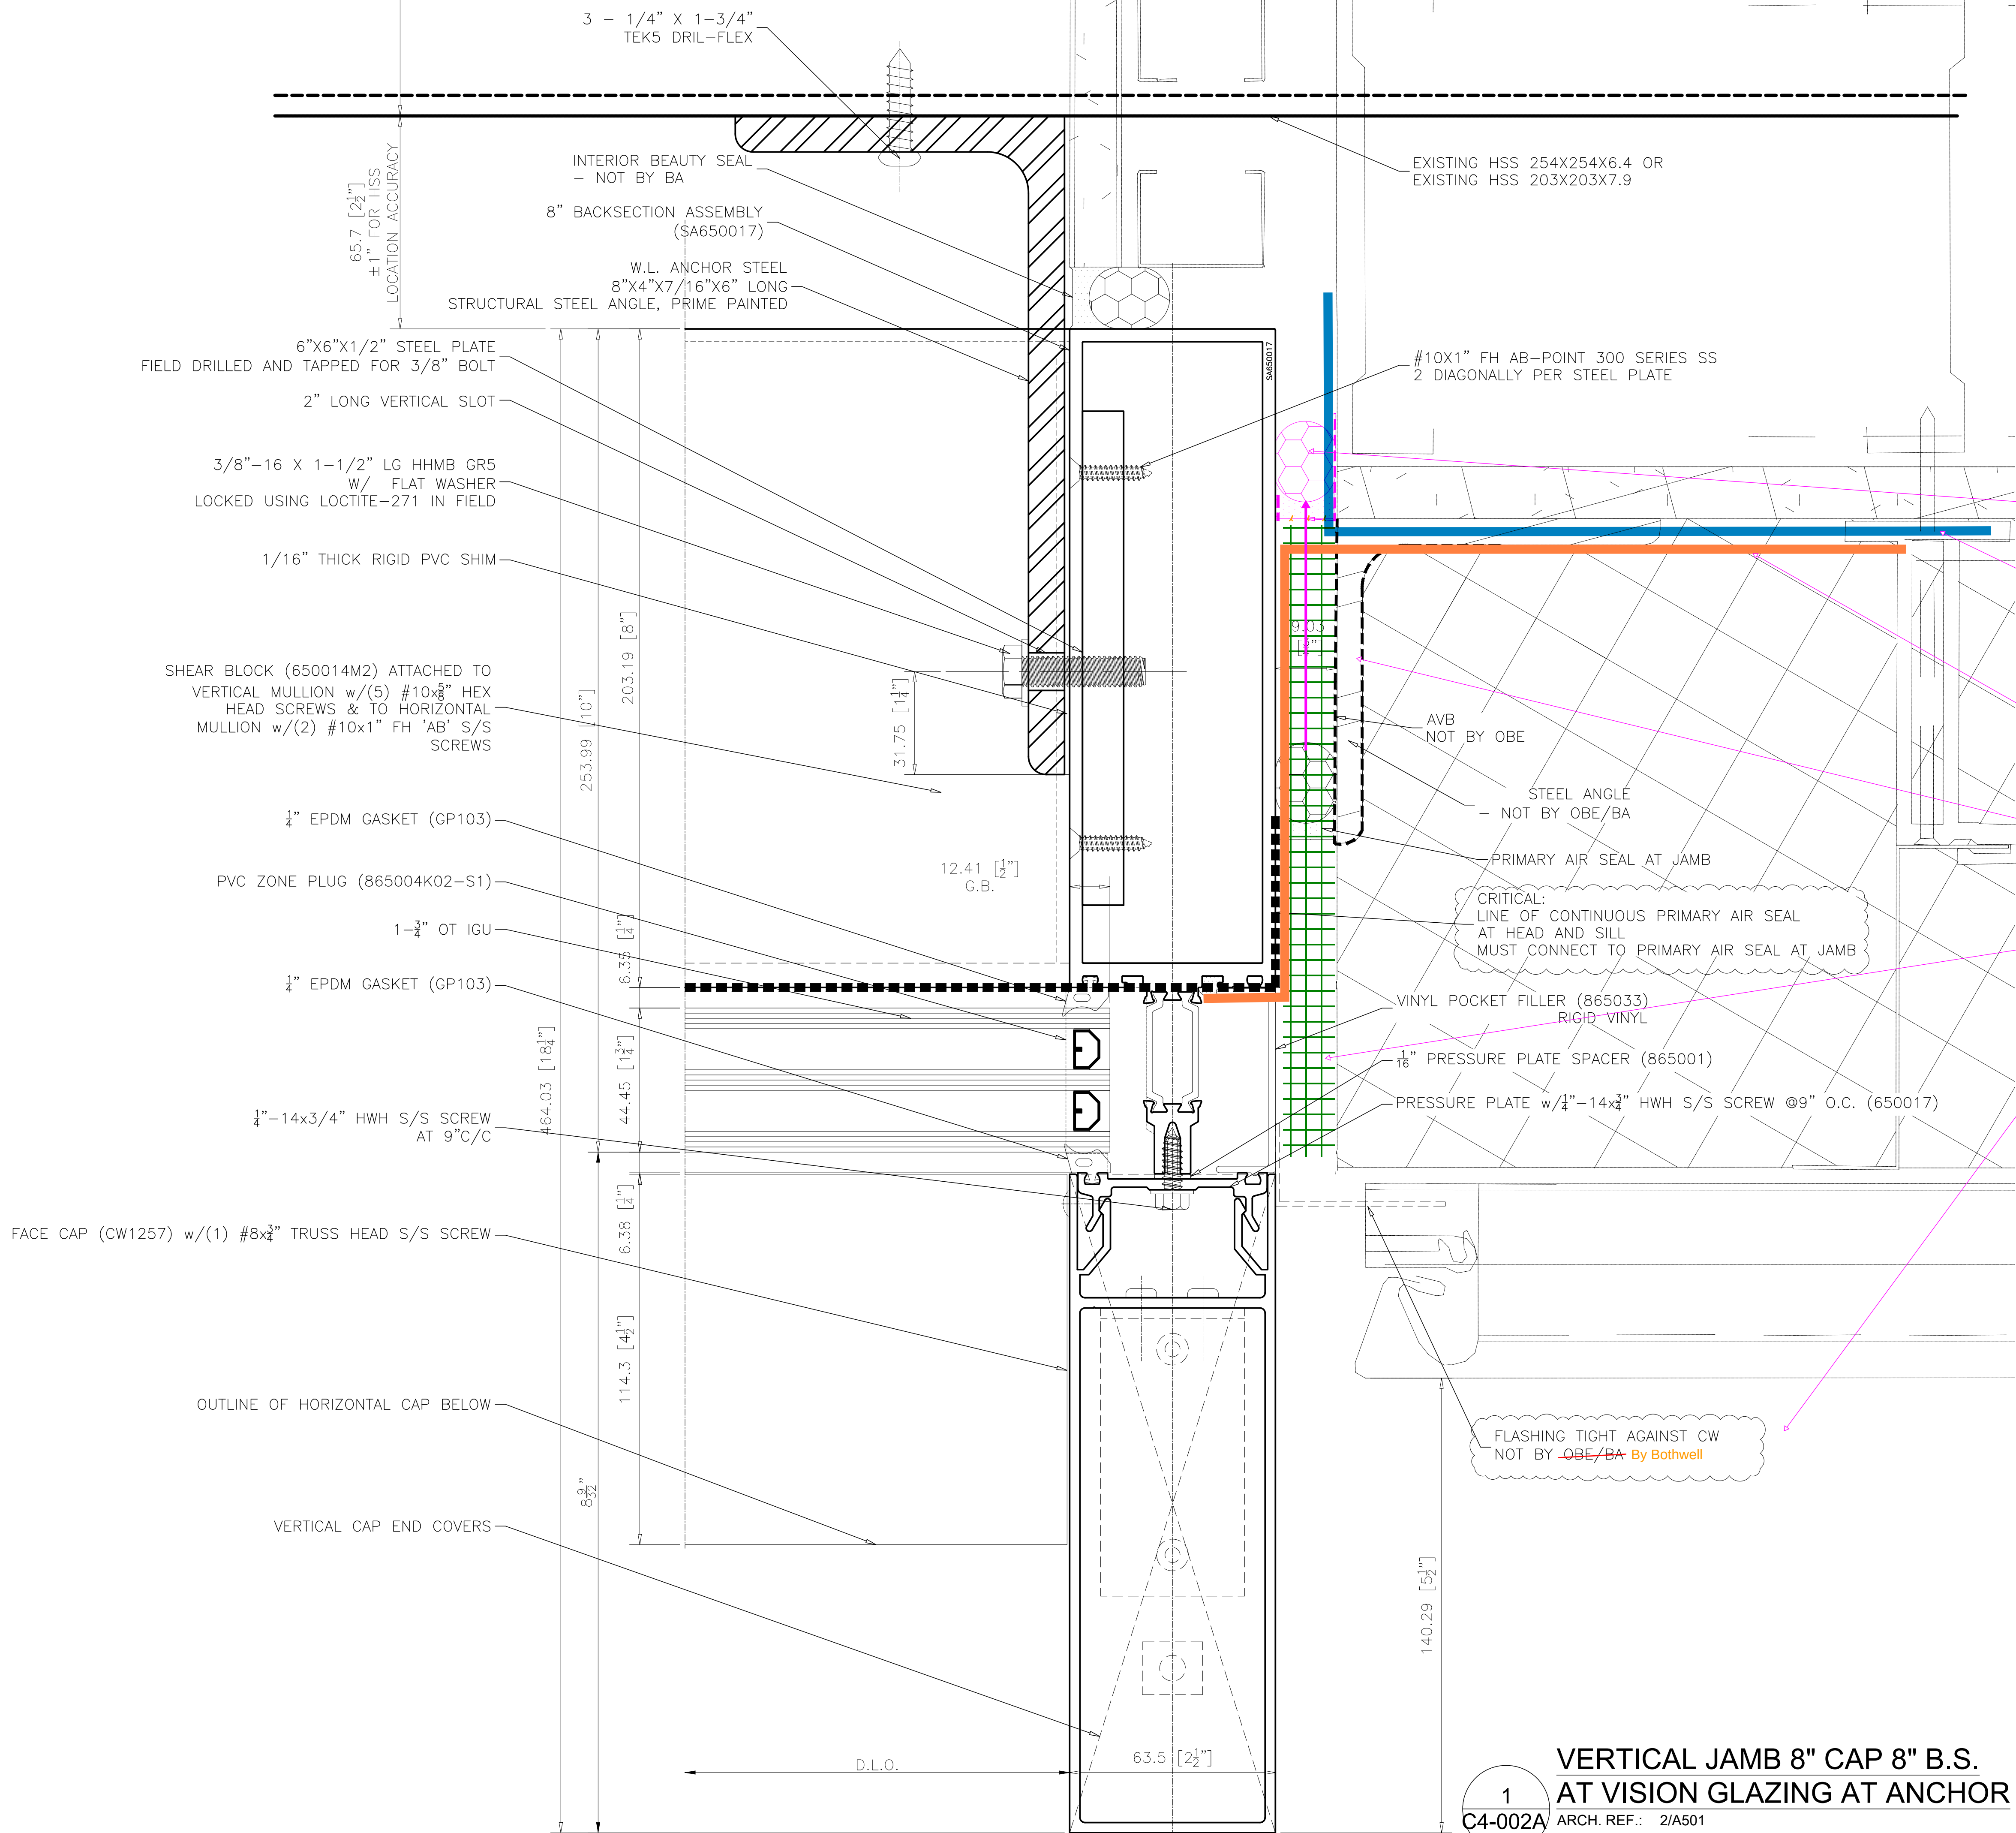

1  
C4-002A

VERTICAL JAMB 8" CAP 8" B.S.  
AT VISION GLAZING AT ANCHOR

ARCH. REF.: 2/A501

| REVISIONS |                                              |          |     |
|-----------|----------------------------------------------|----------|-----|
| No.       | Description:                                 | Date:    | By: |
| 1         | Revised per arch. markups received Feb 11/26 | 03/03/26 | SLR |
|           |                                              |          |     |
|           |                                              |          |     |
|                                   |                                        |                                               |                                             |
|-----------------------------------|----------------------------------------|-----------------------------------------------|---------------------------------------------|
| Project Name:<br>DOCKSTEADER PRPS | Project Location:<br>BRAMPTON, ONTARIO | Architect Name:<br>DIAMOND SCHMITT ARCHITECTS | Customer Name:<br>BOTHWELL ACCURATE GLAZING |
|-----------------------------------|----------------------------------------|-----------------------------------------------|---------------------------------------------|




275 Britannia Road East • Mississauga • Ontario • Canada • L4Z2E7  
905-890-6970 • oldcastlebe.com

Drawing Name:  
PLAN DETAIL

|                           |                             |
|---------------------------|-----------------------------|
| Drawn By:<br>SR           | Checked By:<br>NP           |
| Drawn Date:<br>2026/01/12 | Issue No.:<br>1             |
| Scale:<br>1"=1"           | Release Date:<br>2026/03/03 |

Drawing Number:  
C4-002A

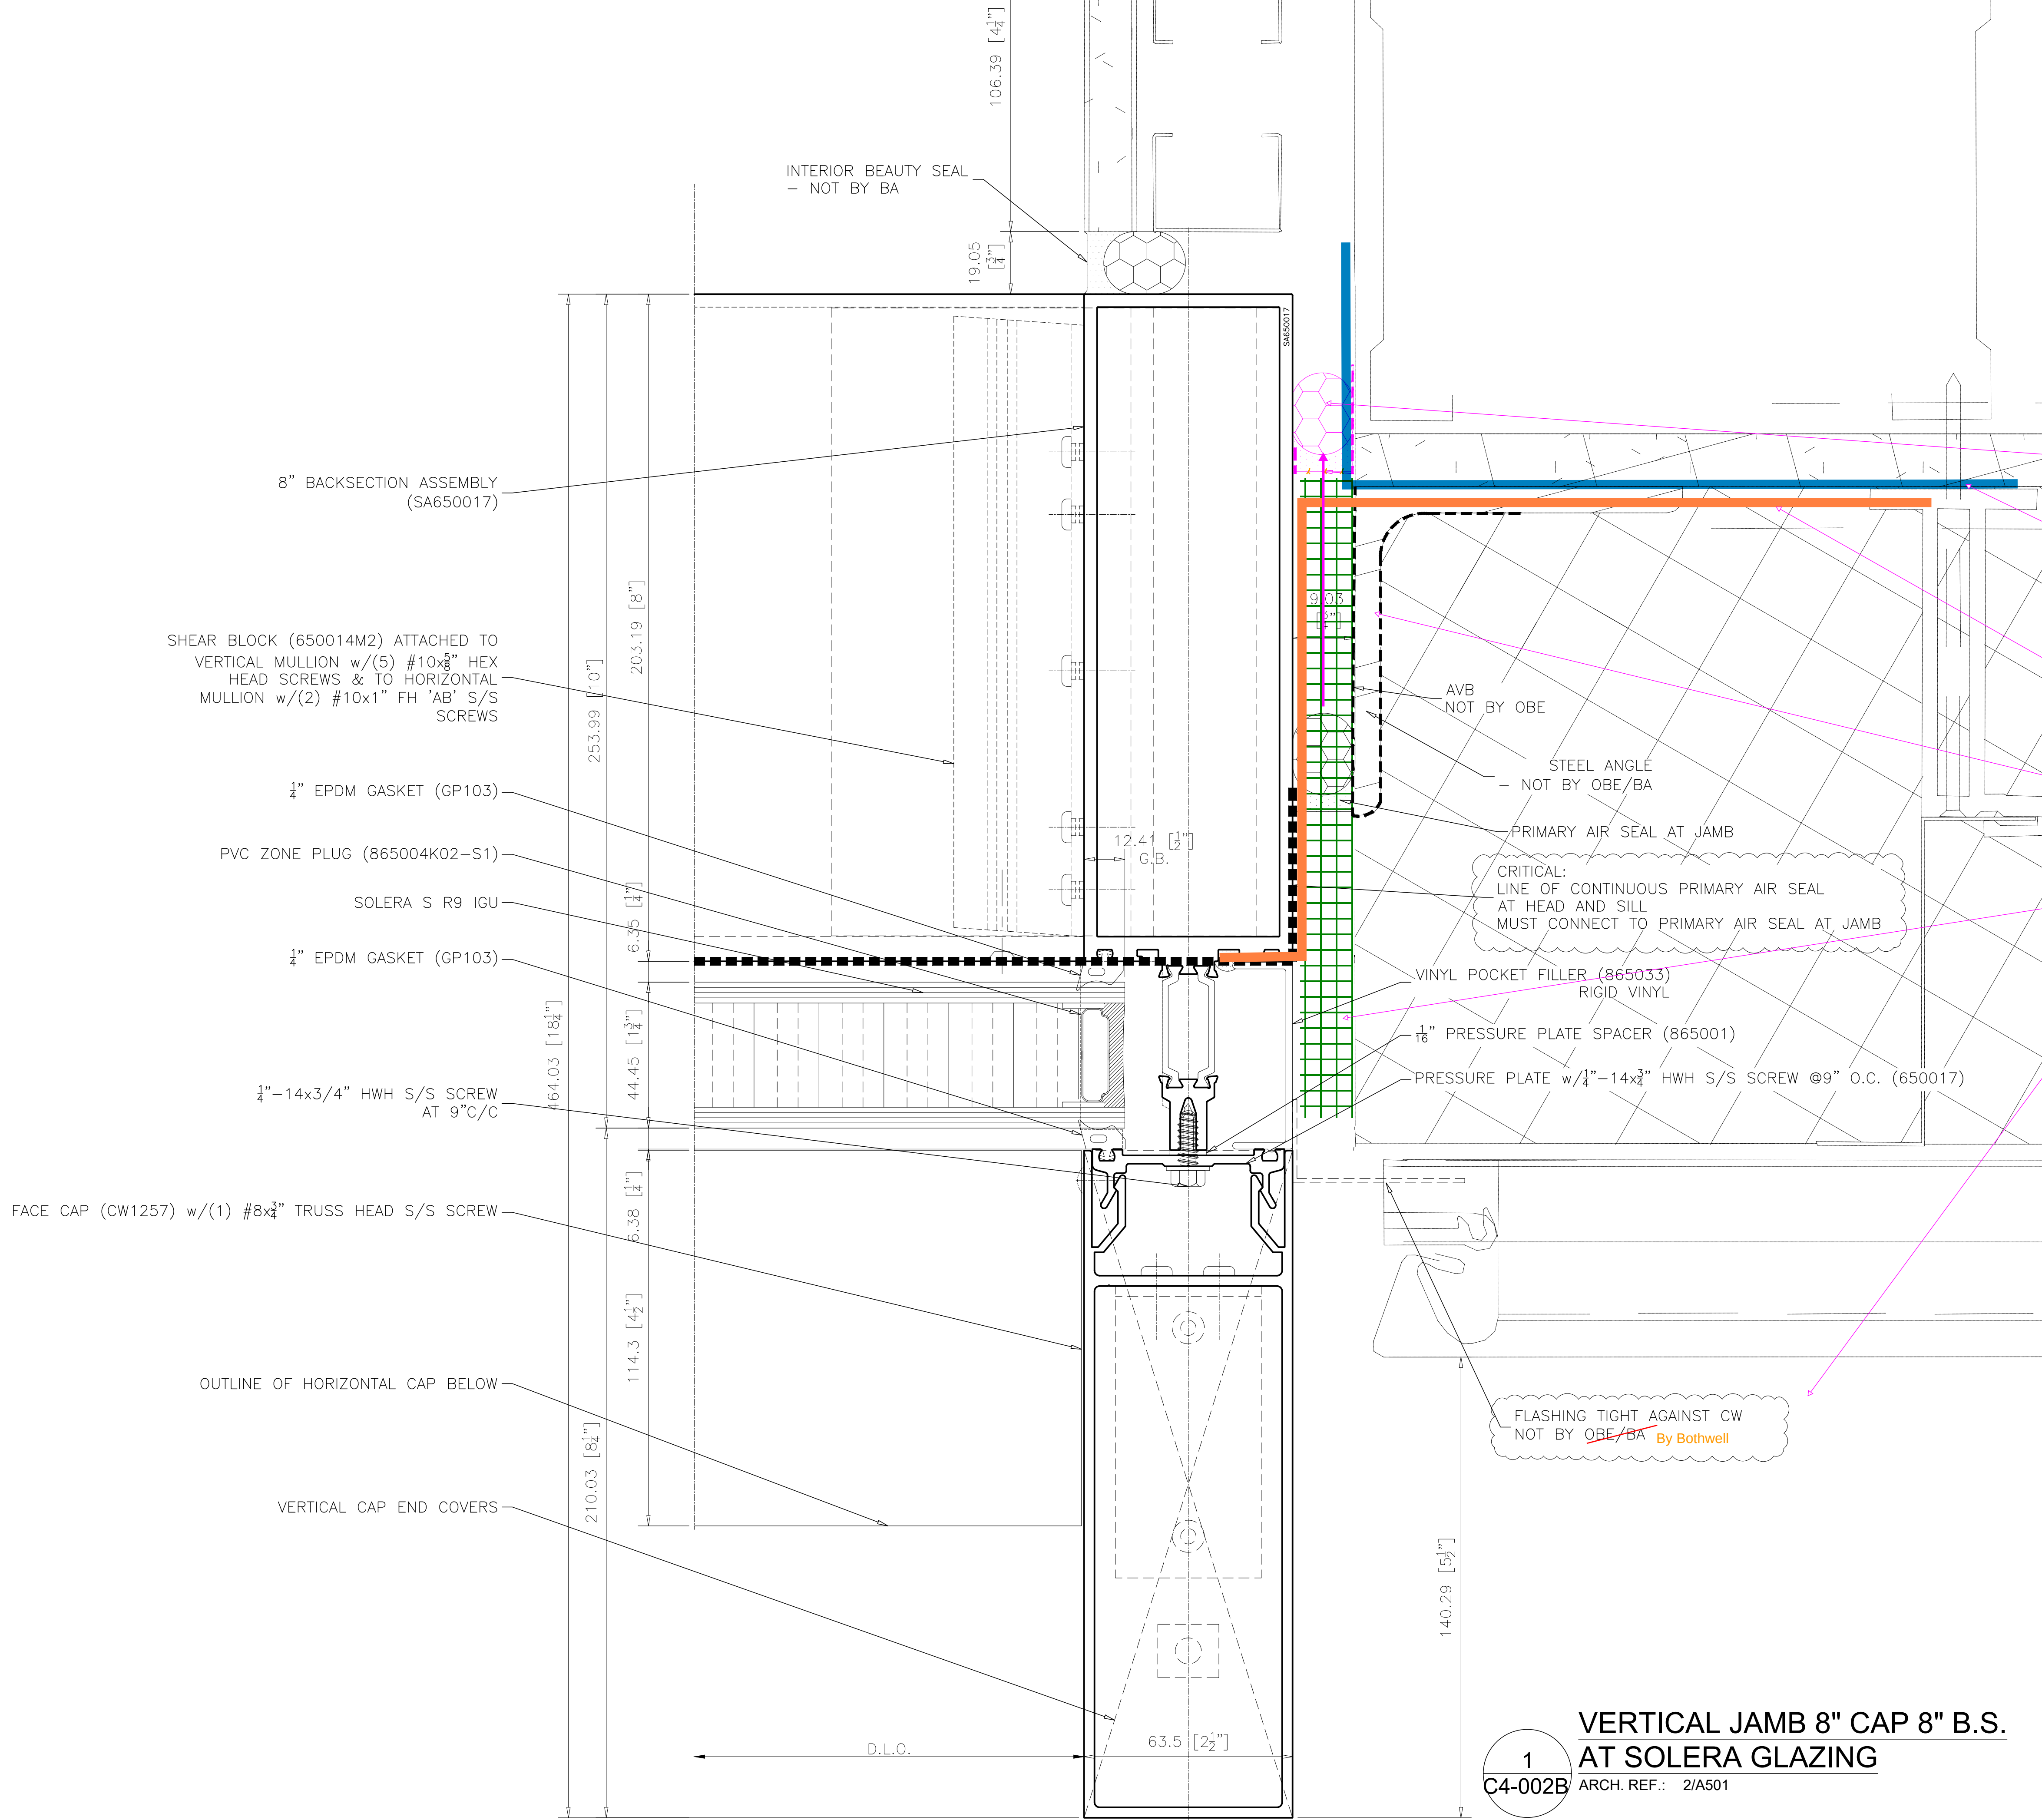

1  
C4-002B

VERTICAL JAMB 8" CAP 8" B.S.  
AT SOLERA GLAZING

ARCH. REF.: 2/A501

- DSA [TC] - Continuous sealant bead to form secondary air seal.
- DSA [TC] - AVBM (BLUE) to Extend Beyond Continuous Sealant Bead to Form Secondary Air Seal
- DSA [TC] - Silicon Transition Sheet (ORANGE) to Lap Over AVBM, Shall Tie in to Mullion Throat as Indicated to Form Primary Air Seal
- DSA [TC] - Delete angle.
- DSA [TC] - Insulation shall extend to face of mullion. Gaps shall be filled following installation to ensure continuity of thermal layer.
- DSA [TC] - This flashing is required.


| REVISIONS |                                              |          |     |
|-----------|----------------------------------------------|----------|-----|
| No.       | Description:                                 | Date:    | By: |
| 1         | Revised per arch. markups received Feb 11/26 | 03/03/26 | SLR |
|           |                                              |          |     |
|           |                                              |          |     |
|                                   |                                        |                                               |                                             |
|-----------------------------------|----------------------------------------|-----------------------------------------------|---------------------------------------------|
| Project Name:<br>DOCKSTEADER PRPS | Project Location:<br>BRAMPTON, ONTARIO | Architect Name:<br>DIAMOND SCHMITT ARCHITECTS | Customer Name:<br>BOTHWELL ACCURATE GLAZING |
|-----------------------------------|----------------------------------------|-----------------------------------------------|---------------------------------------------|



275 Britannia Road East • Mississauga • Ontario • Canada • L4Z2E7  
905-890-6970 • oldcastlebe.com

|                              |                             |
|------------------------------|-----------------------------|
| Drawing Name:<br>PLAN DETAIL |                             |
| Drawn By:<br>SR              | Checked By:<br>NP           |
| Drawn Date:<br>2026/01/12    | Issue No.:<br>1             |
| Scale:<br>1"=1'              | Release Date:<br>2026/03/03 |
| Drawing Number:<br>C4-002B   |                             |

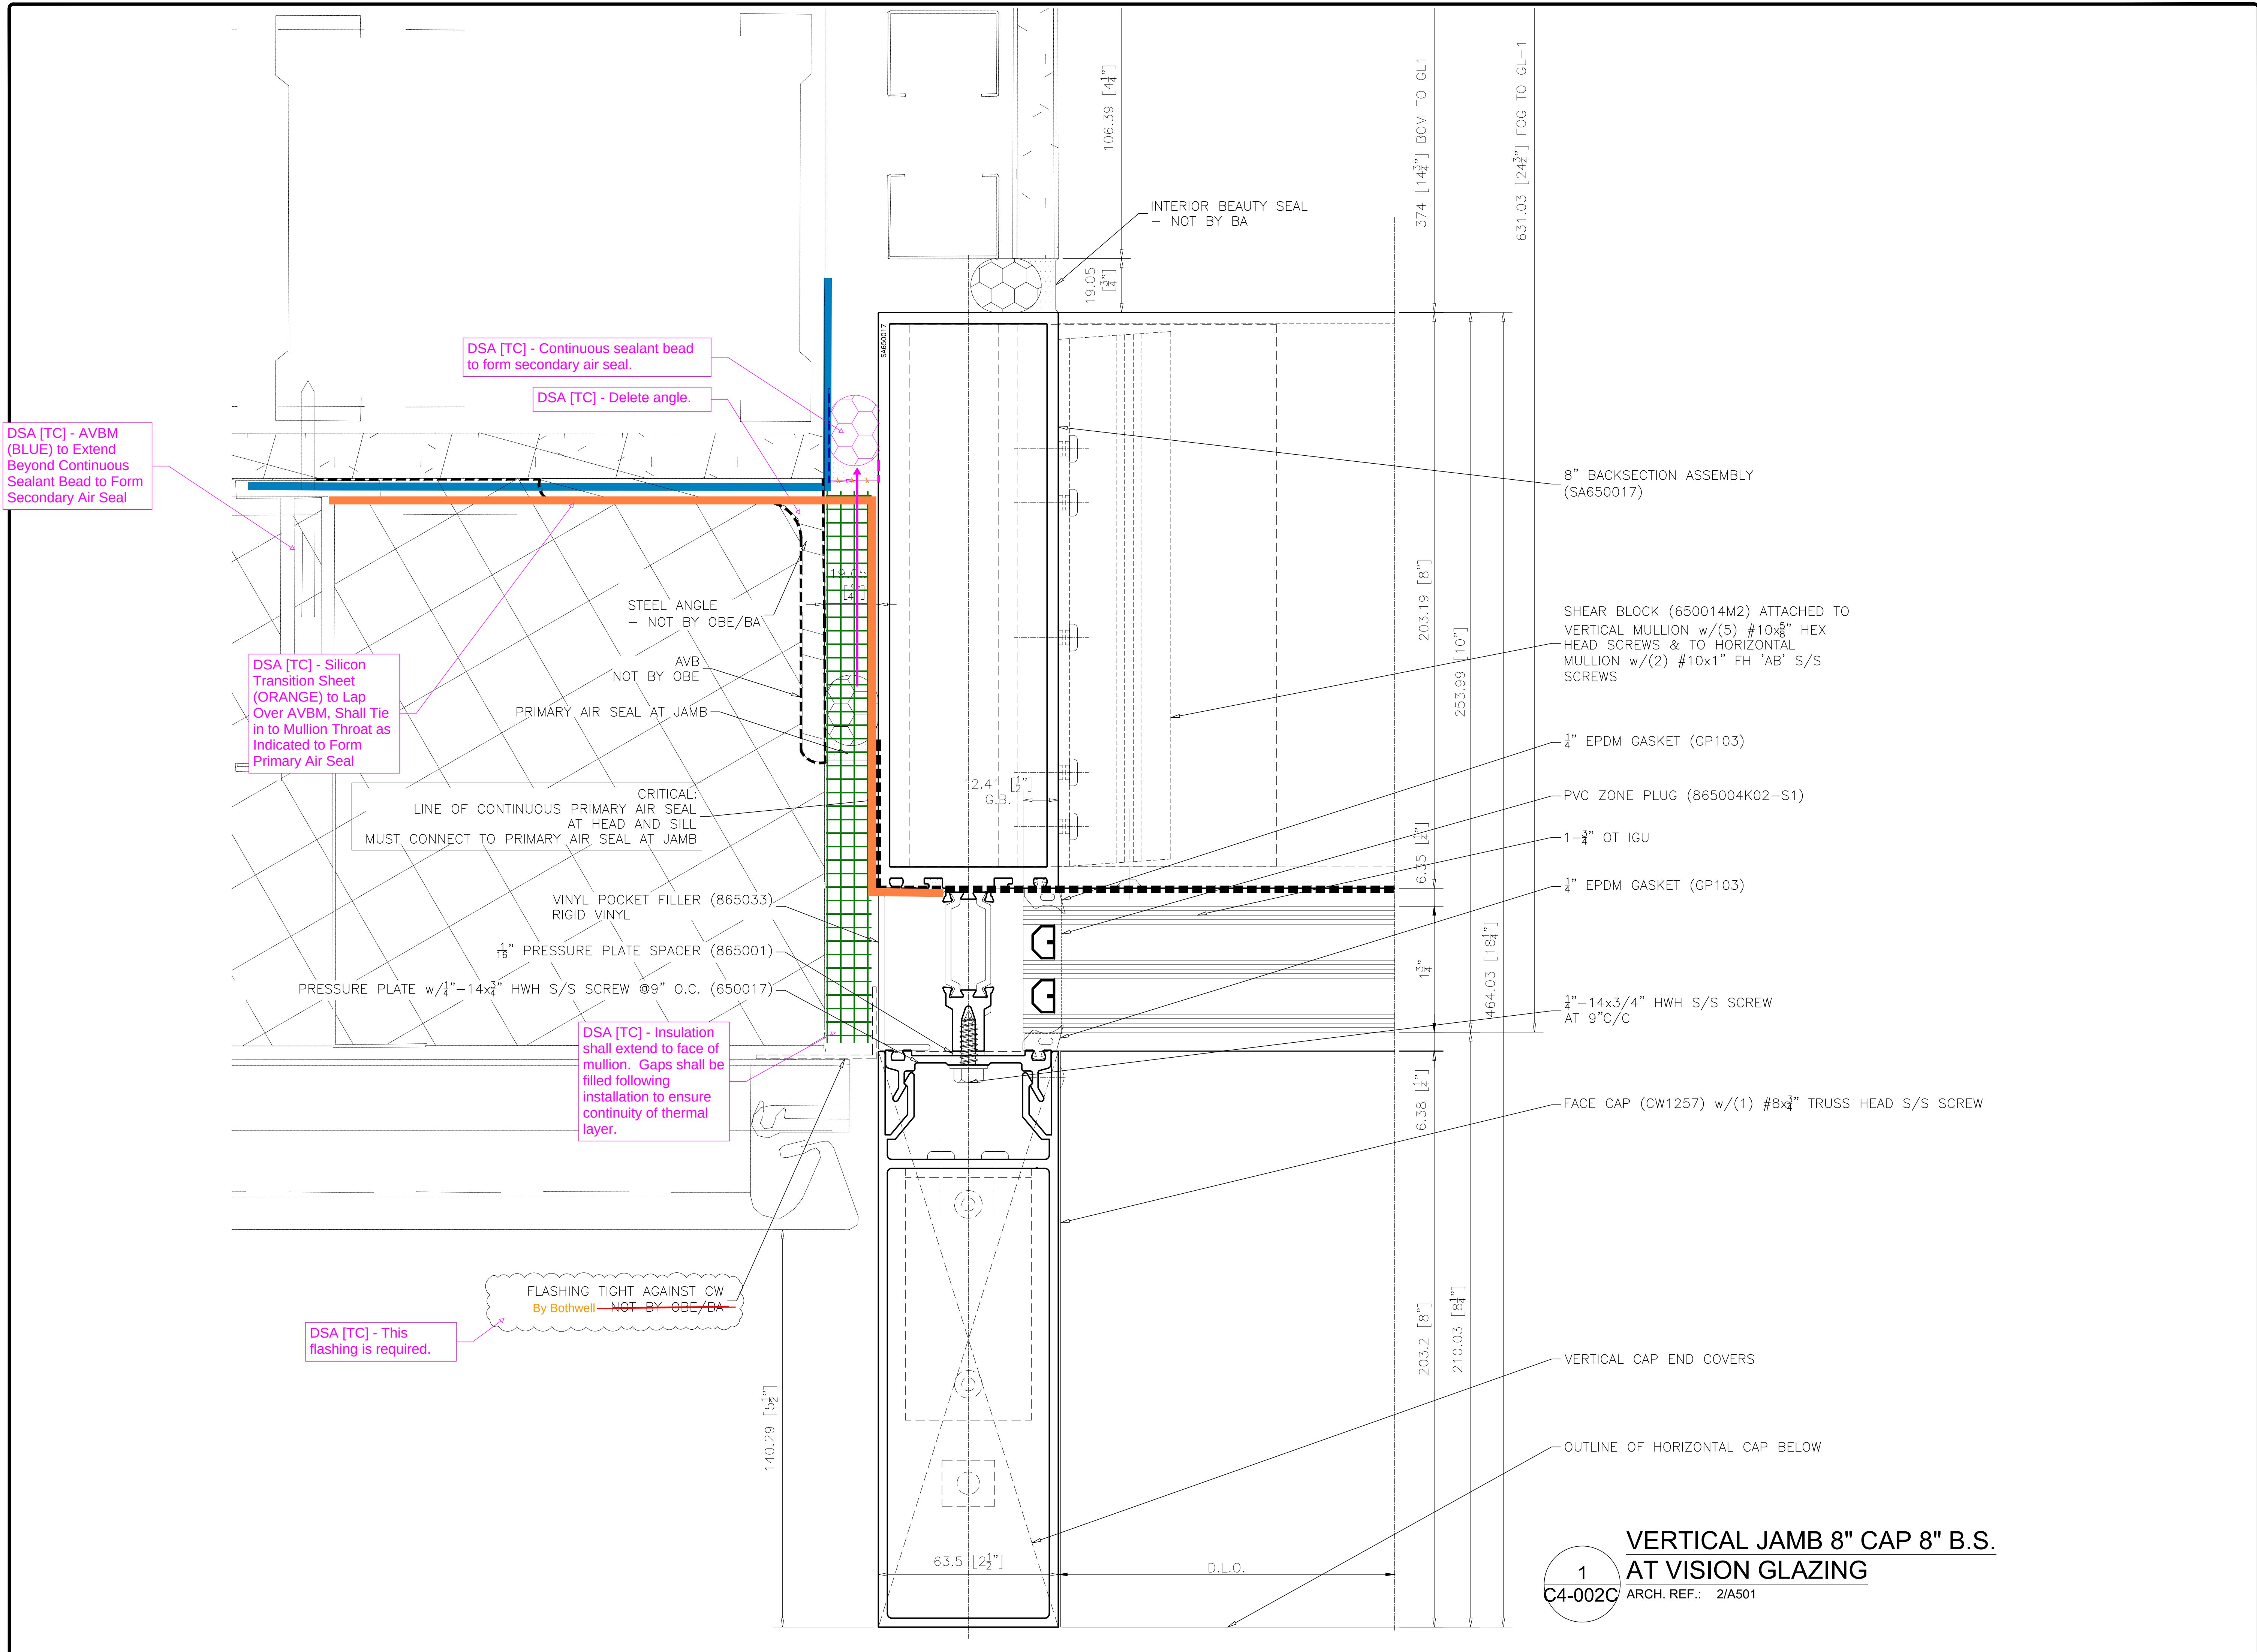


1  
C4-002C

VERTICAL JAMB 8" CAP 8" B.S.  
AT VISION GLAZING

ARCH. REF.: 2/A501

| REVISIONS |                                              |          |     |
|-----------|----------------------------------------------|----------|-----|
| No.       | Description:                                 | Date:    | By: |
| 1         | Revised per arch. markups received Feb 11/26 | 03/03/26 | SLR |
|           |                                              |          |     |
|           |                                              |          |     |
|                                   |                                        |                                               |                                             |
|-----------------------------------|----------------------------------------|-----------------------------------------------|---------------------------------------------|
| Project Name:<br>DOCKSTEADER PRPS | Project Location:<br>BRAMPTON, ONTARIO | Architect Name:<br>DIAMOND SCHMITT ARCHITECTS | Customer Name:<br>BOTHWELL ACCURATE GLAZING |
|-----------------------------------|----------------------------------------|-----------------------------------------------|---------------------------------------------|

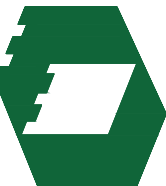**Oldcastle BuildingEnvelope®**

275 Britannia Road East • Mississauga • Ontario • Canada • L4Z2E7  
905-890-6970 • oldcastlebe.com

|                              |                             |
|------------------------------|-----------------------------|
| Drawing Name:<br>PLAN DETAIL |                             |
| Drawn By:<br>SR              | Checked By:<br>NP           |
| Drawn Date:<br>2026/01/12    | Issue No.:<br>1             |
| Scale:<br>1"=1"              | Release Date:<br>2026/03/03 |
| Drawing Number:<br>C4-002C   |                             |


| REVISIONS |                                              |          |     |
|-----------|----------------------------------------------|----------|-----|
| No.       | Description:                                 | Date:    | By: |
| 1         | Revised per arch. markups received Feb 11/26 | 03/03/26 | SLR |
|           |                                              |          |     |
|           |                                              |          |     |
|                                   |                                        |                                               |                                             |
|-----------------------------------|----------------------------------------|-----------------------------------------------|---------------------------------------------|
| Project Name:<br>DOCKSTEADER PRPS | Project Location:<br>BRAMPTON, ONTARIO | Architect Name:<br>DIAMOND SCHMITT ARCHITECTS | Customer Name:<br>BOTHWELL ACCURATE GLAZING |
|-----------------------------------|----------------------------------------|-----------------------------------------------|---------------------------------------------|



275 Britannia Road East • Mississauga • Ontario • Canada • L4Z2E7  
905-890-6970 • oldcastlebe.com

|                              |                             |
|------------------------------|-----------------------------|
| Drawing Name:<br>PLAN DETAIL |                             |
| Drawn By:<br>SR              | Checked By:<br>NP           |
| Drawn Date:<br>2026/01/12    | Issue No.:<br>1             |
| Scale:<br>1"=1"              | Release Date:<br>2026/03/03 |
| Drawing Number:<br>C4-002D   |                             |

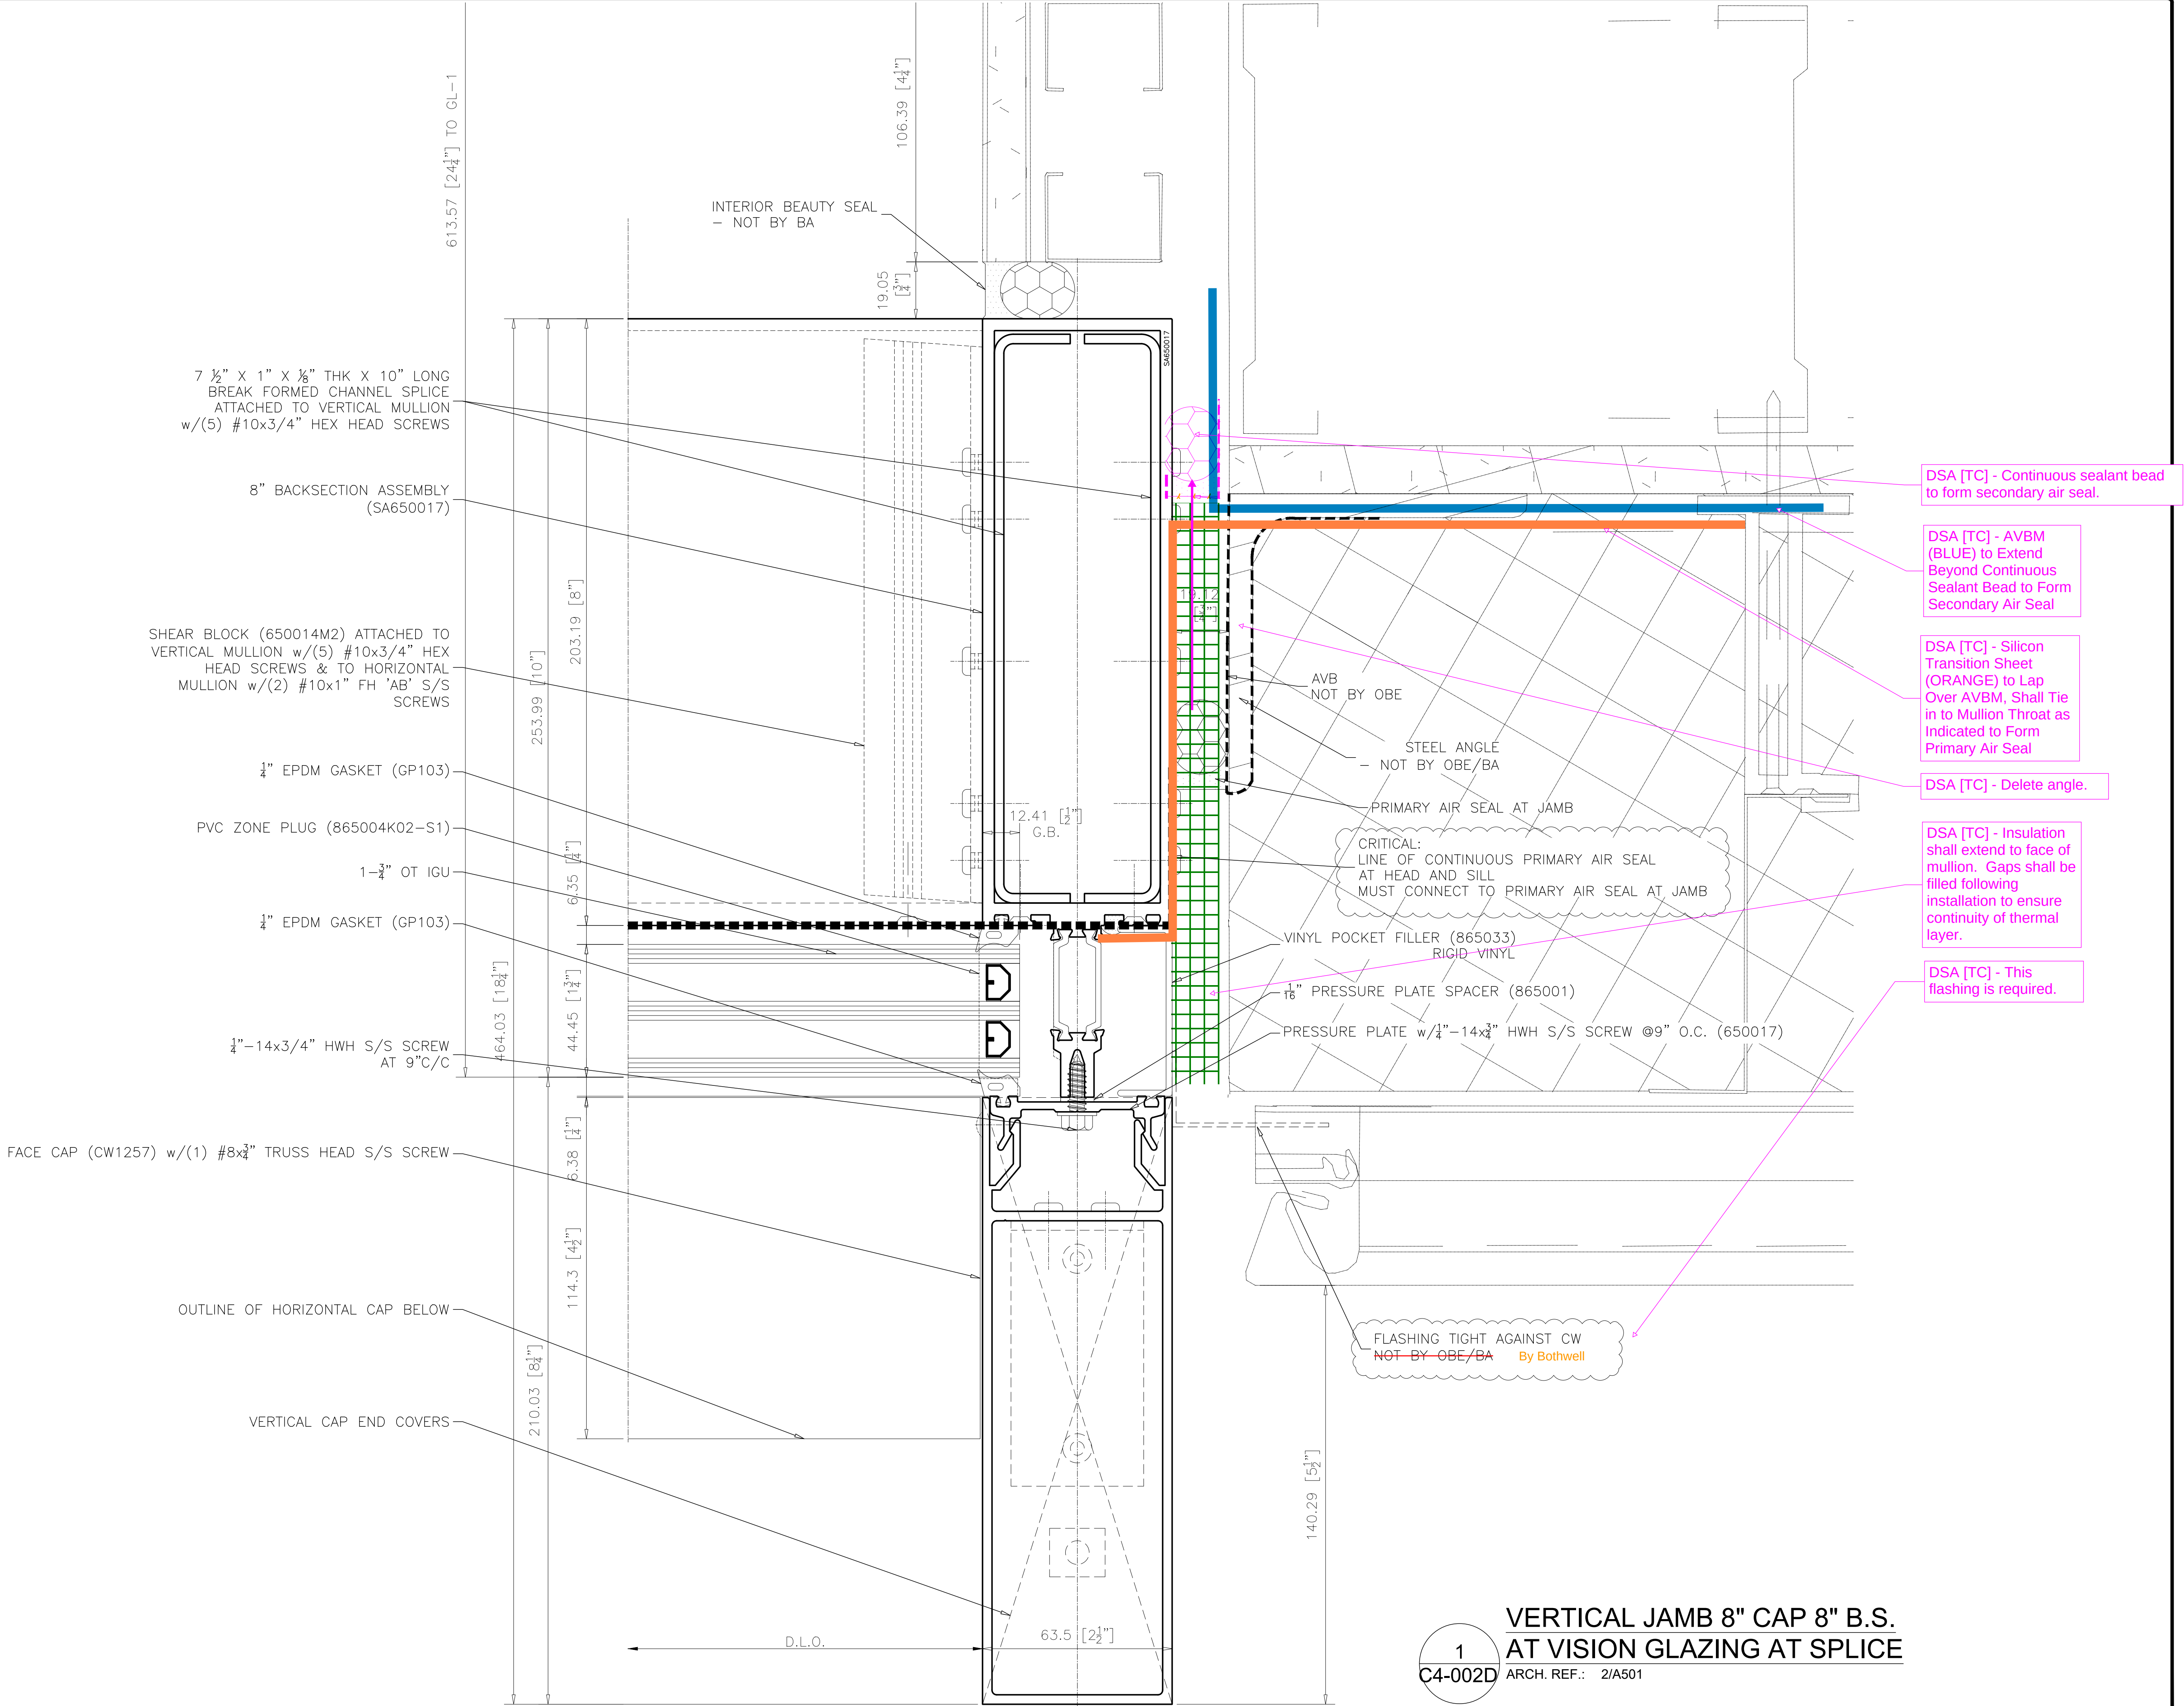


1

C4-002D

VERTICAL JAMB 8" CAP 8" B.S.  
AT VISION GLAZING AT SPLICE

ARCH. REF.: 2/A501

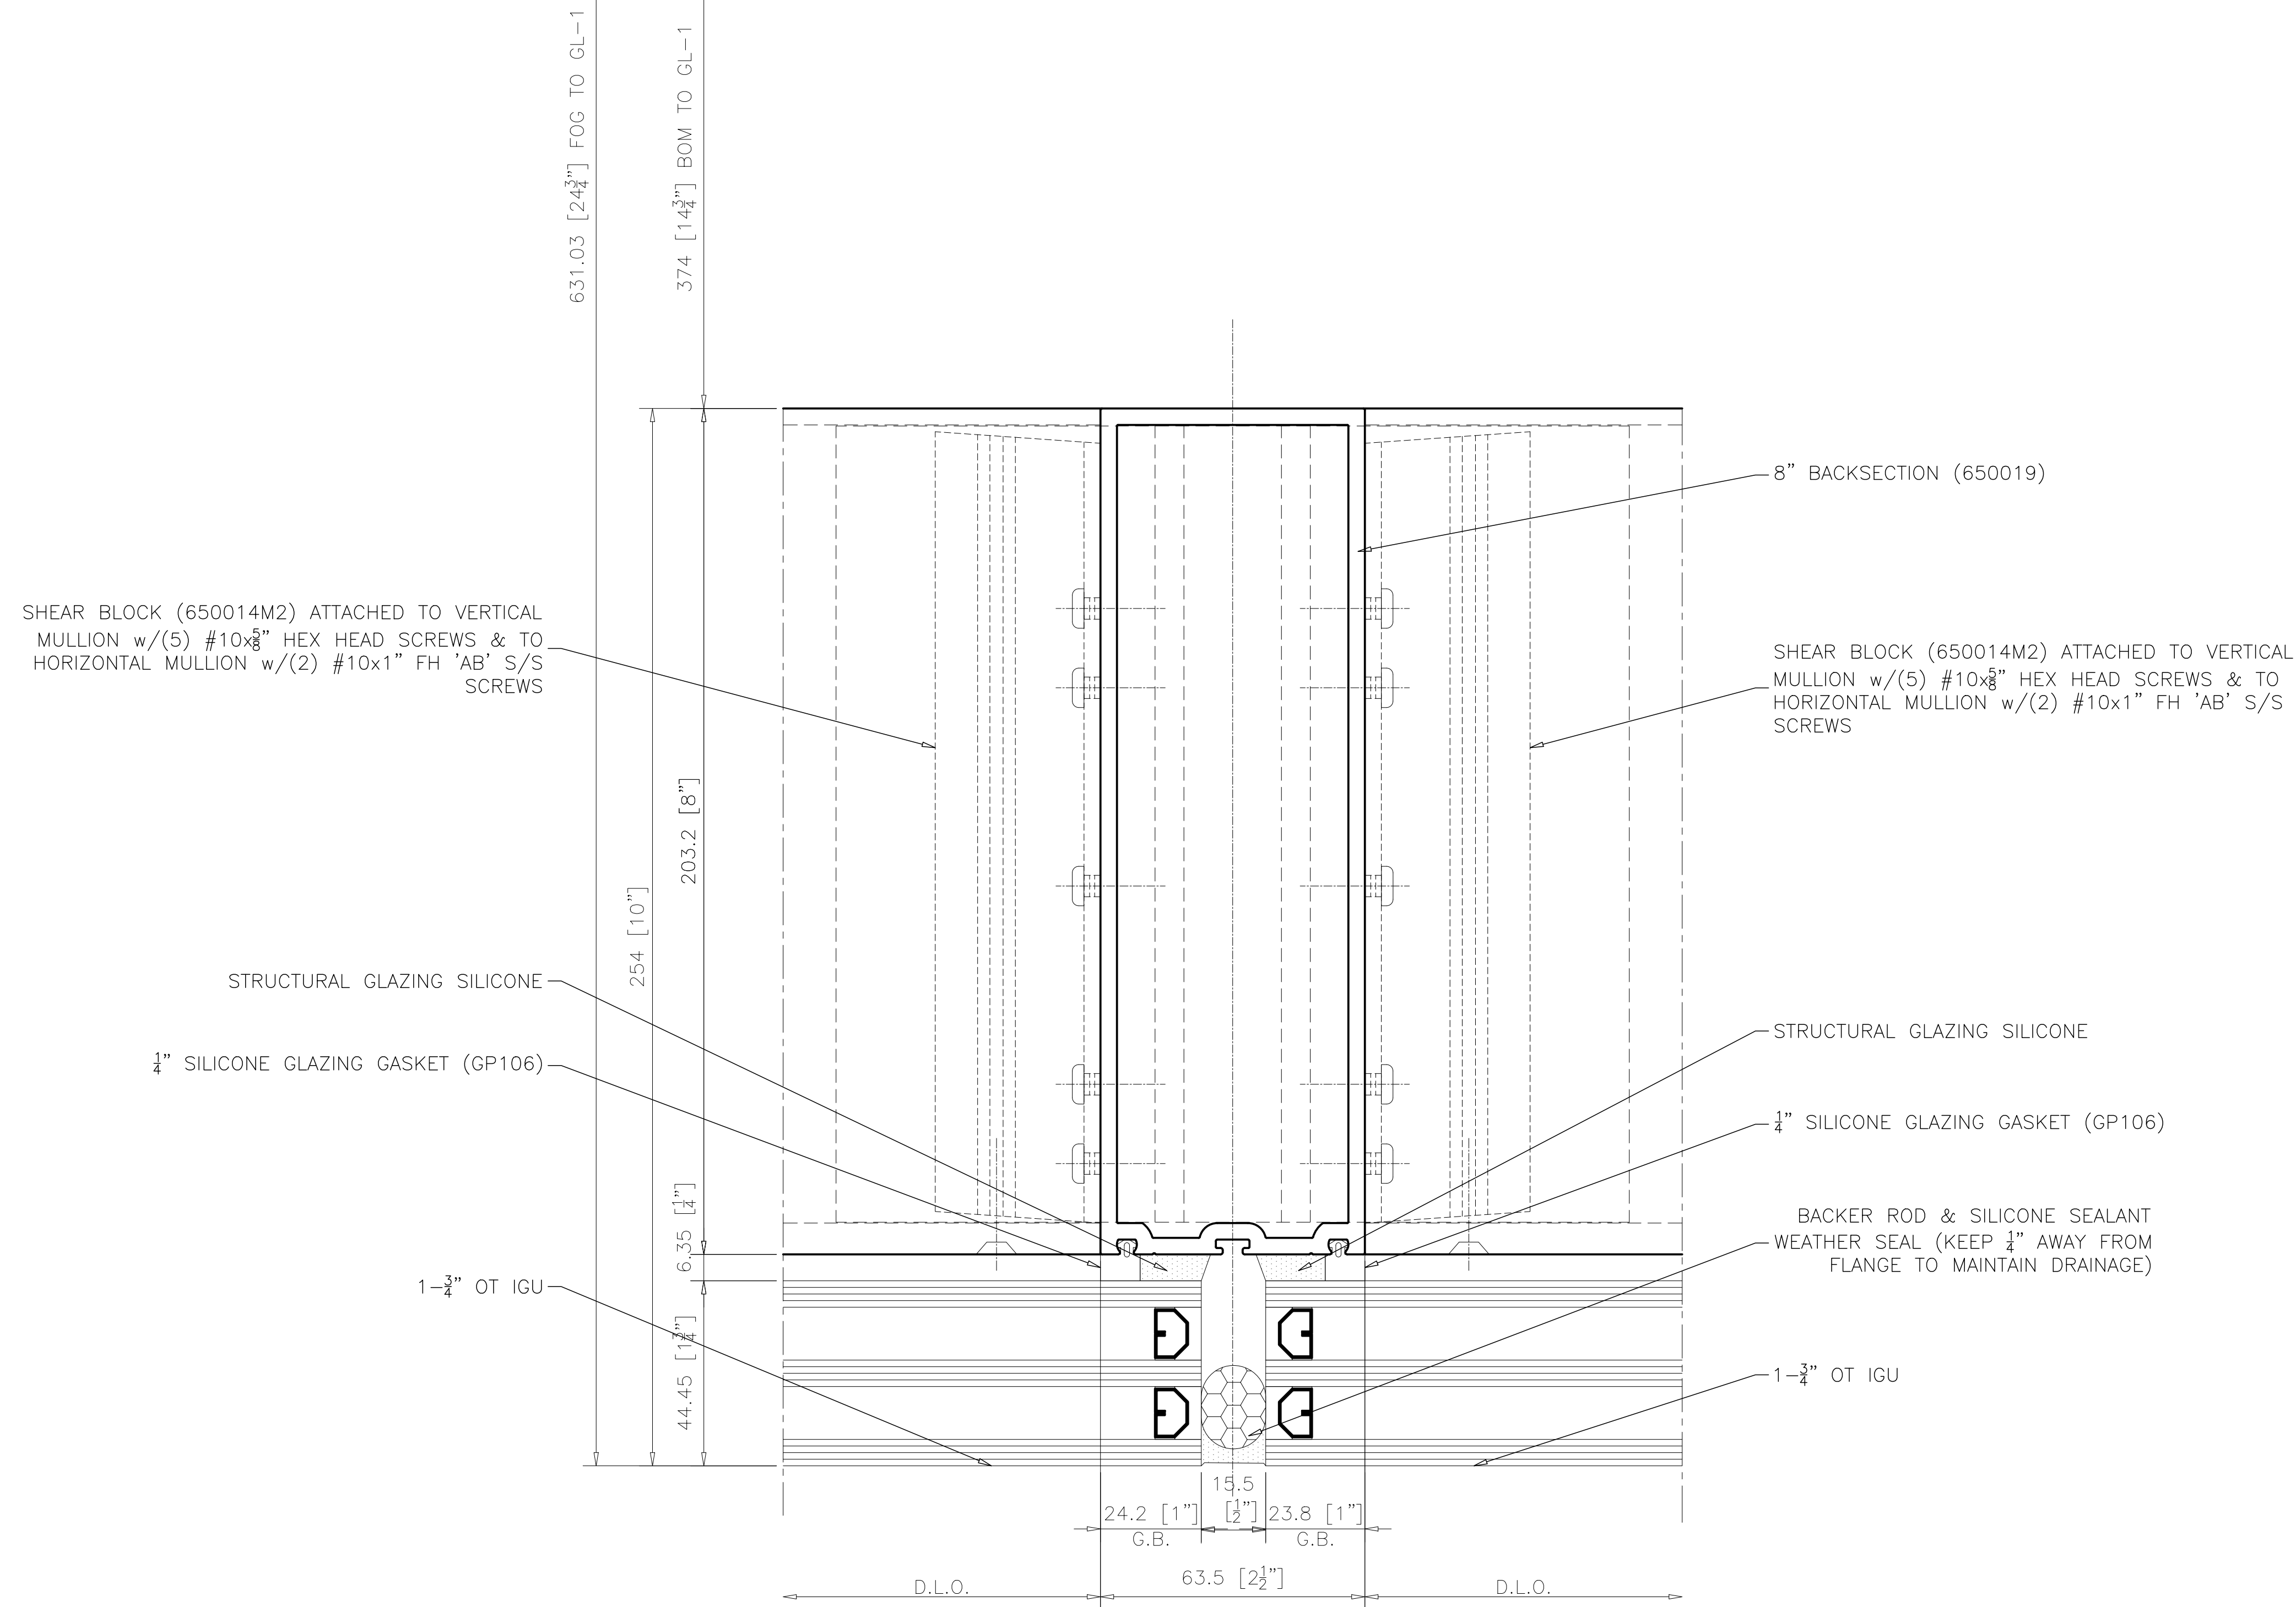

1  
C4-003

INT. VERTICAL SSG 8" B.S.  
AT VISION BESIDE VISION GLAZING

ARCH. REF.: N/A


| REVISIONS |                                              |          |     |
|-----------|----------------------------------------------|----------|-----|
| No.       | Description:                                 | Date:    | By: |
| 1         | Revised per arch. markups received Feb 11/26 | 03/03/26 | SLR |
|           |                                              |          |     |
|           |                                              |          |     |
|                                   |                                        |                                               |                                             |
|-----------------------------------|----------------------------------------|-----------------------------------------------|---------------------------------------------|
| Project Name:<br>DOCKSTEADER PRPS | Project Location:<br>BRAMPTON, ONTARIO | Architect Name:<br>DIAMOND SCHMITT ARCHITECTS | Customer Name:<br>BOTHWELL ACCURATE GLAZING |
|-----------------------------------|----------------------------------------|-----------------------------------------------|---------------------------------------------|



275 Britannia Road East • Mississauga • Ontario • Canada • L4Z2E7  
905-890-6970 • oldcastlebe.com

|                              |                             |
|------------------------------|-----------------------------|
| Drawing Name:<br>PLAN DETAIL |                             |
| Drawn By:<br>SR              | Checked By:<br>NP           |
| Drawn Date:<br>2026/01/12    | Issue No.:<br>1             |
| Scale:<br>1"=1"              | Release Date:<br>2026/03/03 |
| Drawing Number:<br>C4-003    |                             |

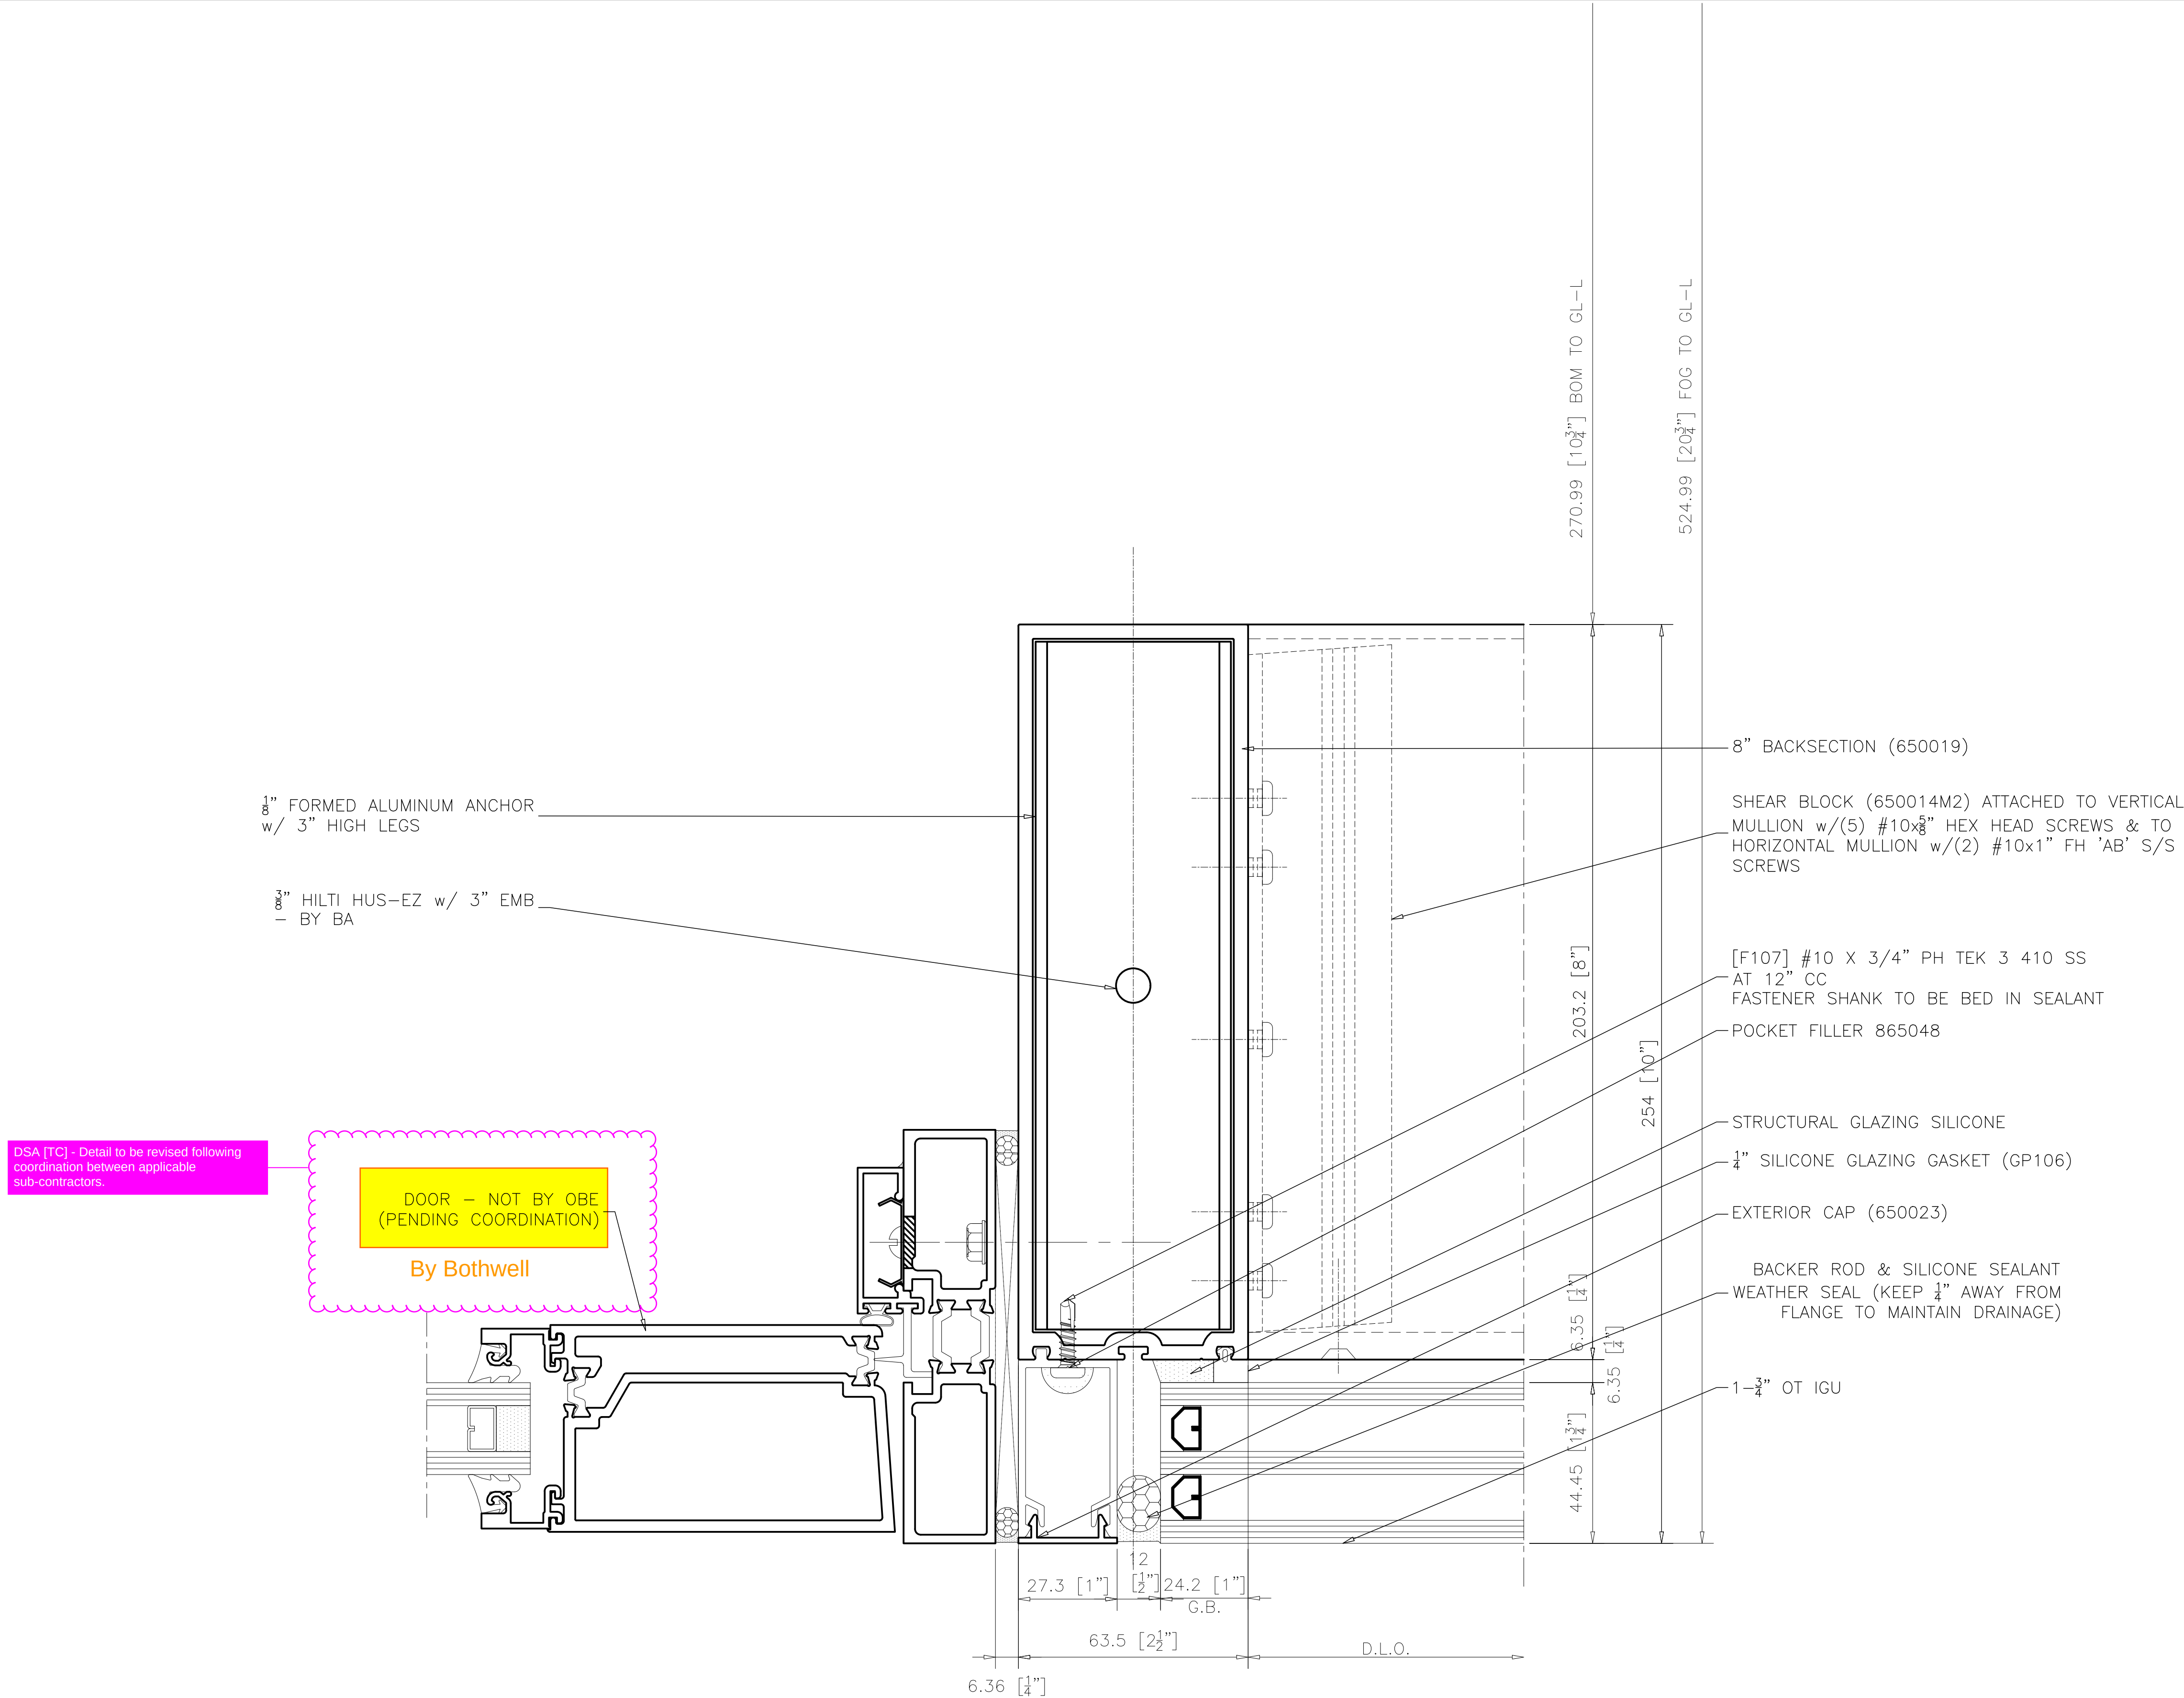

1  
C4-003A INT. VERTICAL SSG 8" B.S.  
AT DOOR BESIDE VISION GLAZING  
ARCH. REF.: N/A


| REVISIONS |                                              |          |     |
|-----------|----------------------------------------------|----------|-----|
| No.       | Description:                                 | Date:    | By: |
| 1         | Revised per arch. markups received Feb 11/26 | 03/03/26 | SLR |
|           |                                              |          |     |
|           |                                              |          |     |
|                                   |                                        |                                               |                                             |
|-----------------------------------|----------------------------------------|-----------------------------------------------|---------------------------------------------|
| Project Name:<br>DOCKSTEADER PRPS | Project Location:<br>BRAMPTON, ONTARIO | Architect Name:<br>DIAMOND SCHMITT ARCHITECTS | Customer Name:<br>BOTHWELL ACCURATE GLAZING |
|-----------------------------------|----------------------------------------|-----------------------------------------------|---------------------------------------------|



2775 Britannia Road East • Mississauga • Ontario • Canada • L4Z2E7  
905-890-6970 • oldcastlebe.com

|                              |                             |
|------------------------------|-----------------------------|
| Drawing Name:<br>PLAN DETAIL |                             |
| Drawn By:<br>SR              | Checked By:<br>NP           |
| Drawn Date:<br>2026/01/12    | Issue No.:<br>1             |
| Scale:<br>1"=1"              | Release Date:<br>2026/03/03 |
| Drawing Number:<br>C4-003A   |                             |

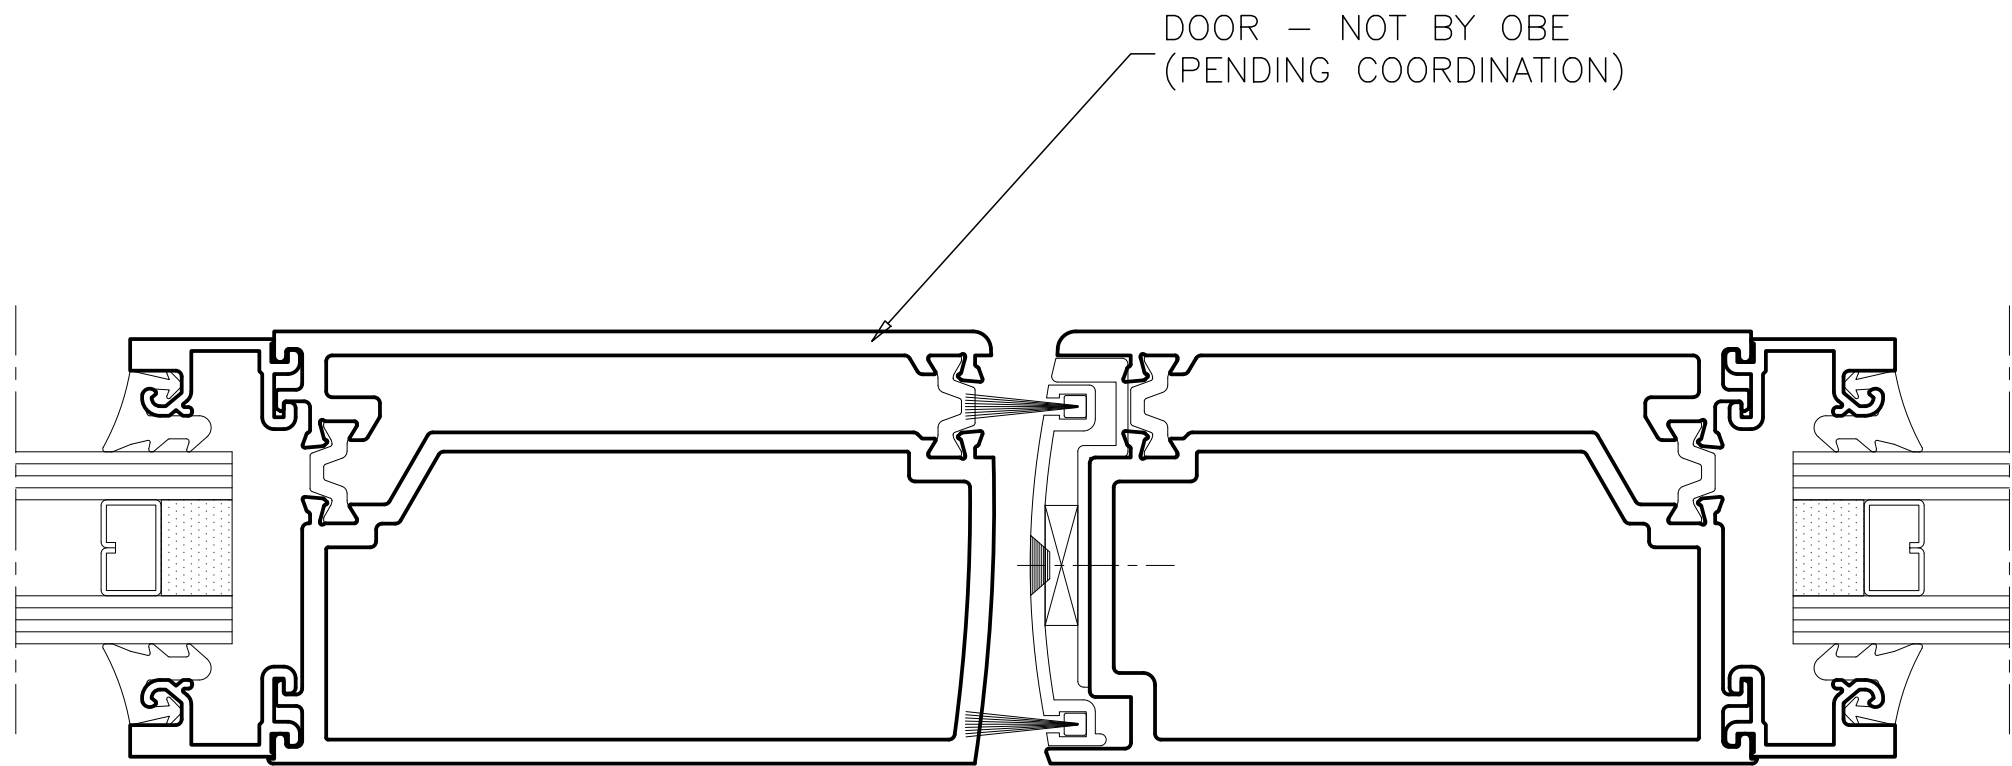

1

C4-003B

INT. VERTICAL  
AT DOOR STILES

ARCH. REF.: N/A

| REVISIONS |                                              |          |     |
|-----------|----------------------------------------------|----------|-----|
| No.       | Description:                                 | Date:    | By: |
| 1         | Revised per arch. markups received Feb 11/26 | 03/03/26 | SLR |
|           |                                              |          |     |
|           |                                              |          |     |
|                                               |  |
|-----------------------------------------------|--|
| Project Name:<br>DOCKSTEADER PRPS             |  |
| Project Location:<br>BRAMPTON, ONTARIO        |  |
| Architect Name:<br>DIAMOND SCHMITT ARCHITECTS |  |
| Customer Name:<br>BOTHWELL ACCURATE GLAZING   |  |




275 Britannia Road East • Mississauga • Ontario • Canada • L4Z2E7  
905-890-6970 • oldcastlebe.com

Drawing Name:  
PLAN DETAIL

|                           |                             |
|---------------------------|-----------------------------|
| Drawn By:<br>SR           | Checked By:<br>NP           |
| Drawn Date:<br>2026/01/12 | Issue No.:<br>1             |
| Scale:<br>1"=1"           | Release Date:<br>2026/03/03 |

Drawing Number: C4-003B

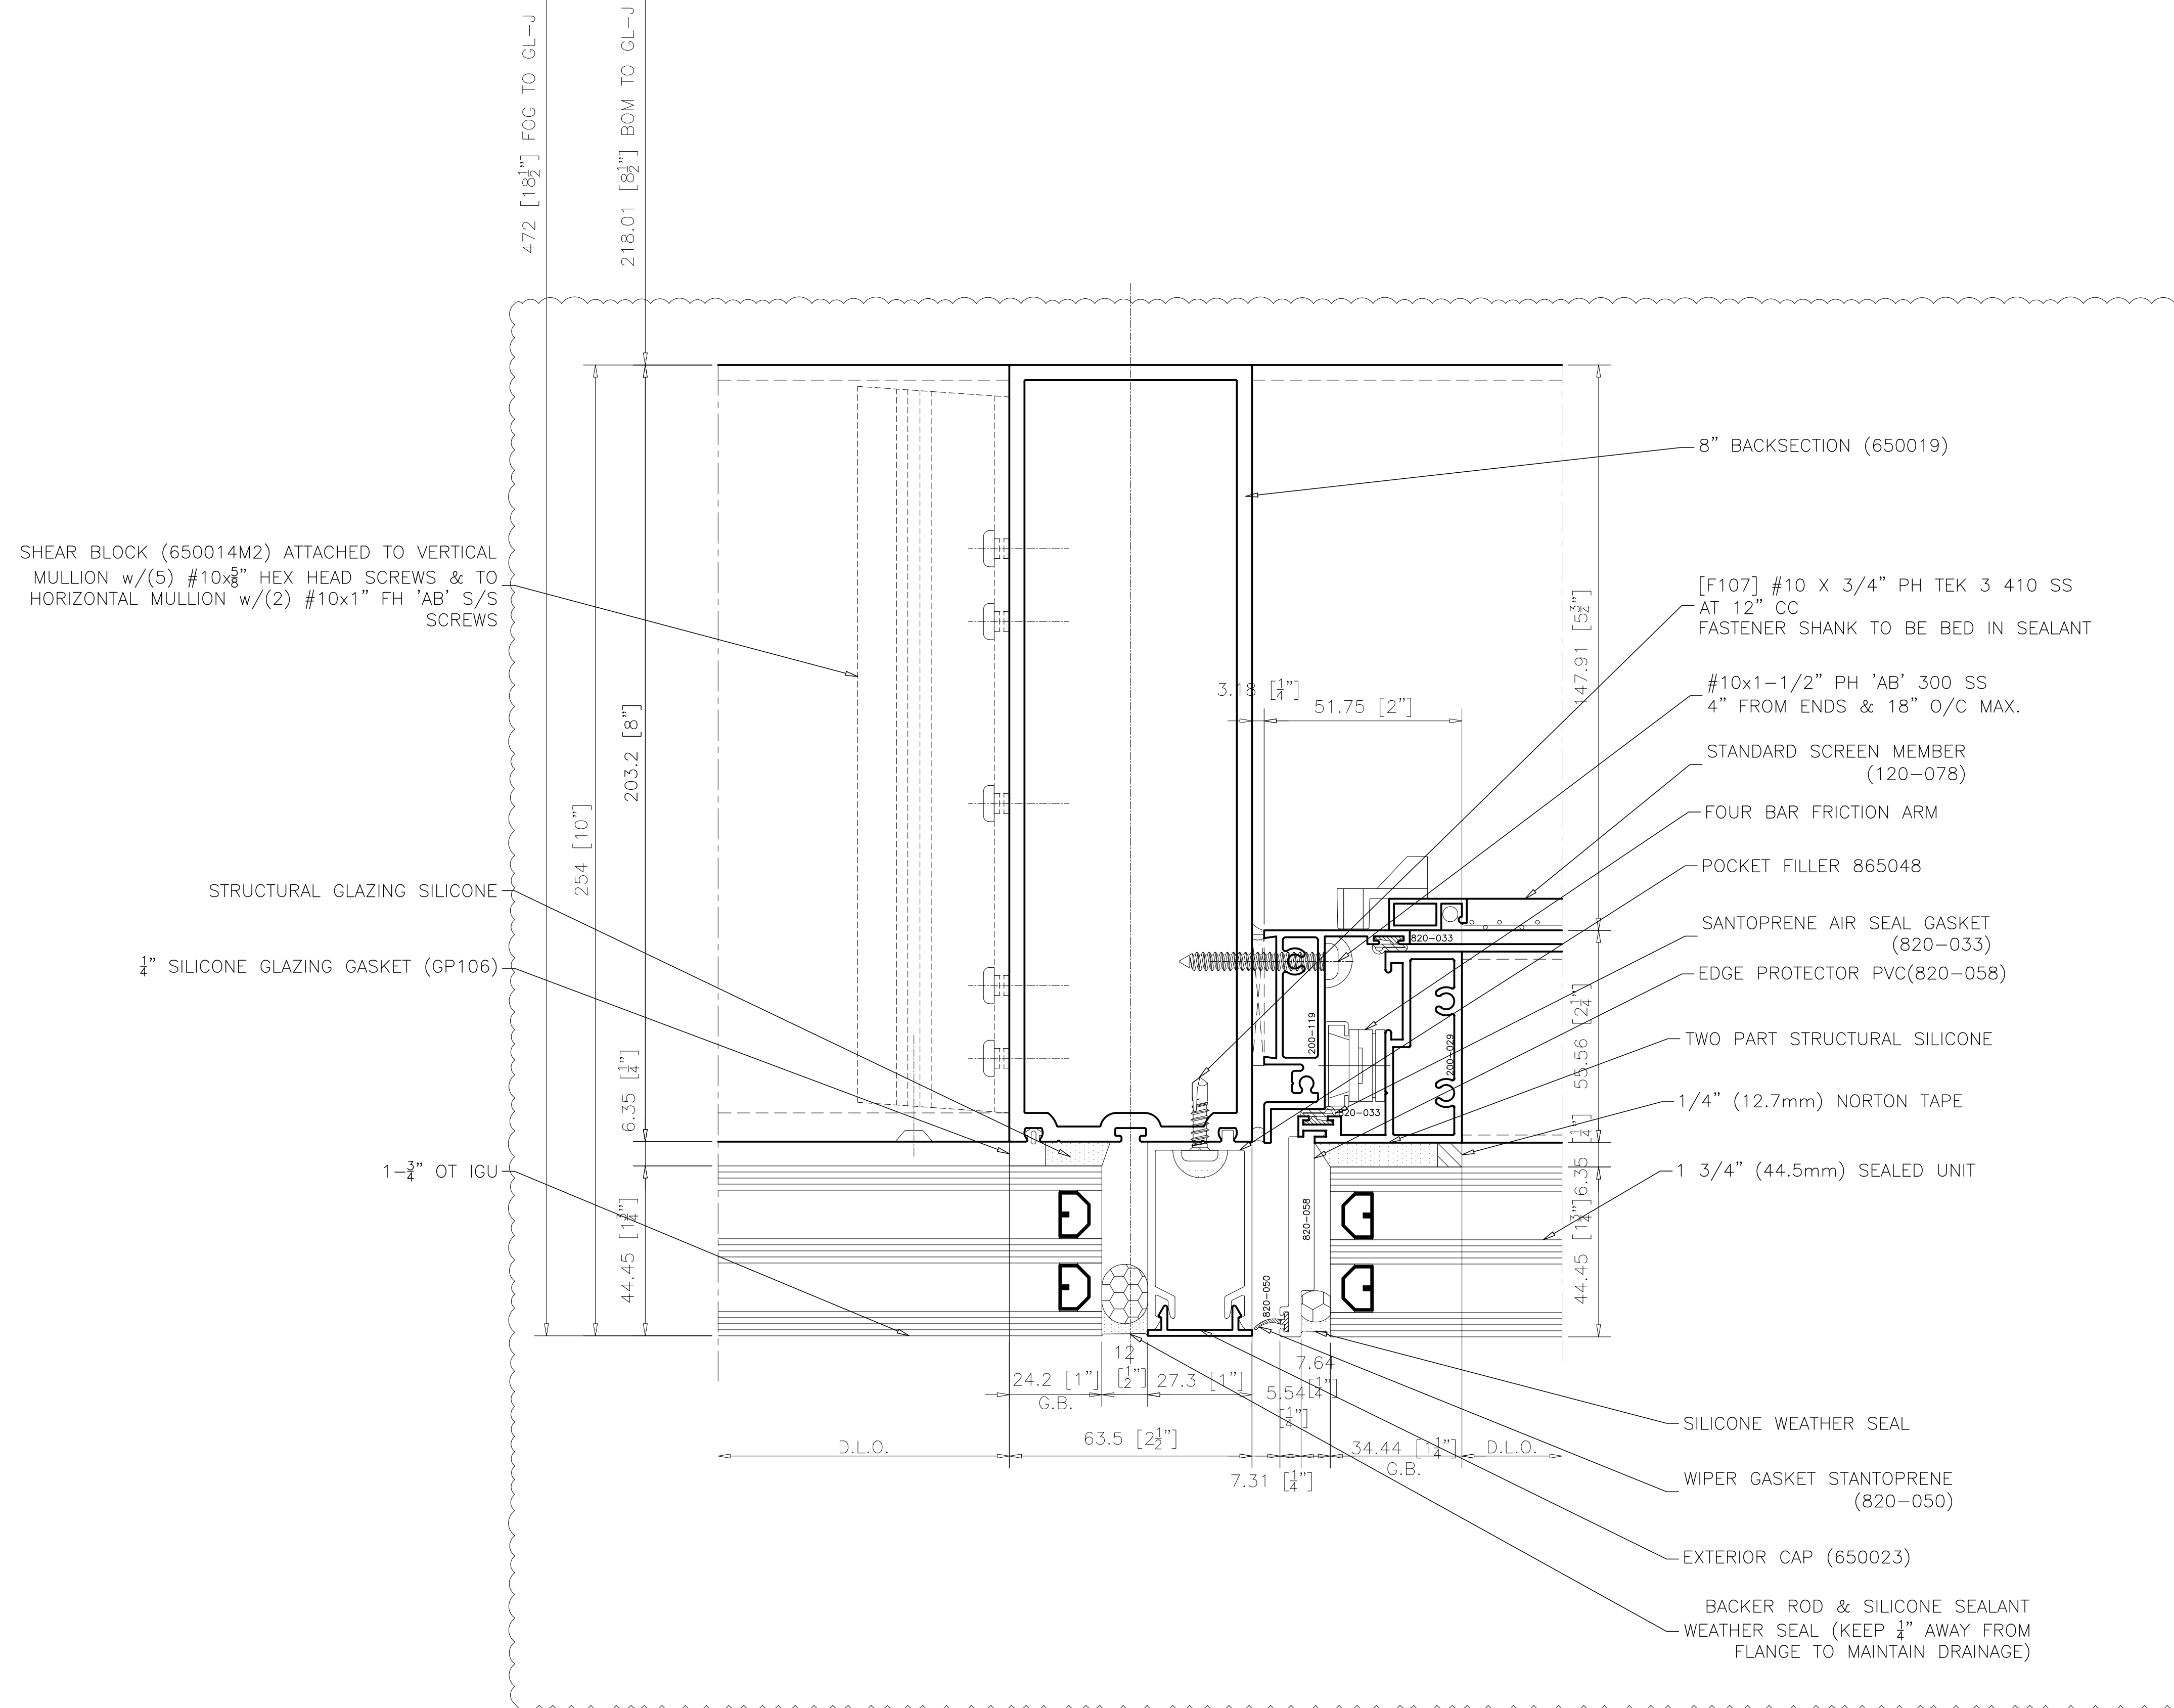


1  
C4-003C

INT. VERTICAL SSG 8" BS  
AT VISION GLAZING BESIDE VENT

ARCH. REF.: N/A


| REVISIONS |                                              |          |     |
|-----------|----------------------------------------------|----------|-----|
| No.       | Description:                                 | Date:    | By: |
| 1         | Revised per arch. markups received Feb 11/26 | 03/03/26 | SLR |
|           |                                              |          |     |
|           |                                              |          |     |
|                                   |                                        |                                               |                                             |
|-----------------------------------|----------------------------------------|-----------------------------------------------|---------------------------------------------|
| Project Name:<br>DOCKSTEADER PRPS | Project Location:<br>BRAMPTON, ONTARIO | Architect Name:<br>DIAMOND SCHMITT ARCHITECTS | Customer Name:<br>BOTHWELL ACCURATE GLAZING |
|-----------------------------------|----------------------------------------|-----------------------------------------------|---------------------------------------------|

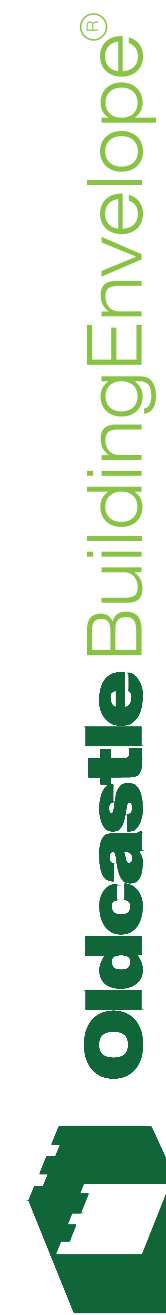

275 Britannia Road East • Mississauga • Ontario • Canada • L4Z2E7  
905-890-6970 • oldcastlebe.com

|                              |                             |
|------------------------------|-----------------------------|
| Drawing Name:<br>PLAN DETAIL |                             |
| Drawn By:<br>SR              | Checked By:<br>NP           |
| Drawn Date:<br>2026/01/12    | Issue No.:<br>1             |
| Scale:<br>1"=1"              | Release Date:<br>2026/03/03 |
| Drawing Number:<br>C4-003C   |                             |

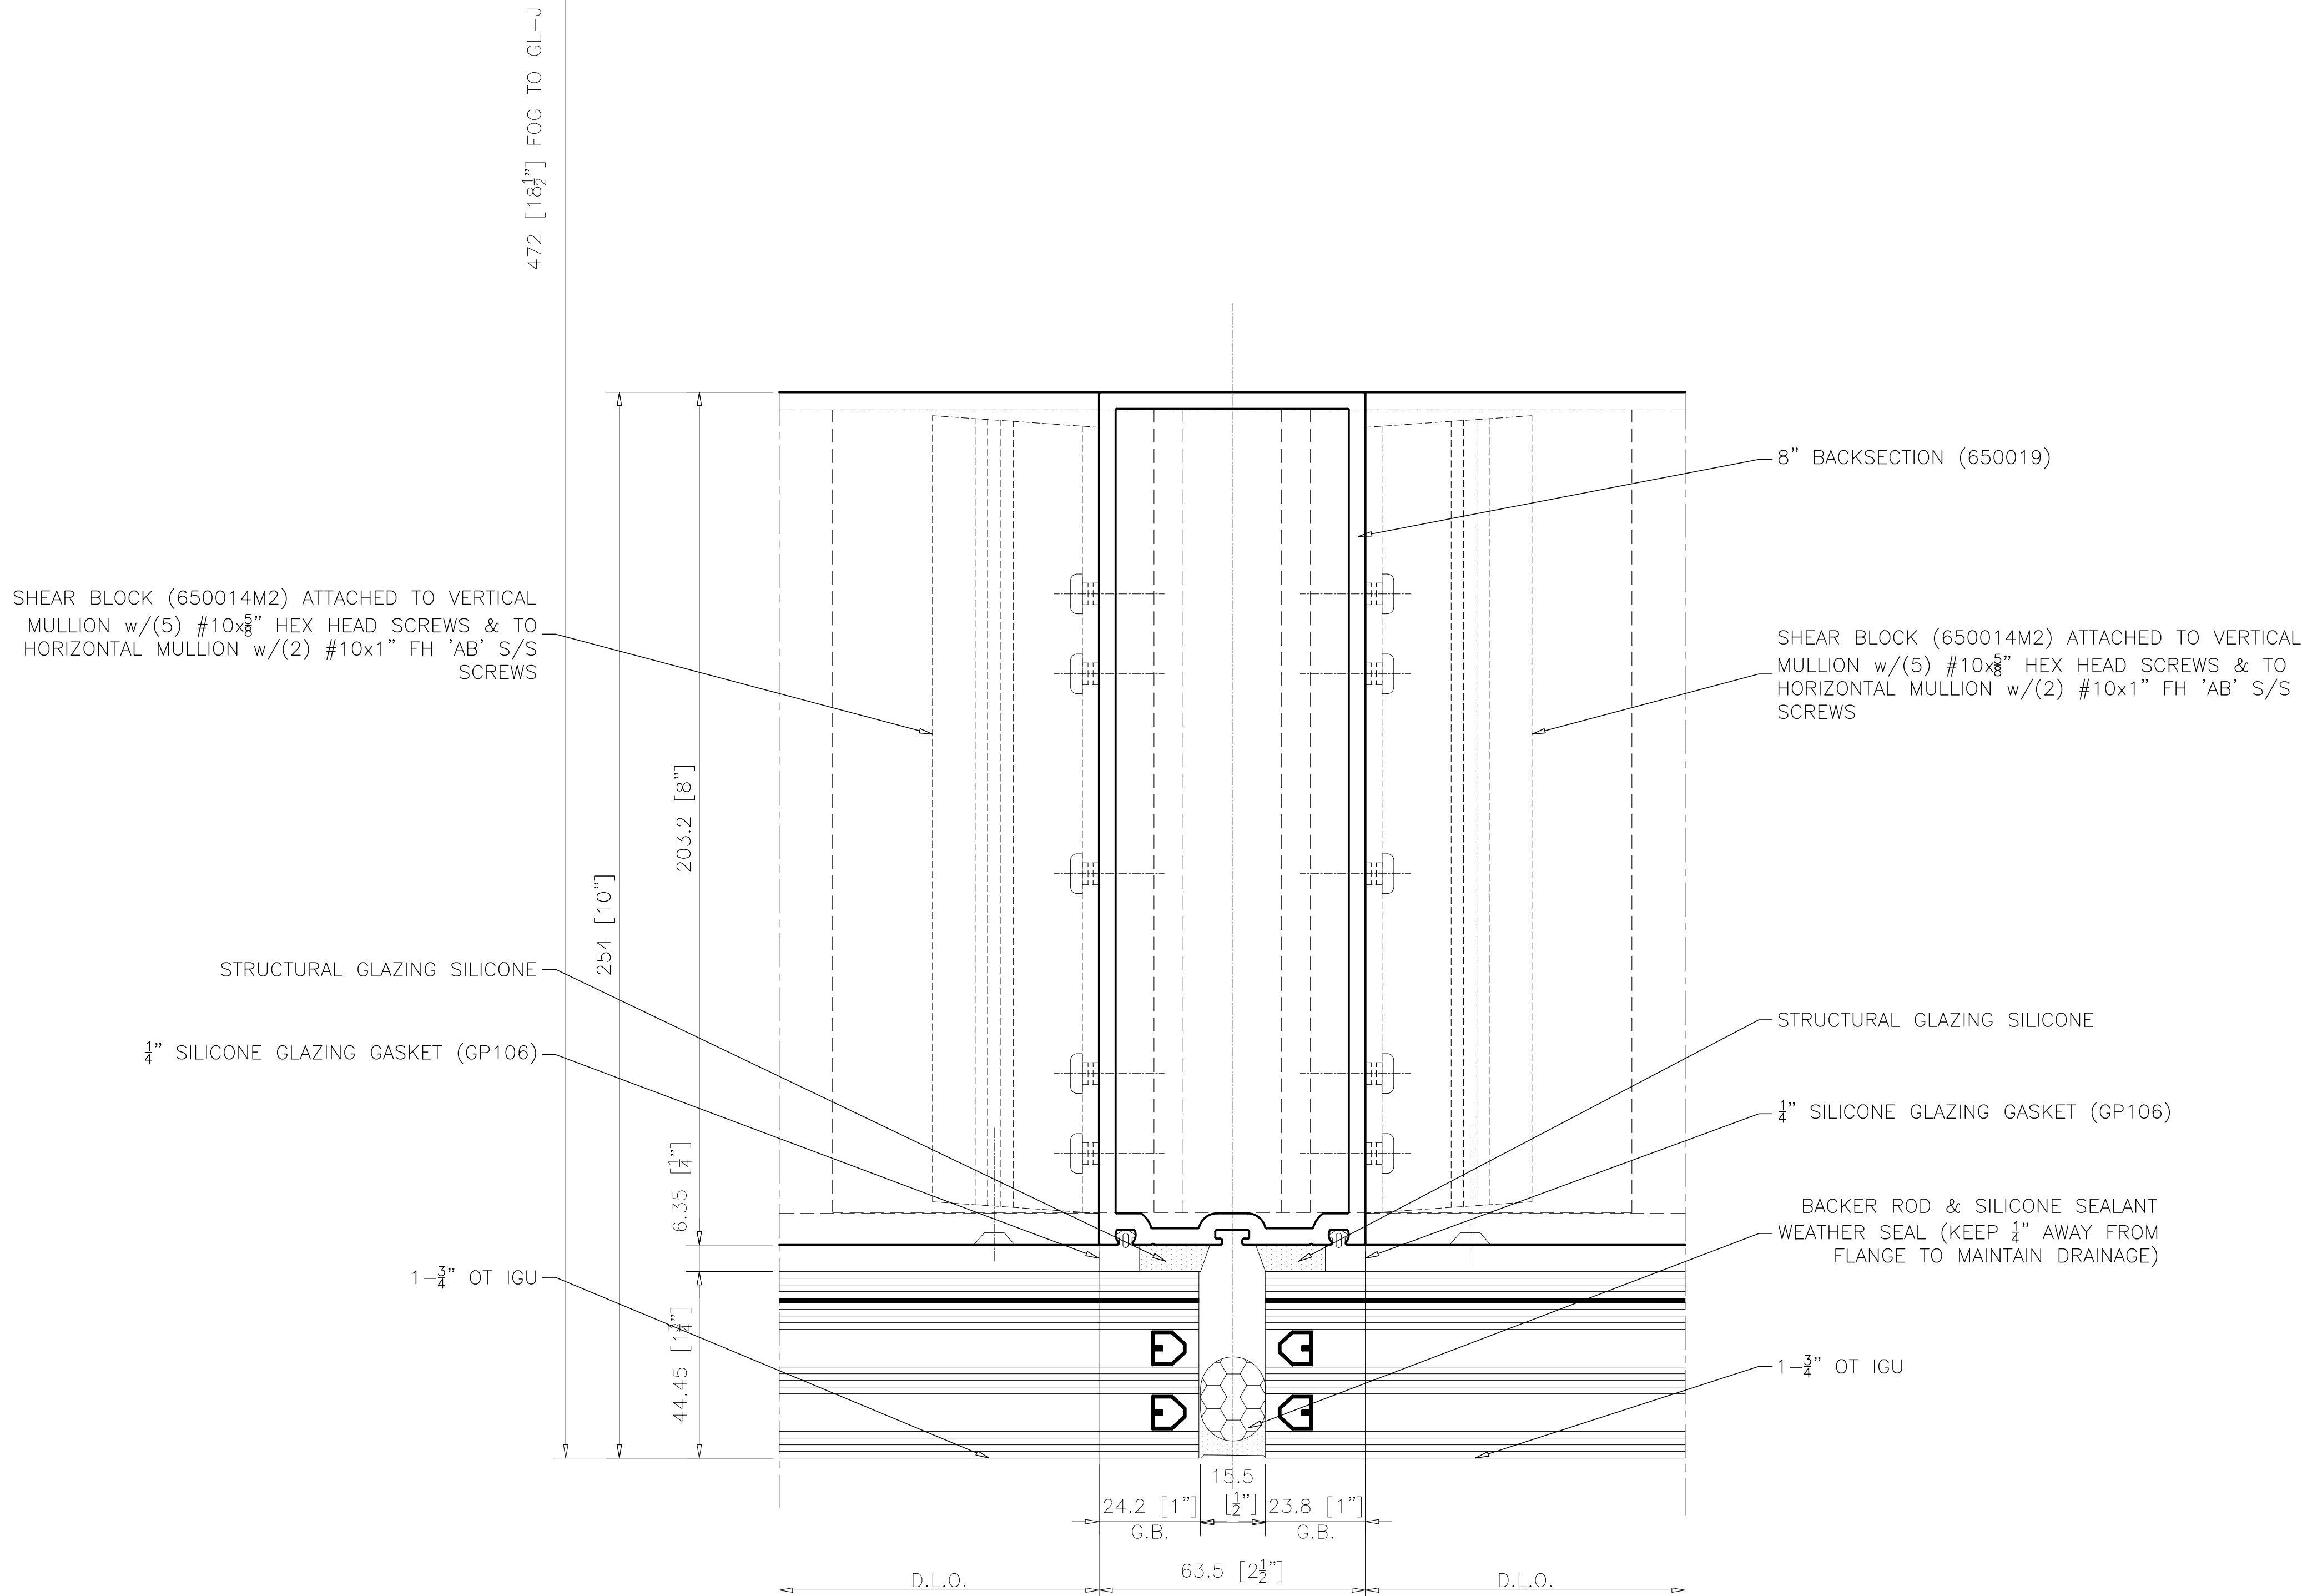

1  
C4-003D

INT. VERTICAL SSG 8" BS  
AT VISION BESIDE VISION GL1B

ARCH. REF.: N/A


| REVISIONS |                                              |          |     |
|-----------|----------------------------------------------|----------|-----|
| No.       | Description:                                 | Date:    | By: |
| 1         | Revised per arch. markups received Feb 11/26 | 03/03/26 | SLR |
|           |                                              |          |     |
|           |                                              |          |     |
|                                   |                                        |                                               |                                             |
|-----------------------------------|----------------------------------------|-----------------------------------------------|---------------------------------------------|
| Project Name:<br>DOCKSTEADER PRPS | Project Location:<br>BRAMPTON, ONTARIO | Architect Name:<br>DIAMOND SCHMITT ARCHITECTS | Customer Name:<br>BOTHWELL ACCURATE GLAZING |
|-----------------------------------|----------------------------------------|-----------------------------------------------|---------------------------------------------|



275 Britannia Road East • Mississauga • Ontario • Canada • L4Z2E7  
905-890-6970 • oldcastlebe.com

|                              |                             |
|------------------------------|-----------------------------|
| Drawing Name:<br>PLAN DETAIL |                             |
| Drawn By:<br>SR              | Checked By:<br>NP           |
| Drawn Date:<br>2026/01/12    | Issue No.:<br>1             |
| Scale:<br>1"=1"              | Release Date:<br>2026/03/03 |
| Drawing Number:<br>C4-003D   |                             |

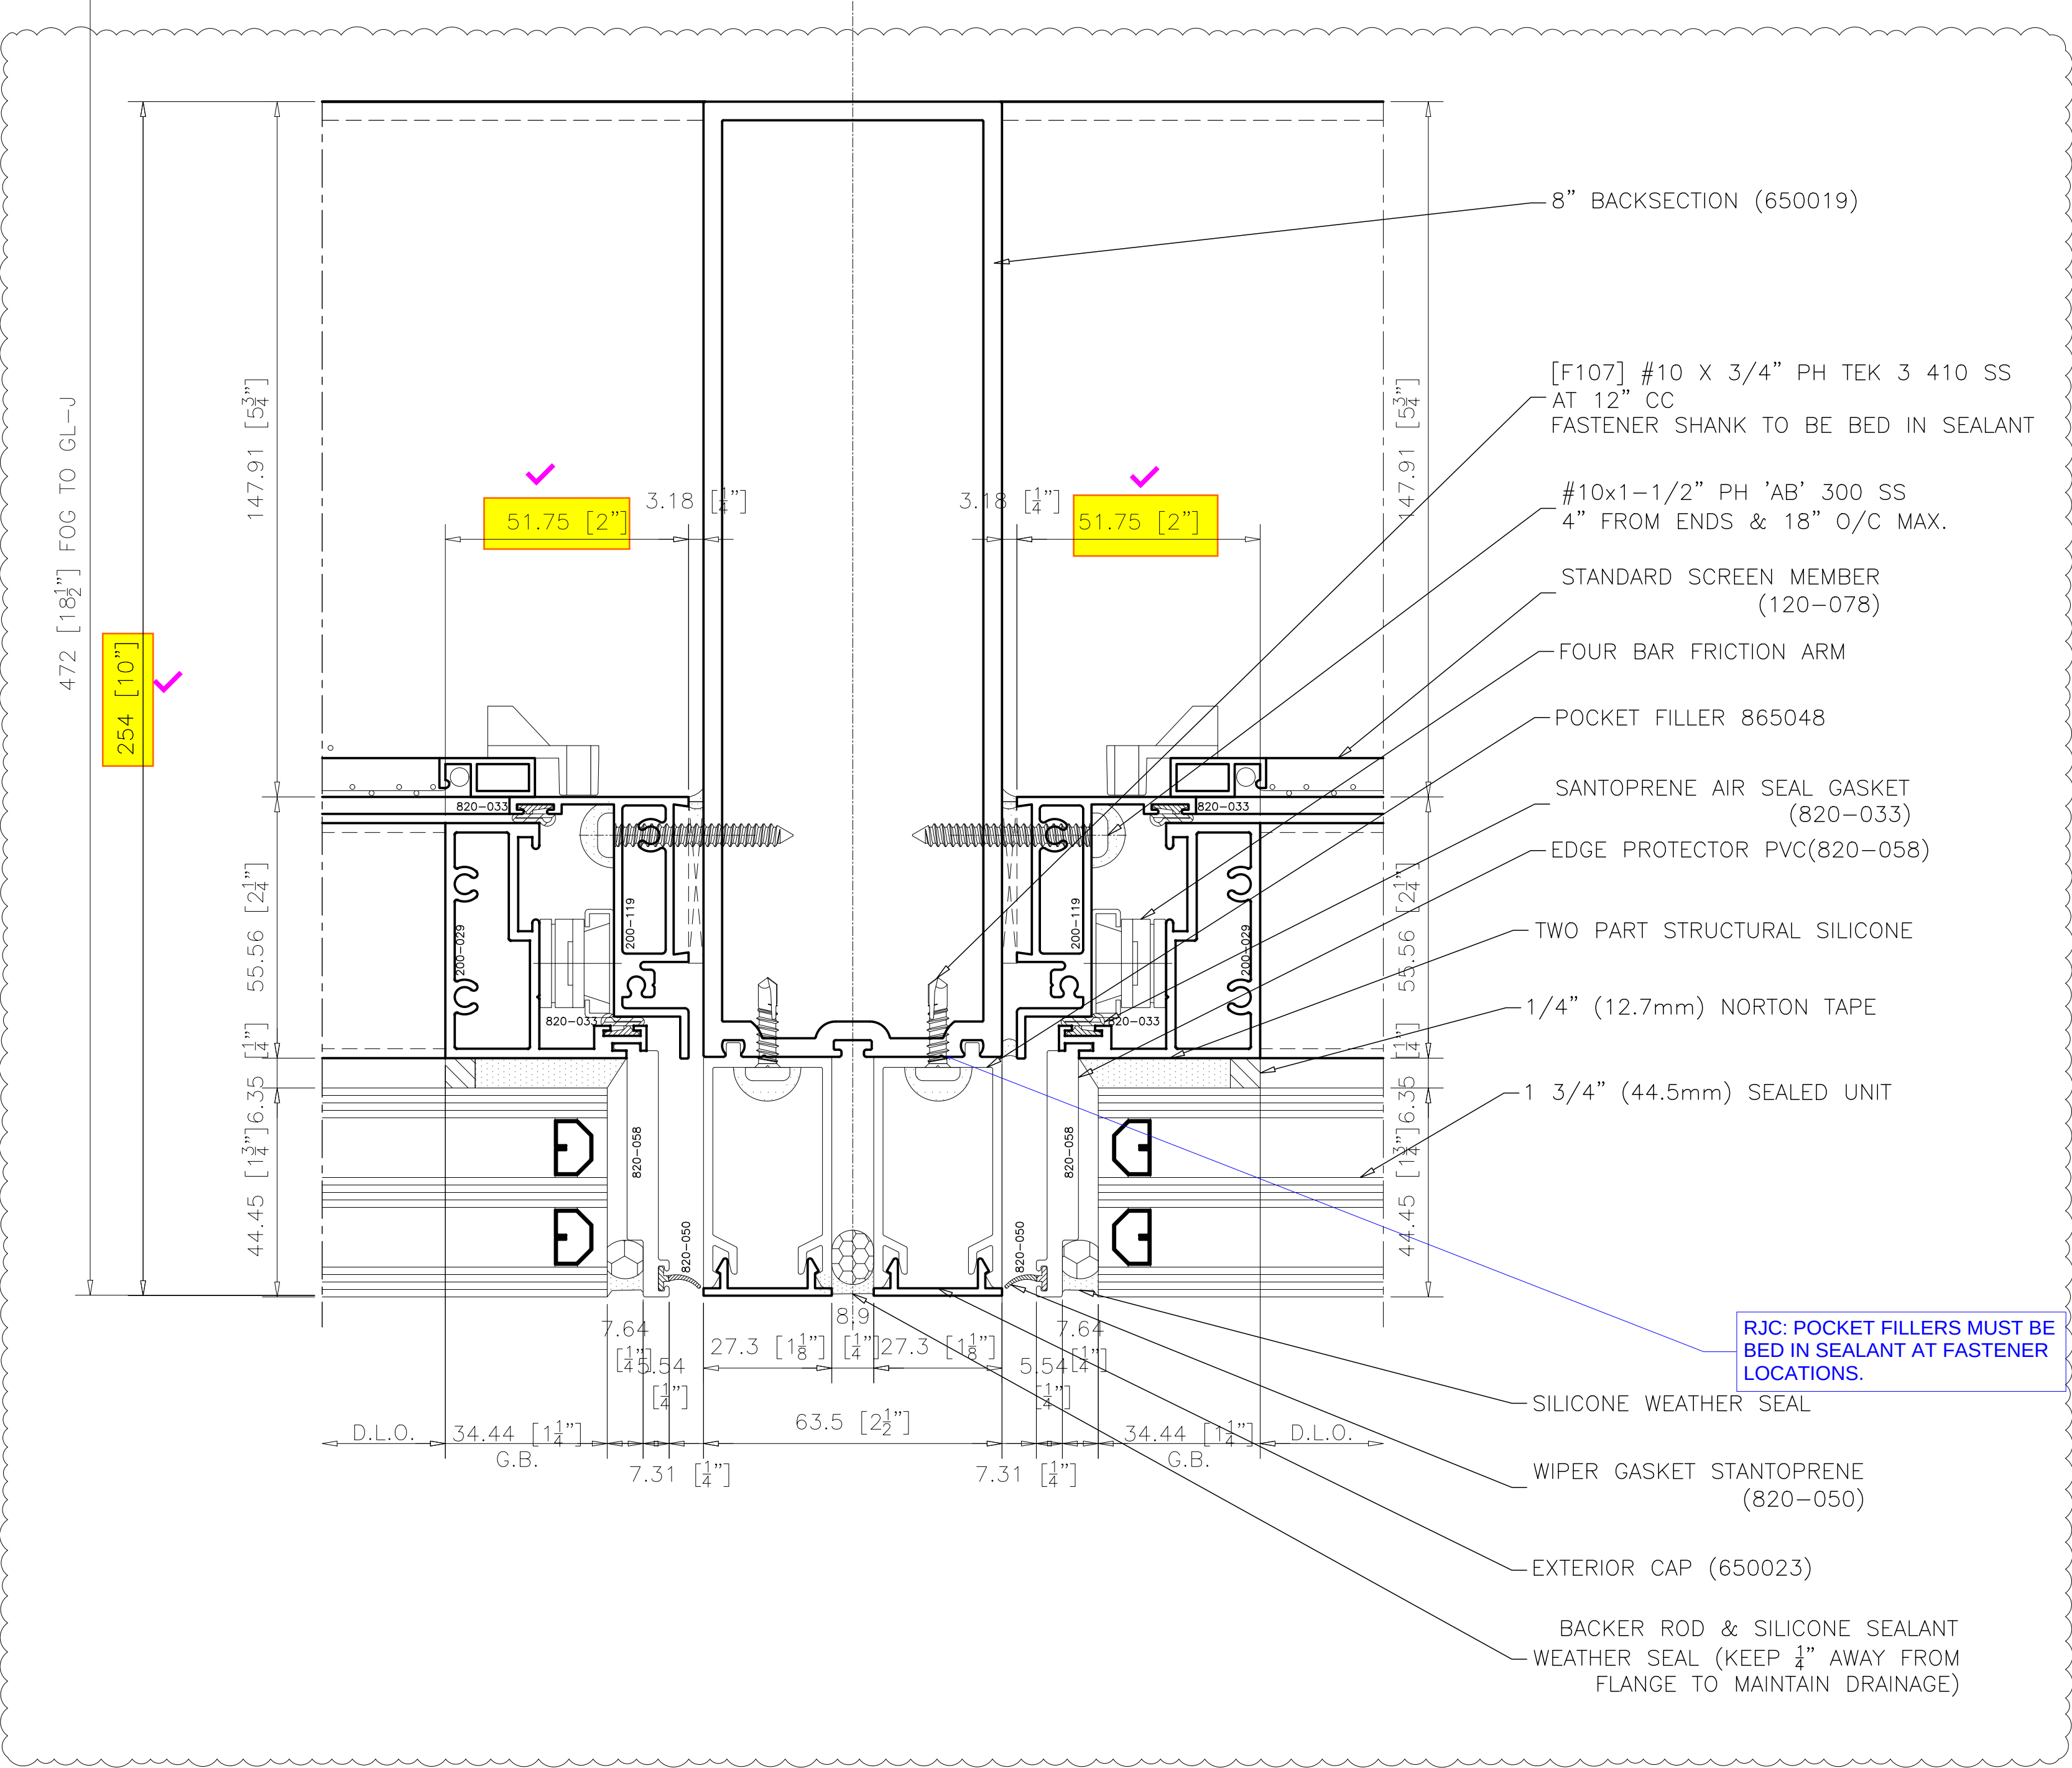

1 INT. VERTICAL SSG 8" BS  
C4-003E AT VENT BESIDE VENT  
ARCH. REF.: N/A


| REVISIONS |                                              |          |     |
|-----------|----------------------------------------------|----------|-----|
| No.       | Description:                                 | Date:    | By: |
| 1         | Revised per arch. markups received Feb 11/26 | 03/03/26 | SLR |
|           |                                              |          |     |
|           |                                              |          |     |
|                                   |                                        |                                               |                                             |
|-----------------------------------|----------------------------------------|-----------------------------------------------|---------------------------------------------|
| Project Name:<br>DOCKSTEADER PRPS | Project Location:<br>BRAMPTON, ONTARIO | Architect Name:<br>DIAMOND SCHMITT ARCHITECTS | Customer Name:<br>BOTHWELL ACCURATE GLAZING |
|-----------------------------------|----------------------------------------|-----------------------------------------------|---------------------------------------------|



275 Britannia Road East • Mississauga • Ontario • Canada • L4Z2E7  
905-890-6970 • oldcastlebe.com

|                              |                             |
|------------------------------|-----------------------------|
| Drawing Name:<br>PLAN DETAIL |                             |
| Drawn By:<br>SR              | Checked By:<br>NP           |
| Drawn Date:<br>2026/01/12    | Issue No.:<br>1             |
| Scale:<br>1"=1"              | Release Date:<br>2026/03/03 |
| Drawing Number:<br>C4-003E   |                             |

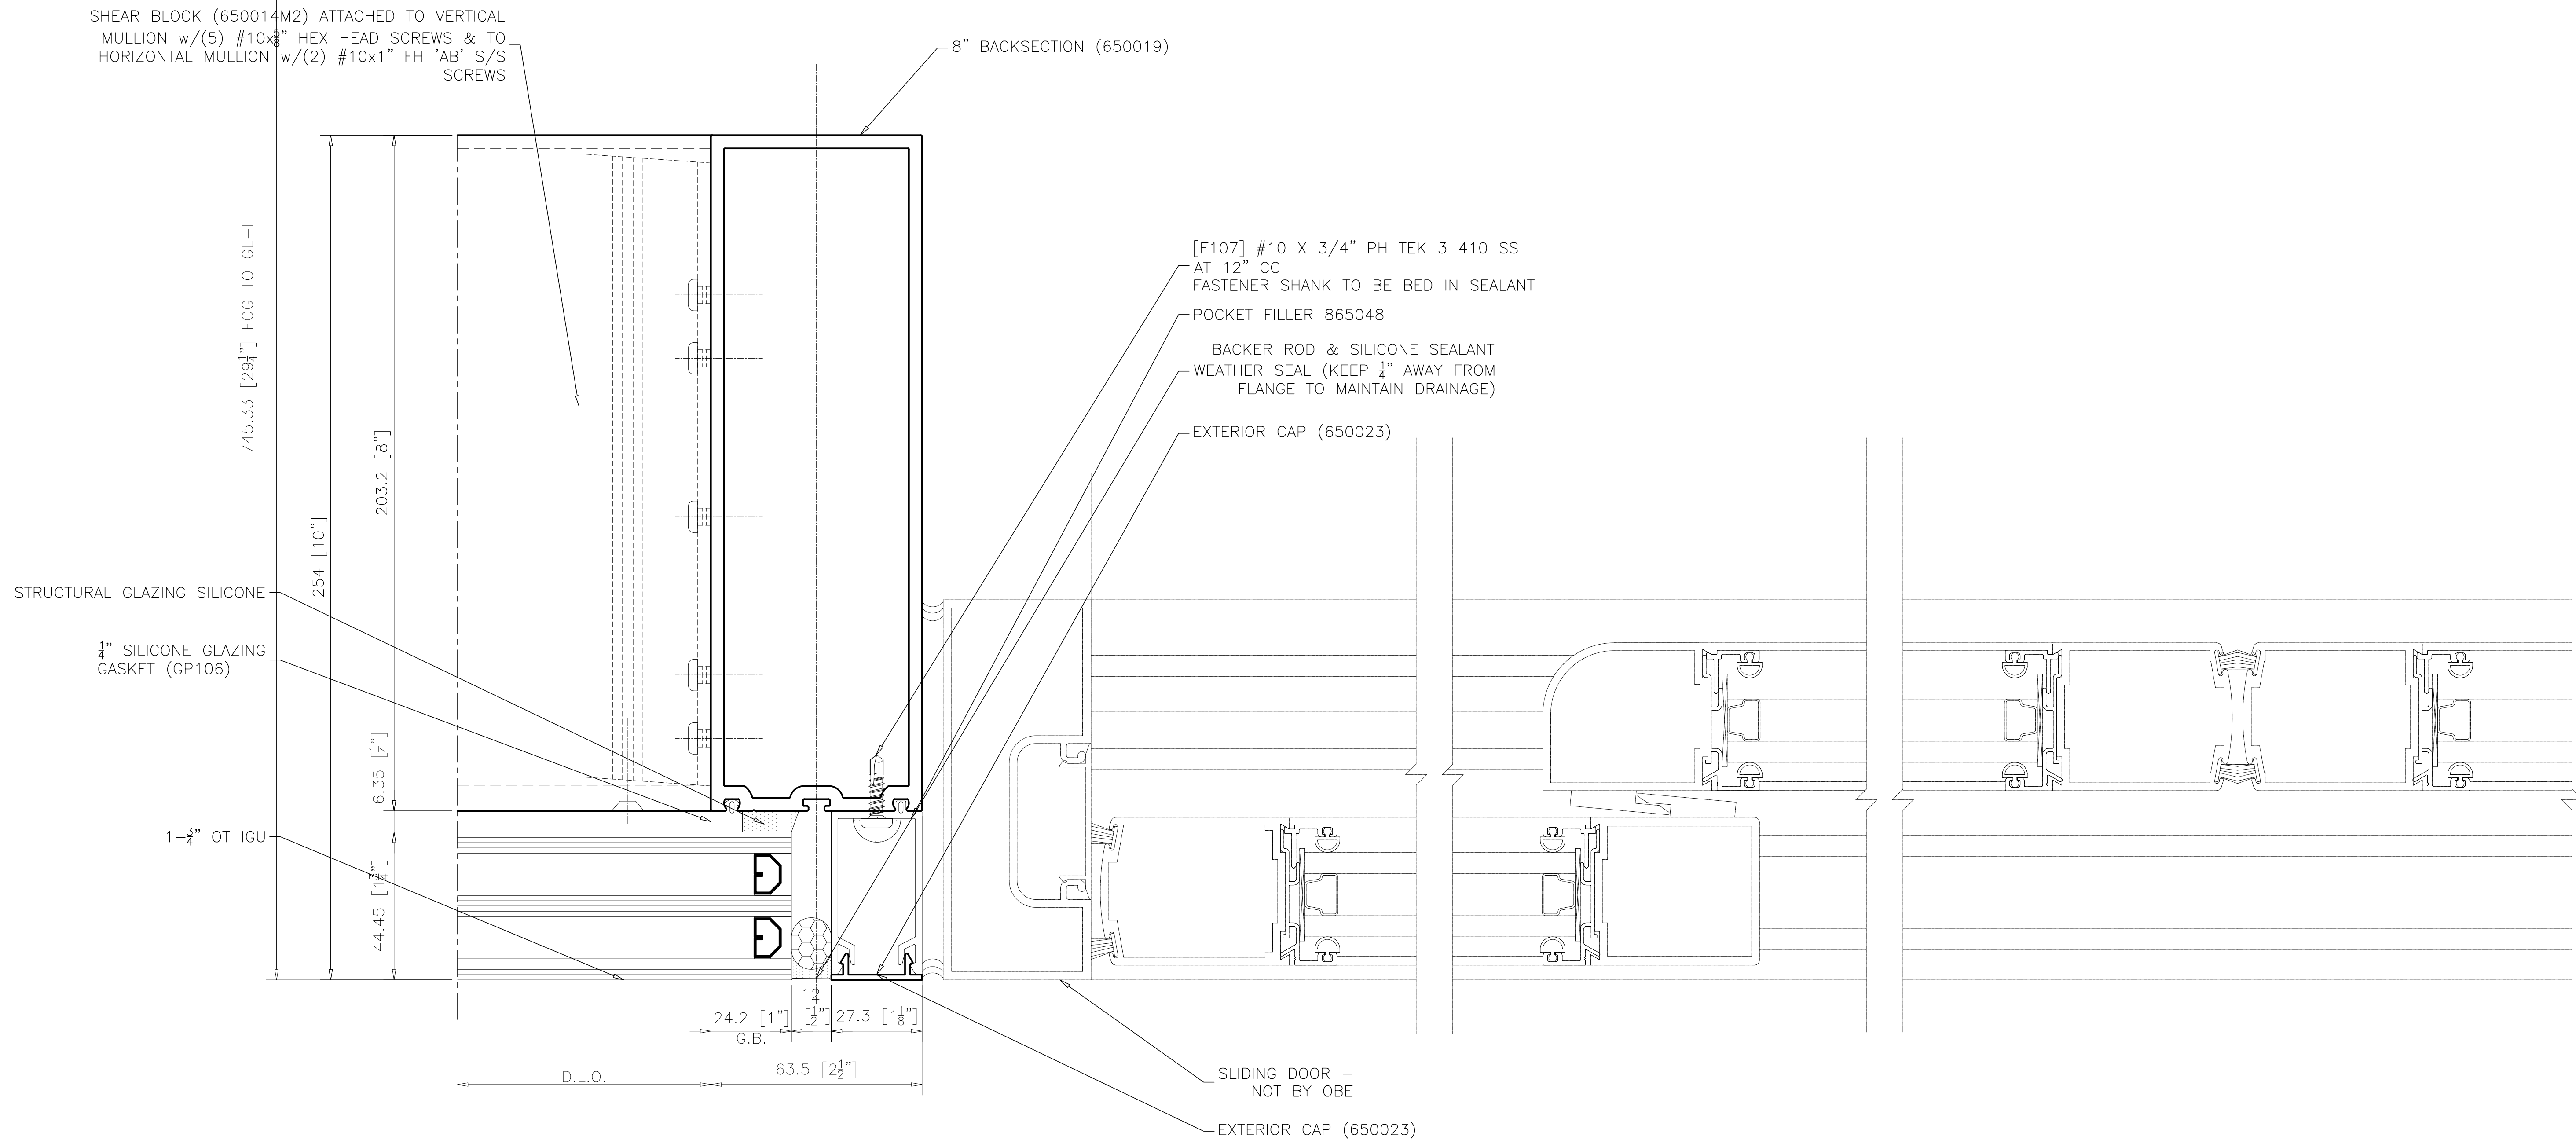

1  
C4-003F

INT. VERTICAL SSG 8" BS  
AT VISION BESIDE SLIDING DOOR

ARCH. REF.: N/A


| REVISIONS |                                              |          |     |
|-----------|----------------------------------------------|----------|-----|
| No.       | Description:                                 | Date:    | By: |
| 1         | Revised per arch. markups received Feb 11/26 | 03/03/26 | SLR |
|           |                                              |          |     |
|           |                                              |          |     |
|                                   |                                        |                                               |                                             |
|-----------------------------------|----------------------------------------|-----------------------------------------------|---------------------------------------------|
| Project Name:<br>DOCKSTEADER PRPS | Project Location:<br>BRAMPTON, ONTARIO | Architect Name:<br>DIAMOND SCHMITT ARCHITECTS | Customer Name:<br>BOTHWELL ACCURATE GLAZING |
|-----------------------------------|----------------------------------------|-----------------------------------------------|---------------------------------------------|



2775 Britannia Road East • Mississauga • Ontario • Canada • L4Z2E7  
905-890-6970 • oldcastlebe.com

|                              |                             |
|------------------------------|-----------------------------|
| Drawing Name:<br>PLAN DETAIL |                             |
| Drawn By:<br>SR              | Checked By:<br>NP           |
| Drawn Date:<br>2026/01/12    | Issue No.:<br>1             |
| Scale:<br>1"=1'              | Release Date:<br>2026/03/03 |
| Drawing Number:<br>C4-003F   |                             |

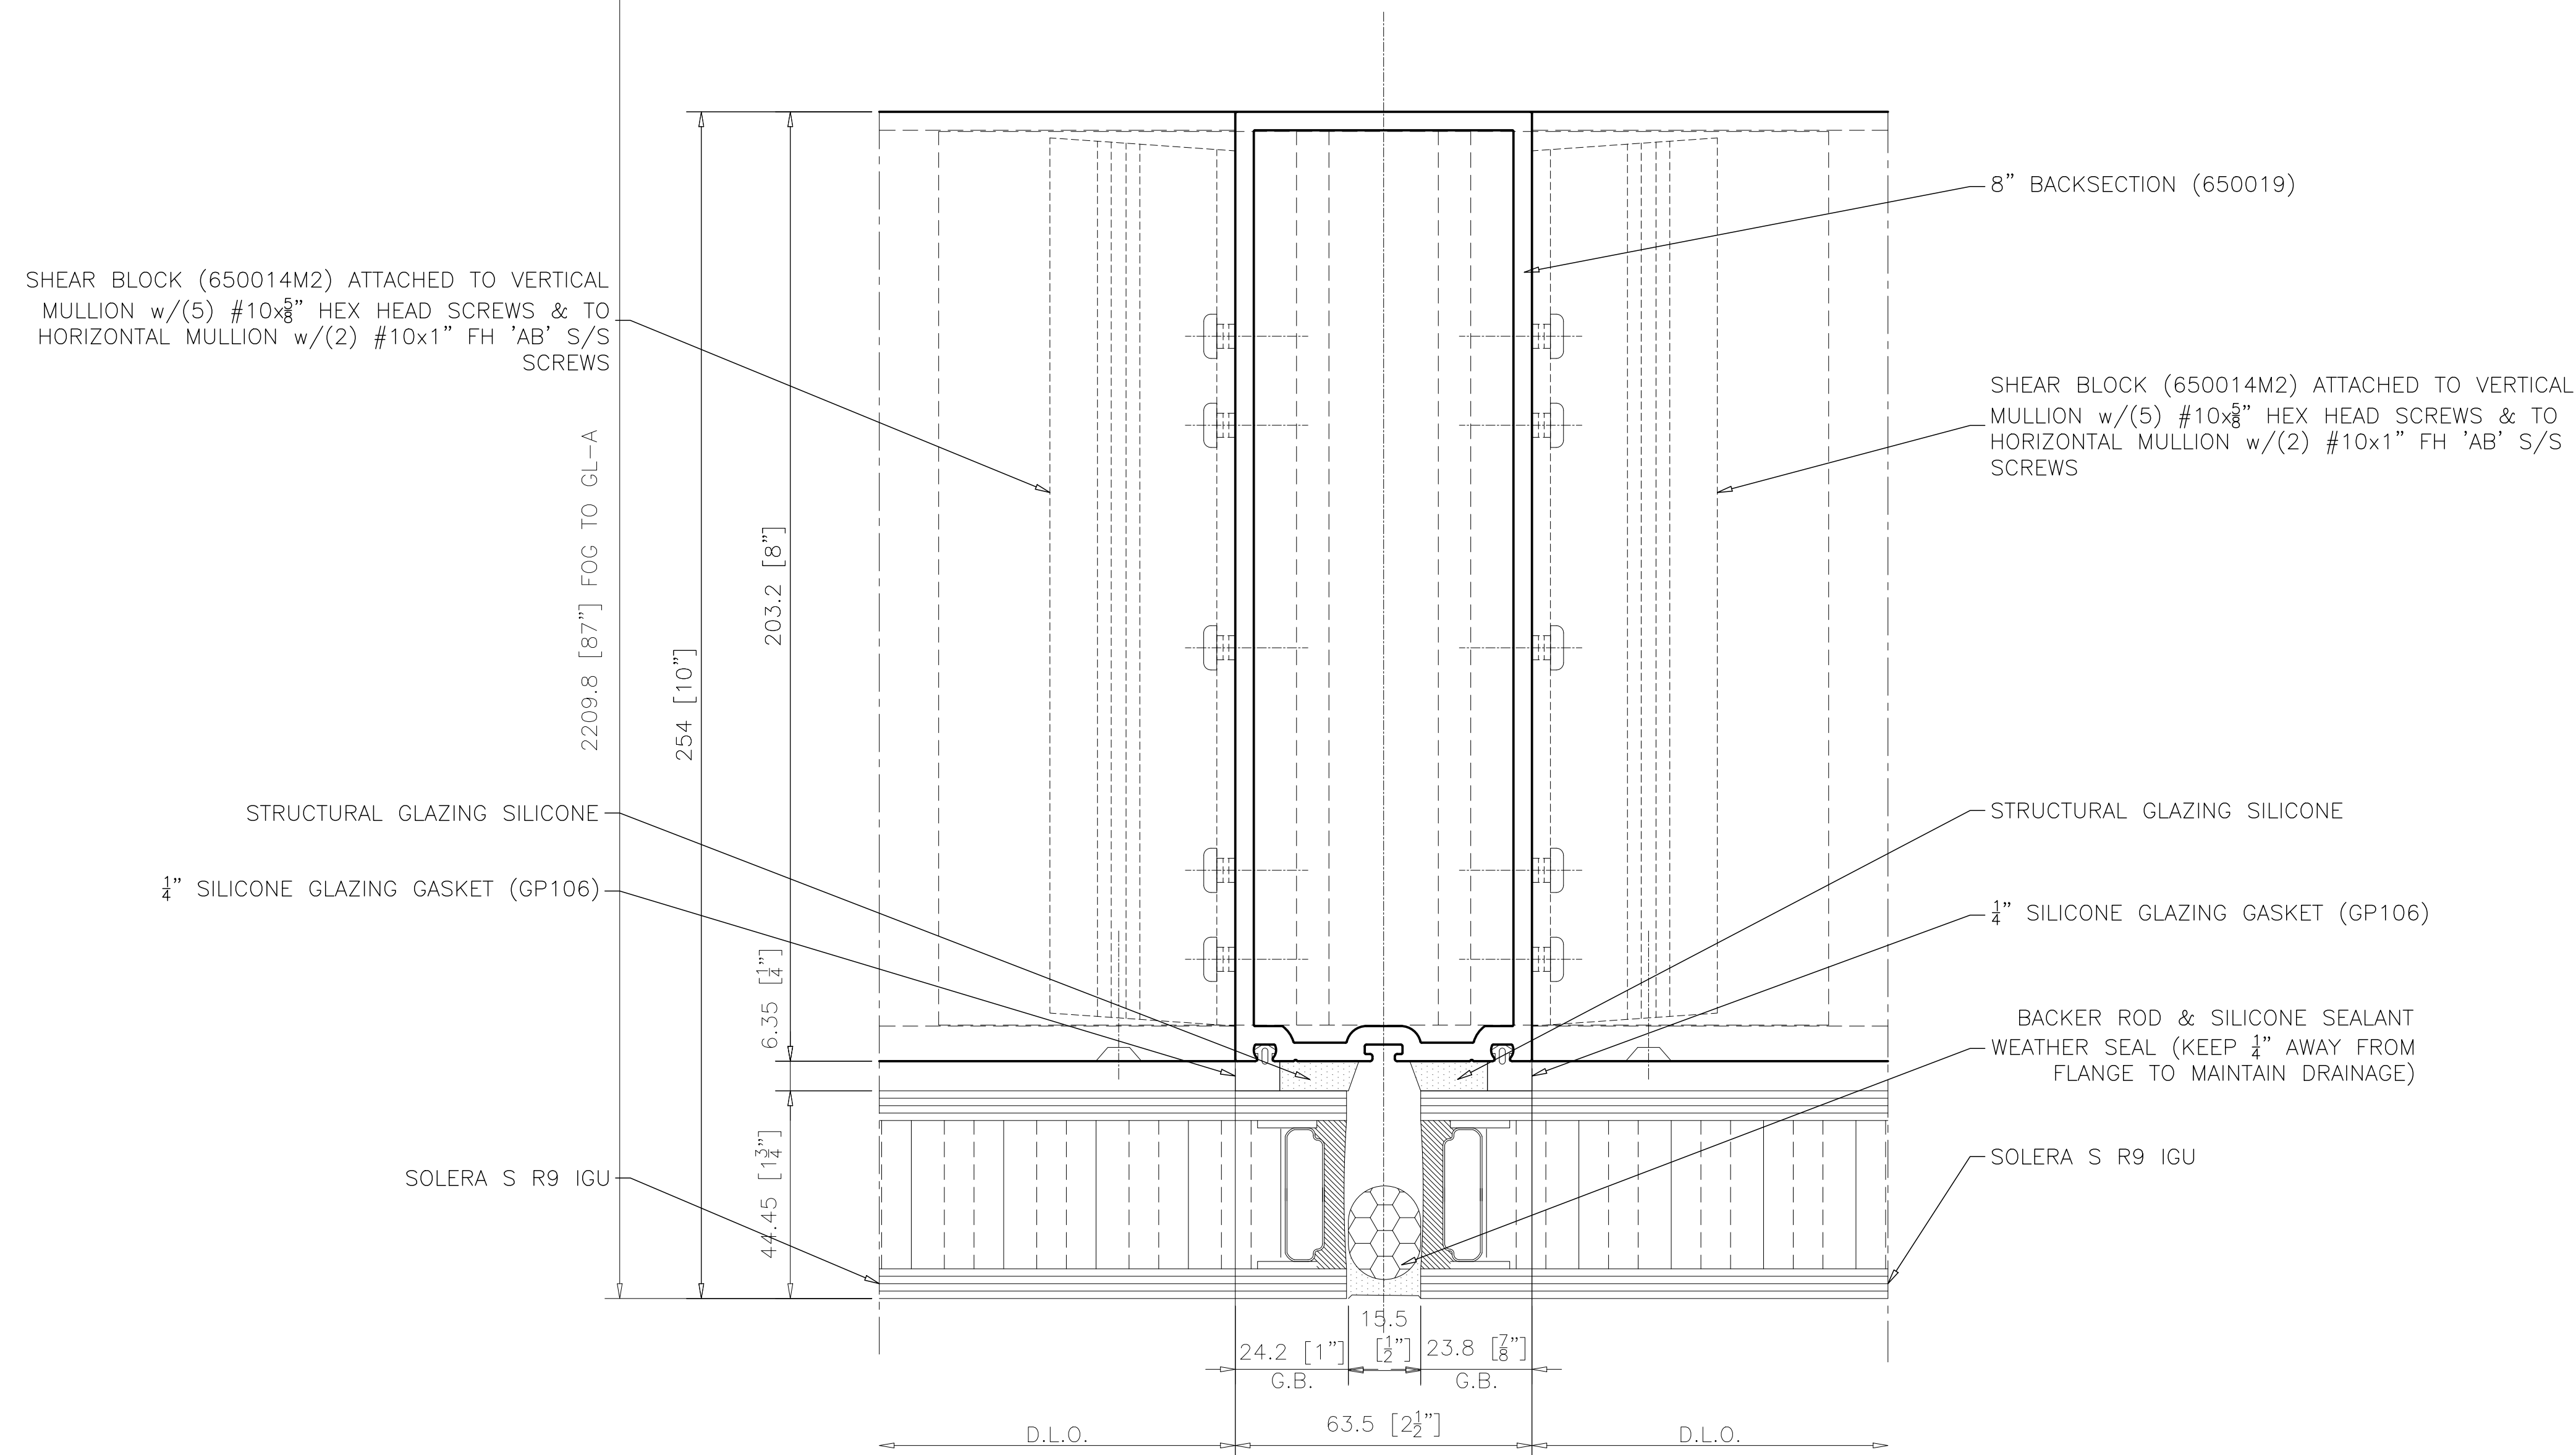

1  
C4-003G

INT. VERTICAL SSG 8" BS  
AT SOLERA BESIDE SOLERA GLAZING

ARCH. REF.: N/A


| REVISIONS |                                              |          |     |
|-----------|----------------------------------------------|----------|-----|
| No.       | Description:                                 | Date:    | By: |
| 1         | Revised per arch. markups received Feb 11/26 | 03/03/26 | SLR |
|           |                                              |          |     |
|           |                                              |          |     |
|                   |                            |
|-------------------|----------------------------|
| Project Name:     | DOCKSTEADER PRPS           |
| Project Location: | BRAMPTON, ONTARIO          |
| Architect Name:   | DIAMOND SCHMITT ARCHITECTS |
| Customer Name:    | BOTHWELL ACCURATE GLAZING  |



275 Britannia Road East • Mississauga • Ontario • Canada • L4Z2E7  
905-890-6970 • oldcastlebe.com

|                 |               |
|-----------------|---------------|
| Drawing Name:   |               |
| PLAN DETAIL     |               |
| Drawn By:       | Checked By:   |
| SR              | NP            |
| Drawn Date:     | Issue No.:    |
| 2026/01/12      | 1             |
| Scale:          | Release Date: |
| 1"=1"           | 2026/03/03    |
| Drawing Number: | C4-003G       |

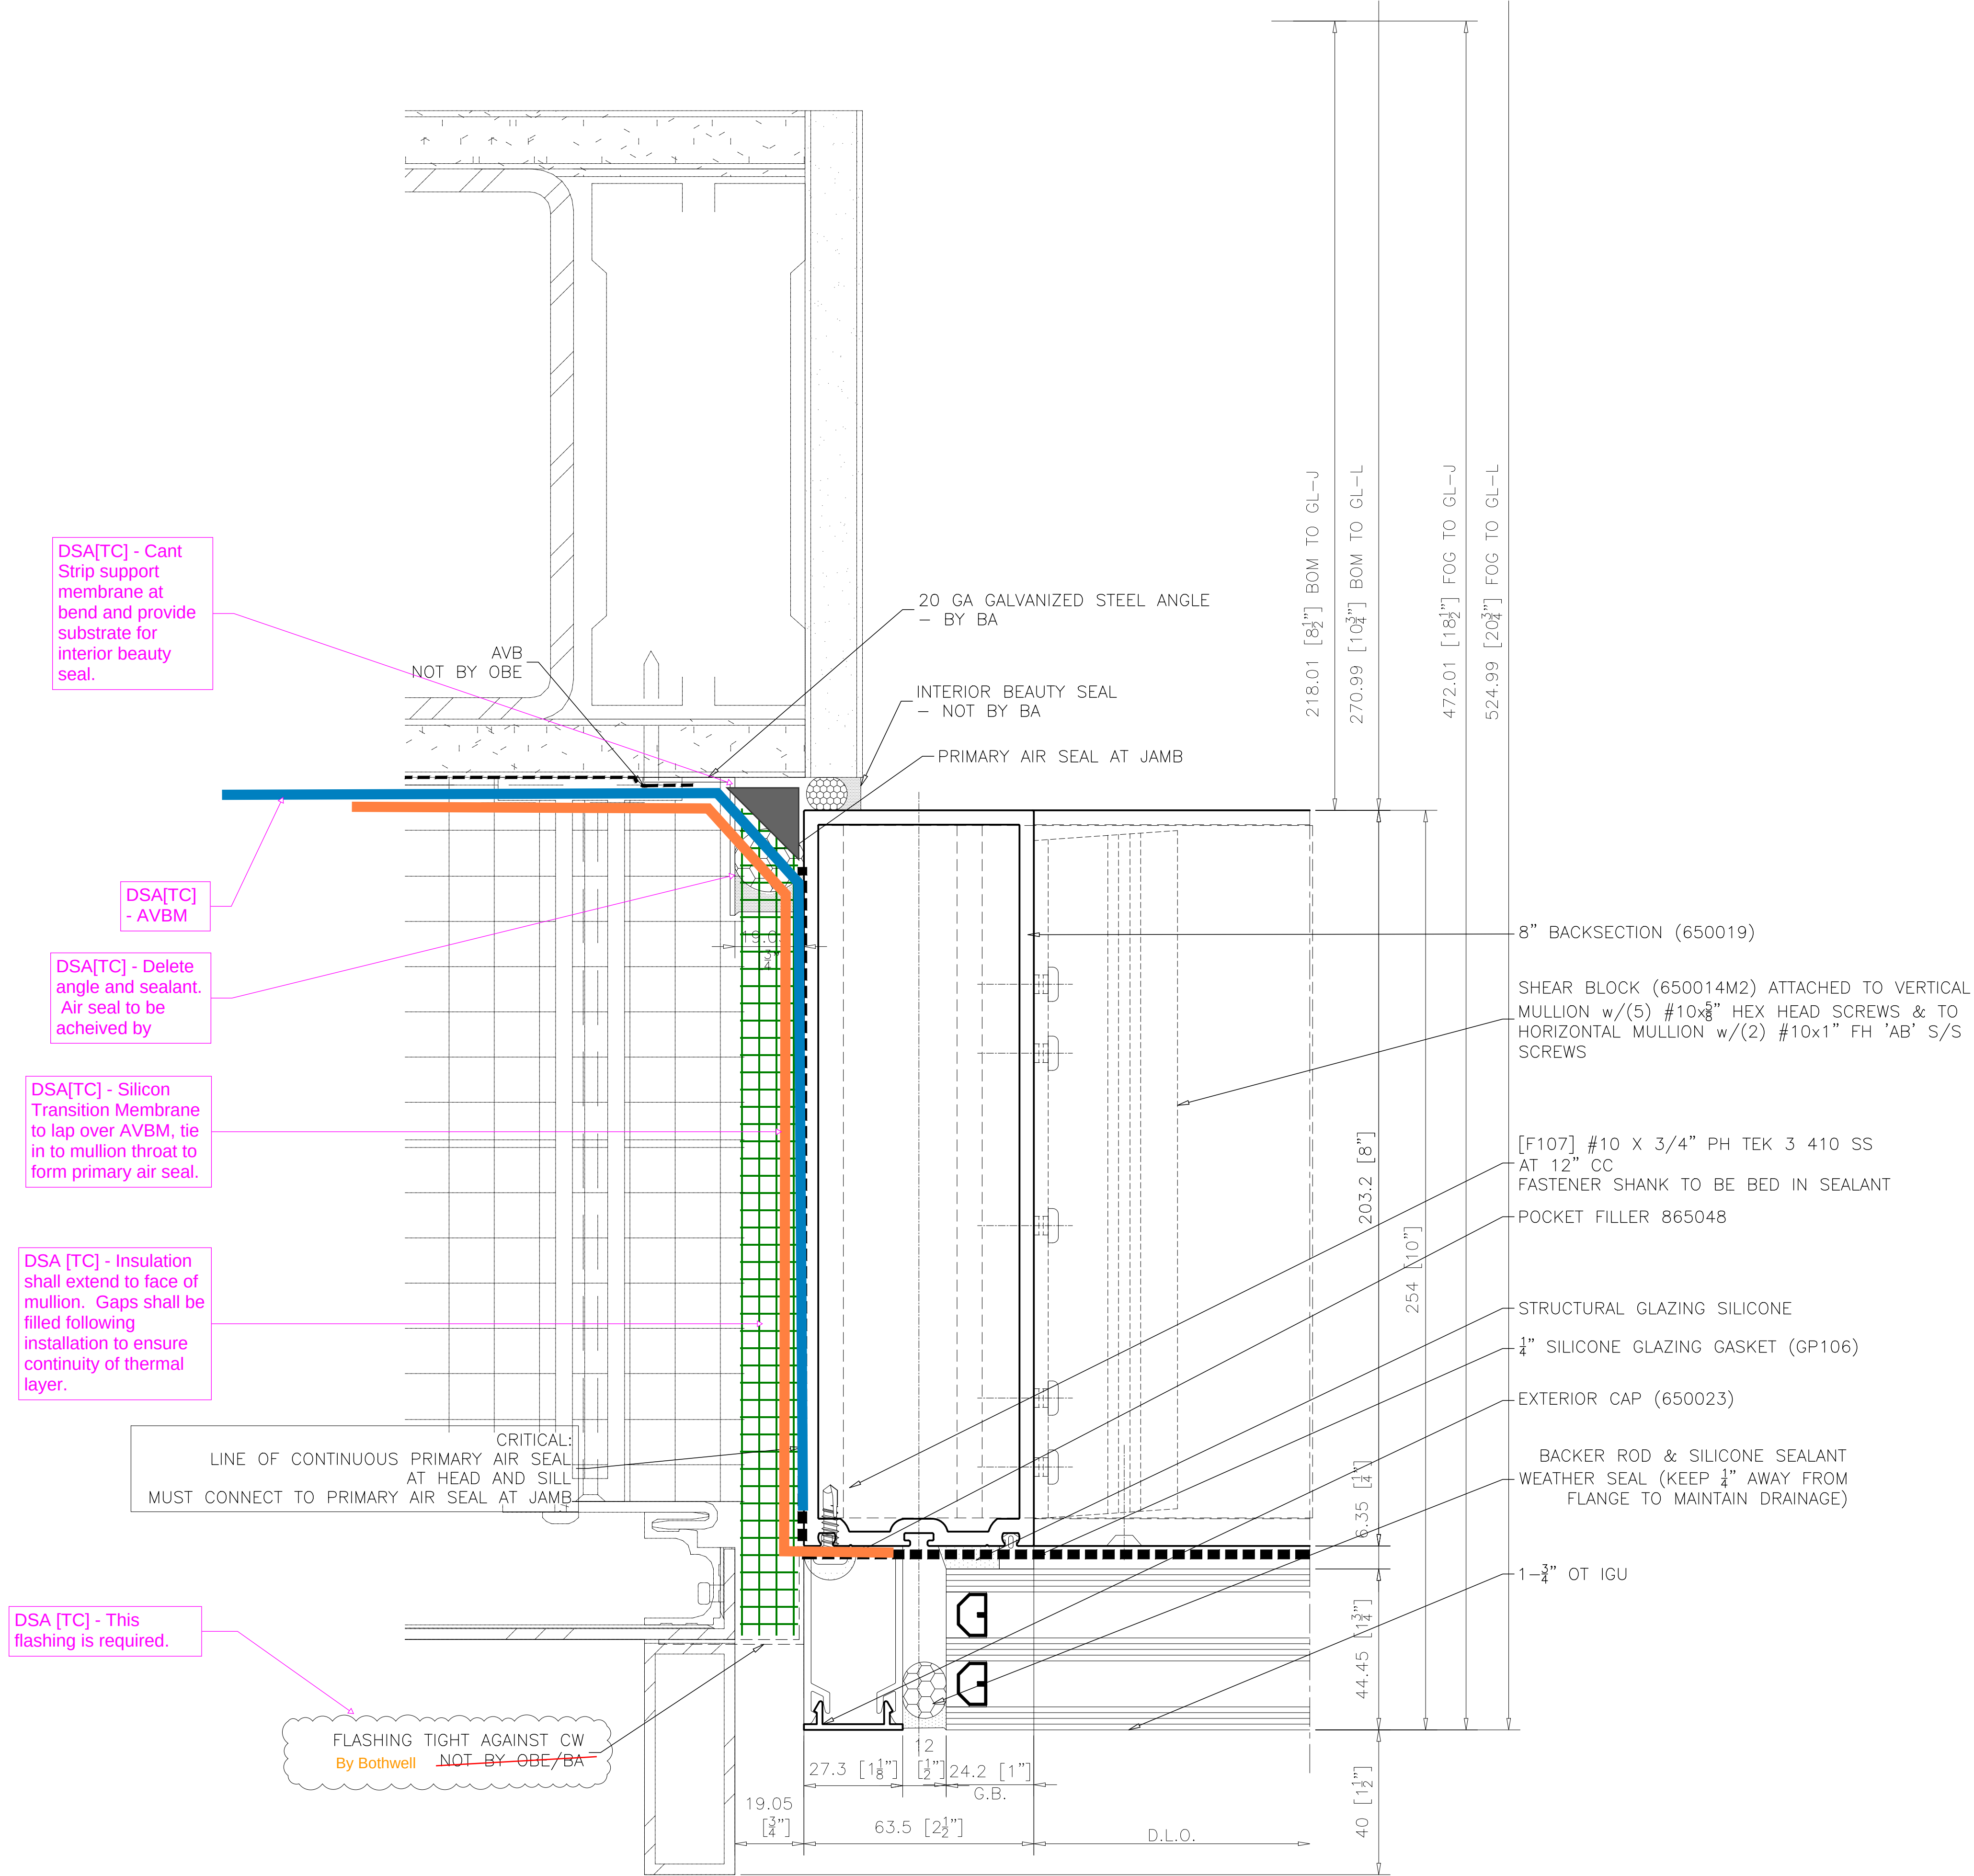

1  
C4-004

JAMB VERTICAL SSG 8" B.S.  
AT VISION GLAZING

ARCH. REF.: 5/A501


| REVISIONS |                                              |          |     |
|-----------|----------------------------------------------|----------|-----|
| No.       | Description:                                 | Date:    | By: |
| 1         | Revised per arch. markups received Feb 11/26 | 03/03/26 | SLR |
|           |                                              |          |     |
|           |                                              |          |     |
|                                   |                                        |                                               |                                             |
|-----------------------------------|----------------------------------------|-----------------------------------------------|---------------------------------------------|
| Project Name:<br>DOCKSTEADER PRPS | Project Location:<br>BRAMPTON, ONTARIO | Architect Name:<br>DIAMOND SCHMITT ARCHITECTS | Customer Name:<br>BOTHWELL ACCURATE GLAZING |
|-----------------------------------|----------------------------------------|-----------------------------------------------|---------------------------------------------|

**Oldcastle BuildingEnvelope®**

275 Britannia Road East • Mississauga • Ontario • Canada • L4Z2E7  
905-890-6970 • oldcastlebe.com

|                              |                             |
|------------------------------|-----------------------------|
| Drawing Name:<br>PLAN DETAIL |                             |
| Drawn By:<br>SR              | Checked By:<br>NP           |
| Drawn Date:<br>2026/01/12    | Issue No.:<br>1             |
| Scale:<br>1"=1'              | Release Date:<br>2026/03/03 |
| Drawing Number:<br>C4-004    |                             |

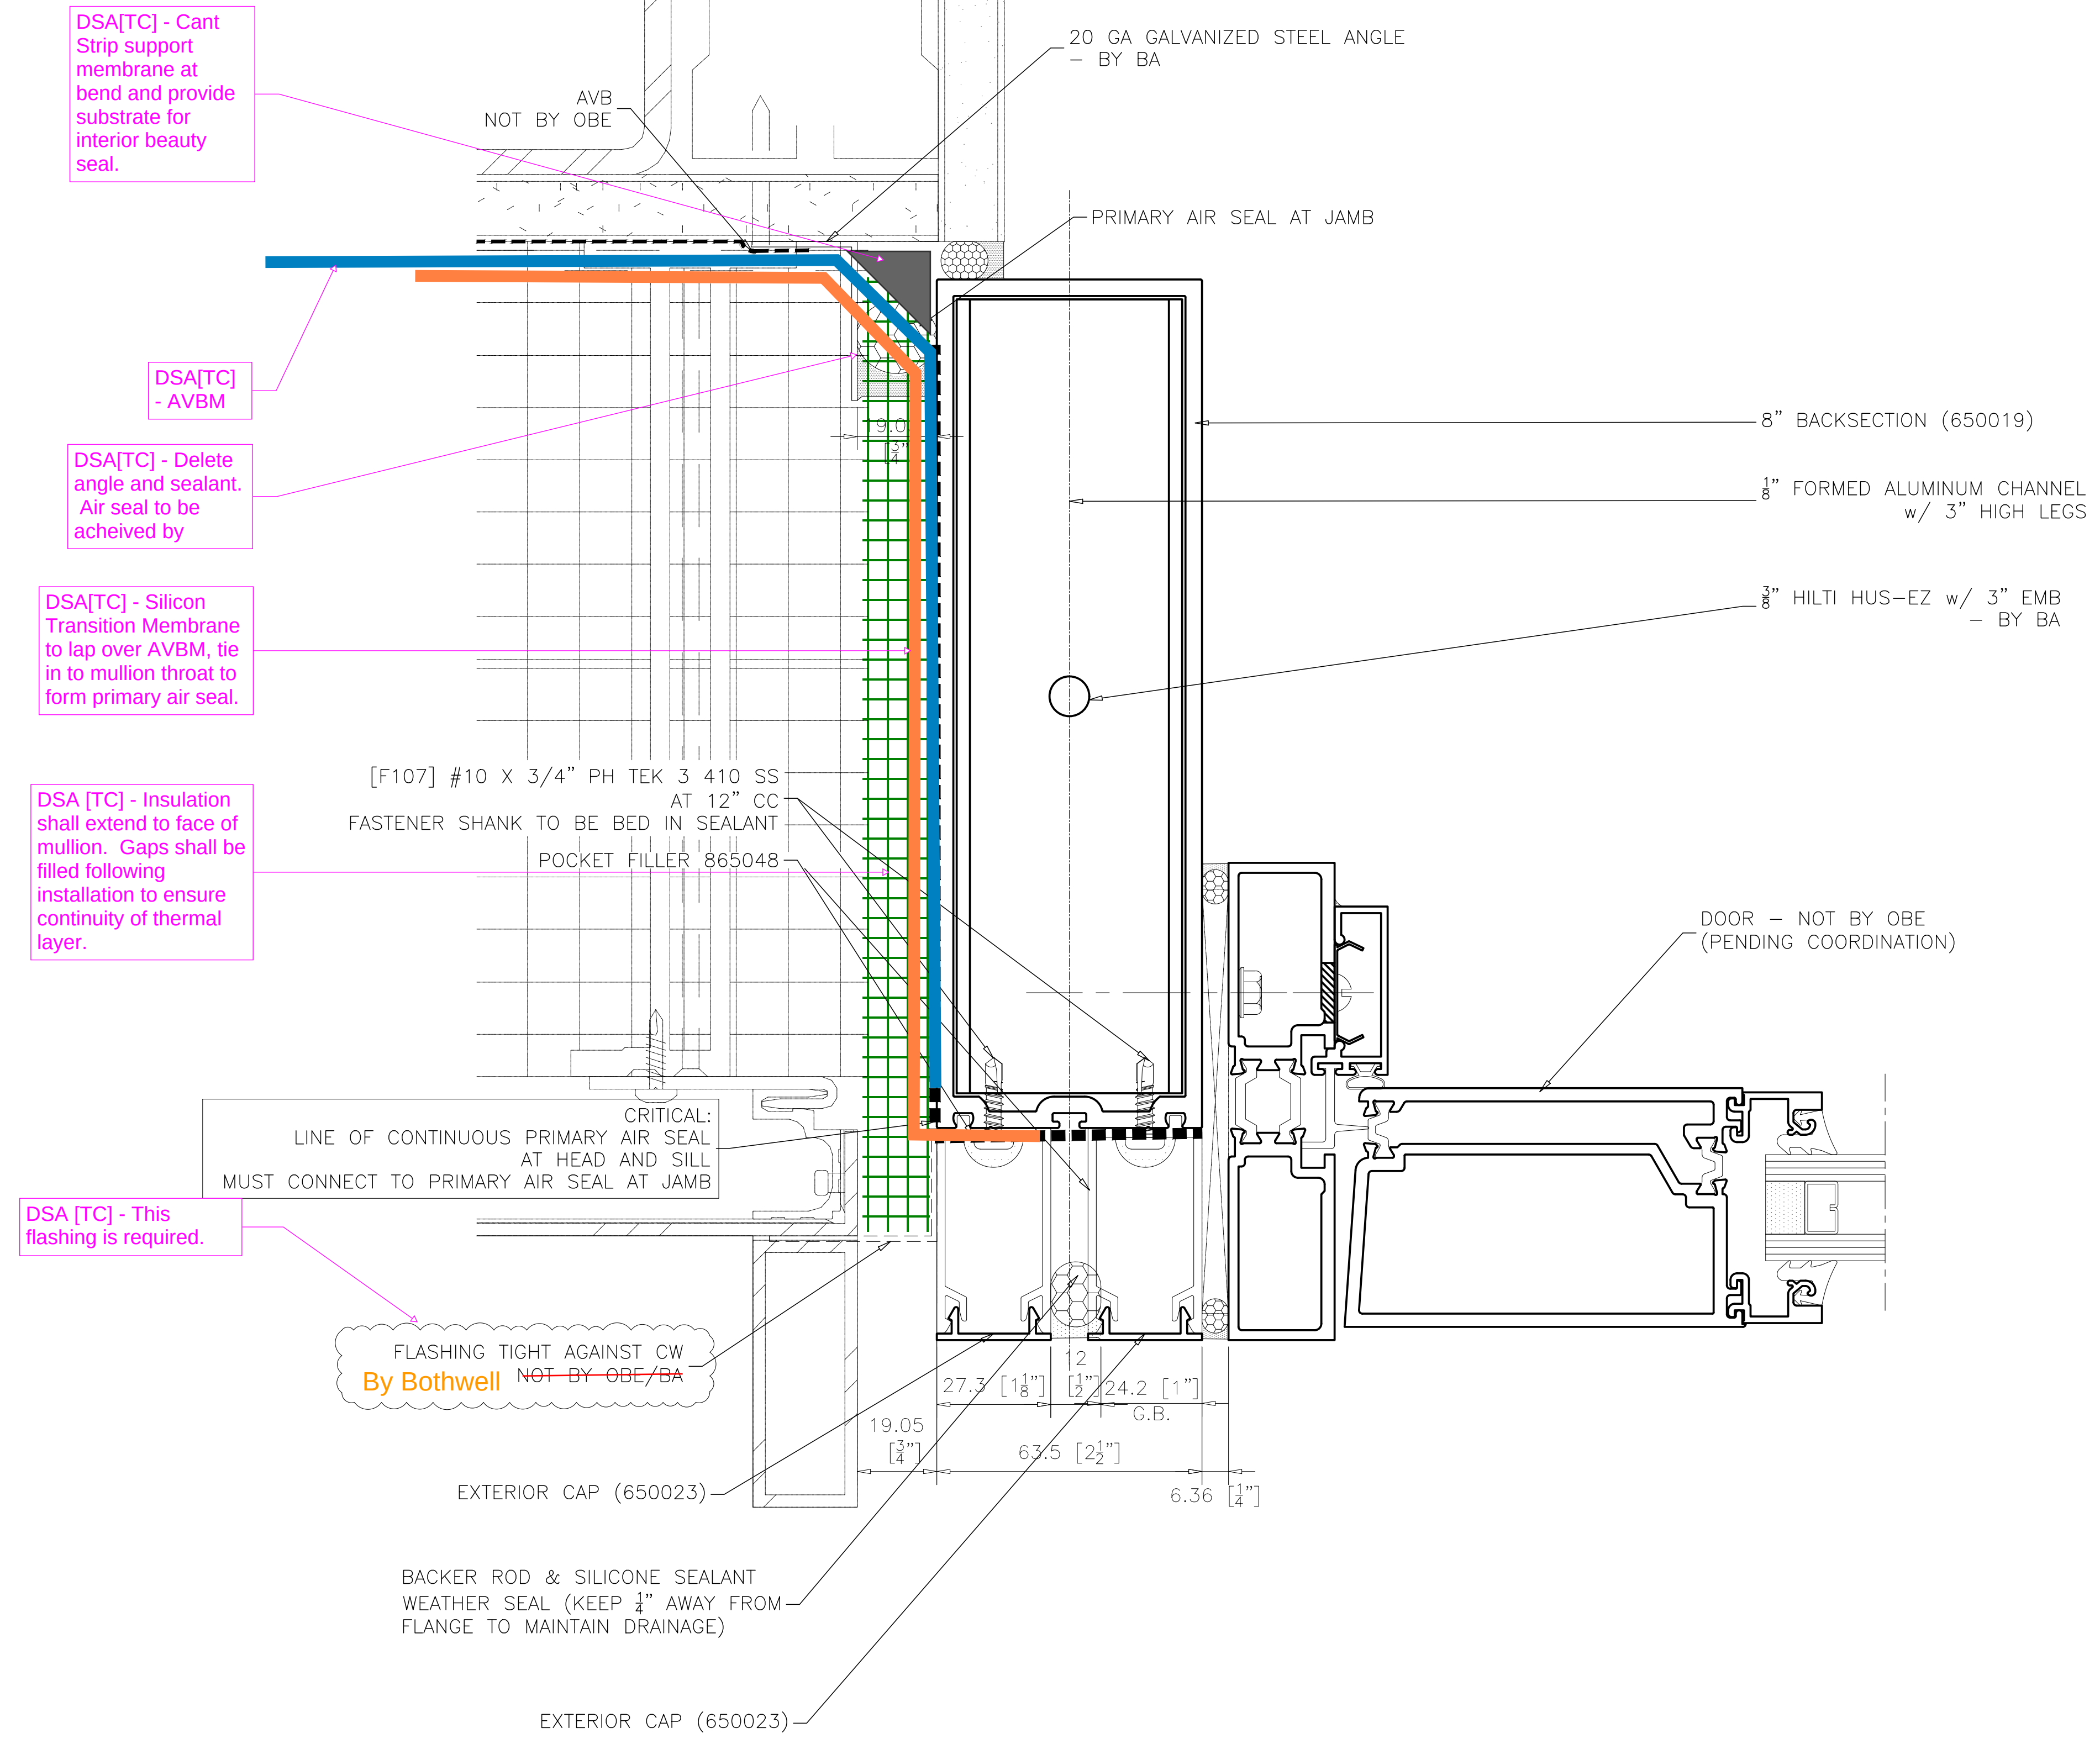

1  
C4-004A

JAMB VERTICAL SSG 8" B.S.  
AT DOOR

ARCH. REF.: 5/A501


| REVISIONS |                                              |          |     |
|-----------|----------------------------------------------|----------|-----|
| No.       | Description:                                 | Date:    | By: |
| 1         | Revised per arch. markups received Feb 11/26 | 03/03/26 | SLR |
|           |                                              |          |     |
|           |                                              |          |     |
|                                   |                                        |                                               |                                             |
|-----------------------------------|----------------------------------------|-----------------------------------------------|---------------------------------------------|
| Project Name:<br>DOCKSTEADER PRPS | Project Location:<br>BRAMPTON, ONTARIO | Architect Name:<br>DIAMOND SCHMITT ARCHITECTS | Customer Name:<br>BOTHWELL ACCURATE GLAZING |
|-----------------------------------|----------------------------------------|-----------------------------------------------|---------------------------------------------|



2775 Britannia Road East • Mississauga • Ontario • Canada • L4Z2E7  
905-890-6970 • oldcastlebe.com

|                              |                             |
|------------------------------|-----------------------------|
| Drawing Name:<br>PLAN DETAIL |                             |
| Drawn By:<br>SR              | Checked By:<br>NP           |
| Drawn Date:<br>2026/01/12    | Issue No.:<br>1             |
| Scale:<br>1"=1"              | Release Date:<br>2026/03/03 |
| Drawing Number:<br>C4-004A   |                             |

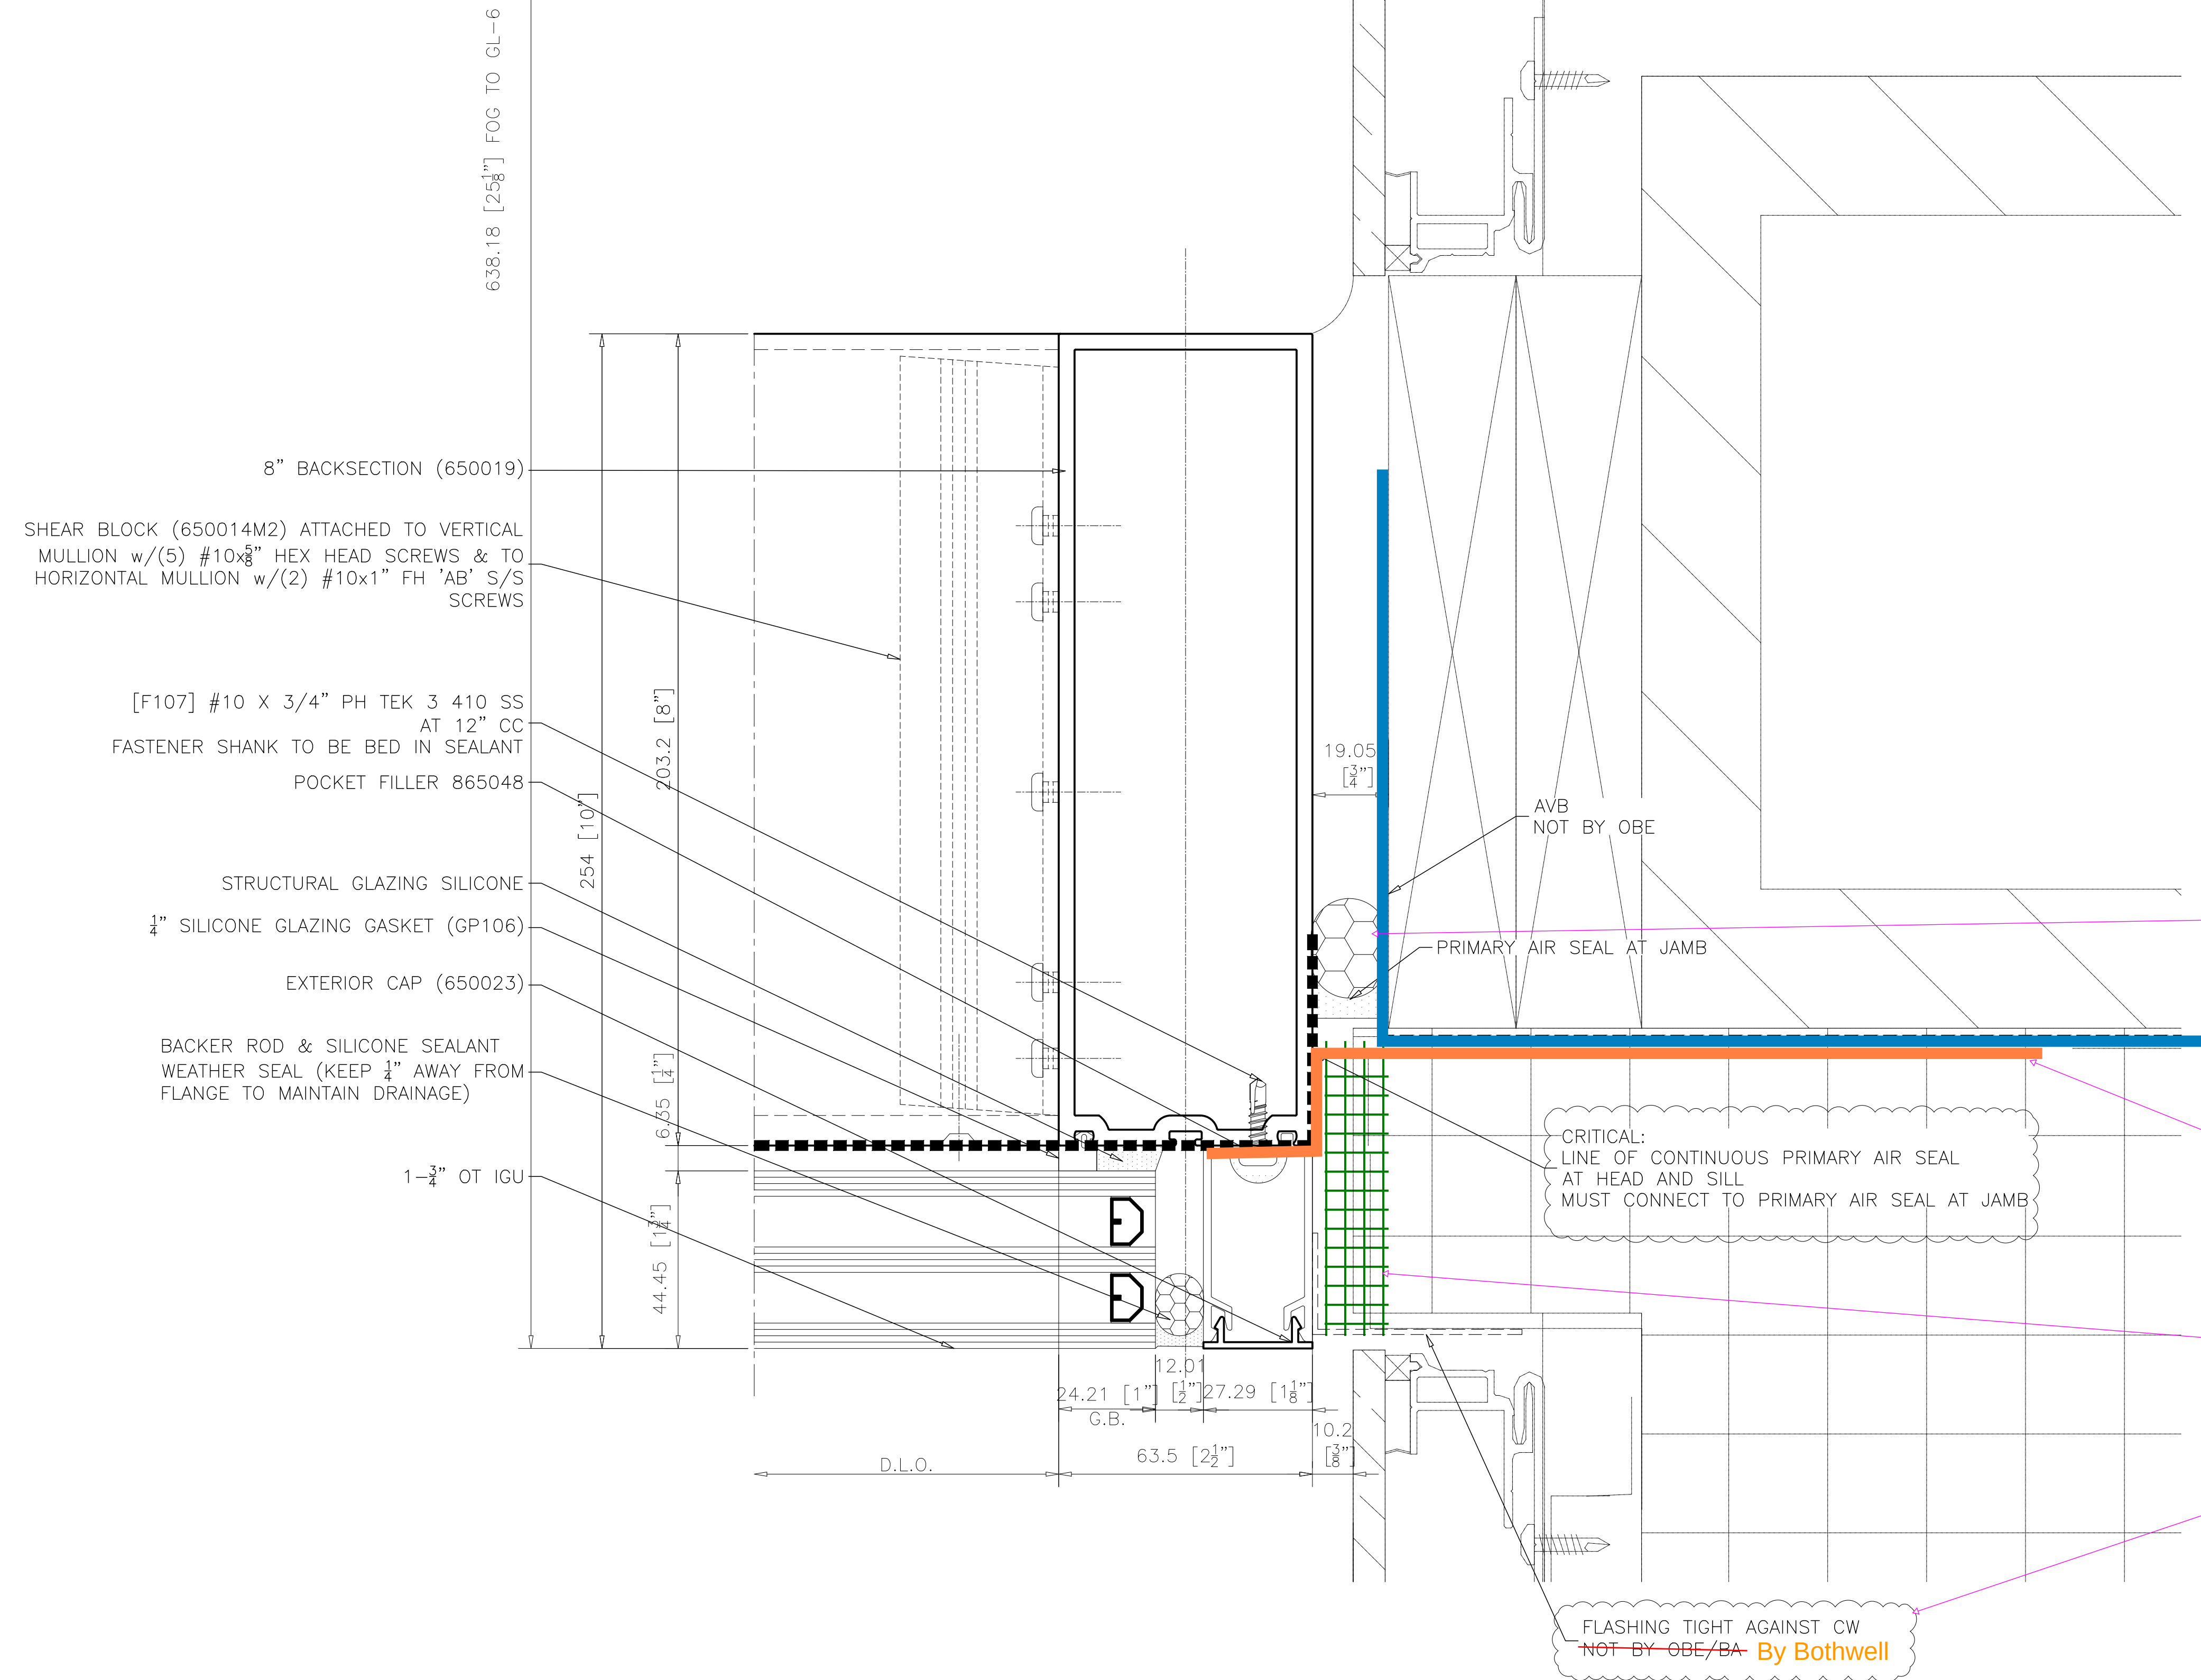

1  
C4-004B

JAMB VERTICAL SSG 8" B.S.  
AT VISION GLAZING

ARCH. REF.: 6/A502


| REVISIONS |                                              |          |     |
|-----------|----------------------------------------------|----------|-----|
| No.       | Description:                                 | Date:    | By: |
| 1         | Revised per arch. markups received Feb 11/26 | 03/03/26 | SLR |
|           |                                              |          |     |
|           |                                              |          |     |
|                                   |                                        |                                               |                                             |
|-----------------------------------|----------------------------------------|-----------------------------------------------|---------------------------------------------|
| Project Name:<br>DOCKSTEADER PRPS | Project Location:<br>BRAMPTON, ONTARIO | Architect Name:<br>DIAMOND SCHMITT ARCHITECTS | Customer Name:<br>BOTHWELL ACCURATE GLAZING |
|-----------------------------------|----------------------------------------|-----------------------------------------------|---------------------------------------------|



275 Britannia Road East • Mississauga • Ontario • Canada • L4Z2E7  
905-890-6970 • oldcastlebe.com

|                              |                             |
|------------------------------|-----------------------------|
| Drawing Name:<br>PLAN DETAIL |                             |
| Drawn By:<br>SR              | Checked By:<br>NP           |
| Drawn Date:<br>2026/01/12    | Issue No.:<br>1             |
| Scale:<br>1"=1"              | Release Date:<br>2026/03/03 |
| Drawing Number:<br>C4-004B   |                             |

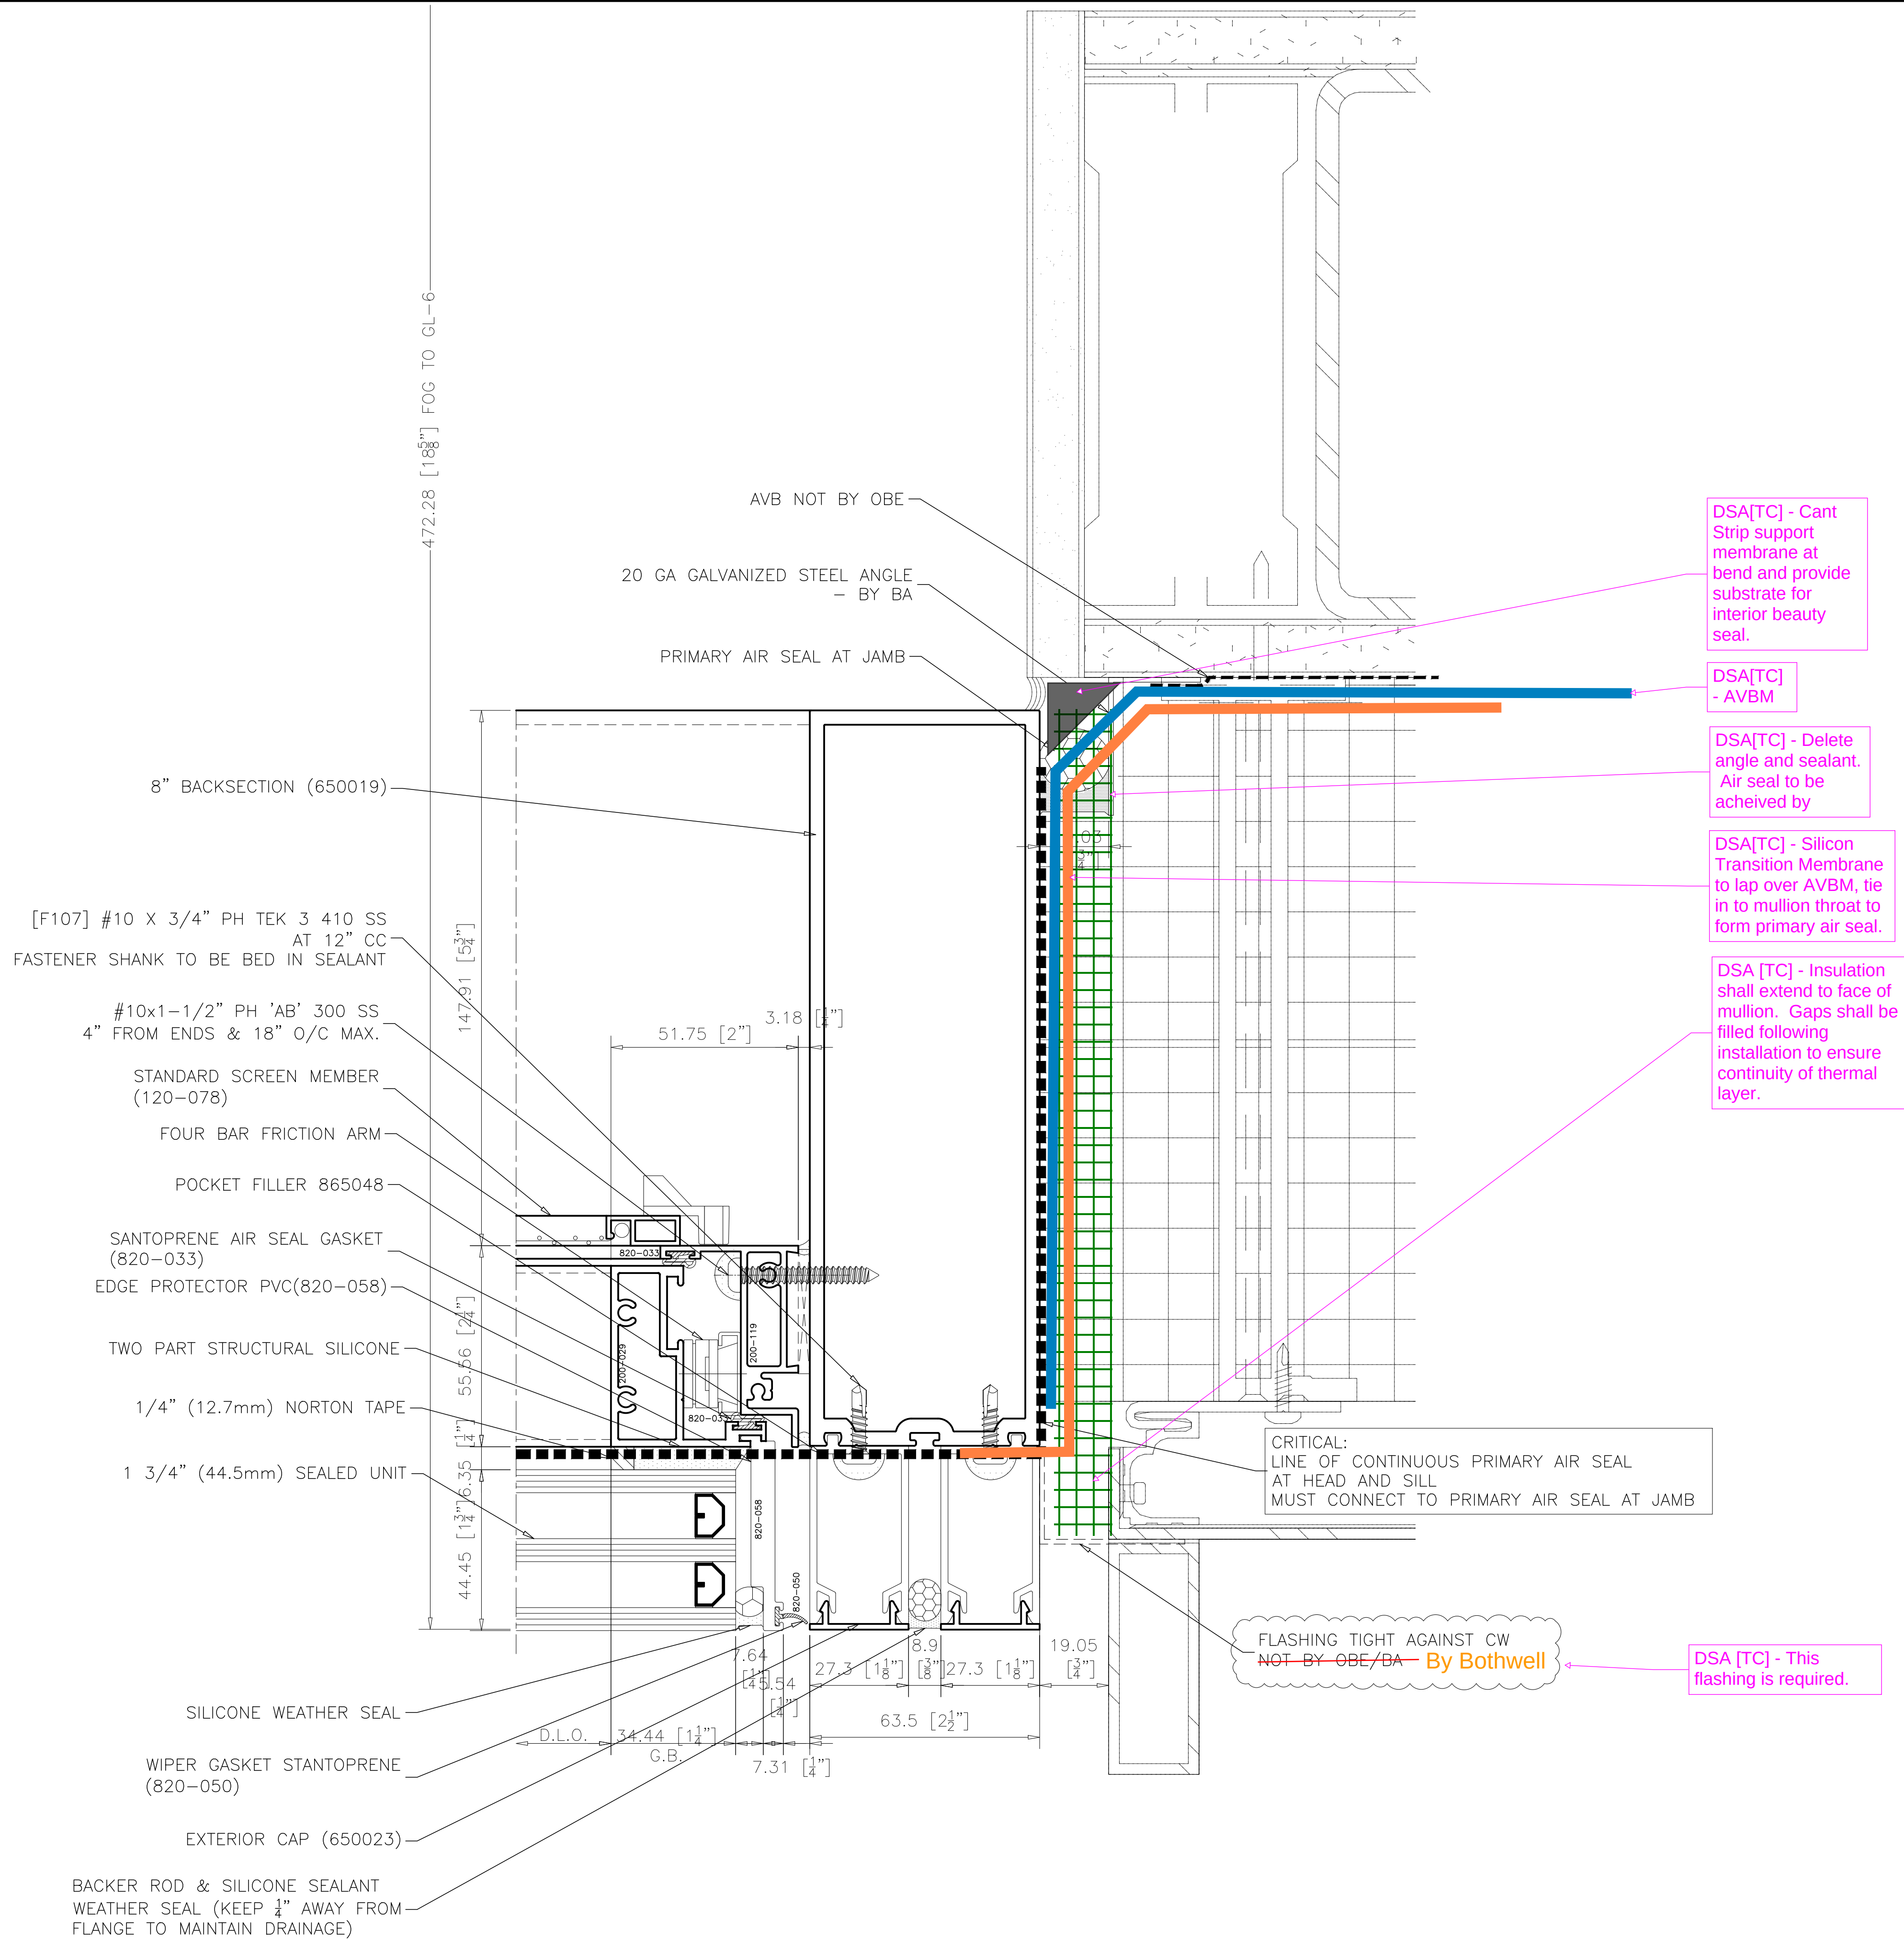

1  
C4-004C

**JAMB VERTICAL SSG 8" B.S.  
AT VENT**

ARCH. REF.: 5/A501


| REVISIONS |                                              |          |     |
|-----------|----------------------------------------------|----------|-----|
| No.       | Description:                                 | Date:    | By: |
| 1         | Revised per arch. markups received Feb 11/26 | 03/03/26 | SLR |
|           |                                              |          |     |
|           |                                              |          |     |
|                                   |                                        |                                               |                                             |
|-----------------------------------|----------------------------------------|-----------------------------------------------|---------------------------------------------|
| Project Name:<br>DOCKSTEADER PRPS | Project Location:<br>BRAMPTON, ONTARIO | Architect Name:<br>DIAMOND SCHMITT ARCHITECTS | Customer Name:<br>BOTHWELL ACCURATE GLAZING |
|-----------------------------------|----------------------------------------|-----------------------------------------------|---------------------------------------------|



275 Britannia Road East • Mississauga • Ontario • Canada • L4Z2E7  
905-890-6970 • oldcastlebe.com

|                                   |                             |
|-----------------------------------|-----------------------------|
| Drawing Name:<br>PLAN DETAIL      |                             |
| Drawn By:<br>SR                   | Checked By:<br>NP           |
| Drawn Date:<br>2026/01/12         | Issue No.:<br>1             |
| Scale:<br>1"=1'                   | Release Date:<br>2026/03/03 |
| Drawing Number:<br><b>C4-004C</b> |                             |

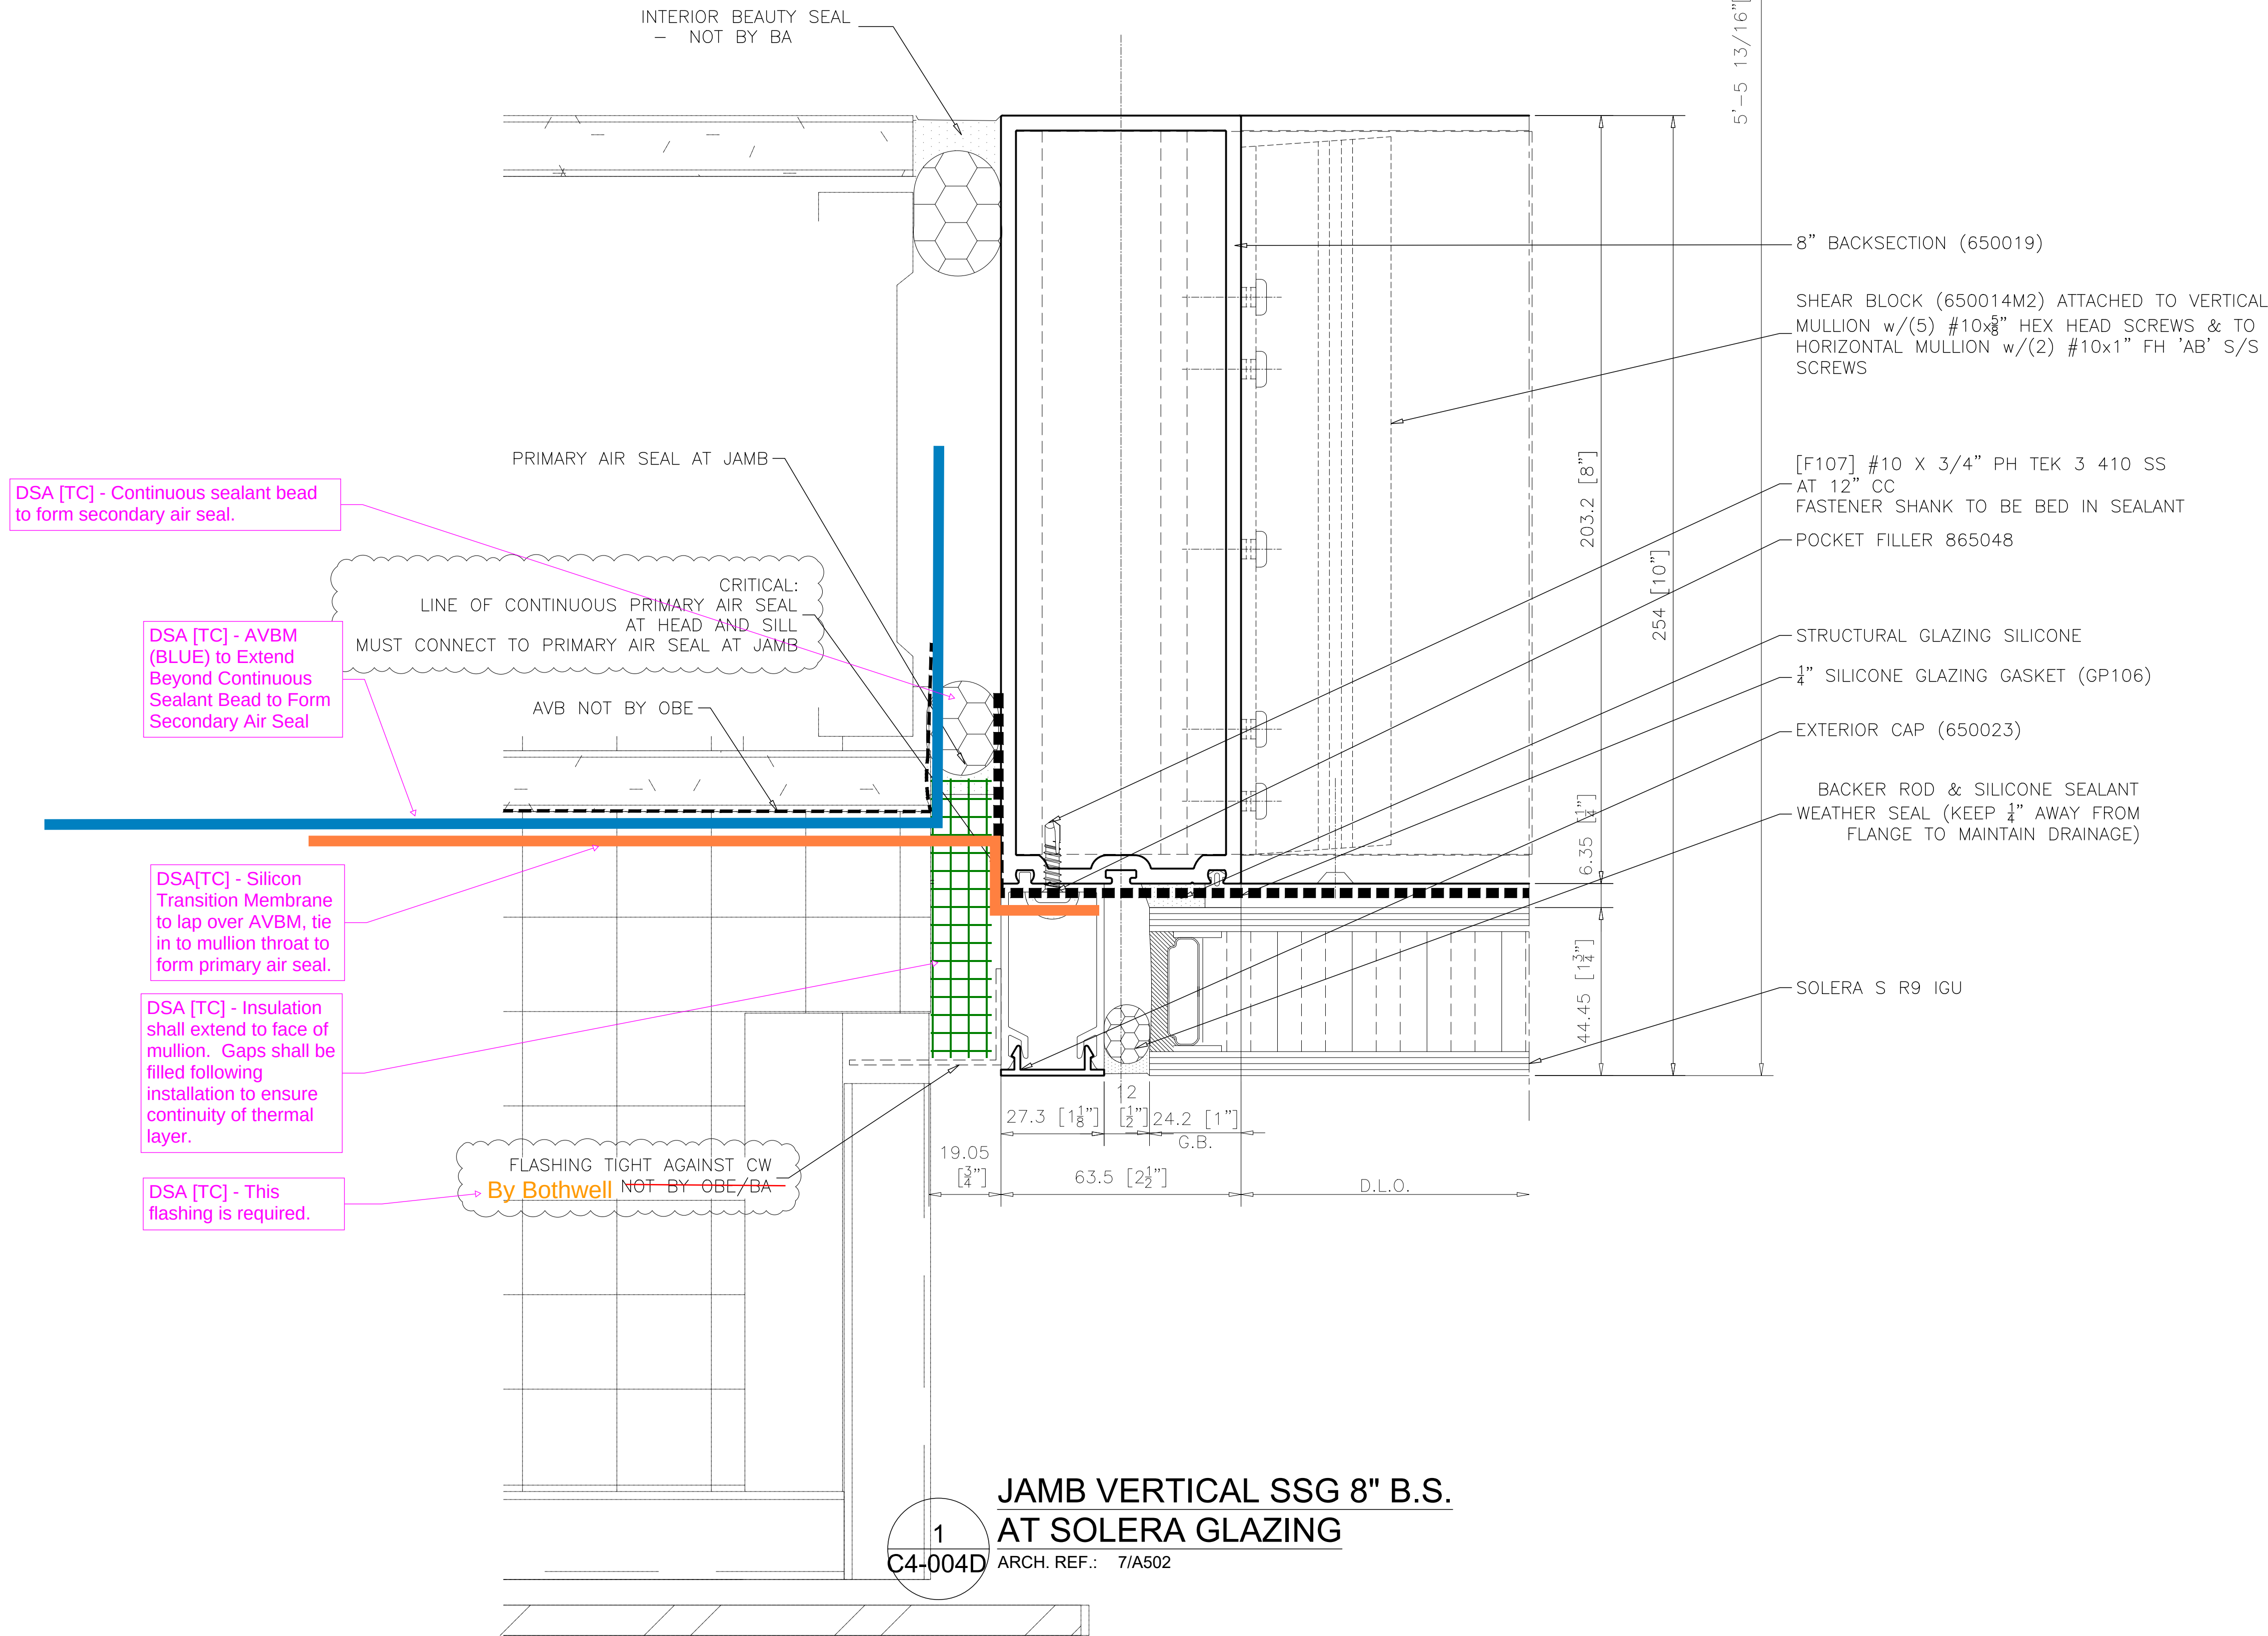

| REVISIONS |                                              |          |     |
|-----------|----------------------------------------------|----------|-----|
| No.       | Description:                                 | Date:    | By: |
| 1         | Revised per arch. markups received Feb 11/26 | 03/03/26 | SLR |
|           |                                              |          |     |
|           |                                              |          |     |
|                                   |                                        |                                               |                                             |
|-----------------------------------|----------------------------------------|-----------------------------------------------|---------------------------------------------|
| Project Name:<br>DOCKSTEADER PRPS | Project Location:<br>BRAMPTON, ONTARIO | Architect Name:<br>DIAMOND SCHMITT ARCHITECTS | Customer Name:<br>BOTHWELL ACCURATE GLAZING |
|-----------------------------------|----------------------------------------|-----------------------------------------------|---------------------------------------------|



275 Britannia Road East • Mississauga • Ontario • Canada • L4Z2E7  
905-890-6970 • oldcastlebe.com

Drawing Name:  
PLAN DETAIL


|                           |                             |
|---------------------------|-----------------------------|
| Drawn By:<br>SR           | Checked By:<br>NP           |
| Drawn Date:<br>2026/01/12 | Issue No.:<br>1             |
| Scale:<br>1"=1"           | Release Date:<br>2026/03/03 |

Drawing Number:  
C4-004D



275 Britannia Road East ▪ Mississauga ▪ Ontario ▪ Canada ▪ L4Z2E7  
905-890-6970 ▪ [oldcastlebe.com](http://oldcastlebe.com)

Drawing Number: C4-005

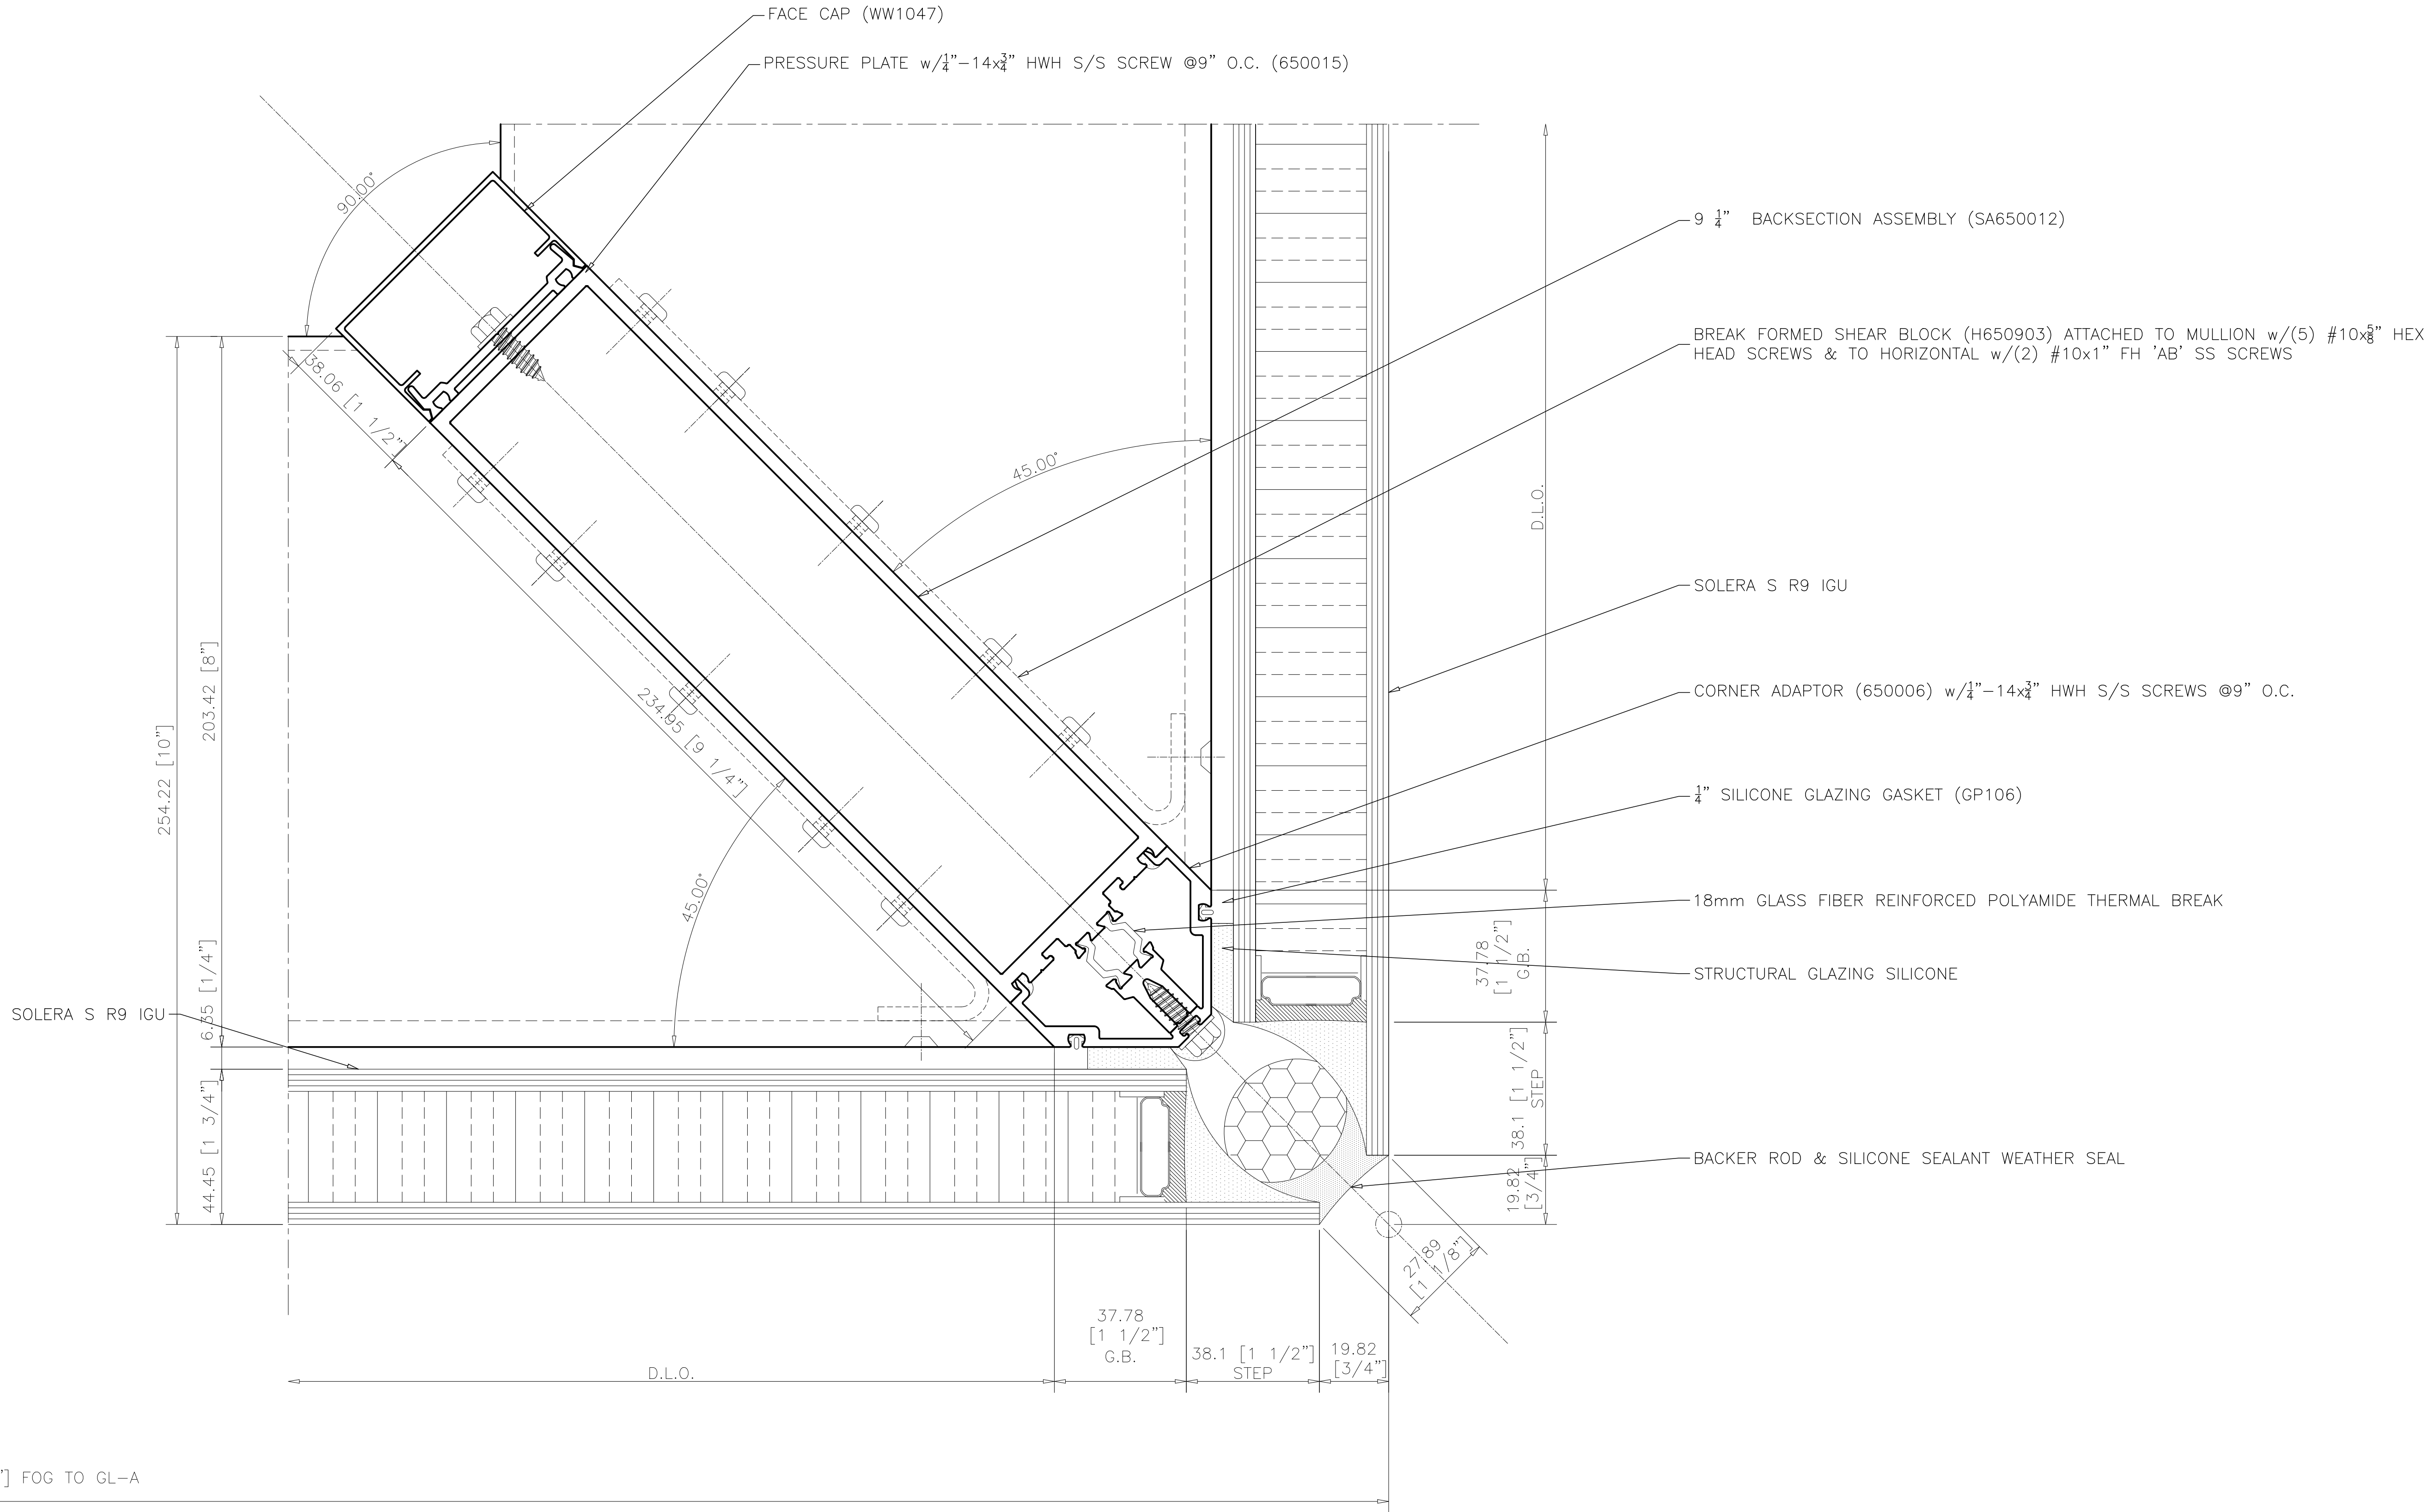


2219.33 [87 3/8"] FOG TO GL-A

1  
C4-005A CORNER VERTICAL SSG 8" B.S.  
AT SOLERA GLAZING  
ARCH. REF.: N/A


| REVISIONS |                                              |          |     |
|-----------|----------------------------------------------|----------|-----|
| No.       | Description:                                 | Date:    | By: |
| 1         | Revised per arch. markups received Feb 11/26 | 03/03/26 | SLR |
|           |                                              |          |     |
|           |                                              |          |     |
|                                   |                                        |                                               |                                             |
|-----------------------------------|----------------------------------------|-----------------------------------------------|---------------------------------------------|
| Project Name:<br>DOCKSTEADER PRPS | Project Location:<br>BRAMPTON, ONTARIO | Architect Name:<br>DIAMOND SCHMITT ARCHITECTS | Customer Name:<br>BOTHWELL ACCURATE GLAZING |
|-----------------------------------|----------------------------------------|-----------------------------------------------|---------------------------------------------|

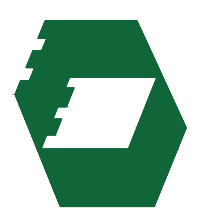**Oldcastle BuildingEnvelope®**

275 Britannia Road East • Mississauga • Ontario • Canada • L4Z2E7  
905-890-6970 • oldcastlebe.com

|                                   |                             |
|-----------------------------------|-----------------------------|
| Drawing Name:<br>PLAN DETAIL      |                             |
| Drawn By:<br>SR                   | Checked By:<br>NP           |
| Drawn Date:<br>2026/01/12         | Issue No.:<br>1             |
| Scale:<br>1"=1"                   | Release Date:<br>2026/03/03 |
| Drawing Number:<br><b>C4-005A</b> |                             |

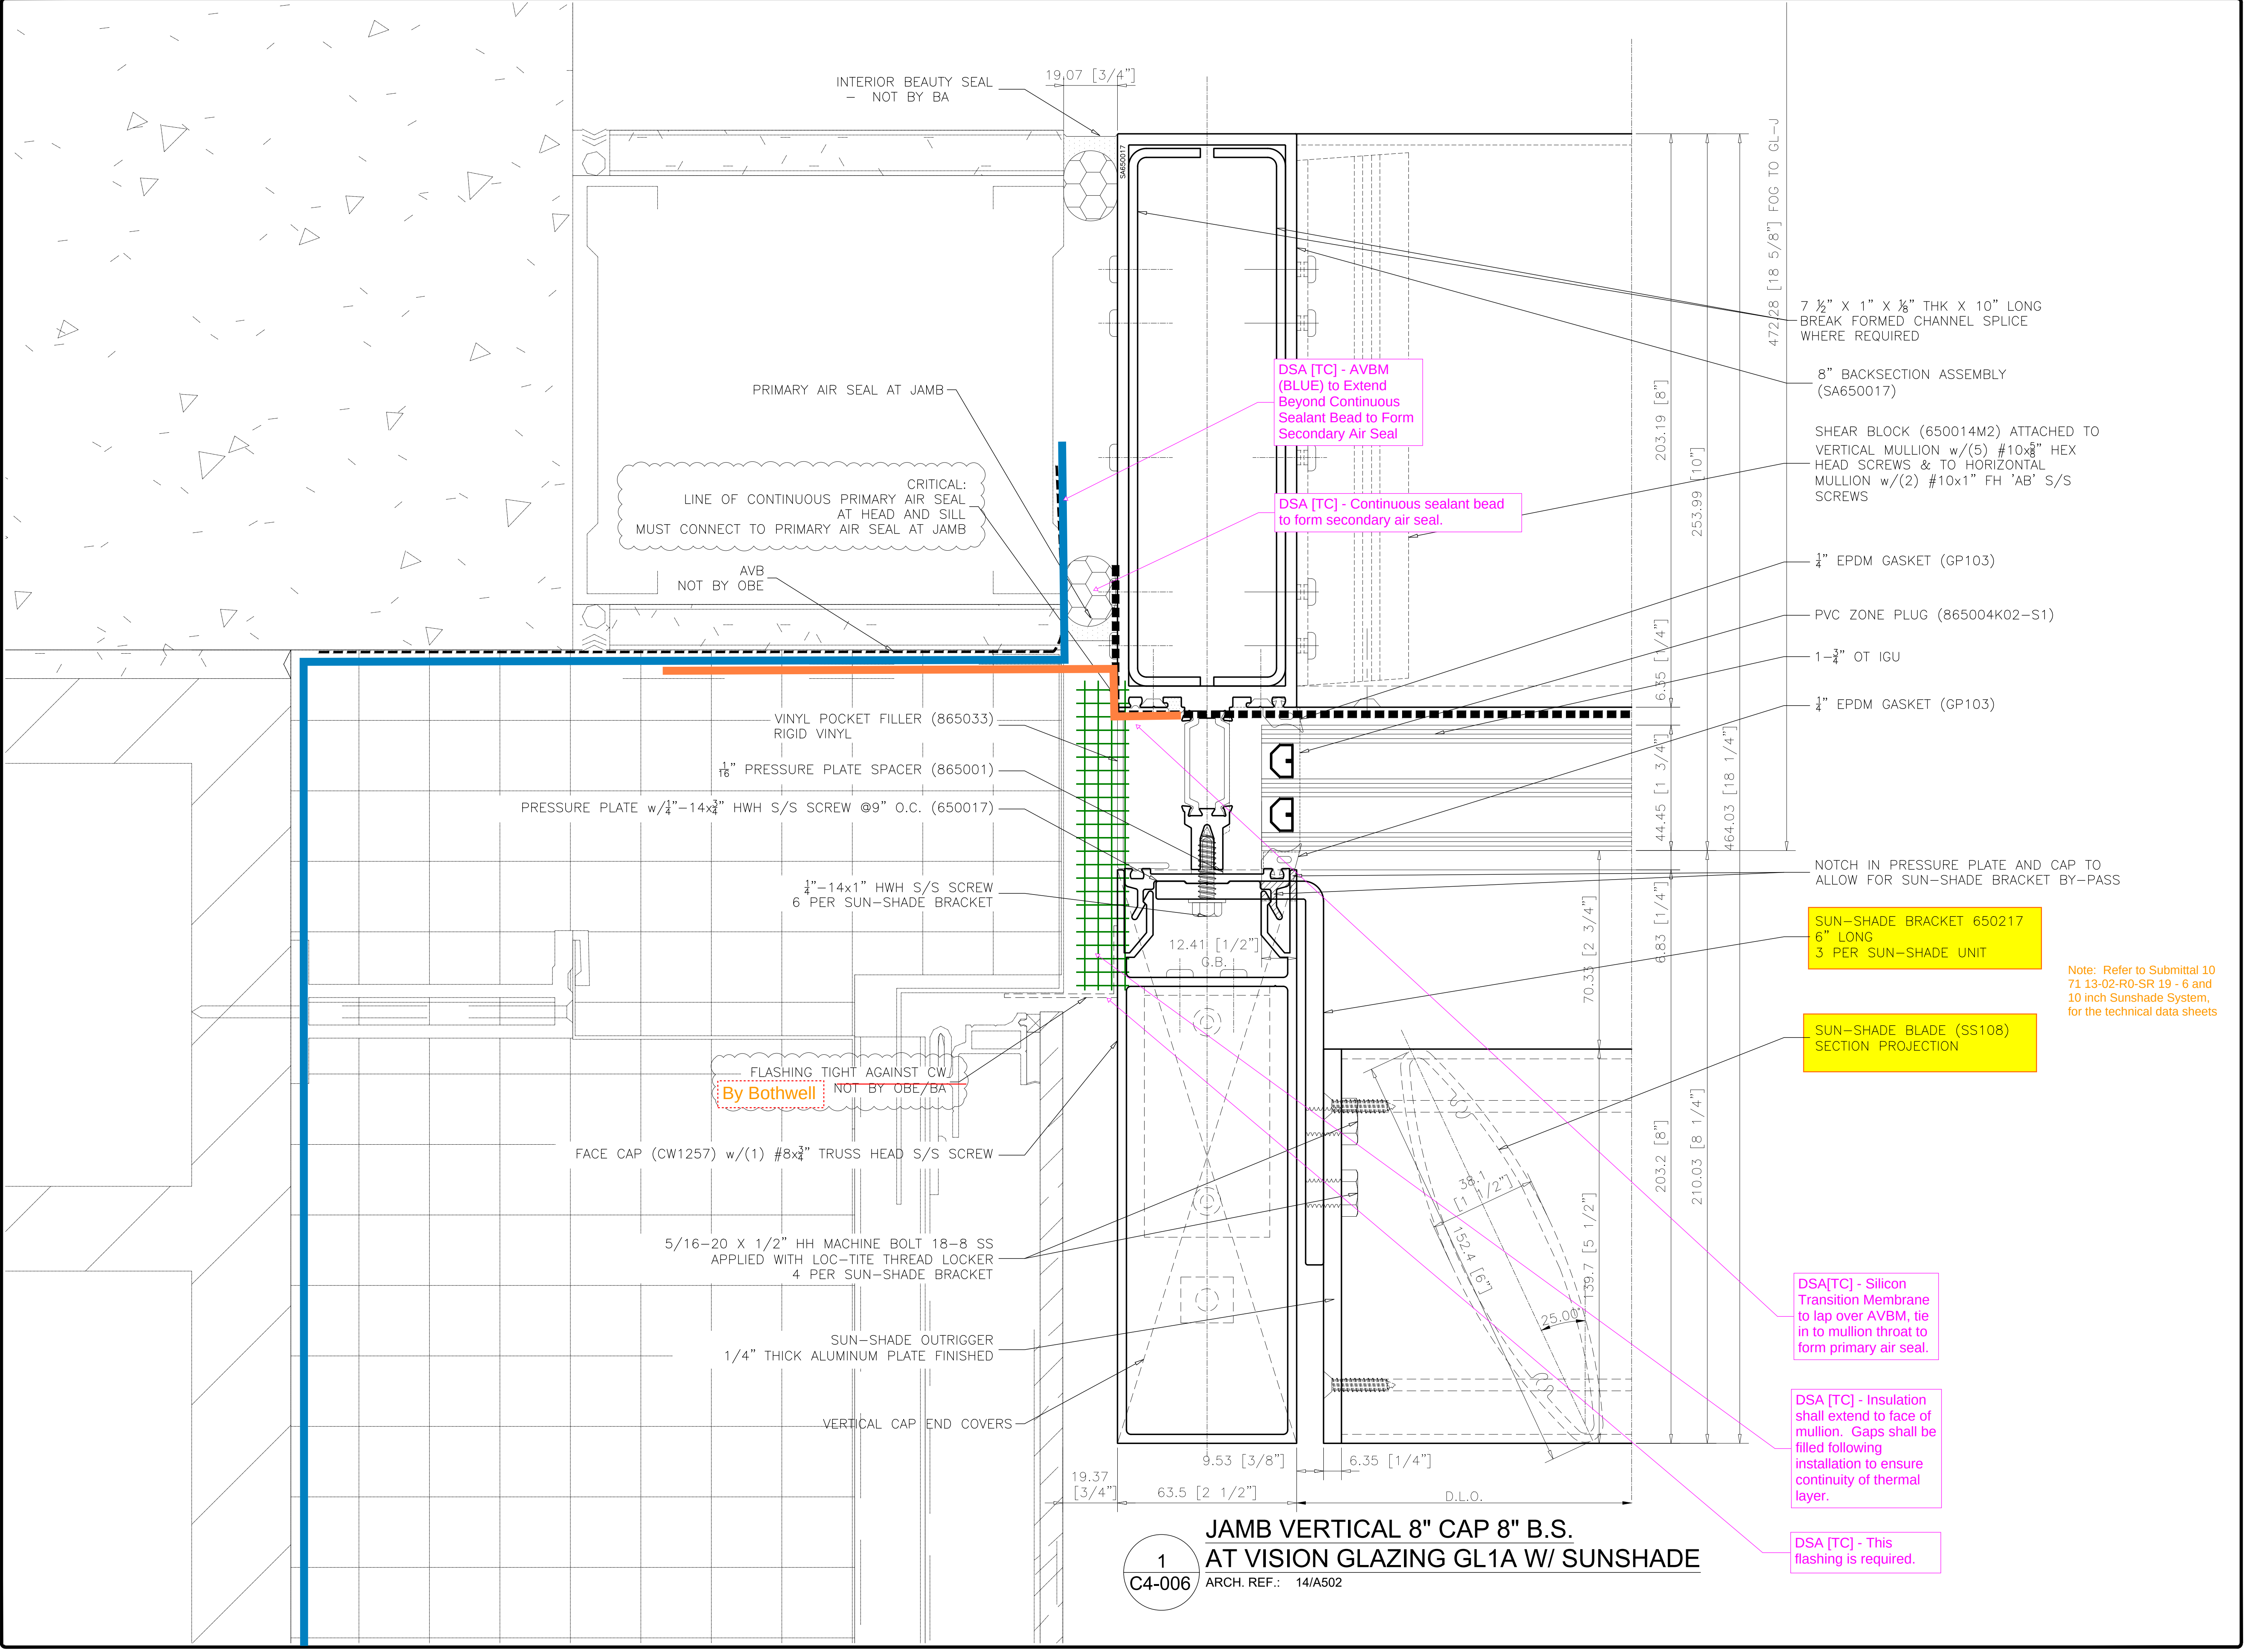

| REVISIONS |                                              |          |     |
|-----------|----------------------------------------------|----------|-----|
| No.       | Description:                                 | Date:    | By: |
| 1         | Revised per arch. markups received Feb 11/26 | 03/03/26 | SLR |
|           |                                              |          |     |
|           |                                              |          |     |
|                                   |                                        |                                               |                                             |
|-----------------------------------|----------------------------------------|-----------------------------------------------|---------------------------------------------|
| Project Name:<br>DOCKSTEADER PRPS | Project Location:<br>BRAMPTON, ONTARIO | Architect Name:<br>DIAMOND SCHMITT ARCHITECTS | Customer Name:<br>BOTHWELL ACCURATE GLAZING |
|-----------------------------------|----------------------------------------|-----------------------------------------------|---------------------------------------------|



275 Britannia Road East • Mississauga • Ontario • Canada • L4Z2E7  
905-890-6970 • oldcastlebe.com

Drawing Name:  
PLAN DETAIL

|                           |                             |
|---------------------------|-----------------------------|
| Drawn By:<br>SR           | Checked By:<br>NP           |
| Drawn Date:<br>2026/01/12 | Issue No.:<br>1             |
| Scale:<br>1"=1"           | Release Date:<br>2026/03/03 |

Drawing Number:  
C4-006