


Refer to Submittal 10 71
13-02-R0-SR 19 - 6 and 10
inch Sunshade System, for
the technical data sheets

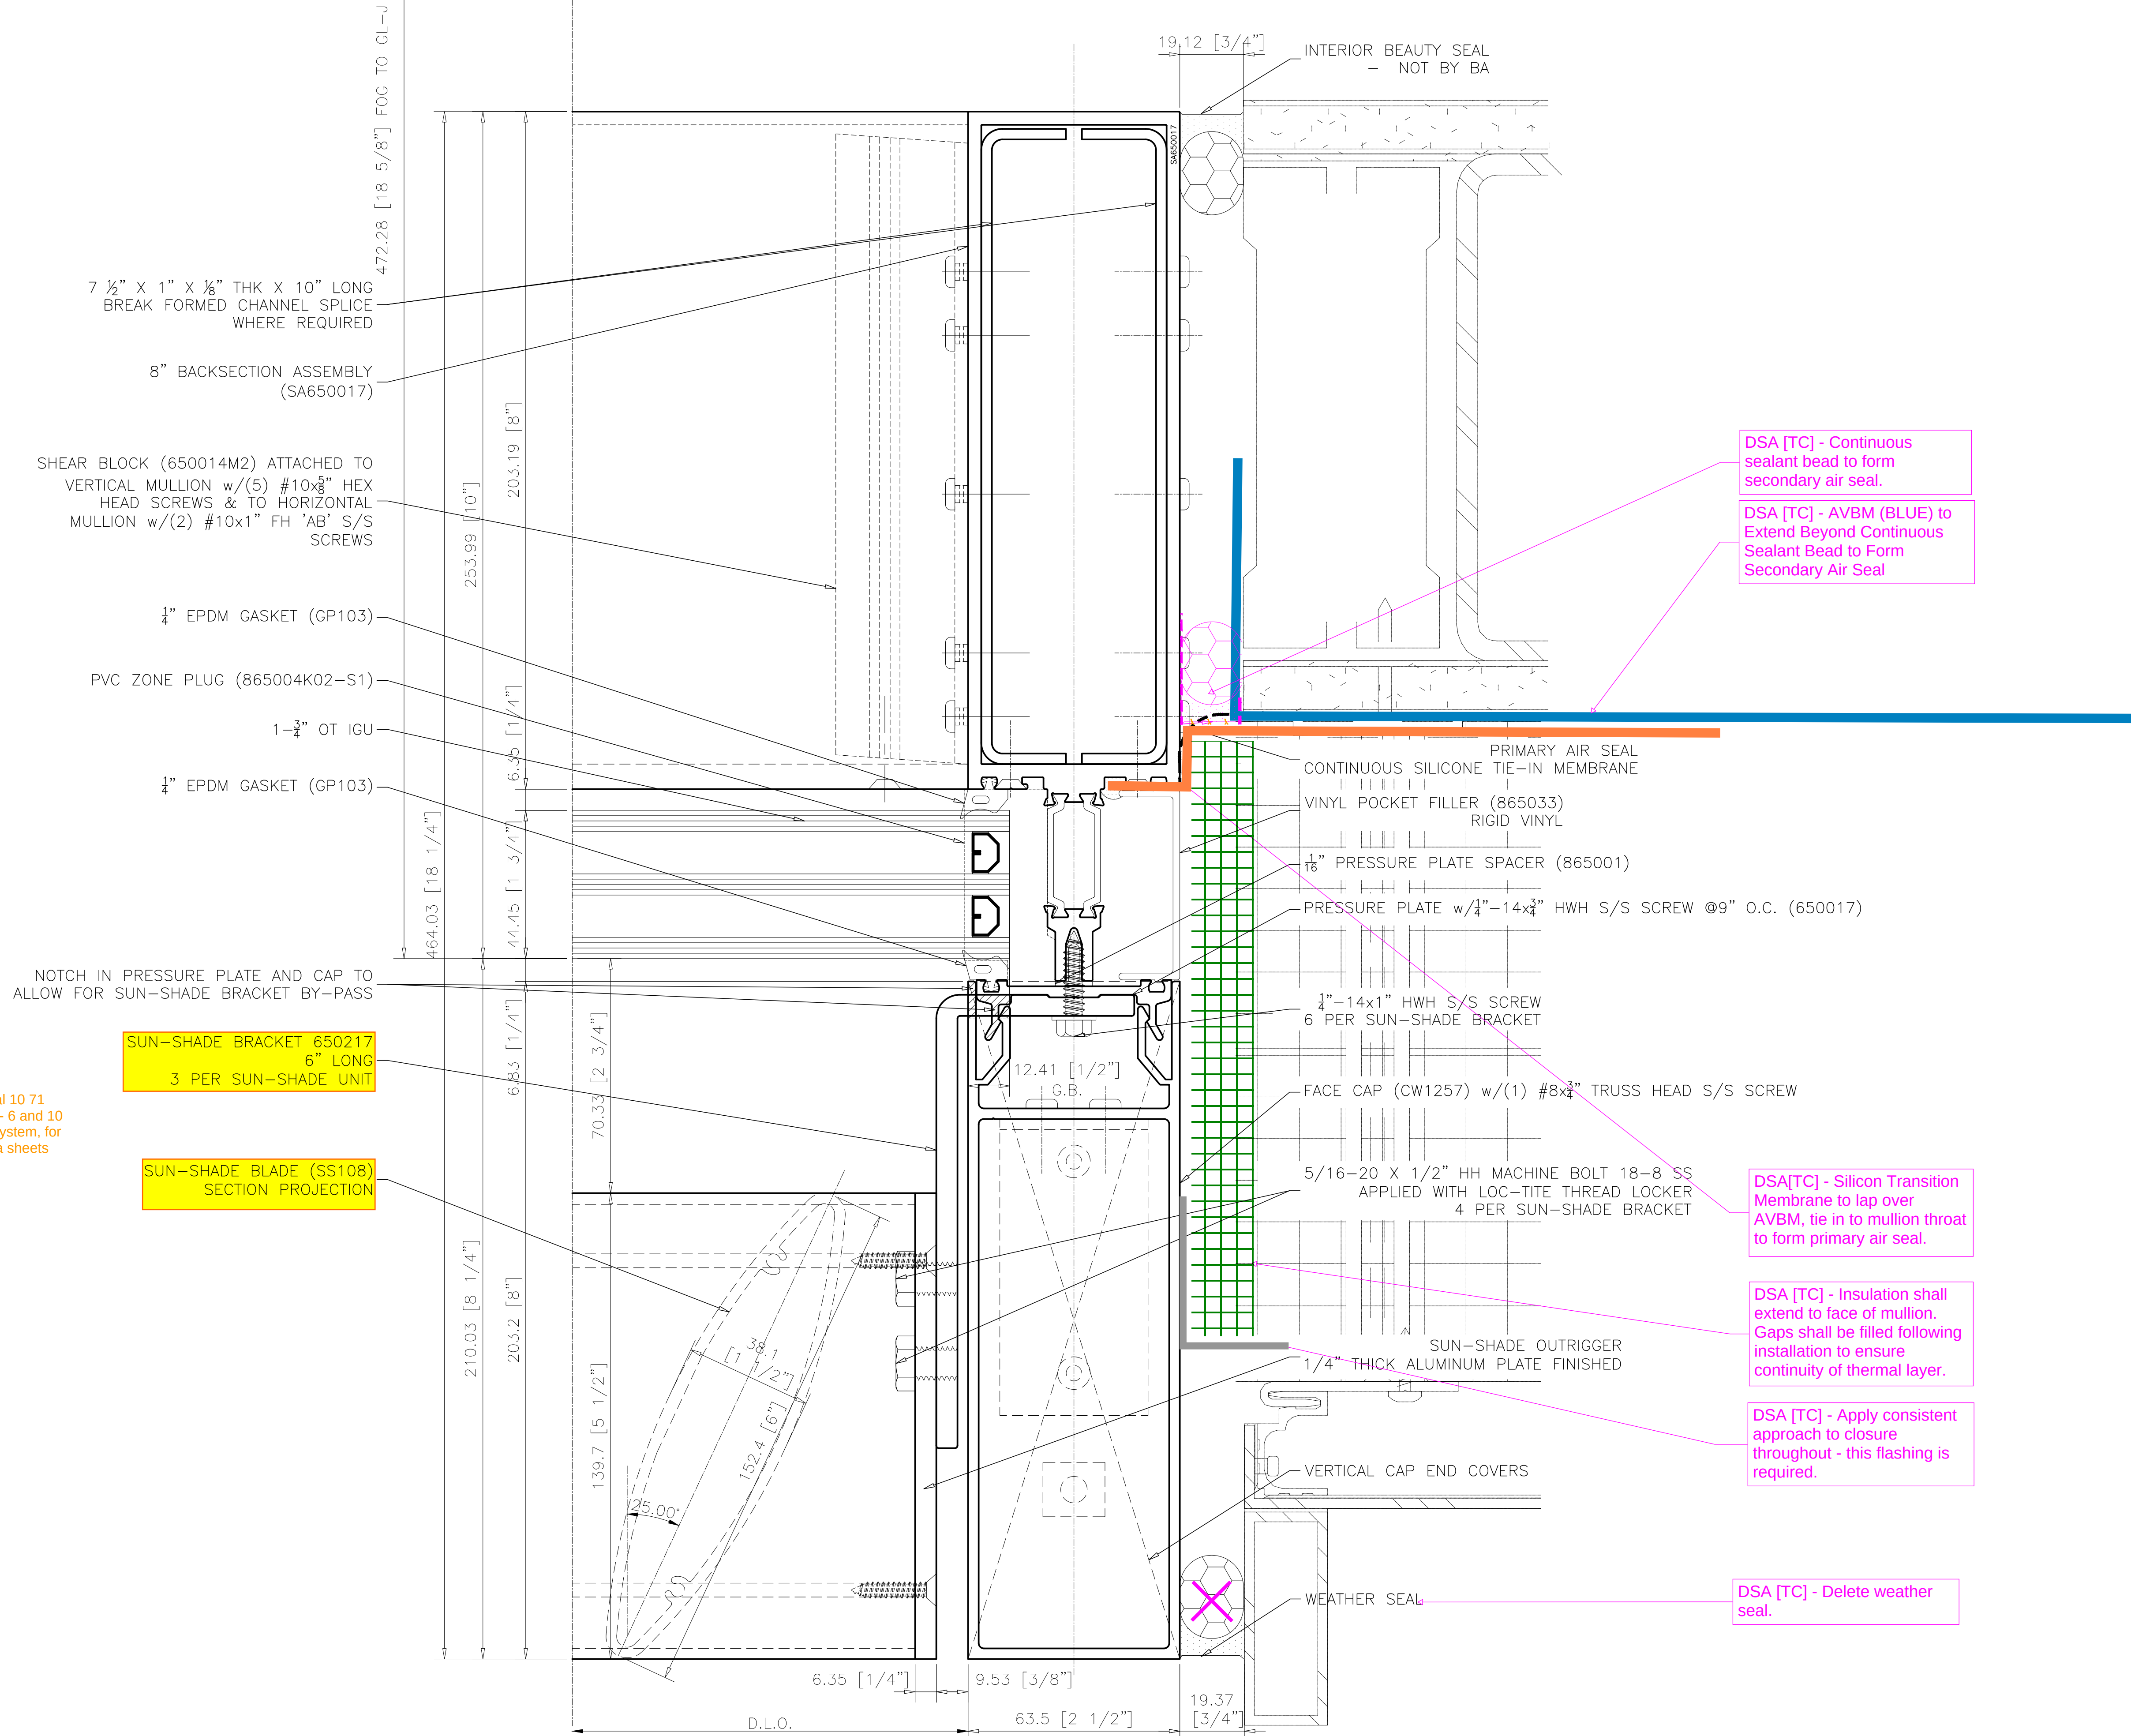

1
C4-007

JAMB VERTICAL 8" CAP 8" B.S.
AT VISION GLAZING GL1A W/ SUNSHADE

ARCH. REF.: 10/A501


REVISIONS			
No.	Description:	Date:	By:
1	Revised per arch. markups received Feb 11/26	03/03/26	SLR

Project Name: DOCKSTEADER PRPS	Project Location: BRAMPTON, ONTARIO	Architect Name: DIAMOND SCHMITT ARCHITECTS	Customer Name: BOTHWELL ACCURATE GLAZING
-----------------------------------	--	---	---



275 Britannia Road East • Mississauga • Ontario • Canada • L4Z2E7
905-890-6970 • oldcastlebe.com

Drawing Name: PLAN DETAIL	
Drawn By: SR	Checked By: NP
Drawn Date: 2026/01/12	Issue No.: 1
Scale: 1"=1"	Release Date: 2026/03/03
Drawing Number: C4-007	

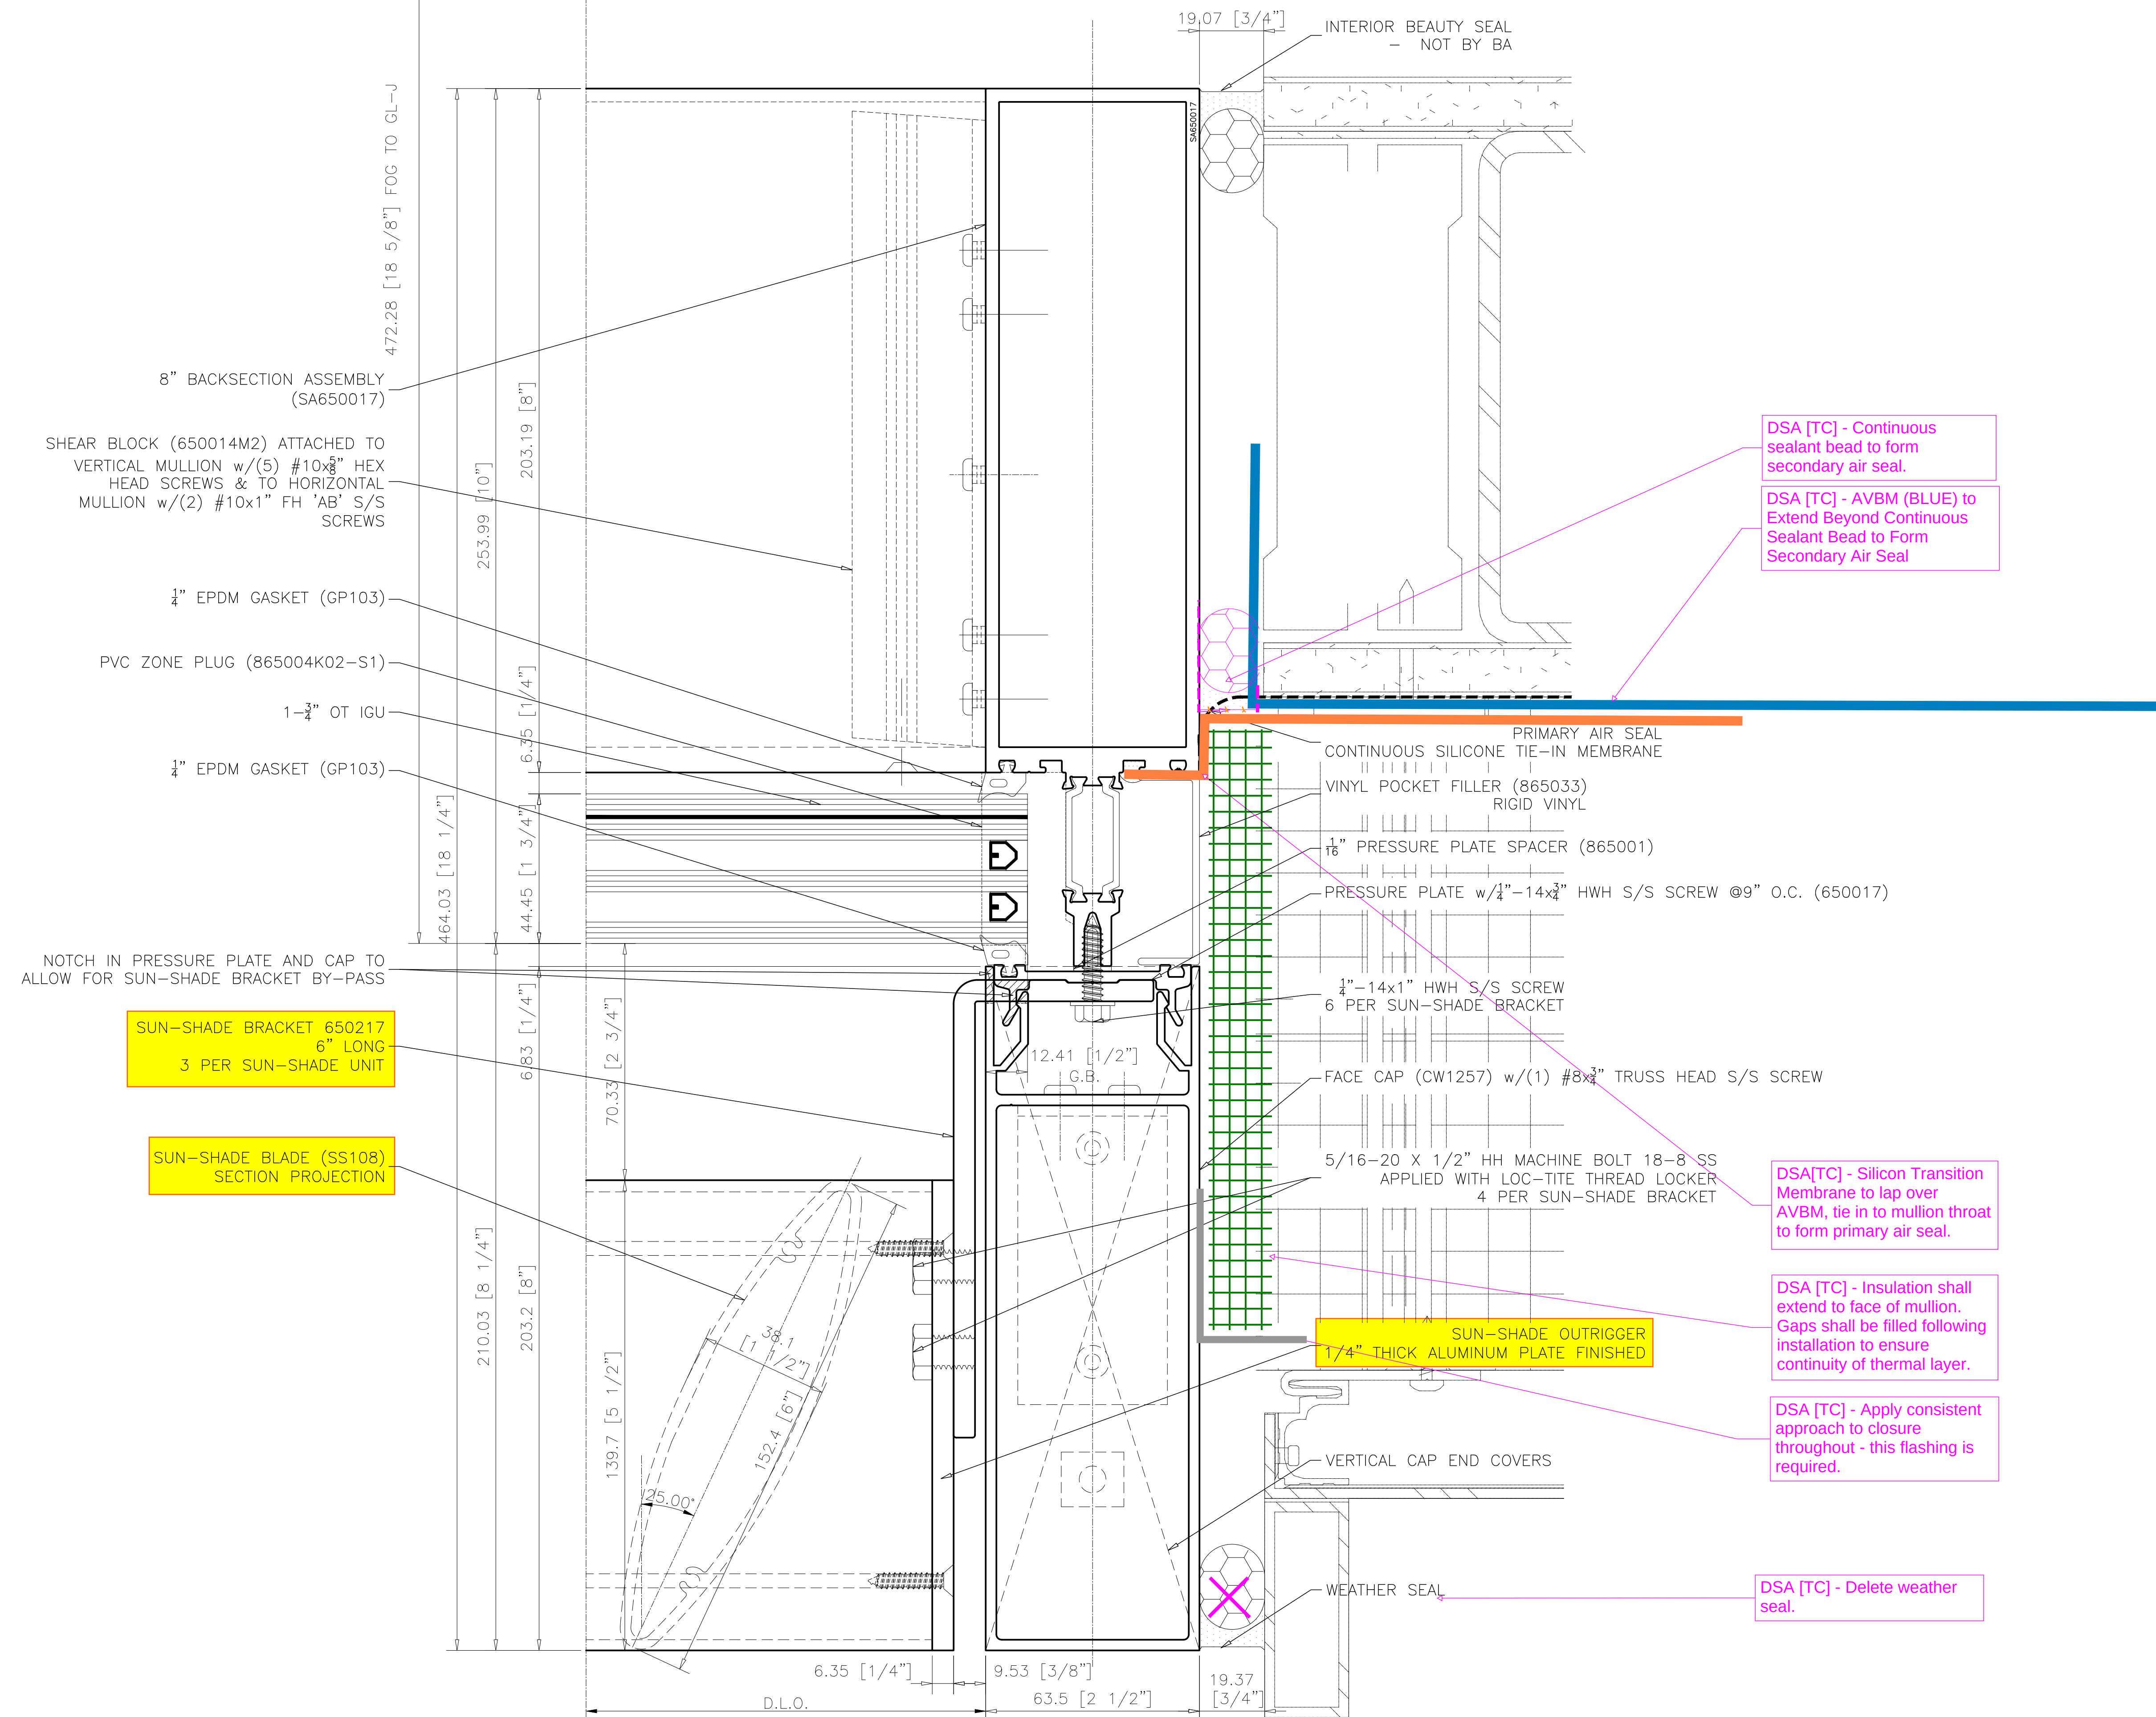

1
C4-007A

JAMB VERTICAL 8" CAP 8" B.S.
AT VISION GLAZING GL1B W/ SUNSHADE


ARCH. REF.: 10/A501

REVISIONS			
No.	Description:	Date:	By:
1	Revised per arch. markups received Feb 11/26	03/03/26	SLR

Project Name: DOCKSTEADER PRPS	Project Location: BRAMPTON, ONTARIO	Architect Name: DIAMOND SCHMITT ARCHITECTS	Customer Name: BOTHWELL ACCURATE GLAZING
-----------------------------------	--	---	---



Drawing Name: PLAN DETAIL	
Drawn By: SR	Checked By: NP
Drawn Date: 2026/01/12	Issue No.: 1
Scale: 1"=1'	Release Date: 2026/03/03
Drawing Number: C4-007A	

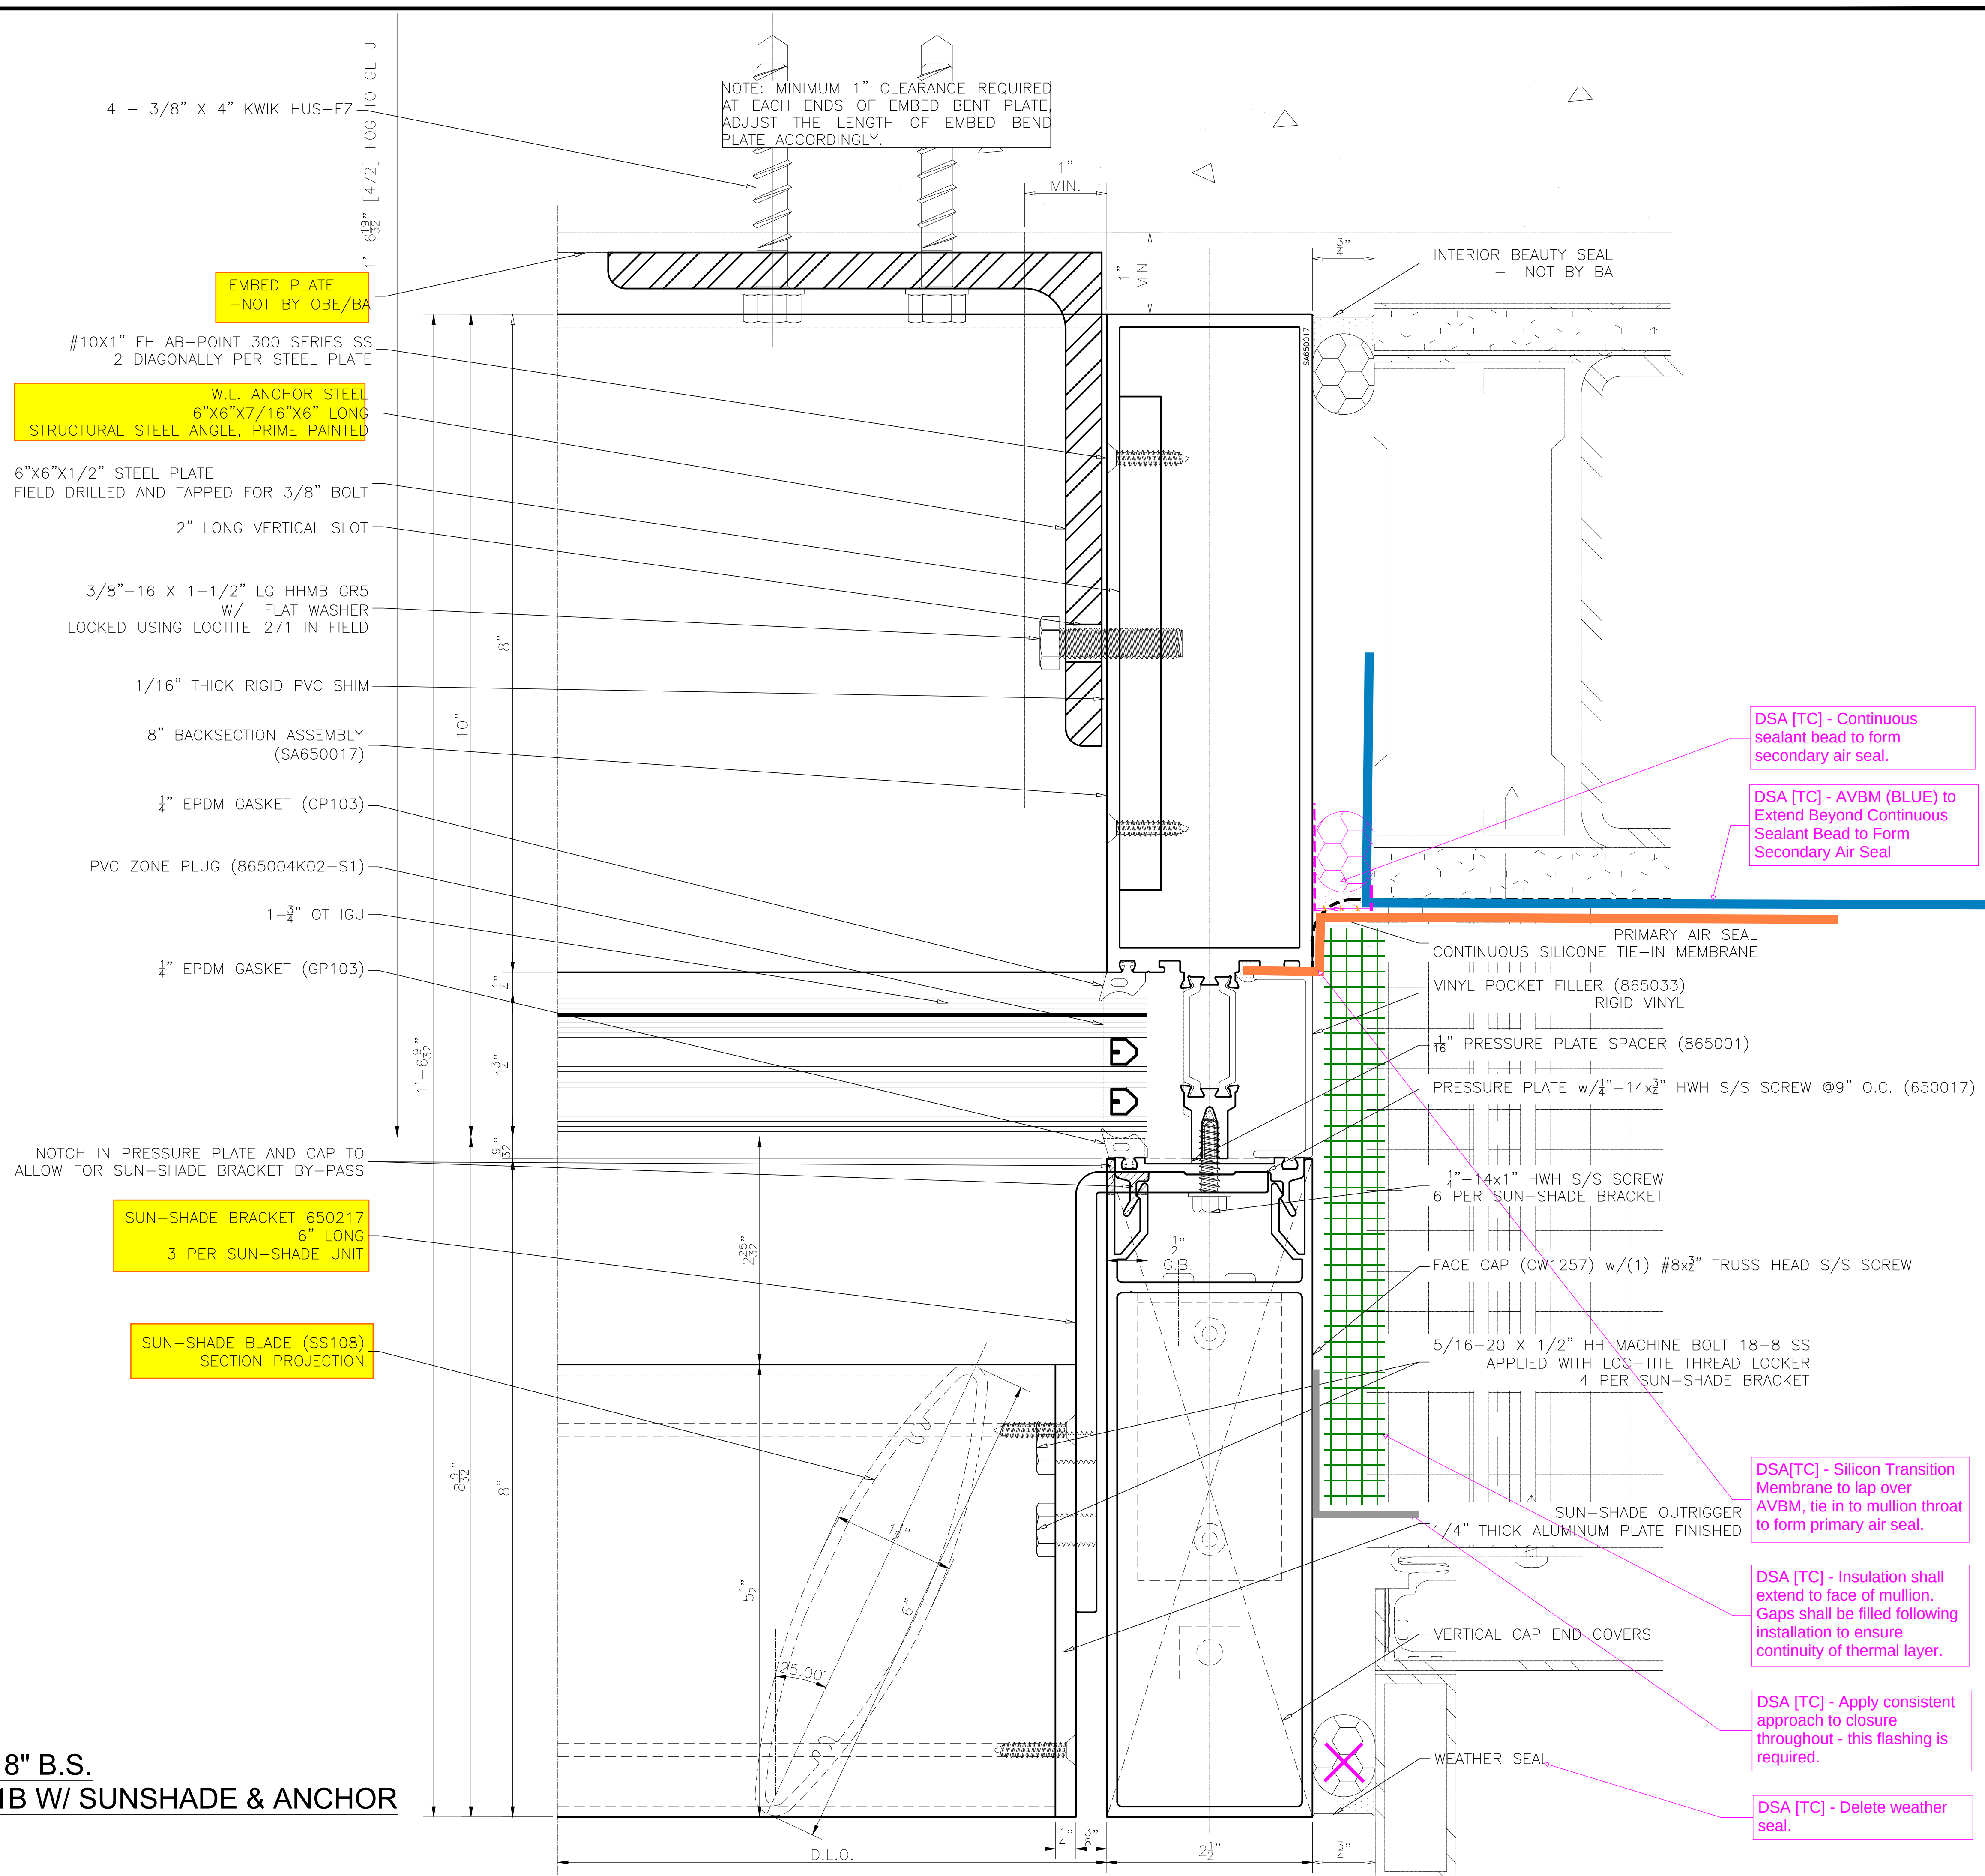

**JAMB VERTICAL 8" CAP 8" B.S.
AT VISION GLAZING GL1B W/ SUNSHADE & ANCHOR**
ARCH. REF.: 10/A501

REVISIONS			
No.	Description:	Date:	By:
1	Revised per arch. markups received Feb 11/26	03/03/26	SLR

Project Name: DOCKSTEADER PRPS	Project Location: BRAMPTON, ONTARIO	Architect Name: DIAMOND SCHMITT ARCHITECTS	Customer Name: BOTHWELL ACCURATE GLAZING
-----------------------------------	--	---	---




275 Britannia Road East • Mississauga • Ontario • Canada • L4Z2E7
905-890-6970 • oldcastlebe.com

Drawing Name:
PLAN DETAIL

Drawn By: SR	Checked By: NP
Drawn Date: 2026/01/12	Issue No.: 1
Scale: 1"=1'	Release Date: 2026/03/03

Drawing Number:
C4-007B

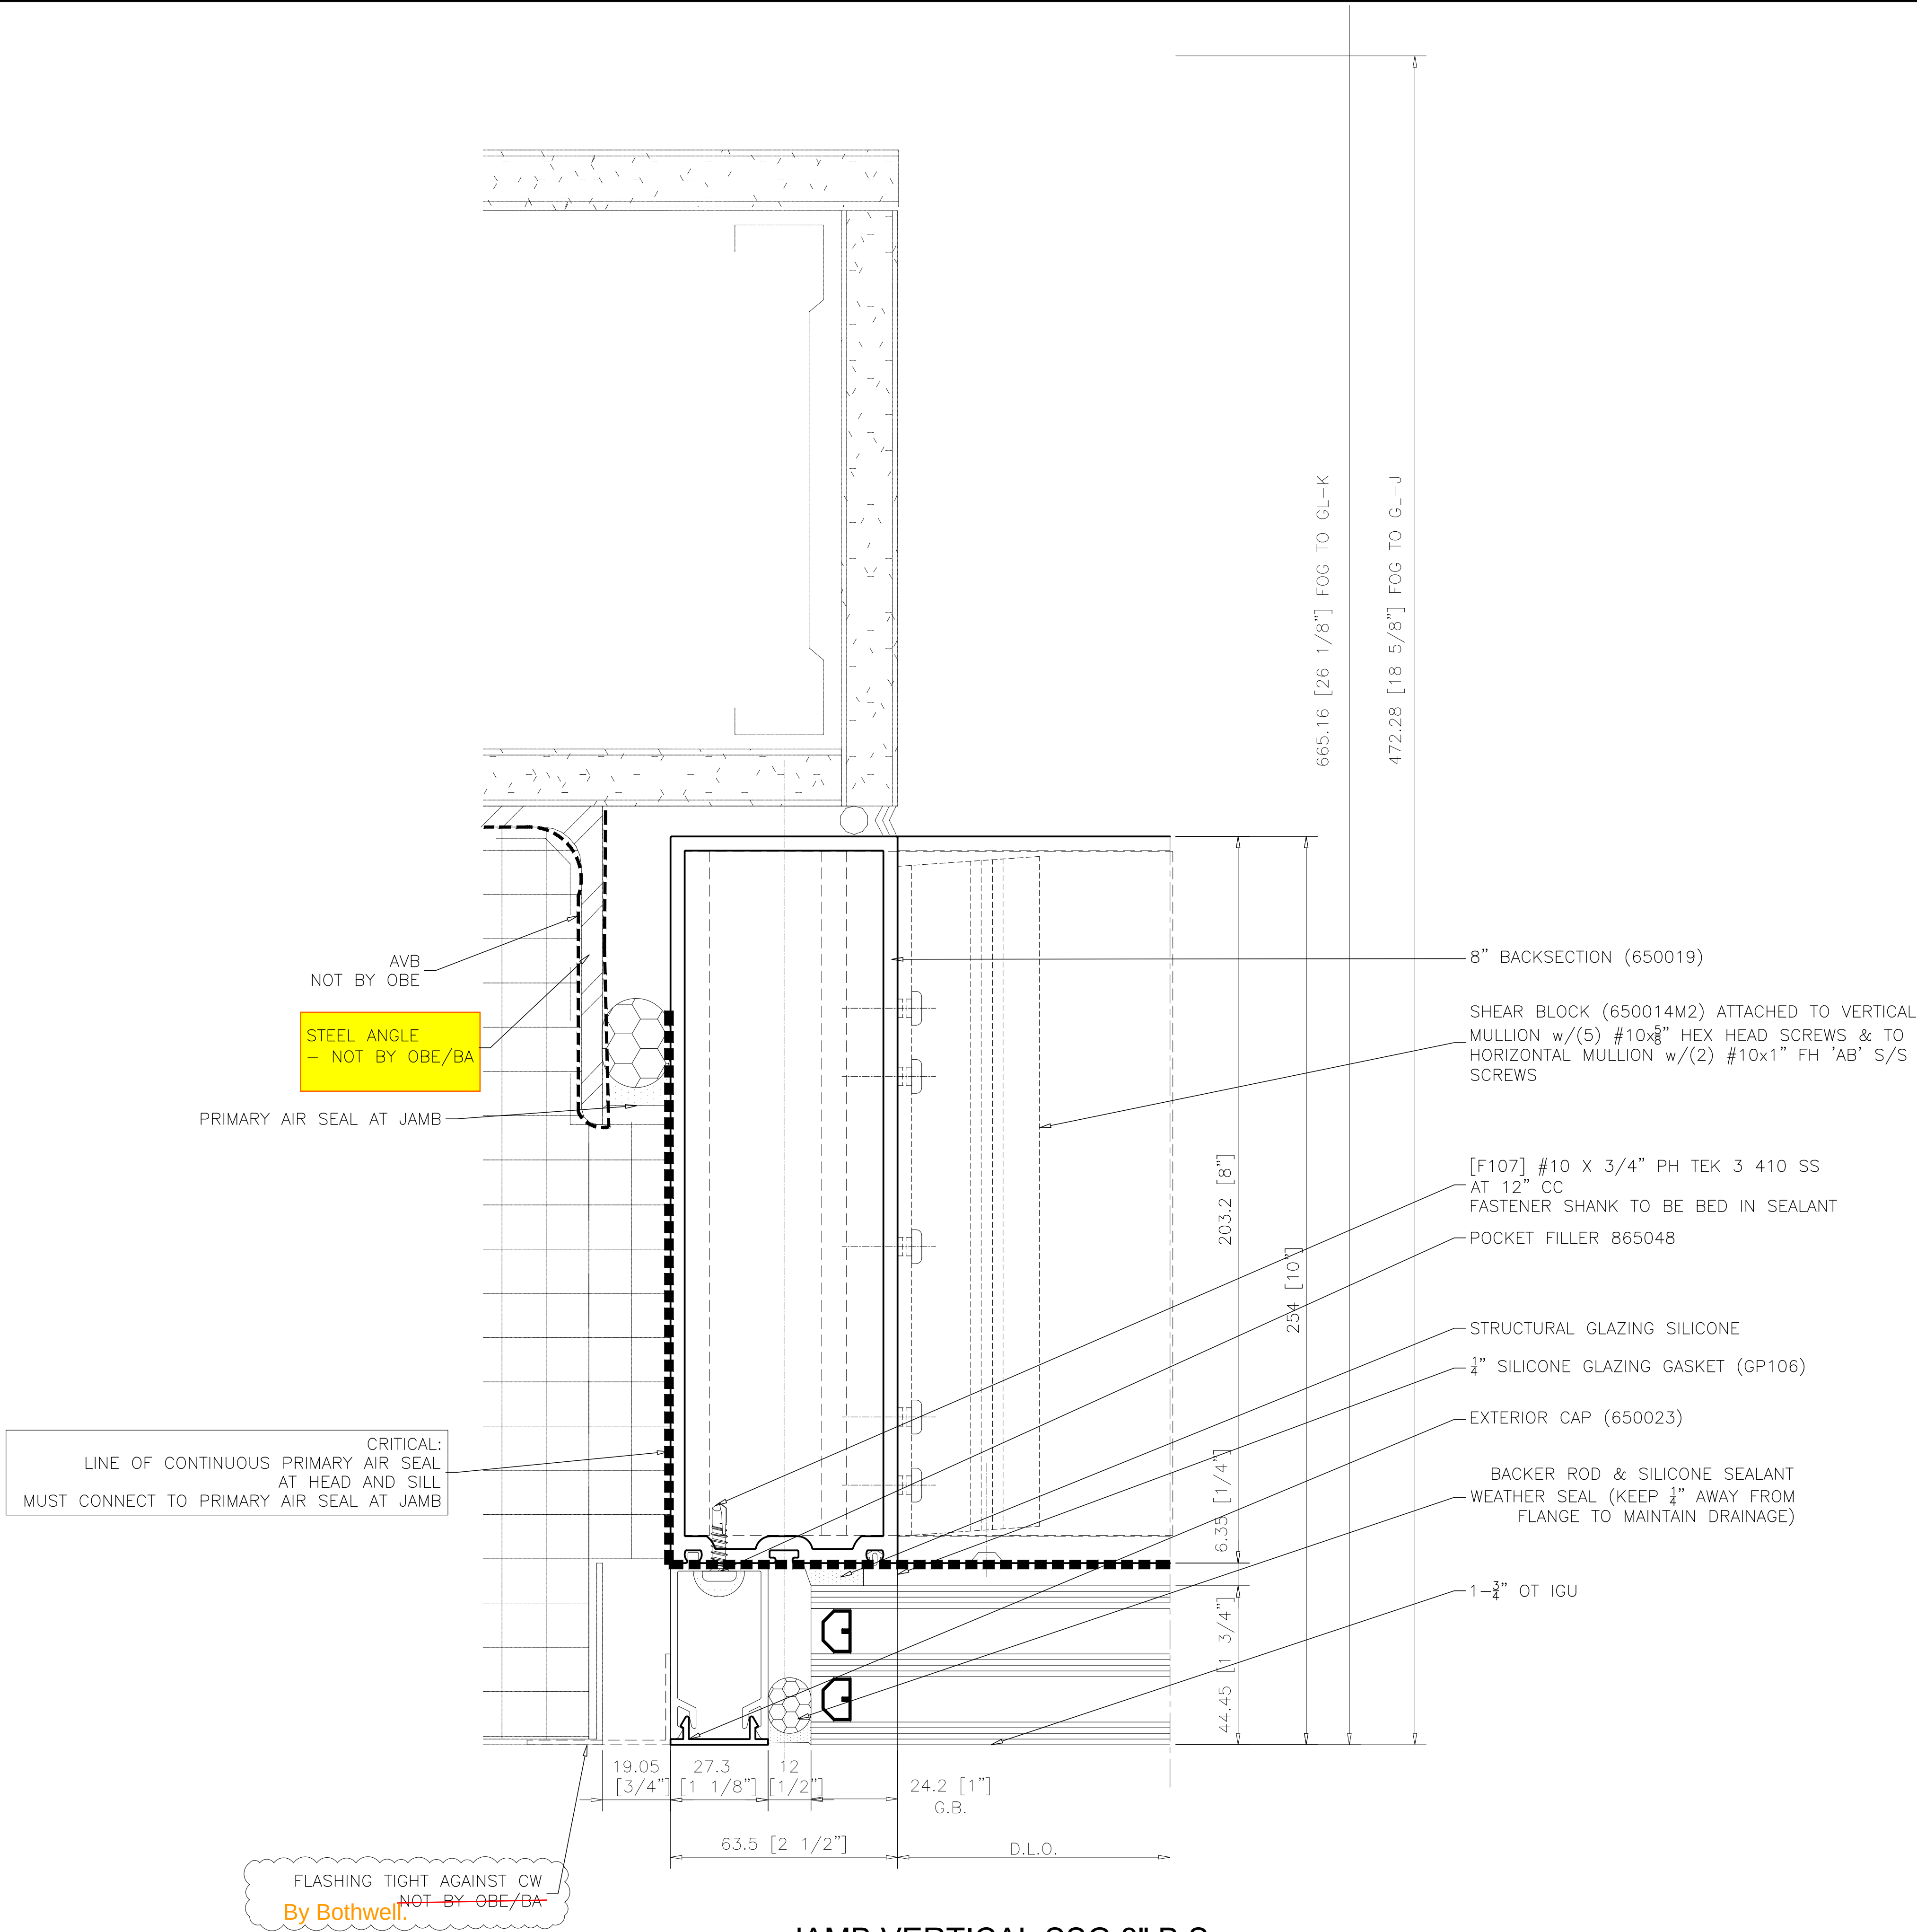

1
C4-008

JAMB VERTICAL SSG 8" B.S.
AT VISION GLAZING GL1A

ARCH. REF.: 1/A501

REVISIONS			
No.	Description:	Date:	By:
1	Revised per arch. markups received Feb 11/26	03/03/26	SLR

Project Name: DOCKSTEADER PRPS	Project Location: BRAMPTON, ONTARIO	Architect Name: DIAMOND SCHMITT ARCHITECTS	Customer Name: BOTHWELL ACCURATE GLAZING
-----------------------------------	--	---	---




2775 Britannia Road East • Mississauga • Ontario • Canada • L4Z2E7
905-890-6970 • oldcastlebe.com

Drawing Name:
PLAN DETAIL

Drawn By: SR	Checked By: NP
Drawn Date: 2026/01/12	Issue No.: 1
Scale: 1"=1"	Release Date: 2026/03/03

Drawing Number:
C4-008

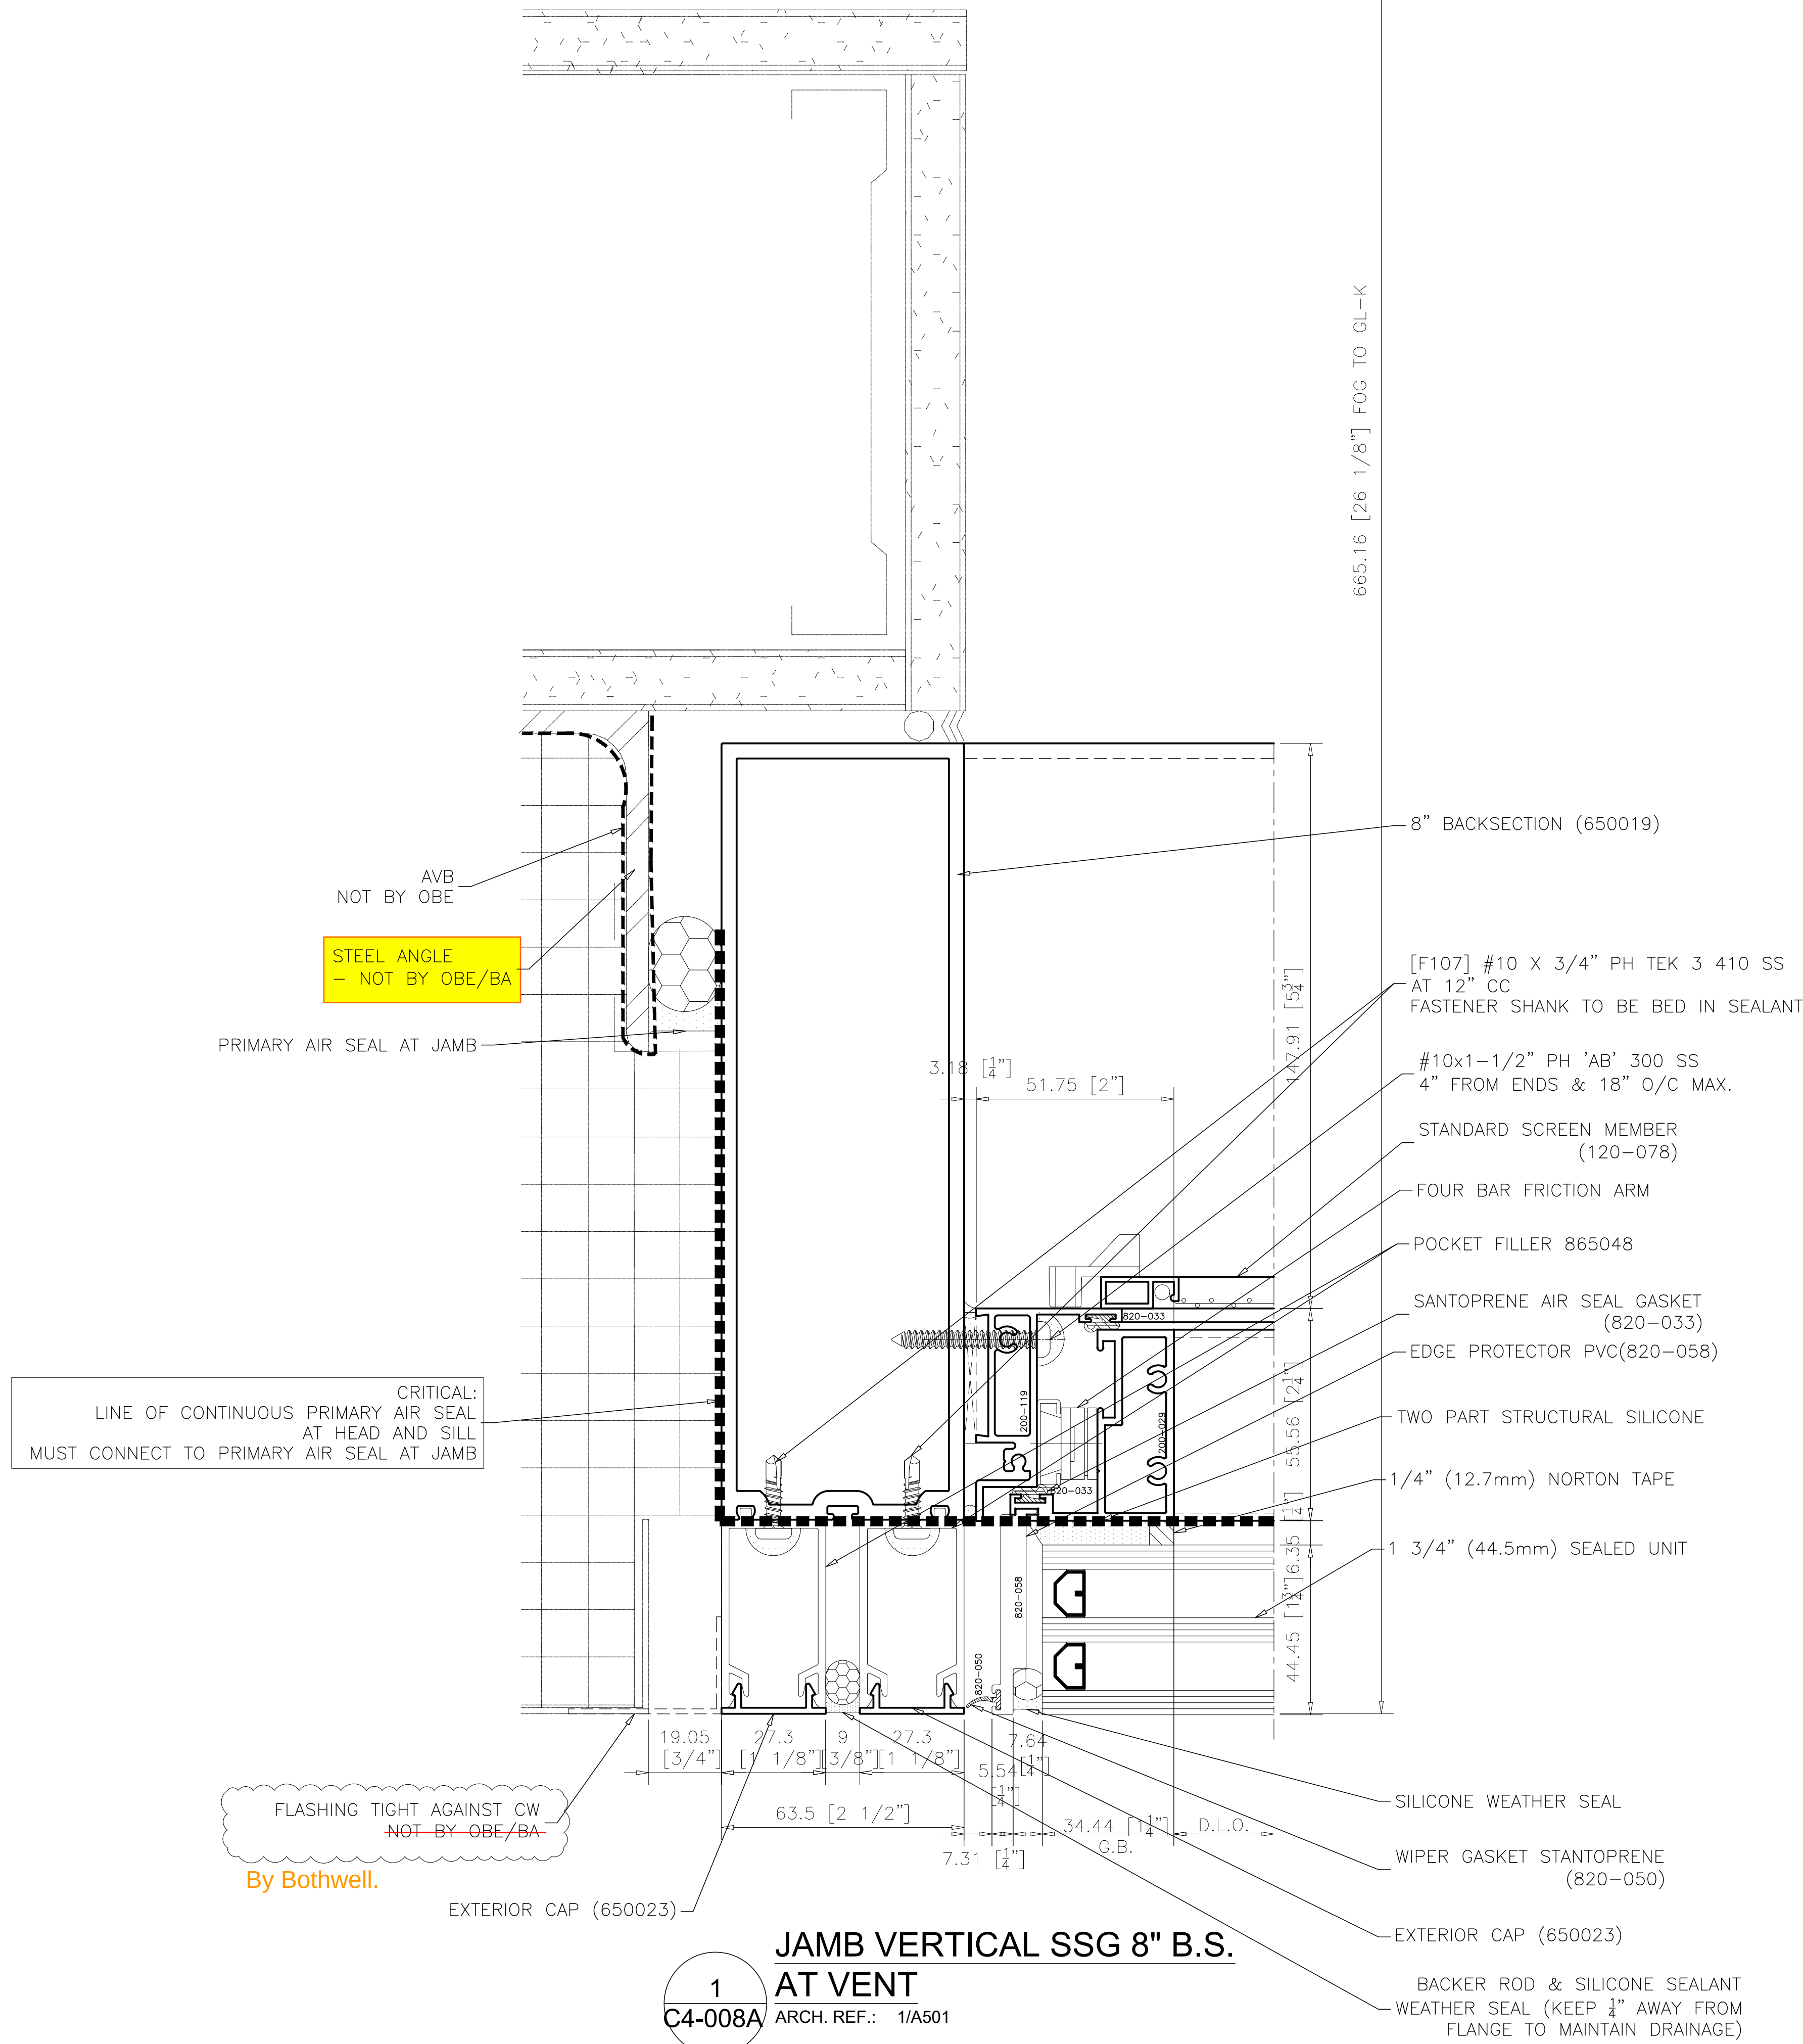

REVISIONS			
No.	Description:	Date:	By:
1	Revised per arch. markups received Feb 11/26	03/03/26	SLR

Project Name: DOCKSTEADER PRPS	Project Location: BRAMPTON, ONTARIO	Architect Name: DIAMOND SCHMITT ARCHITECTS	Customer Name: BOTHWELL ACCURATE GLAZING
-----------------------------------	--	---	---



275 Britannia Road East • Mississauga • Ontario • Canada • L4Z2E7
905-890-6970 • oldcastlebe.com

Drawing Name: PLAN DETAIL	
Drawn By: SR	Checked By: NP
Drawn Date: 2026/01/12	Issue No.: 1
Scale: 1"=1"	Release Date: 2026/03/03
Drawing Number: C4-008A	


REVISIONS			
No.	Description:	Date:	By:
1	Revised per arch. markups received Feb 11/26	03/03/26	SLR

Project Name: DOCKSTEADER PRPS	Project Location: BRAMPTON, ONTARIO	Architect Name: DIAMOND SCHMITT ARCHITECTS	Customer Name: BOTHWELL ACCURATE GLAZING
-----------------------------------	--	---	---




275 Britannia Road East • Mississauga • Ontario • Canada • L4Z2E7
905-890-6970 • oldcastlebe.com

Drawing Name: PLAN DETAIL	
Drawn By: SR	Checked By: NP
Drawn Date: 2026/01/12	Issue No.: 1
Scale: 1"=1"	Release Date: 2026/03/03
Drawing Number: C4-008B	

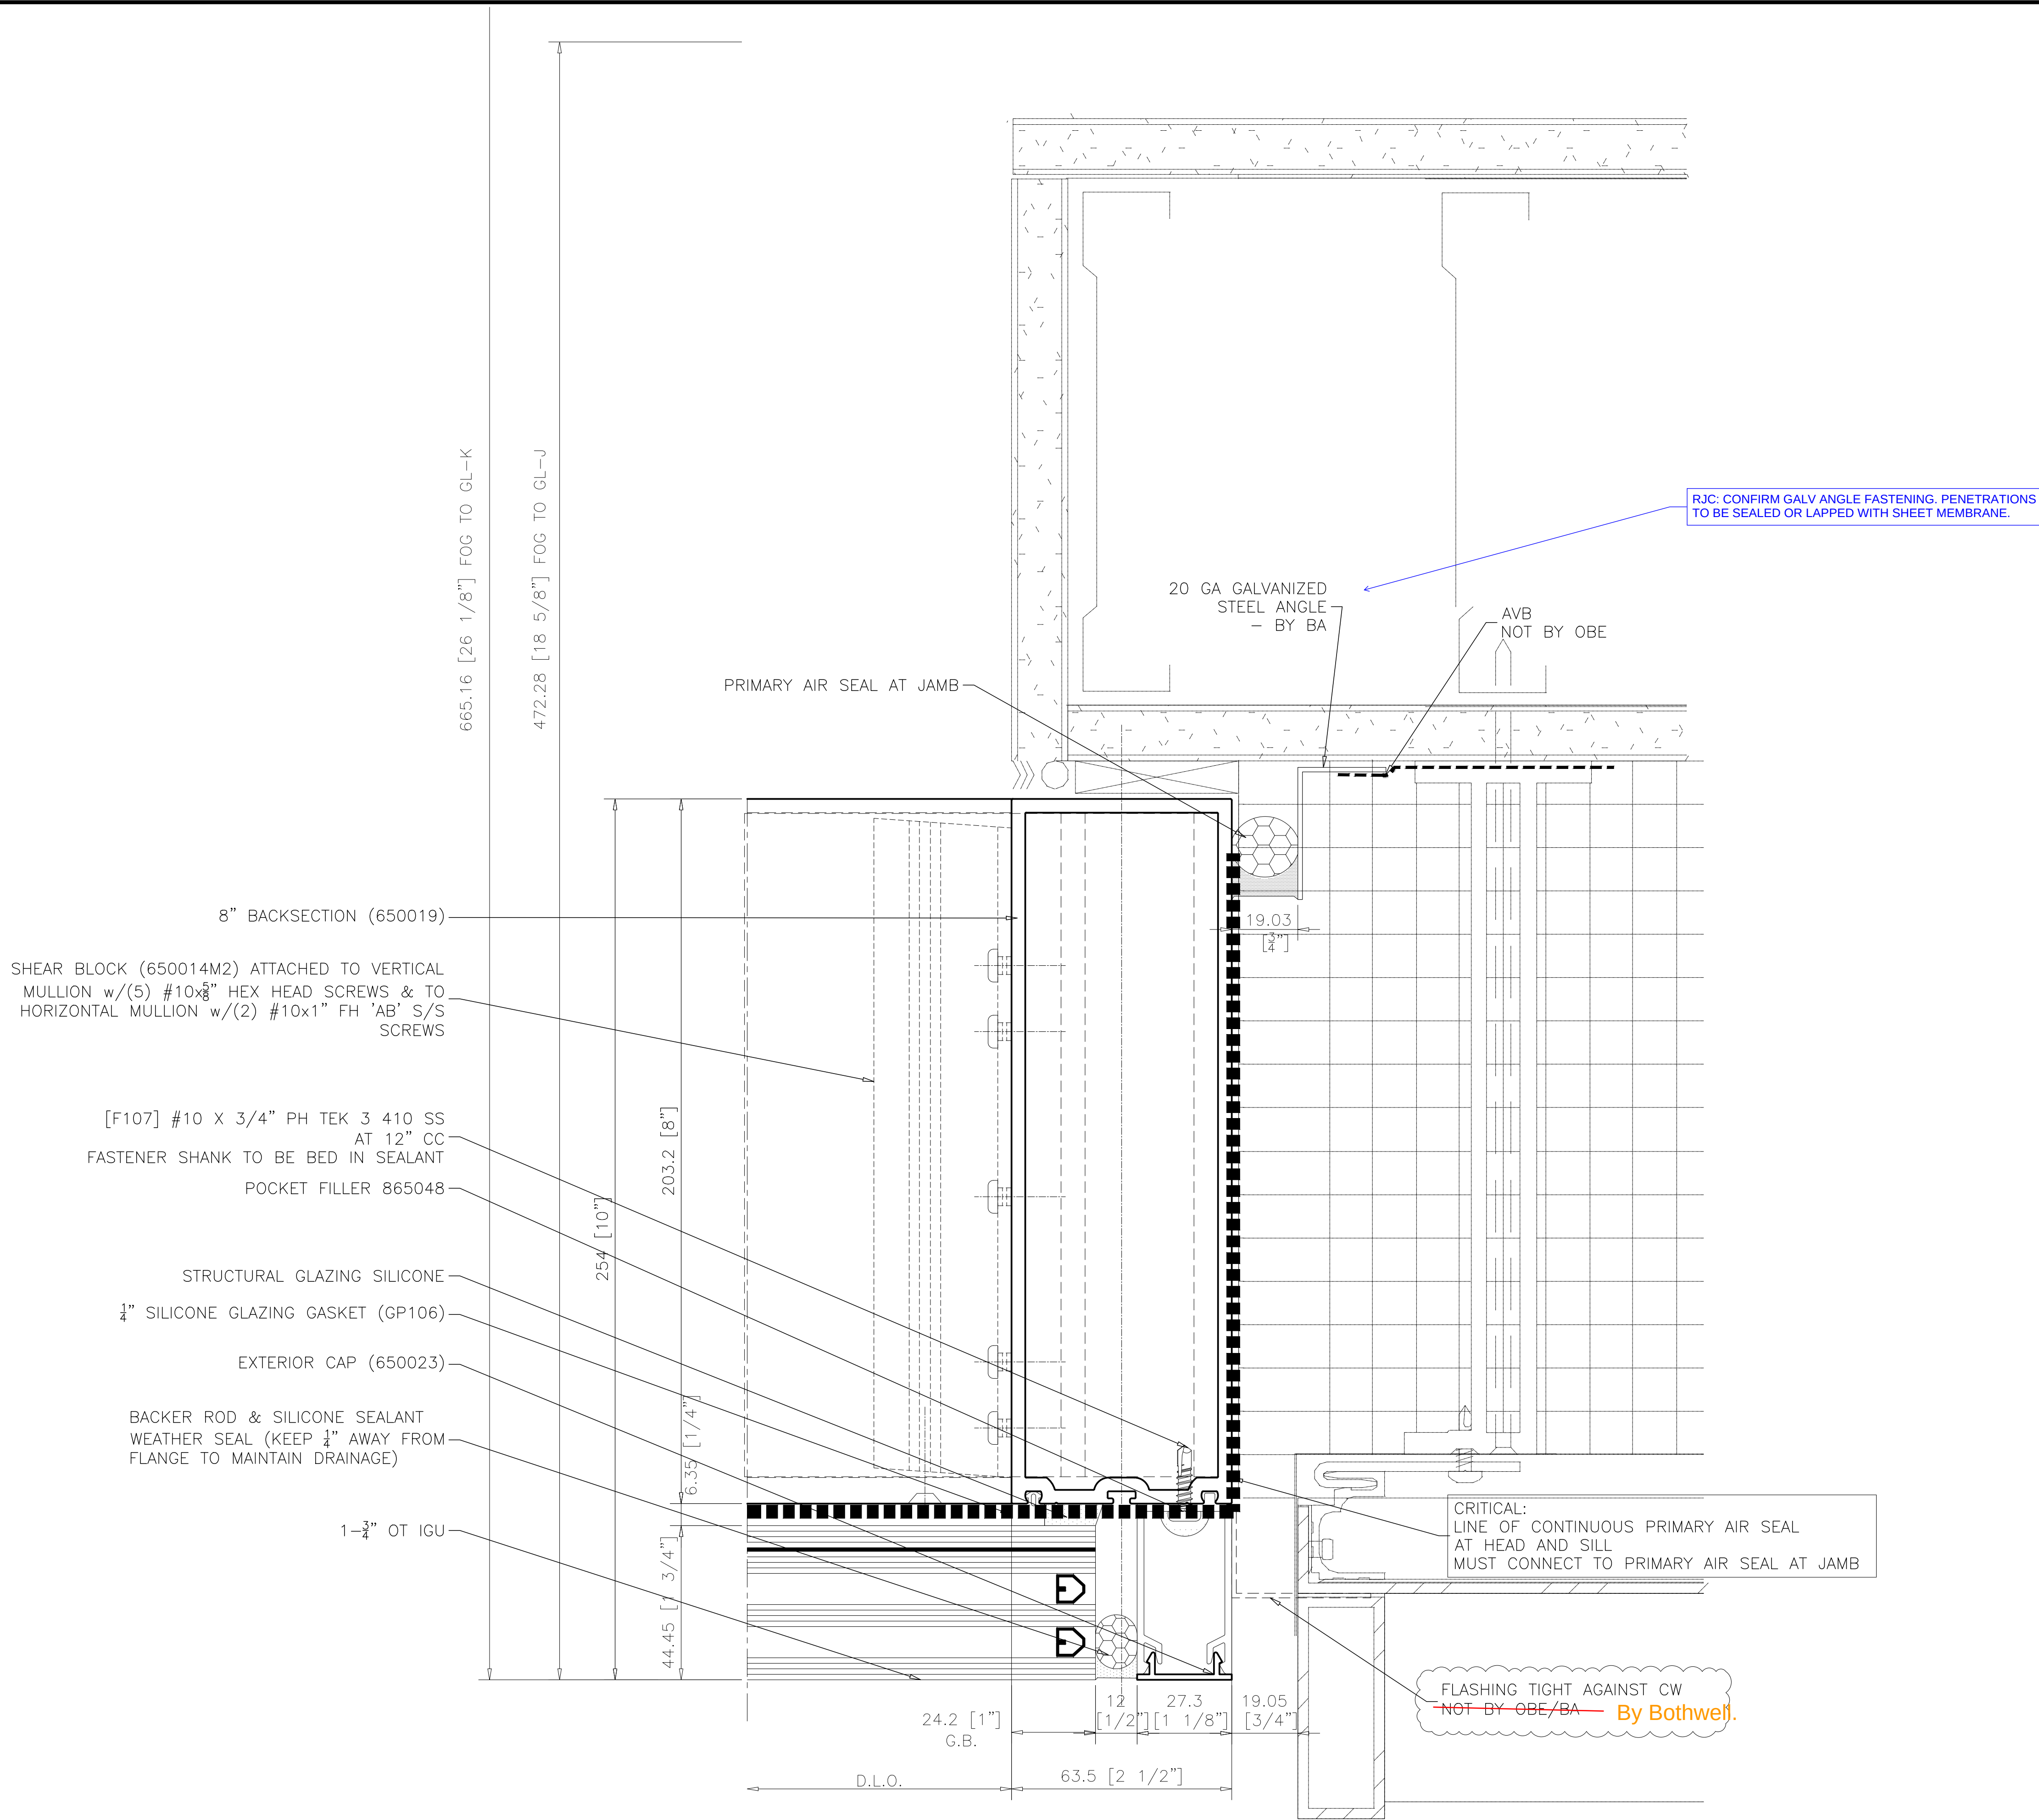

1
C4-008B JAMB VERTICAL SSG 8" B.S.
AT VISION GLAZING GL1B
ARCH. REF.: 1/A501, 12/A501

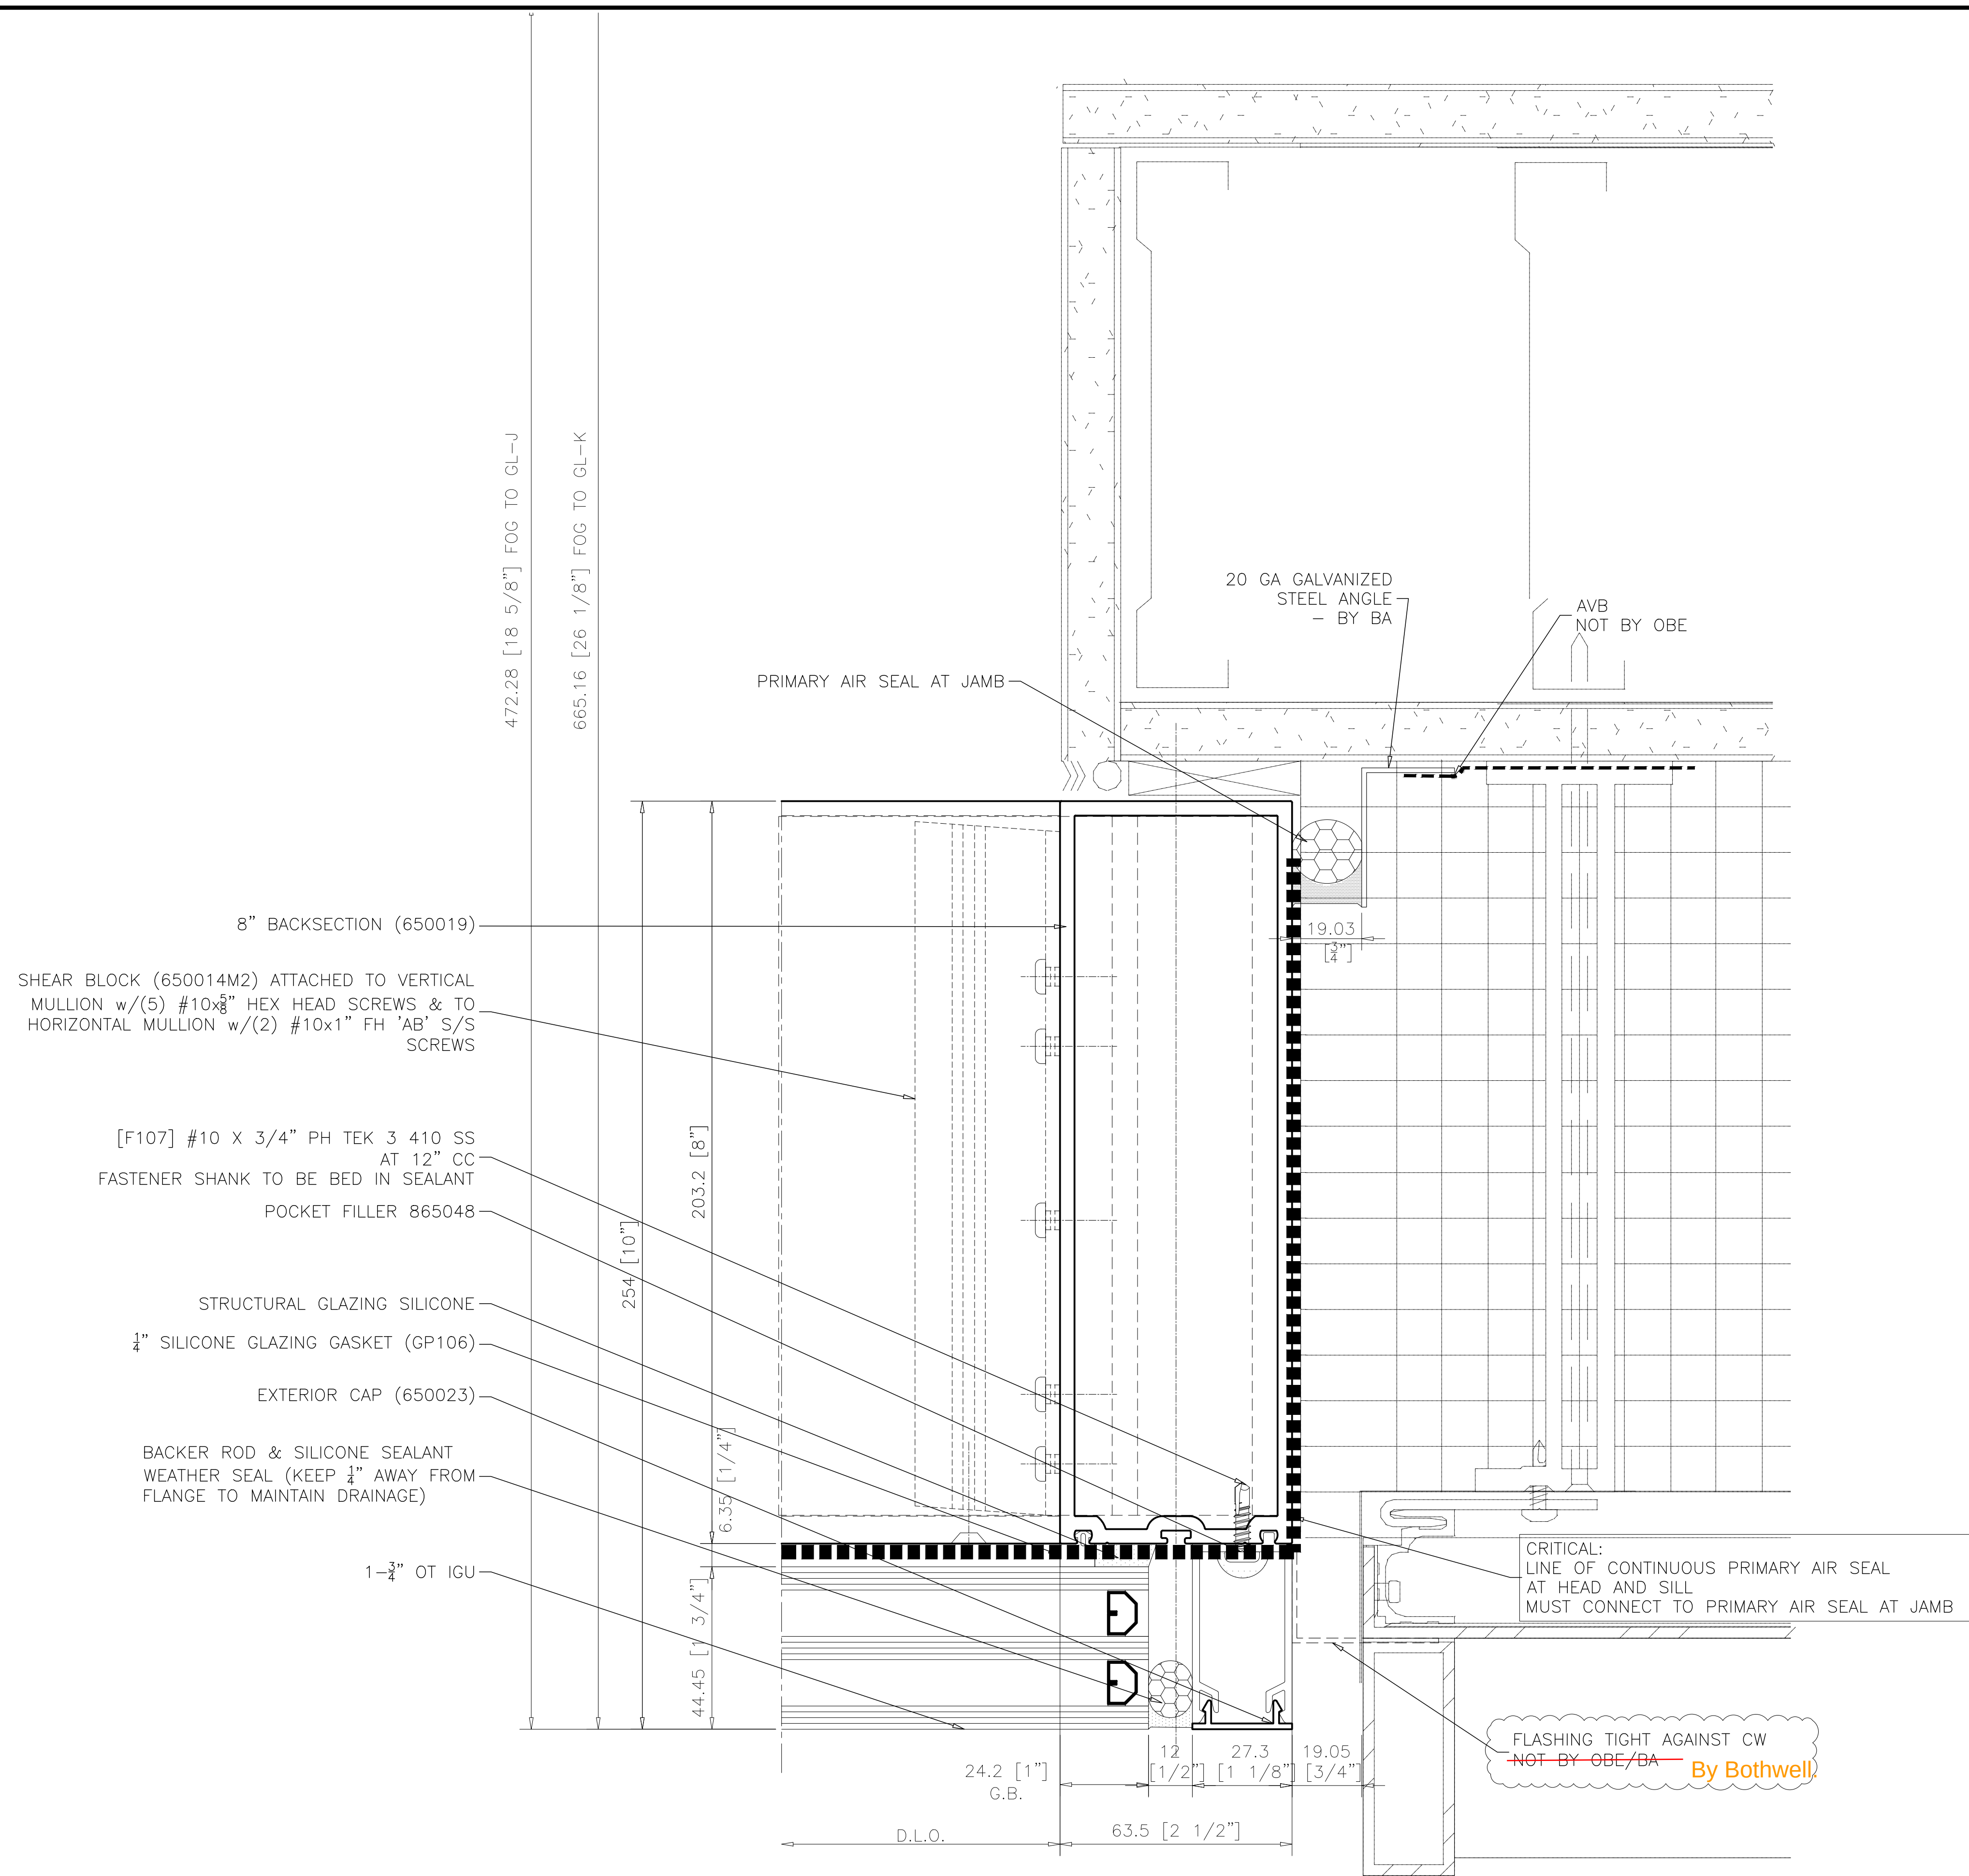

**JAMB VERTICAL SSG 8" B.S.
AT VISION GLAZING GL1B**
ARCH. REF.: 5/A501


REVISIONS			
No.	Description:	Date:	By:
1	Revised per arch. markups received Feb 11/26	03/03/26	SLR

Project Name: DOCKSTEADER PRPS	Project Location: BRAMPTON, ONTARIO	Architect Name: DIAMOND SCHMITT ARCHITECTS	Customer Name: BOTHWELL ACCURATE GLAZING
-----------------------------------	--	---	---



275 Britannia Road East • Mississauga • Ontario • Canada • L4Z2E7
905-890-6970 • oldcastlebe.com

Drawing Name: PLAN DETAIL	
Drawn By: SR	Checked By: NP
Drawn Date: 2026/01/12	Issue No.: 1
Scale: 1"=1"	Release Date: 2026/03/03
Drawing Number: C4-008C	

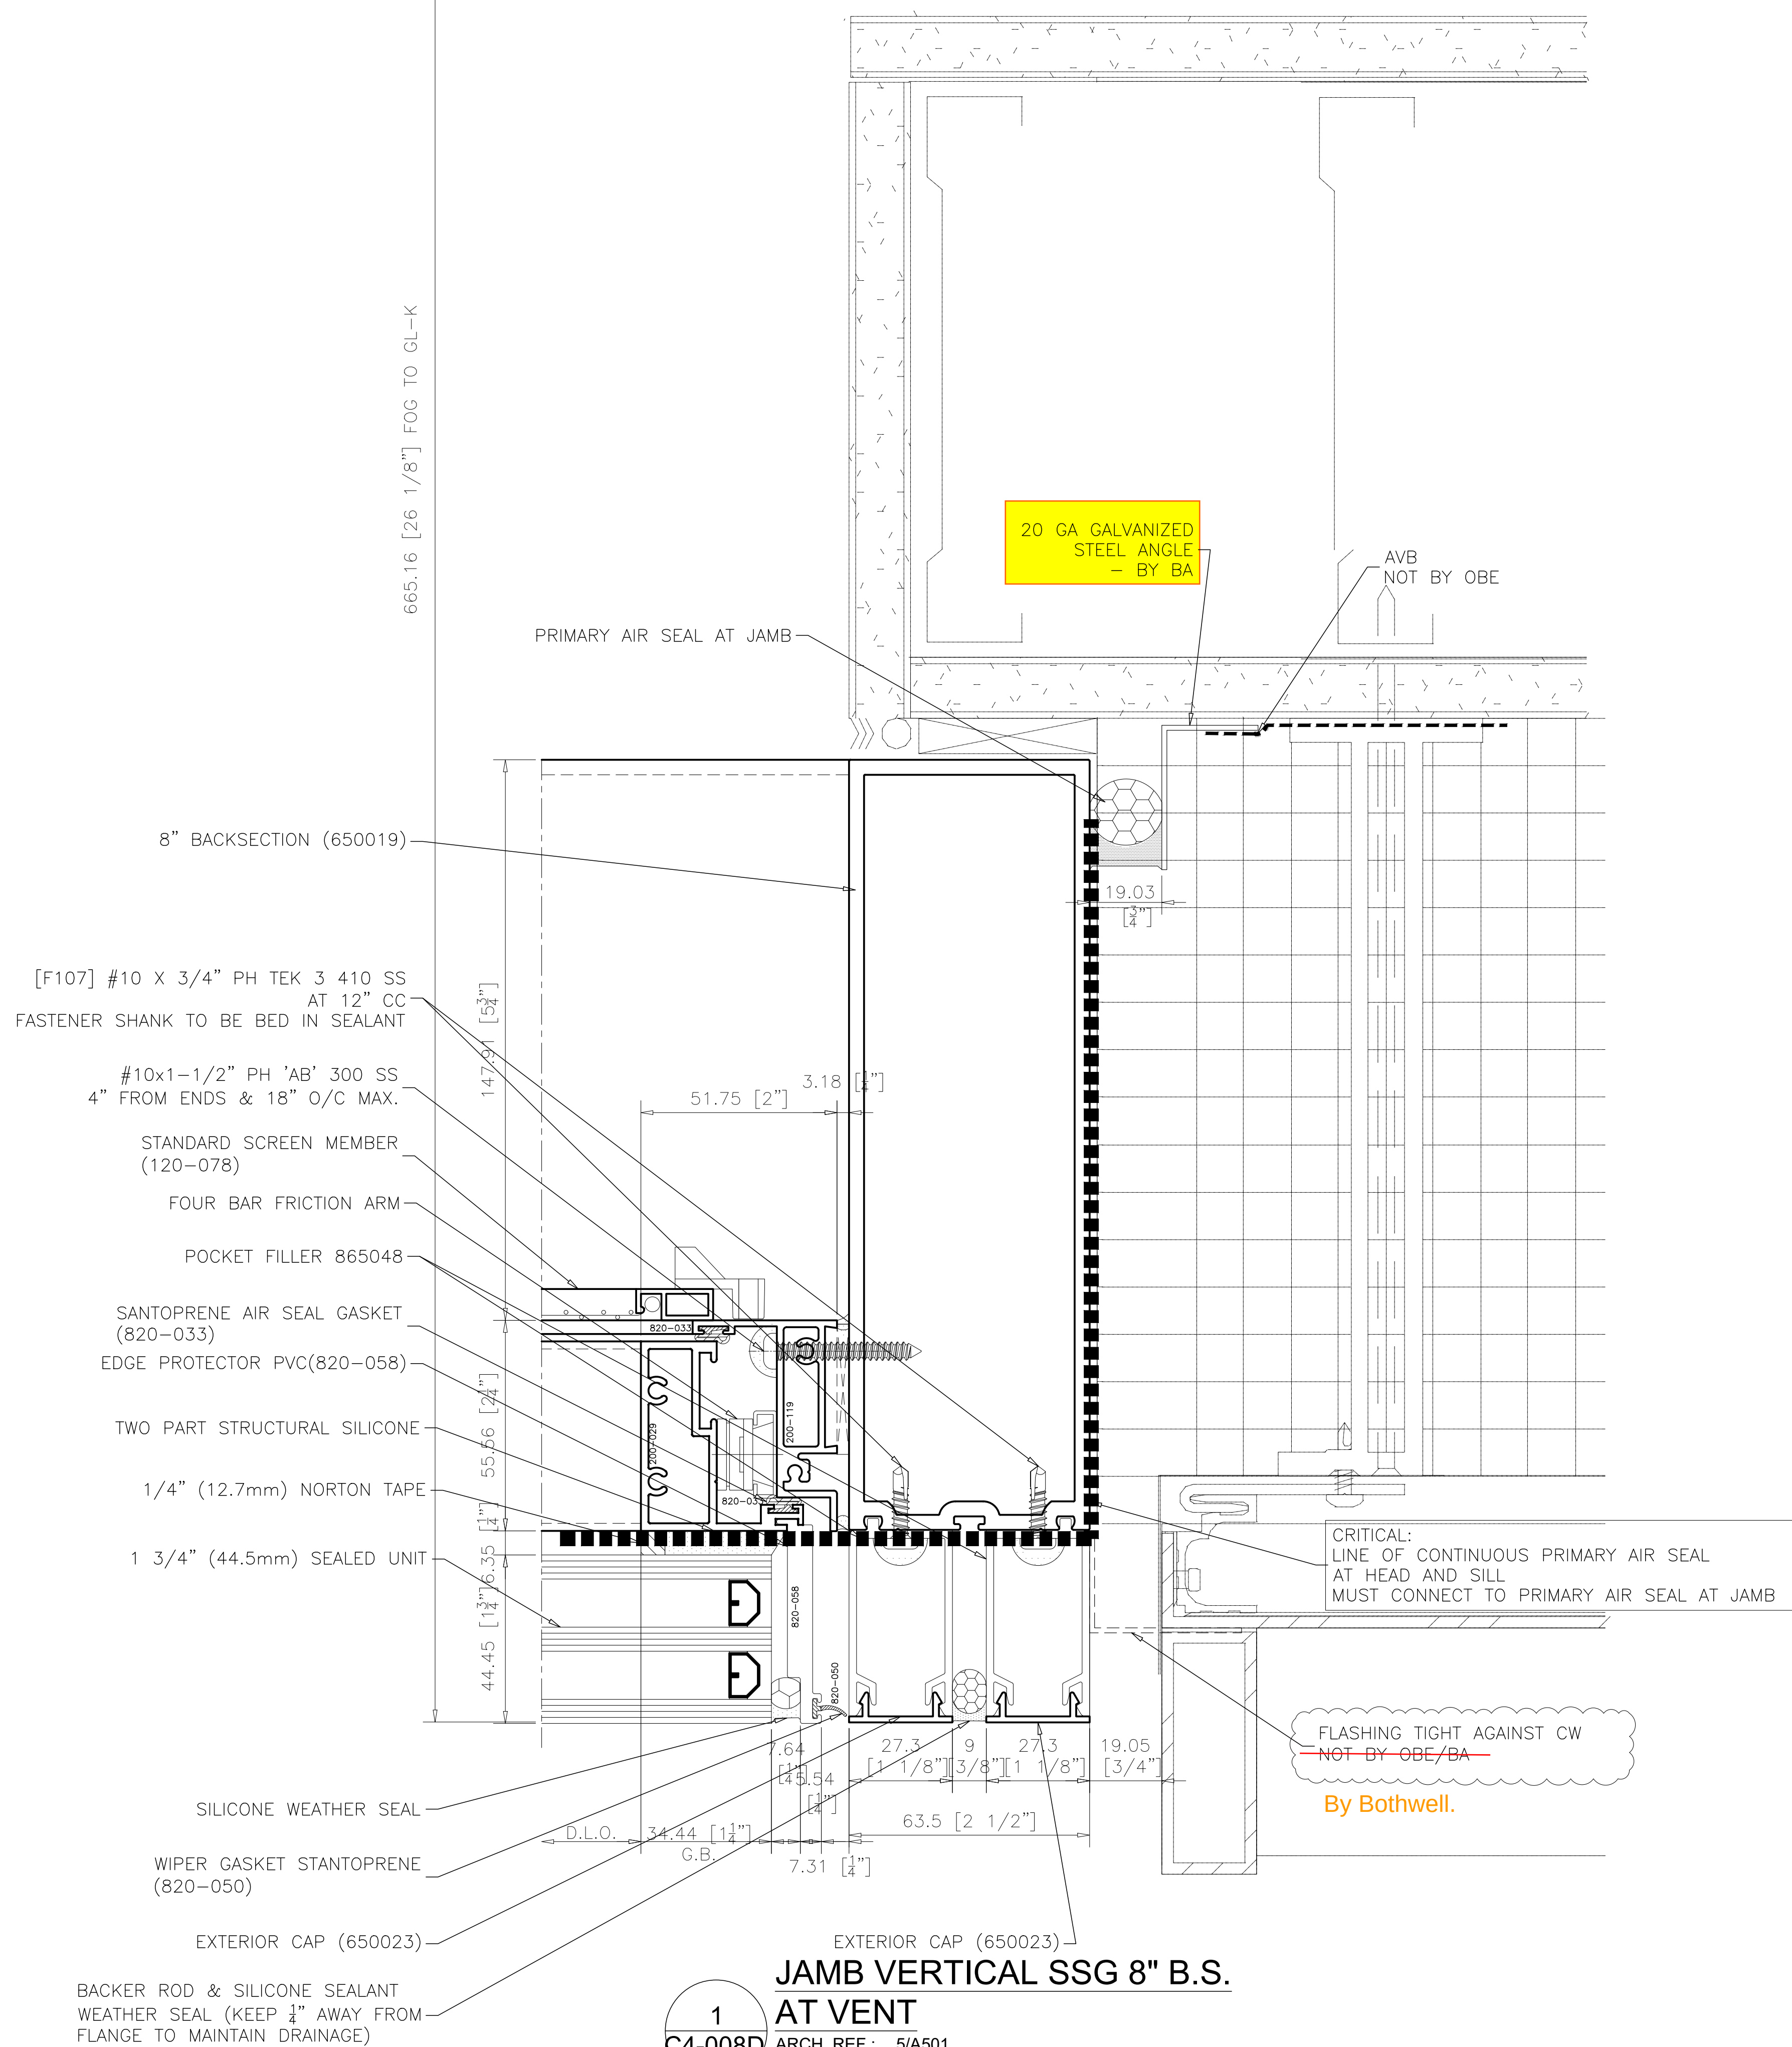

1
C4-008D

JAMB VERTICAL SSG 8" B.S.
AT VENT

ARCH. REF.: 5/A501


REVISIONS			
No.	Description:	Date:	By:
1	Revised per arch. markups received Feb 11/26	03/03/26	SLR

Project Name: DOCKSTEADER PRPS	Project Location: BRAMPTON, ONTARIO	Architect Name: DIAMOND SCHMITT ARCHITECTS	Customer Name: BOTHWELL ACCURATE GLAZING
-----------------------------------	--	---	---




275 Britannia Road East • Mississauga • Ontario • Canada • L4Z2E7
905-890-6970 • oldcastlebe.com

Drawing Name: PLAN DETAIL	
Drawn By: SR	Checked By: NP
Drawn Date: 2026/01/12	Issue No.: 1
Scale: 1"=1"	Release Date: 2026/03/03
Drawing Number: C4-008D	

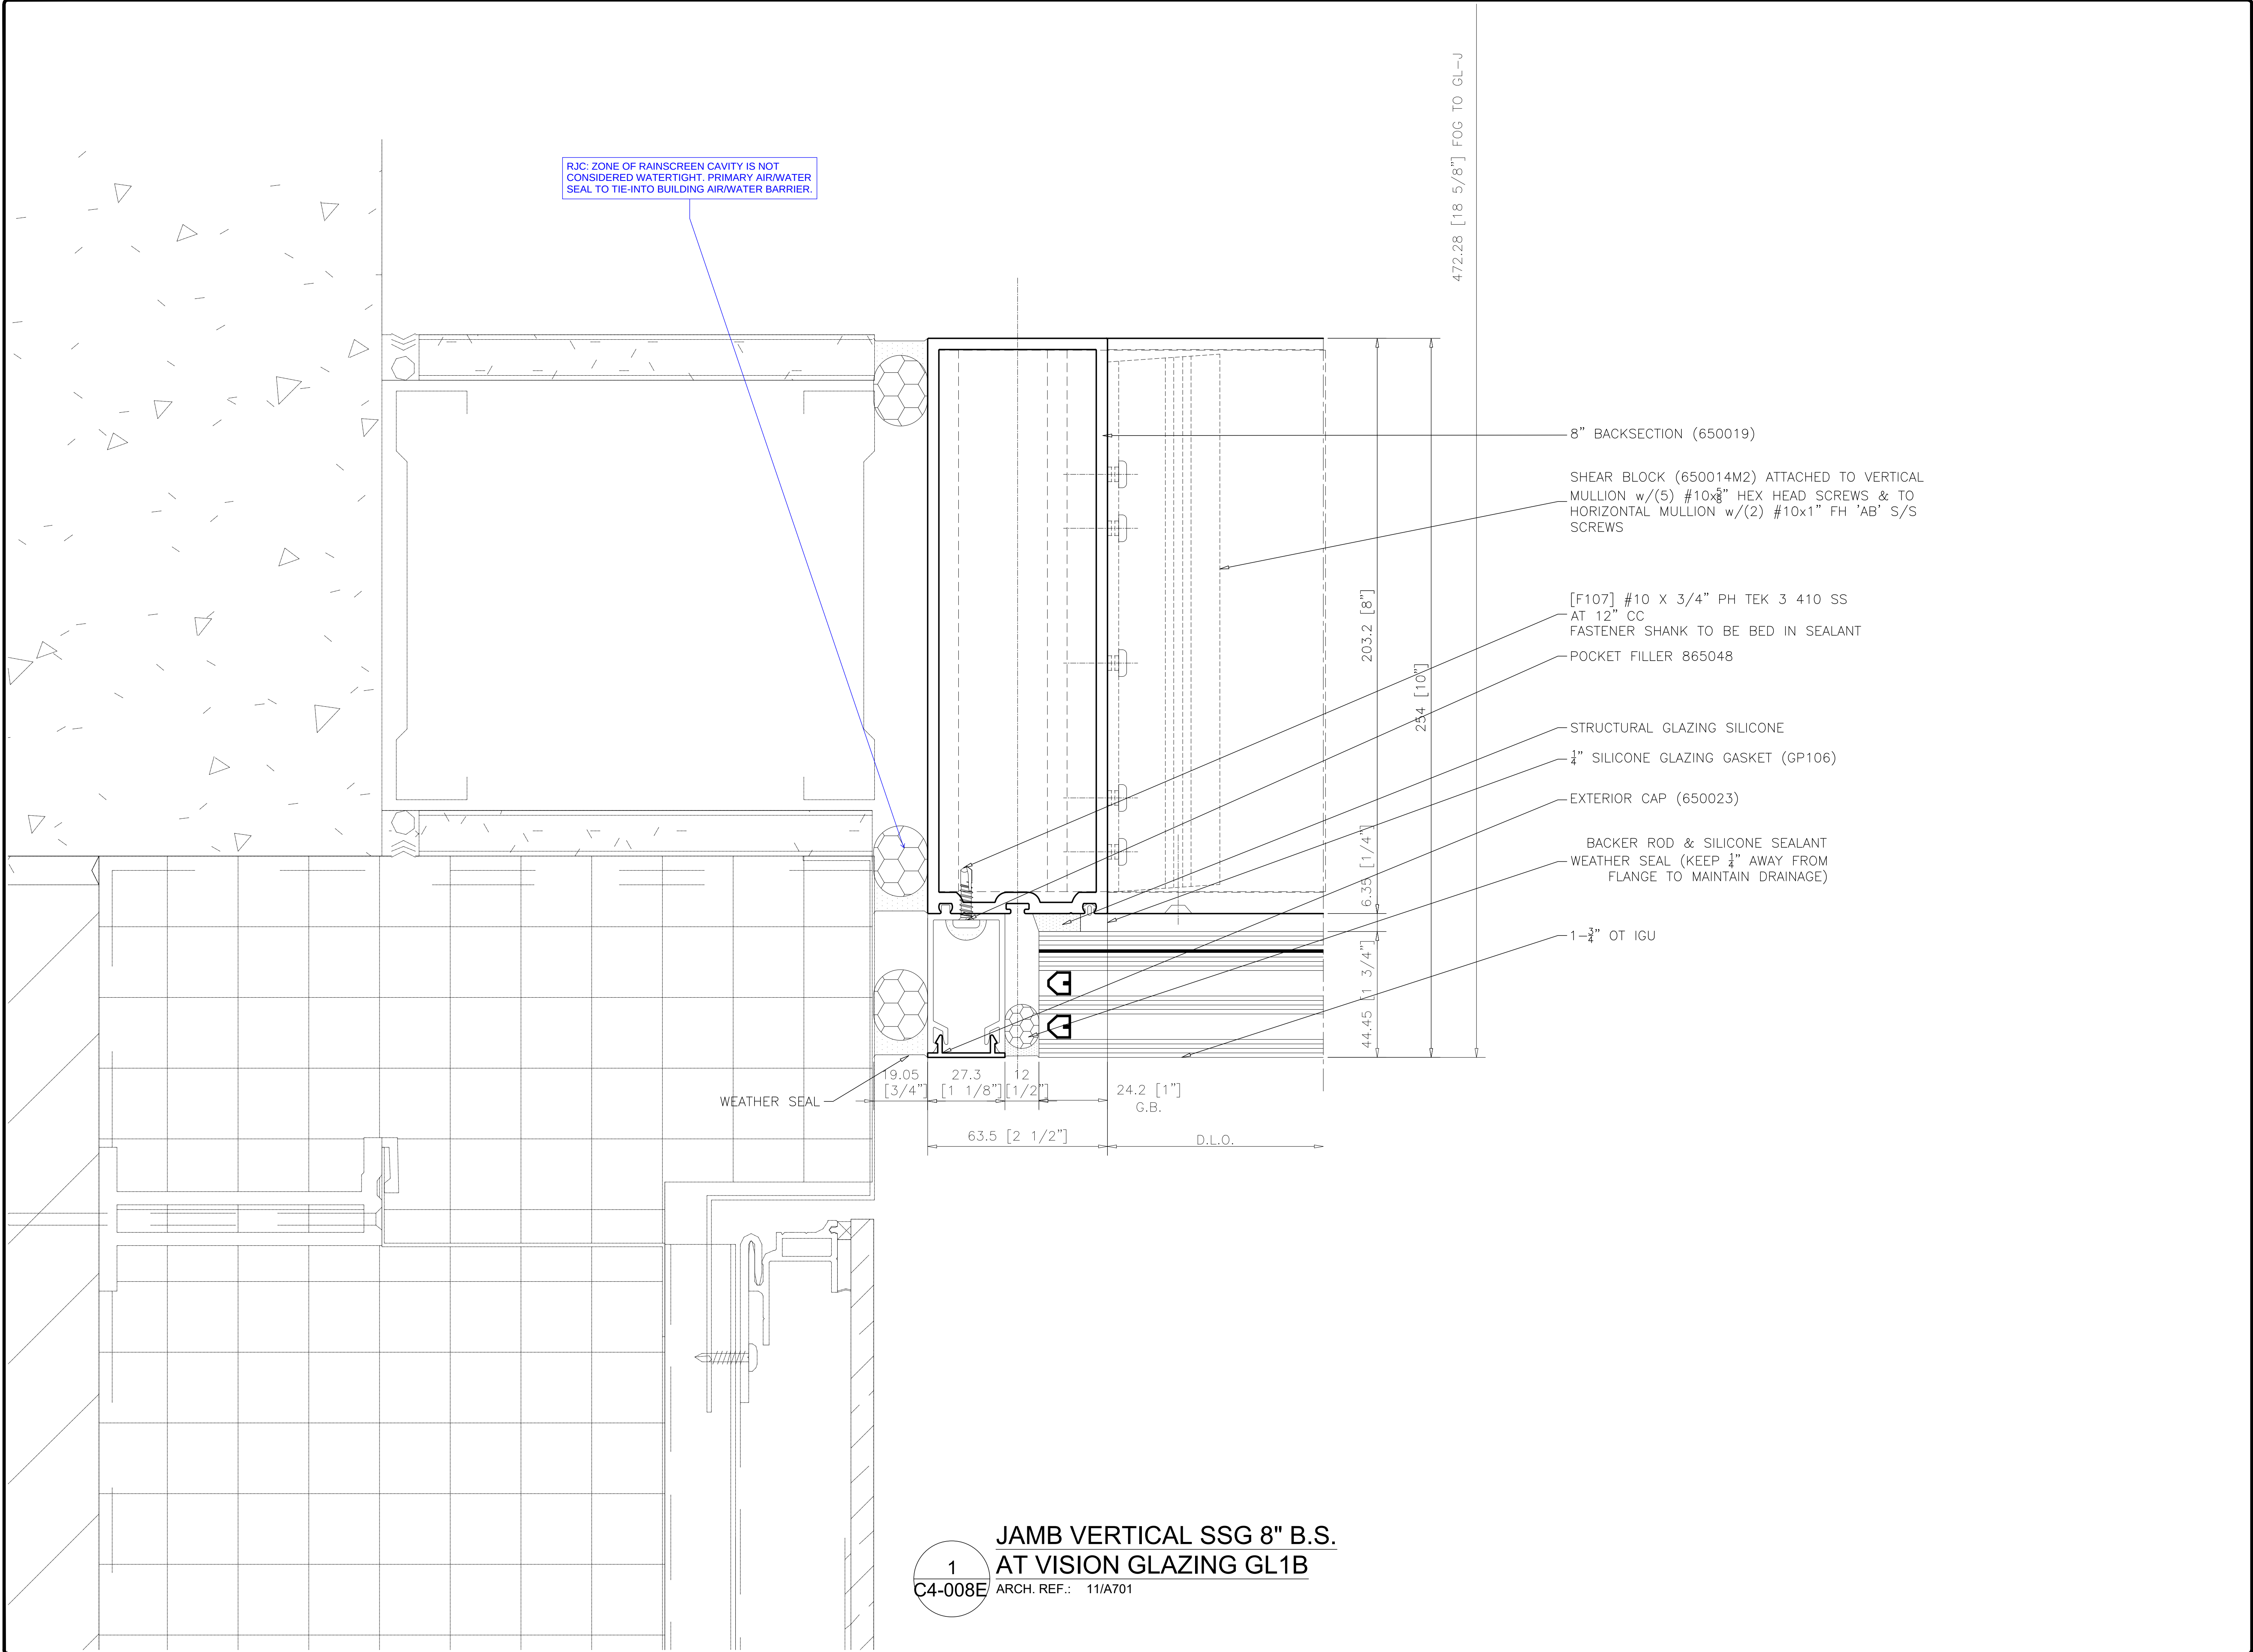


REVISIONS			
No.	Description:	Date:	By:
1	Revised per arch. markups received Feb 11/26	03/03/26	SLR

Project Name: DOCKSTEADER PRPS		Architect Name: DIAMOND SCHMITT ARCHITECTS	
Project Location: BRAMPTON, ONTARIO		Customer Name: BOTHWELL ACCURATE GLAZING	

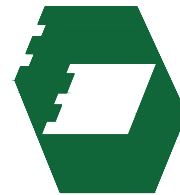**Oldcastle BuildingEnvelope®**

275 Britannia Road East • Mississauga • Ontario • Canada • L4Z2E7
905-890-6970 • oldcastlebe.com

Drawing Name: PLAN DETAIL	
Drawn By: SR	Checked By: NP
Drawn Date: 2026/01/12	Issue No.: 1
Scale: 1"=1'	Release Date: 2026/03/03
Drawing Number: C4-008E	

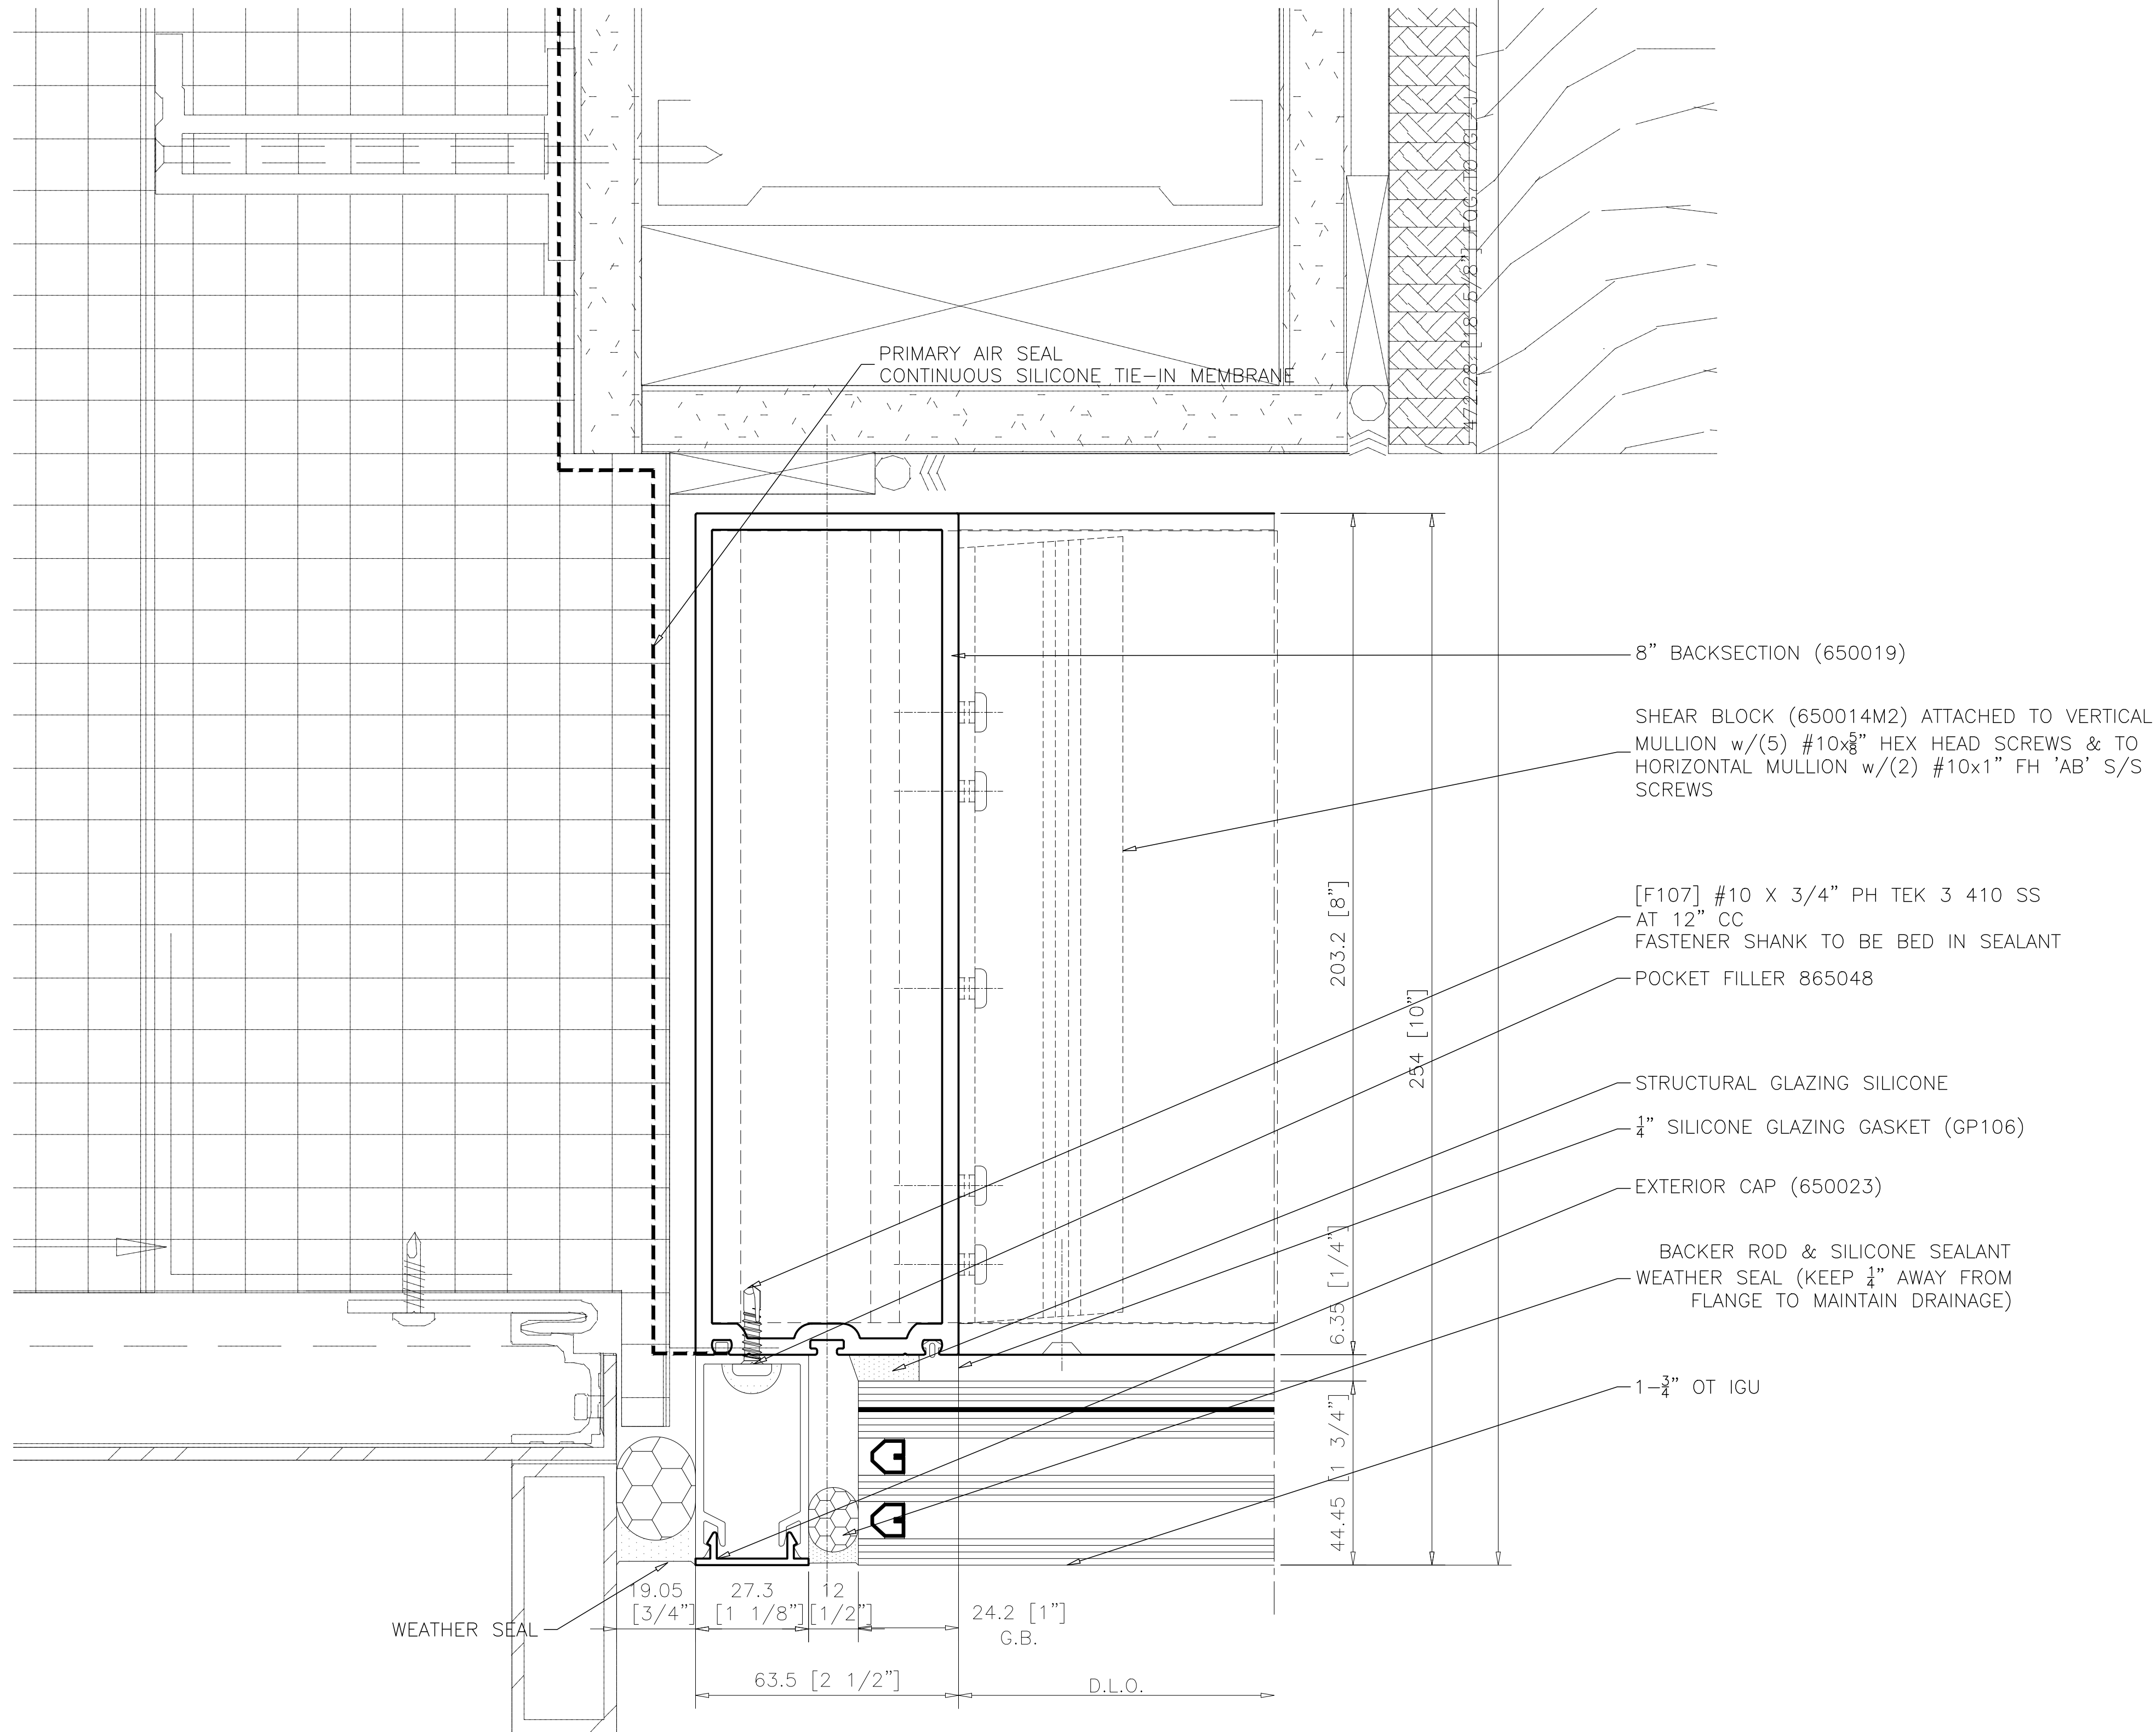

**JAMB VERTICAL SSG 8" B.S.
AT VISION GLAZING GL1B**

ARCH. REF.: 12/A501


REVISIONS			
No.	Description:	Date:	By:
1	Revised per arch. markups received Feb 11/26	03/03/26	SLR

Project Name: DOCKSTEADER PRPS	Project Location: BRAMPTON, ONTARIO	Architect Name: DIAMOND SCHMITT ARCHITECTS	Customer Name: BOTHWELL ACCURATE GLAZING
-----------------------------------	--	---	---



275 Britannia Road East • Mississauga • Ontario • Canada • L4Z2E7
905-890-6970 • oldcastlebe.com

Drawing Name: PLAN DETAIL	
Drawn By: SR	Checked By: NP
Drawn Date: 2026/01/12	Issue No.: 1
Scale: 1"=1"	Release Date: 2026/03/03
Drawing Number: C4-008F	

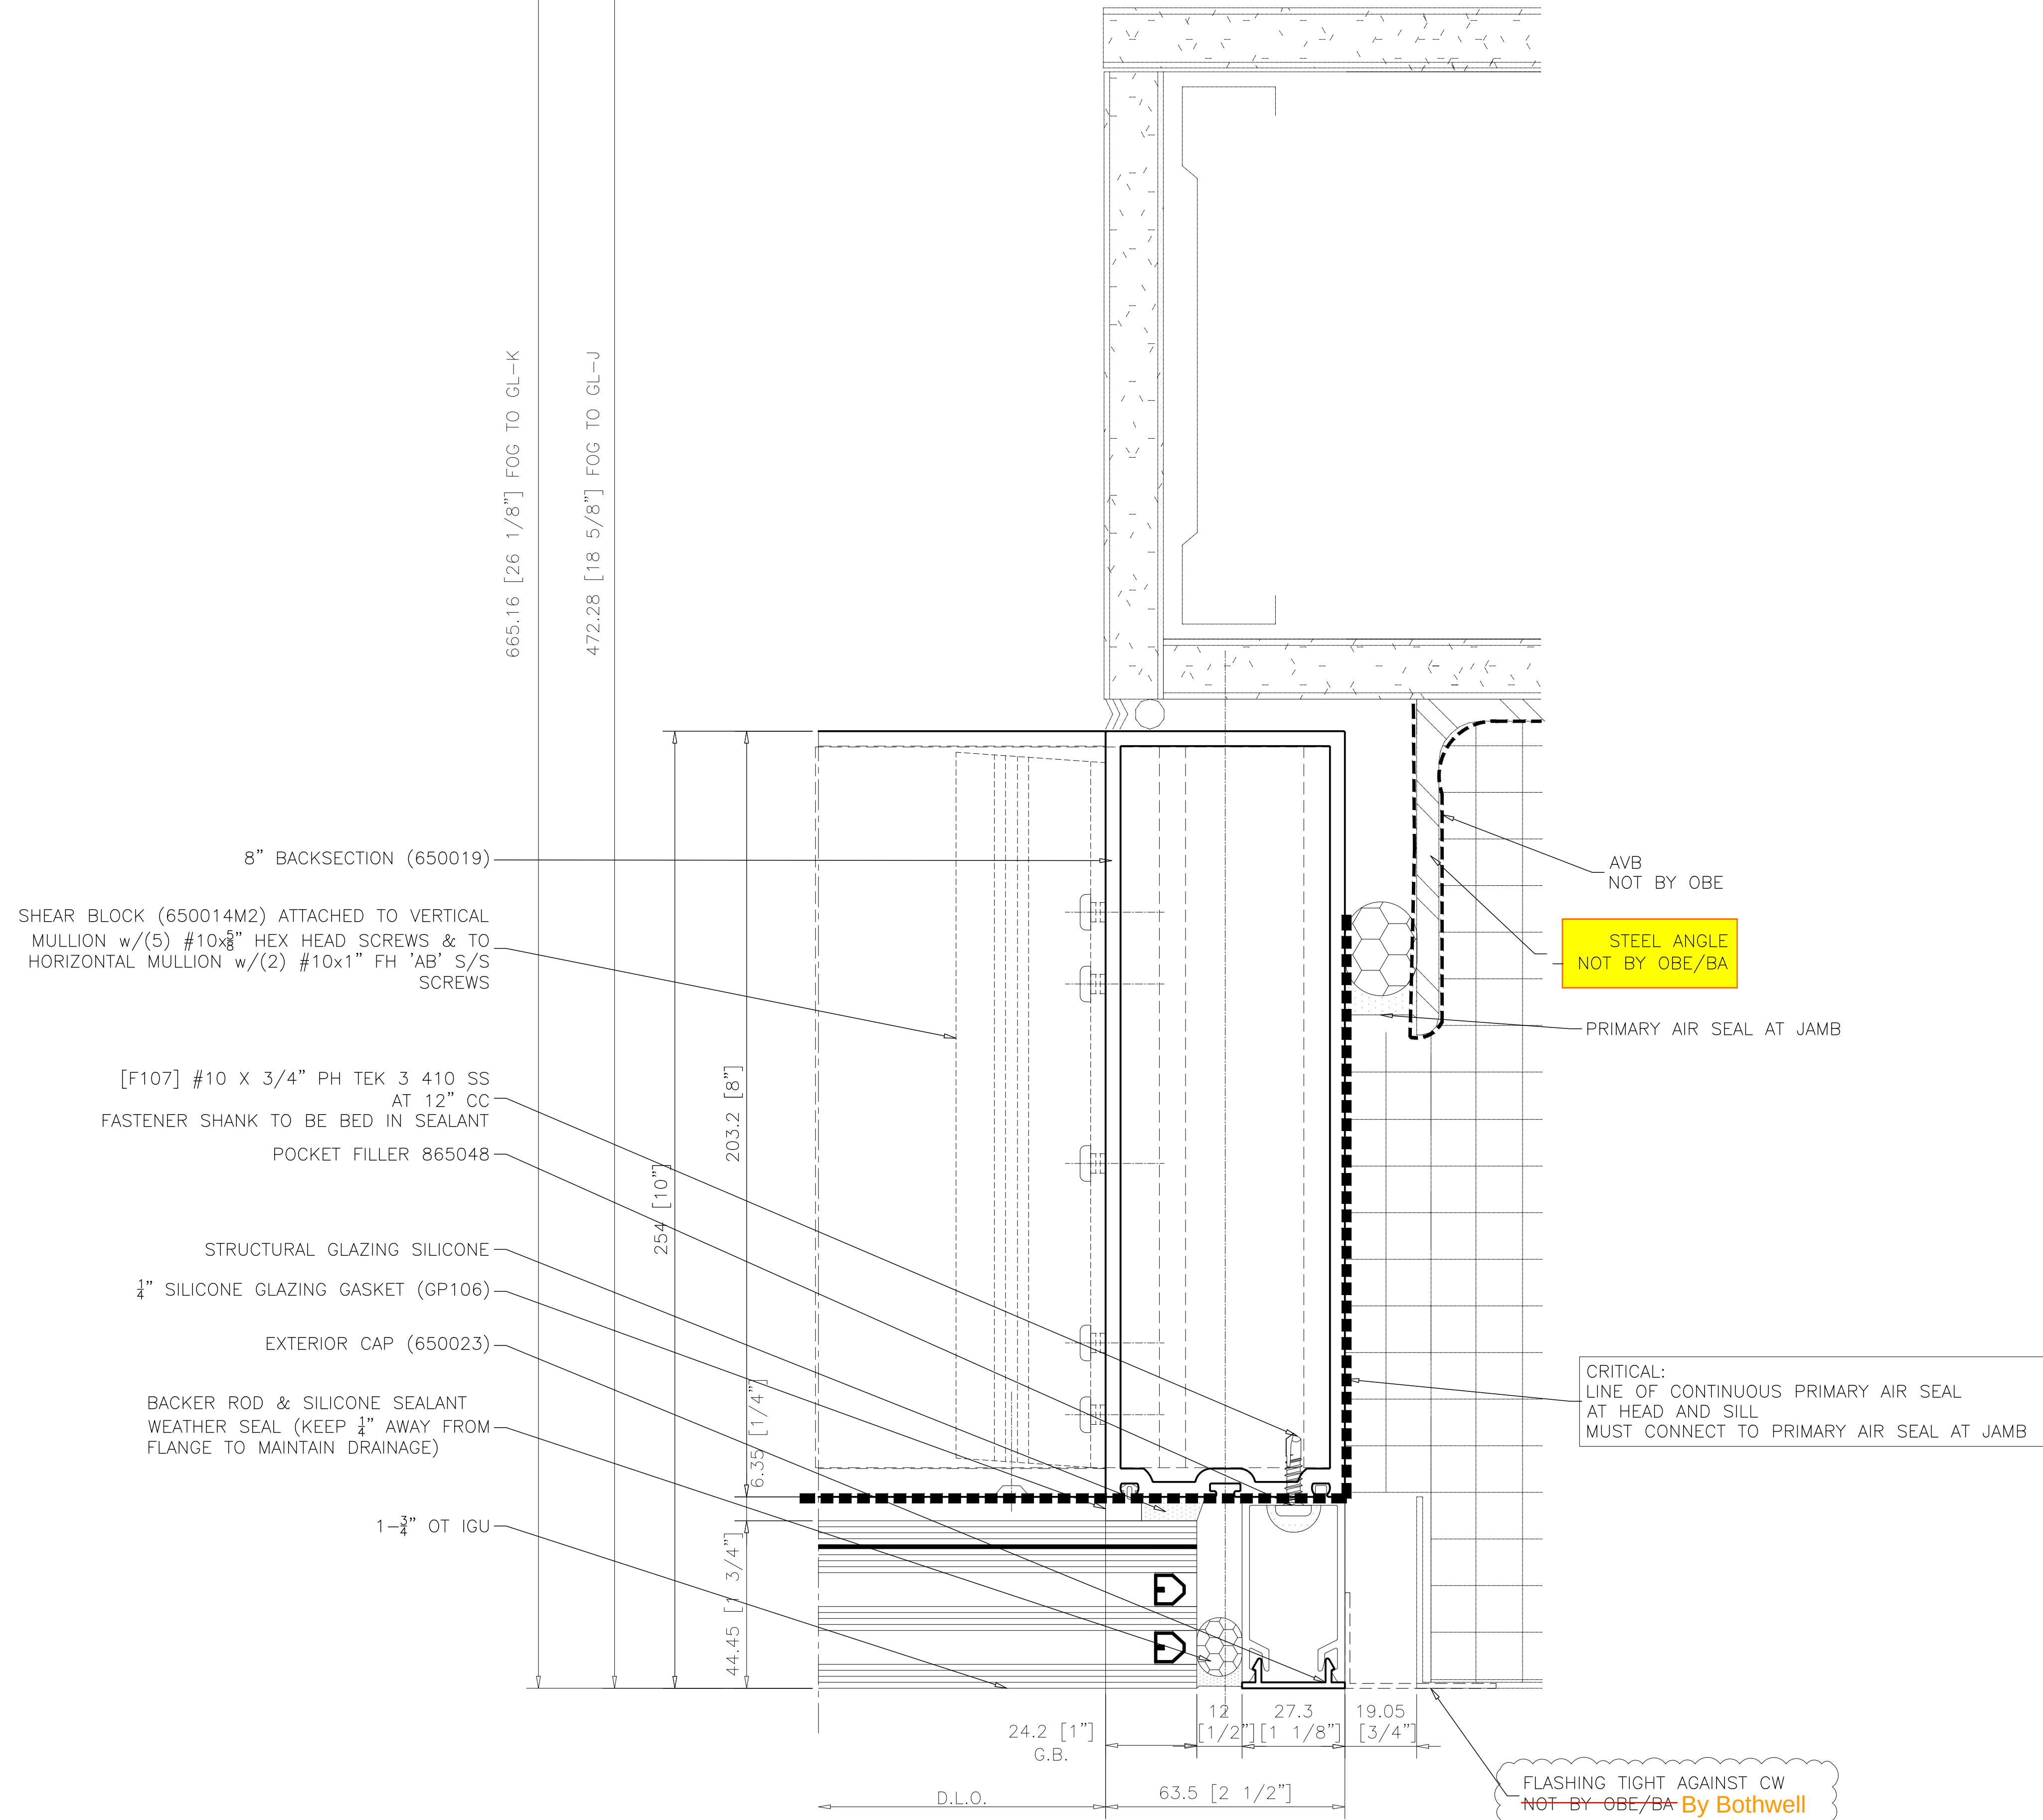

**JAMB VERTICAL SSG 8" B.S.
AT VISION GLAZING GL1B**

ARCH. REF.: 1/A501


REVISIONS			
No.	Description:	Date:	By:
1	Revised per arch. markups received Feb 11/26	03/03/26	SLR

Project Name: DOCKSTEADER PRPS	Project Location: BRAMPTON, ONTARIO	Architect Name: DIAMOND SCHMITT ARCHITECTS	Customer Name: BOTHWELL ACCURATE GLAZING
-----------------------------------	--	---	---



275 Britannia Road East • Mississauga • Ontario • Canada • L4Z2E7
905-890-6970 • oldcastlebe.com

Drawing Name: PLAN DETAIL	
Drawn By: SR	Checked By: NP
Drawn Date: 2026/01/12	Issue No.: 1
Scale: 1"=1"	Release Date: 2026/03/03
Drawing Number: C4-008G	

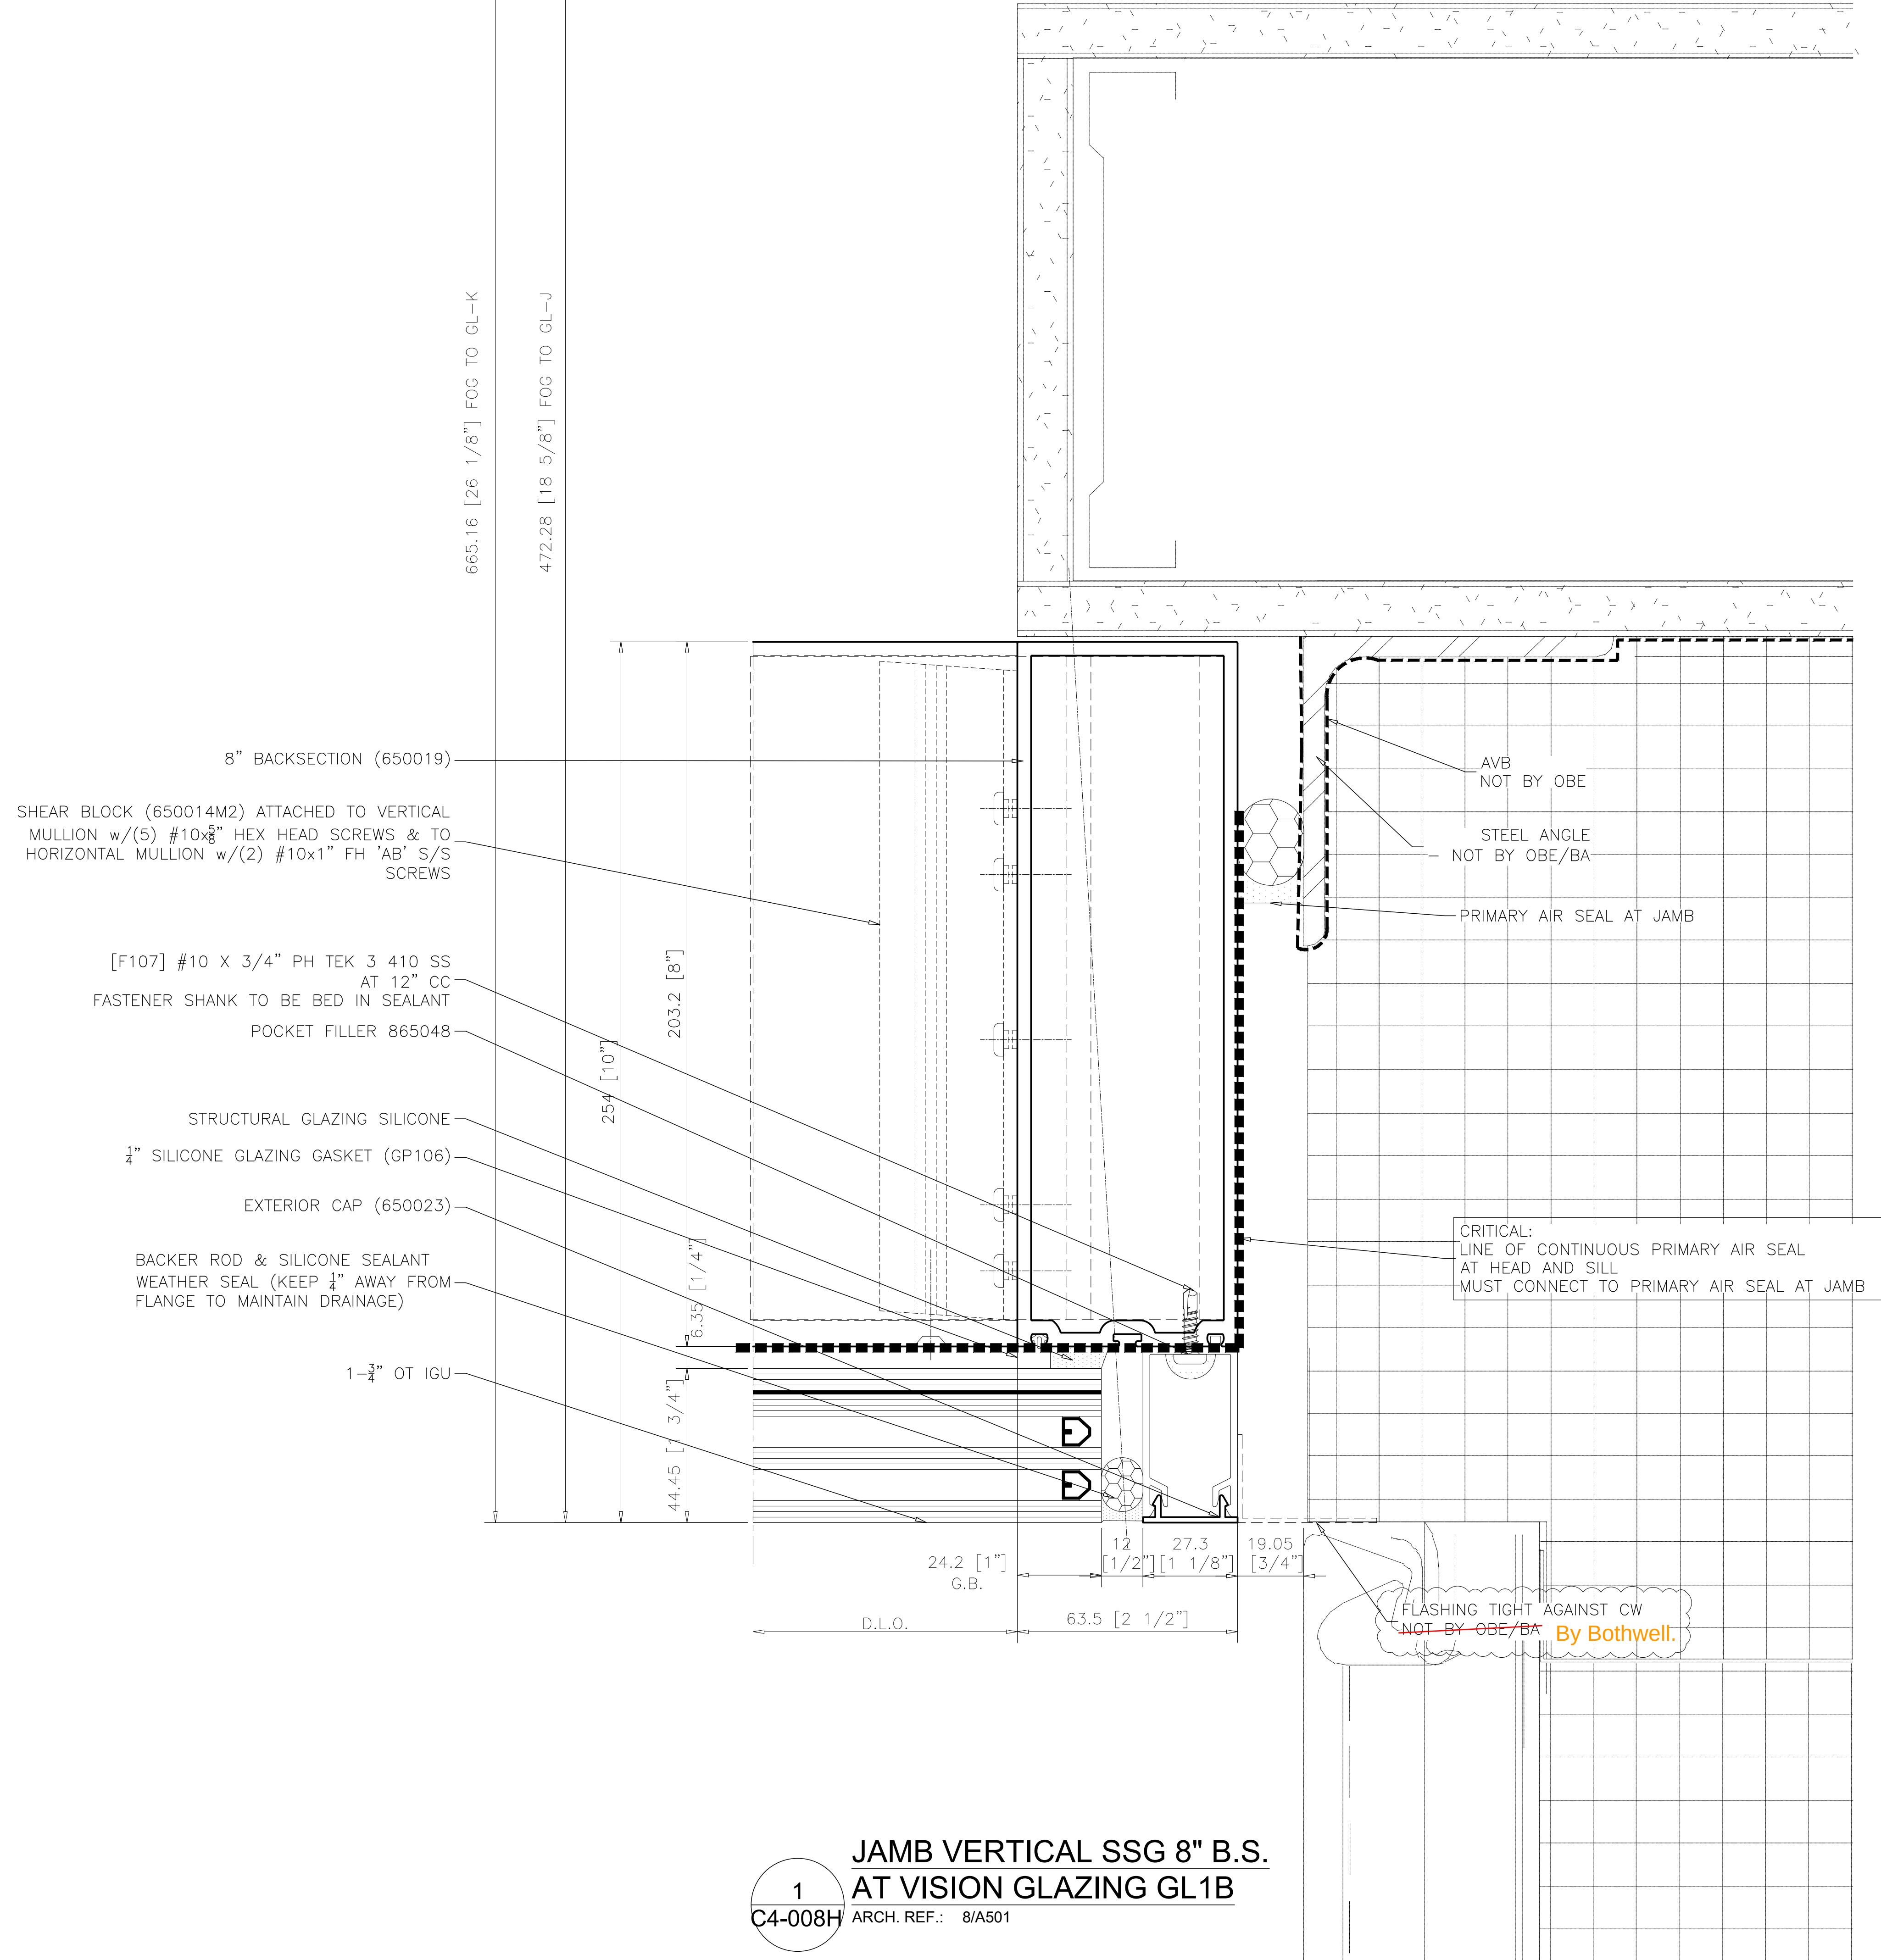

**JAMB VERTICAL SSG 8" B.S.
AT VISION GLAZING GL1B**
ARCH. REF.: 8/A501


REVISIONS			
No.	Description:	Date:	By:
1	Revised per arch. markups received Feb 11/26	03/03/26	SLR

Project Name: DOCKSTEADER PRPS	Project Location: BRAMPTON, ONTARIO	Architect Name: DIAMOND SCHMITT ARCHITECTS	Customer Name: BOTHWELL ACCURATE GLAZING
-----------------------------------	--	---	---



275 Britannia Road East • Mississauga • Ontario • Canada • L4Z2E7
905-890-6970 • oldcastlebe.com

Drawing Name: PLAN DETAIL	
Drawn By: SR	Checked By: NP
Drawn Date: 2026/01/12	Issue No.: 1
Scale: 1"=1"	Release Date: 2026/03/03
Drawing Number: C4-008H	

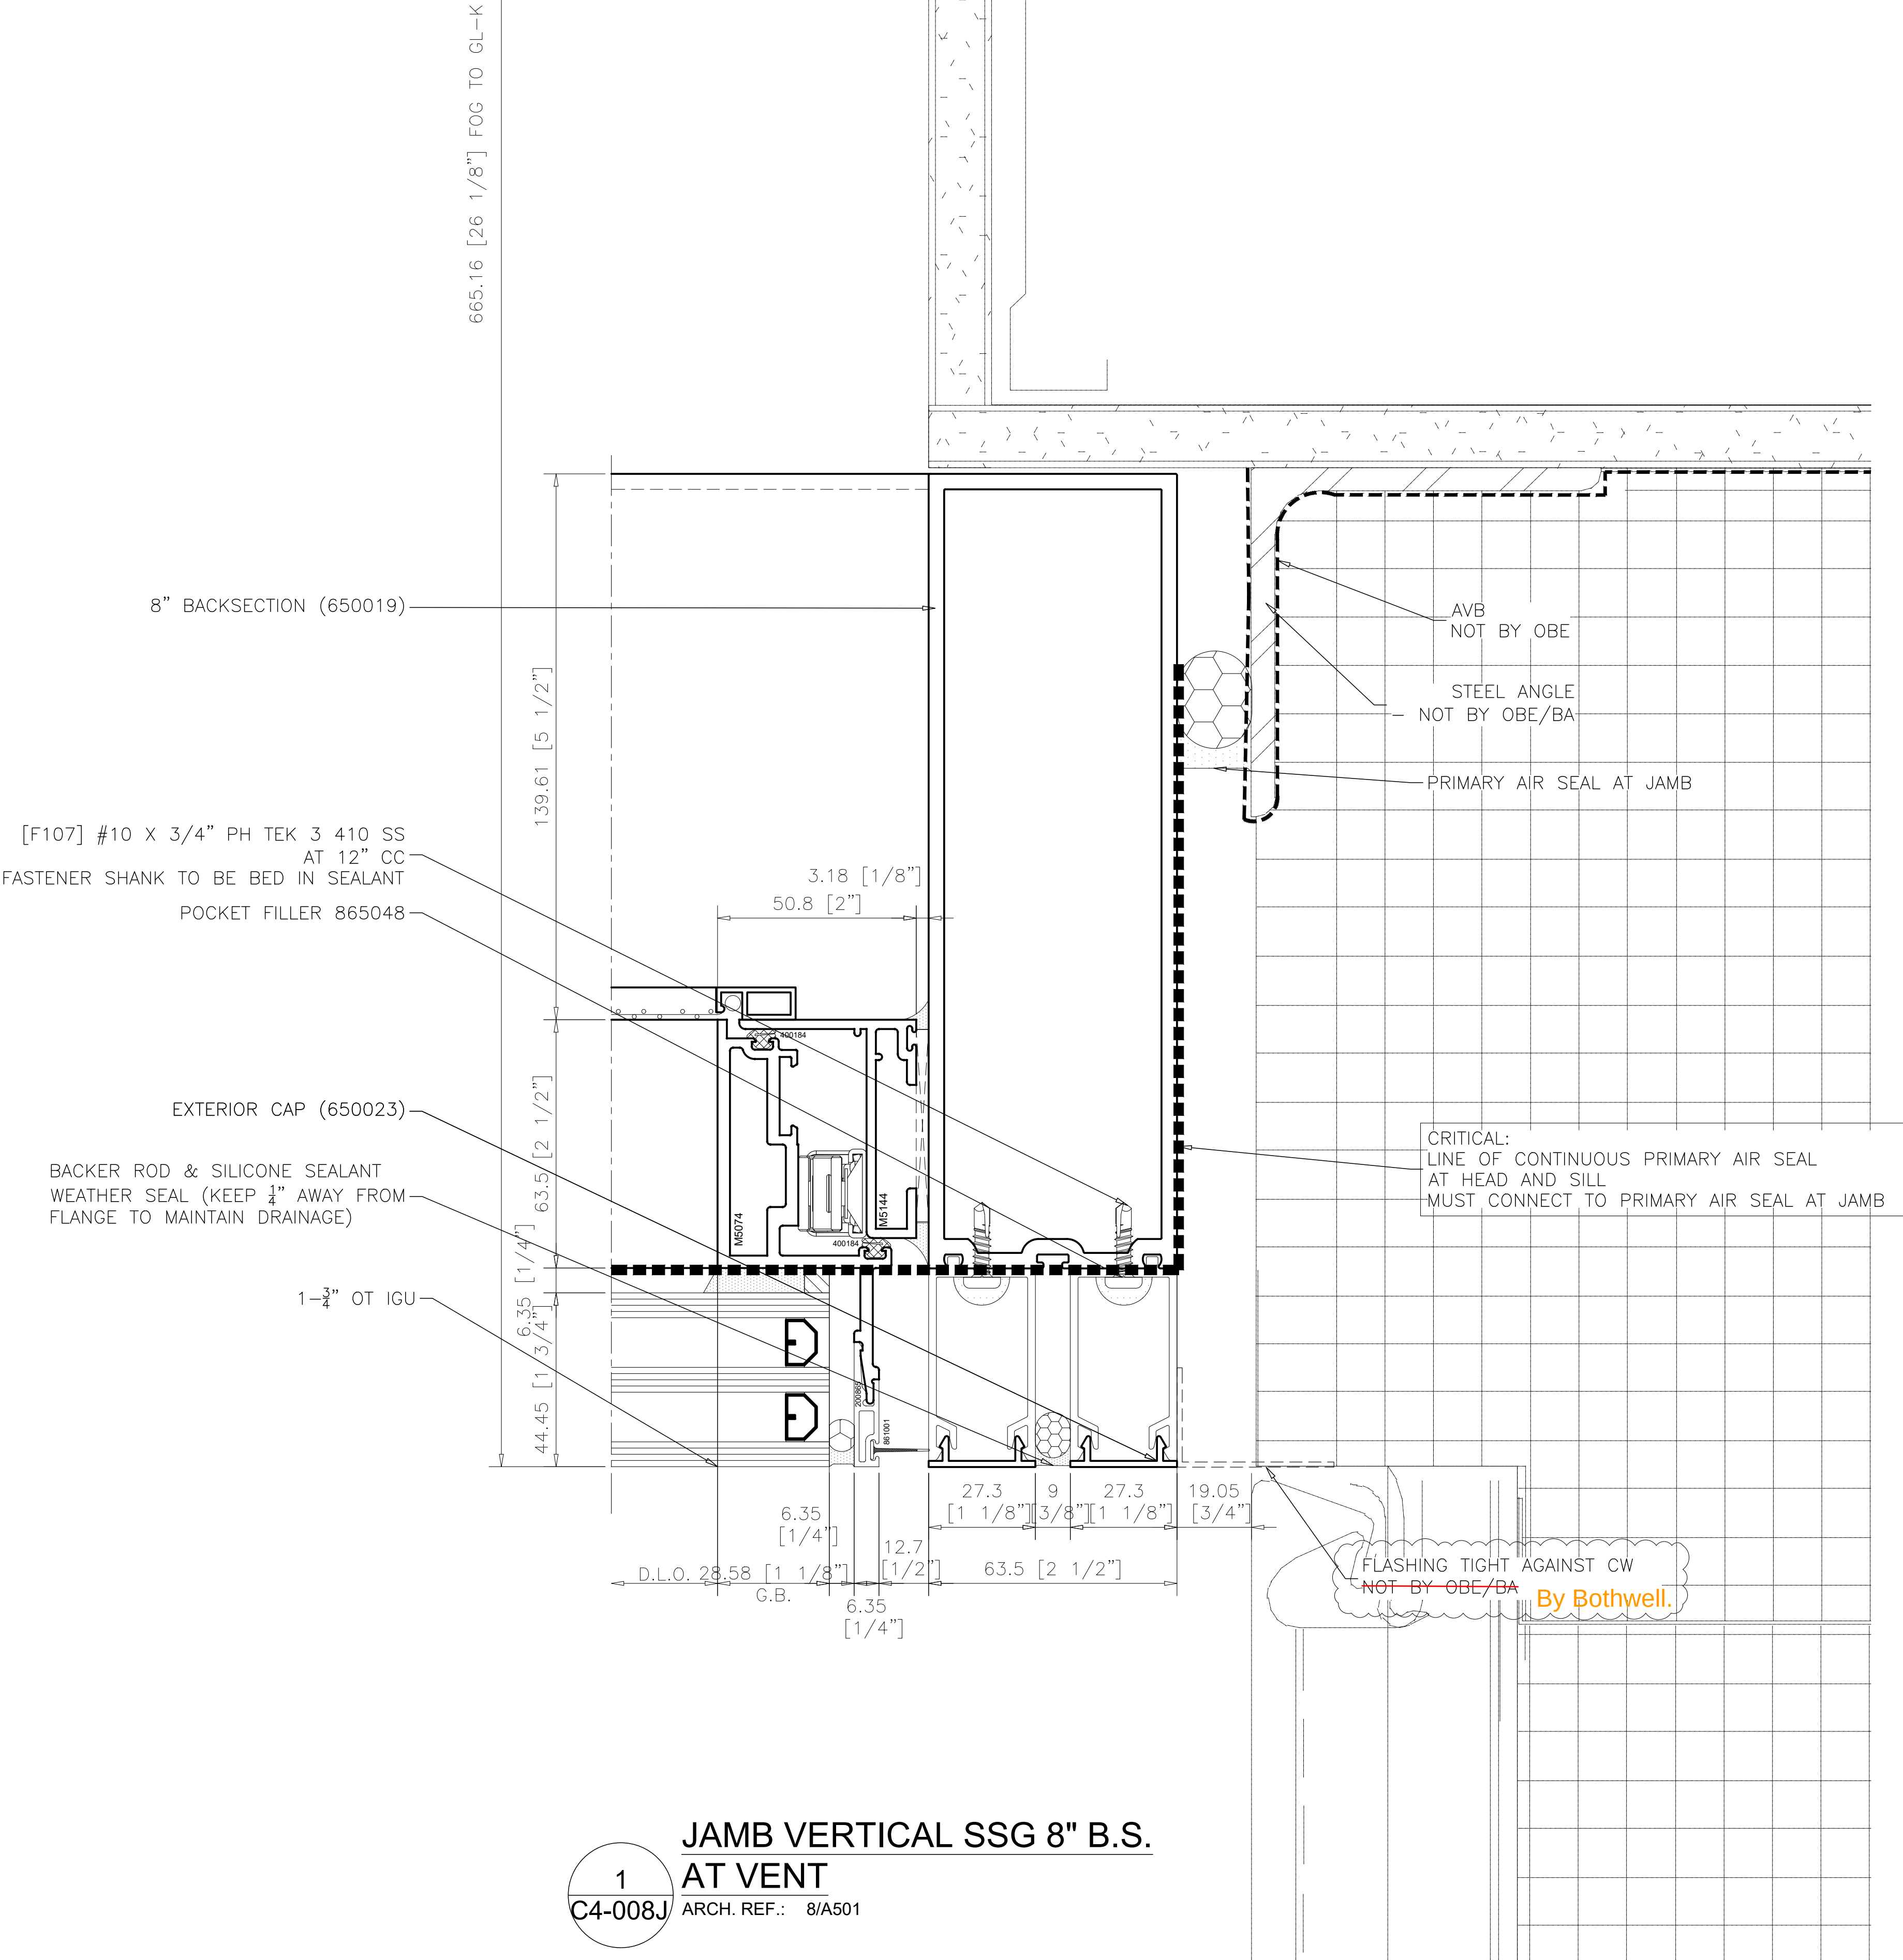

**JAMB VERTICAL SSG 8" B.S.
AT VENT**
ARCH. REF.: 8/A501

REVISIONS			
No.	Description:	Date:	By:
1	Revised per arch. markups received Feb 11/26	03/03/26	SLR


Project Name: DOCKSTEADER PRPS	Project Location: BRAMPTON, ONTARIO	Architect Name: DIAMOND SCHMITT ARCHITECTS	Customer Name: BOTHWELL ACCURATE GLAZING
-----------------------------------	--	---	---



275 Britannia Road East • Mississauga • Ontario • Canada • L4Z2E7
905-890-6970 • oldcastlebe.com


Drawing Name:
PLAN DETAIL

Drawn By: SR	Checked By: NP
Drawn Date: 2026/01/12	Issue No.: 1
Scale: 1"=1"	Release Date: 2026/03/03
Drawing Number: C4-008J	

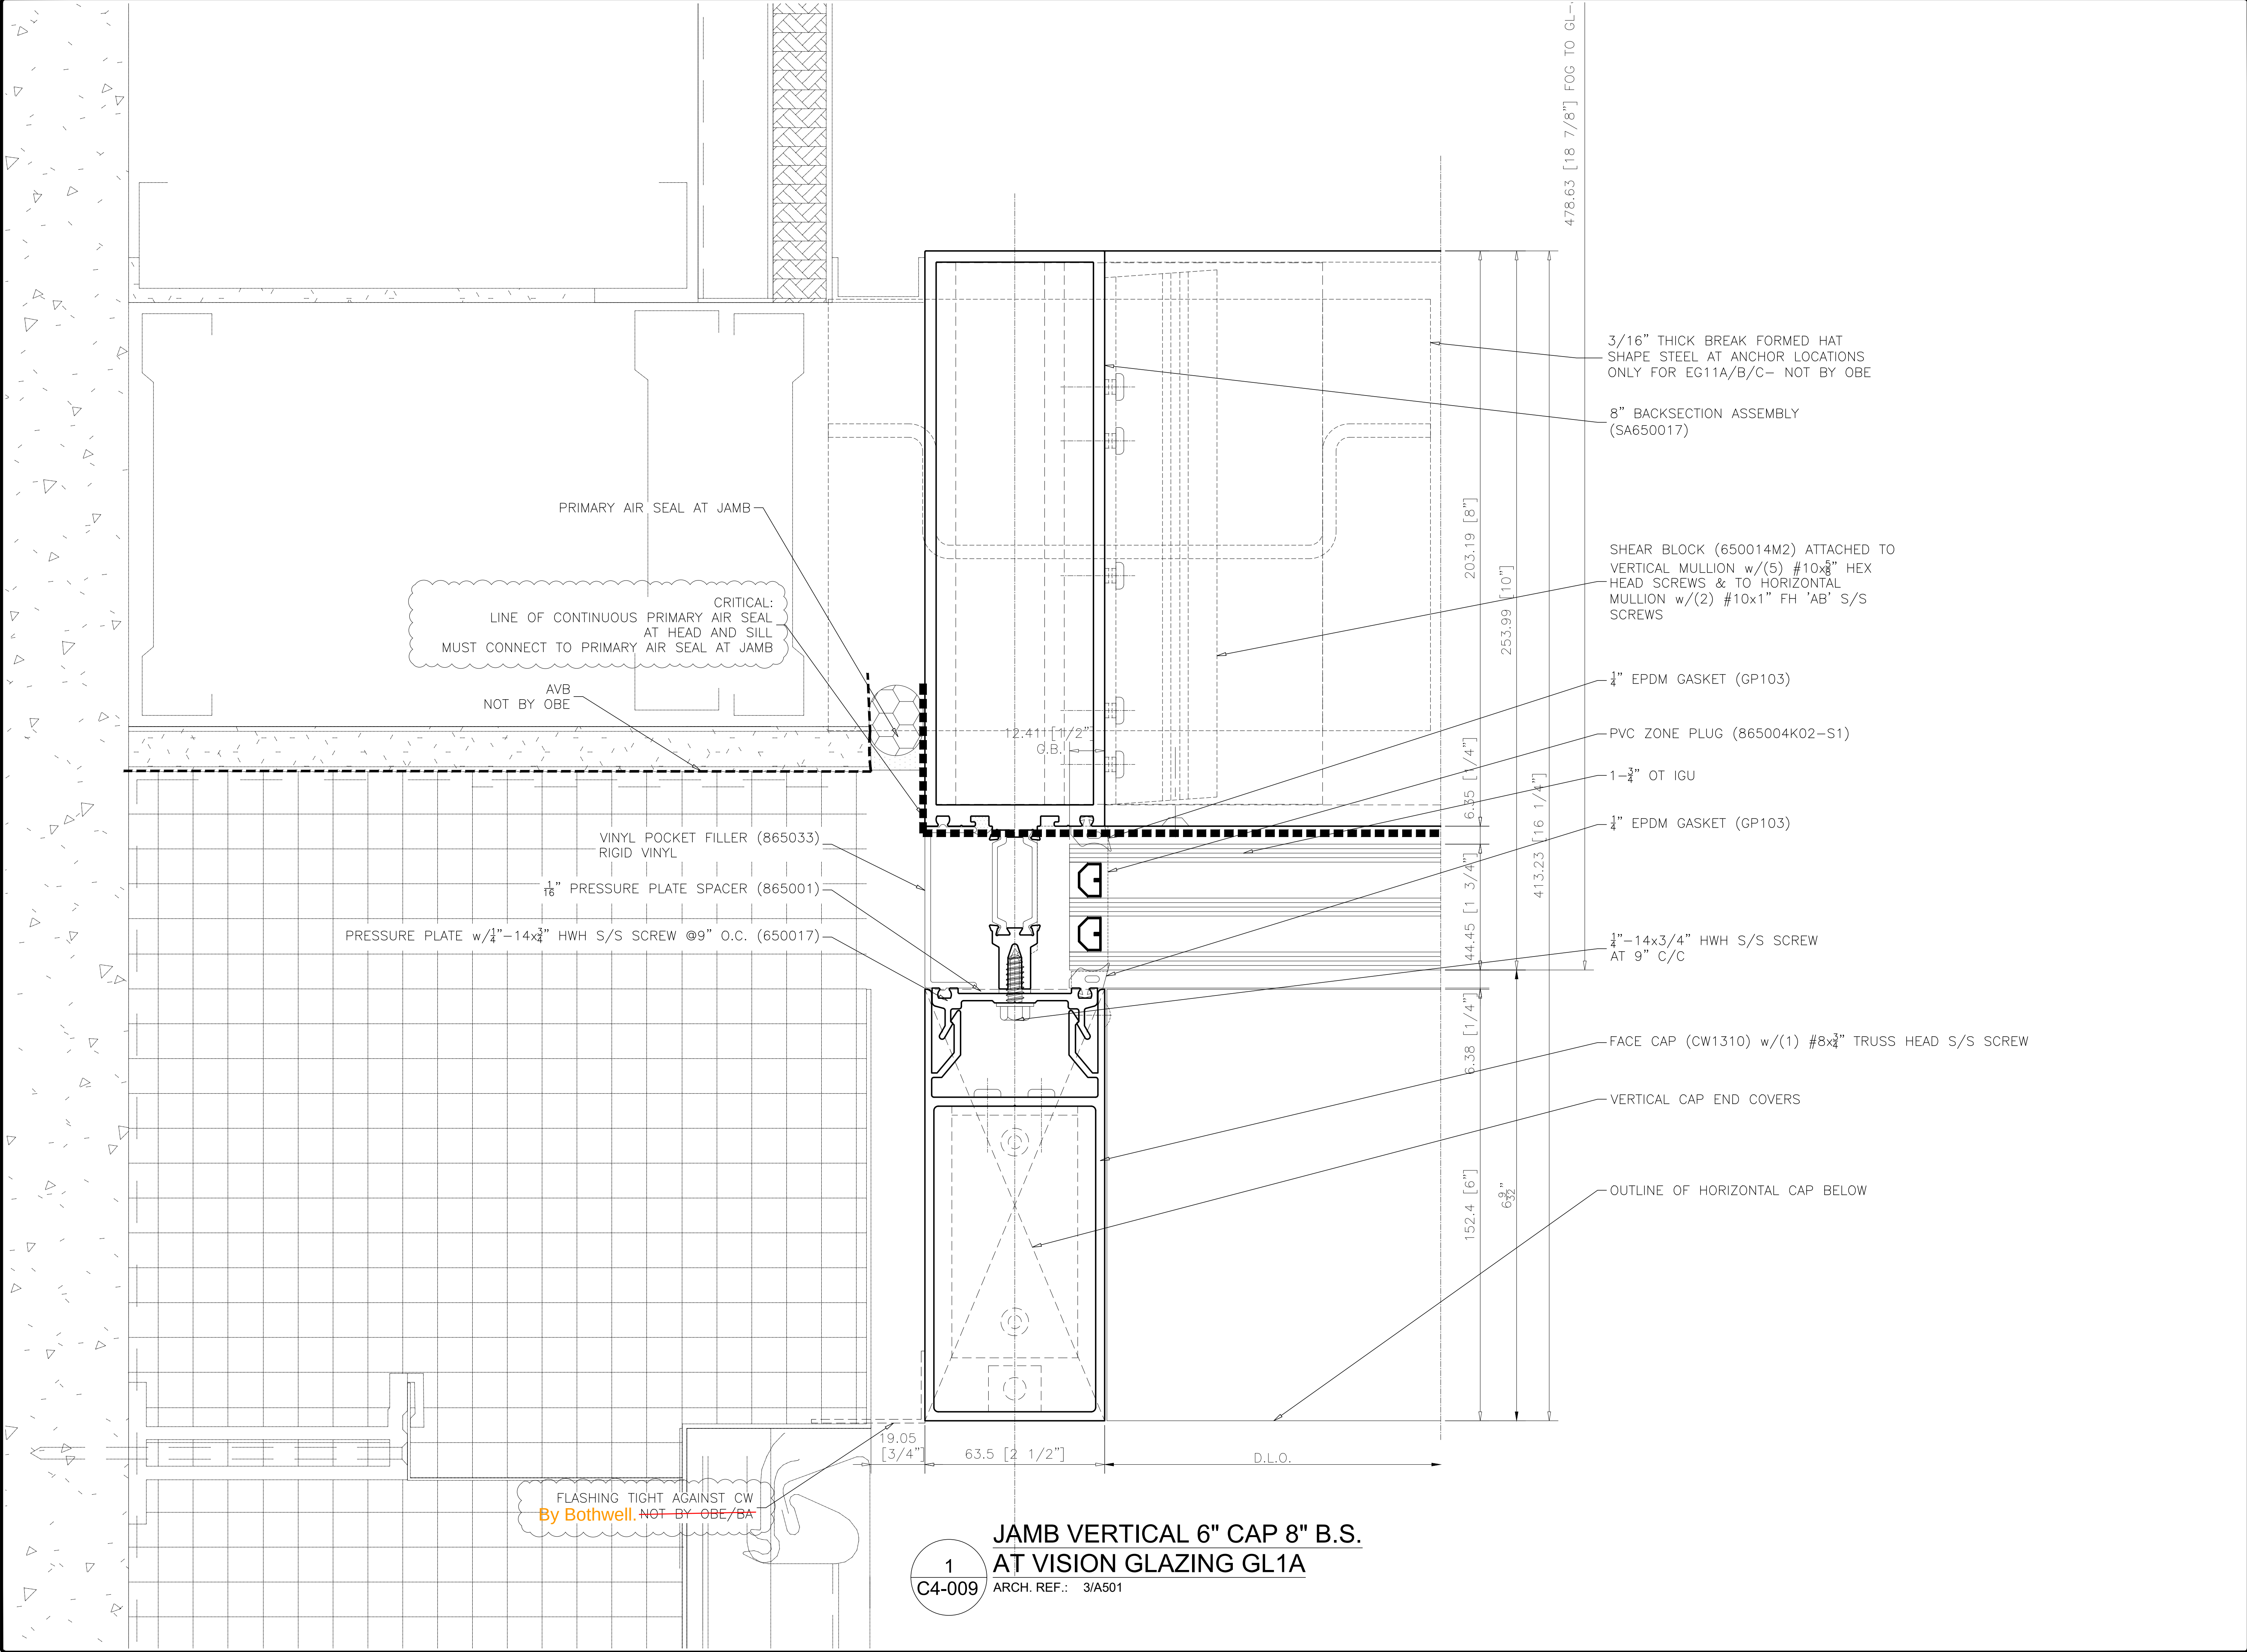

REVISIONS			
No.	Description:	Date:	By:
1	Revised per arch. markups received Feb 11/26	03/03/26	SLR

Project Name: DOCKSTEADER PRPS	Project Location: BRAMPTON, ONTARIO	Architect Name: DIAMOND SCHMITT ARCHITECTS	Customer Name: BOTHWELL ACCURATE GLAZING
-----------------------------------	--	---	---

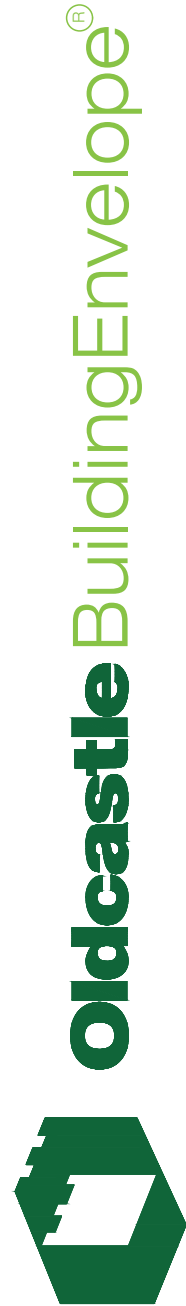


275 Britannia Road East • Mississauga • Ontario • Canada • L4Z2E7
905-890-6970 • oldcastlebe.com

Drawing Name:
PLAN DETAIL

Drawn By: SR	Checked By: NP
Drawn Date: 2026/01/12	Issue No.: 1
Scale: 1"=1'	Release Date: 2026/03/03

Drawing Number:
C4-009

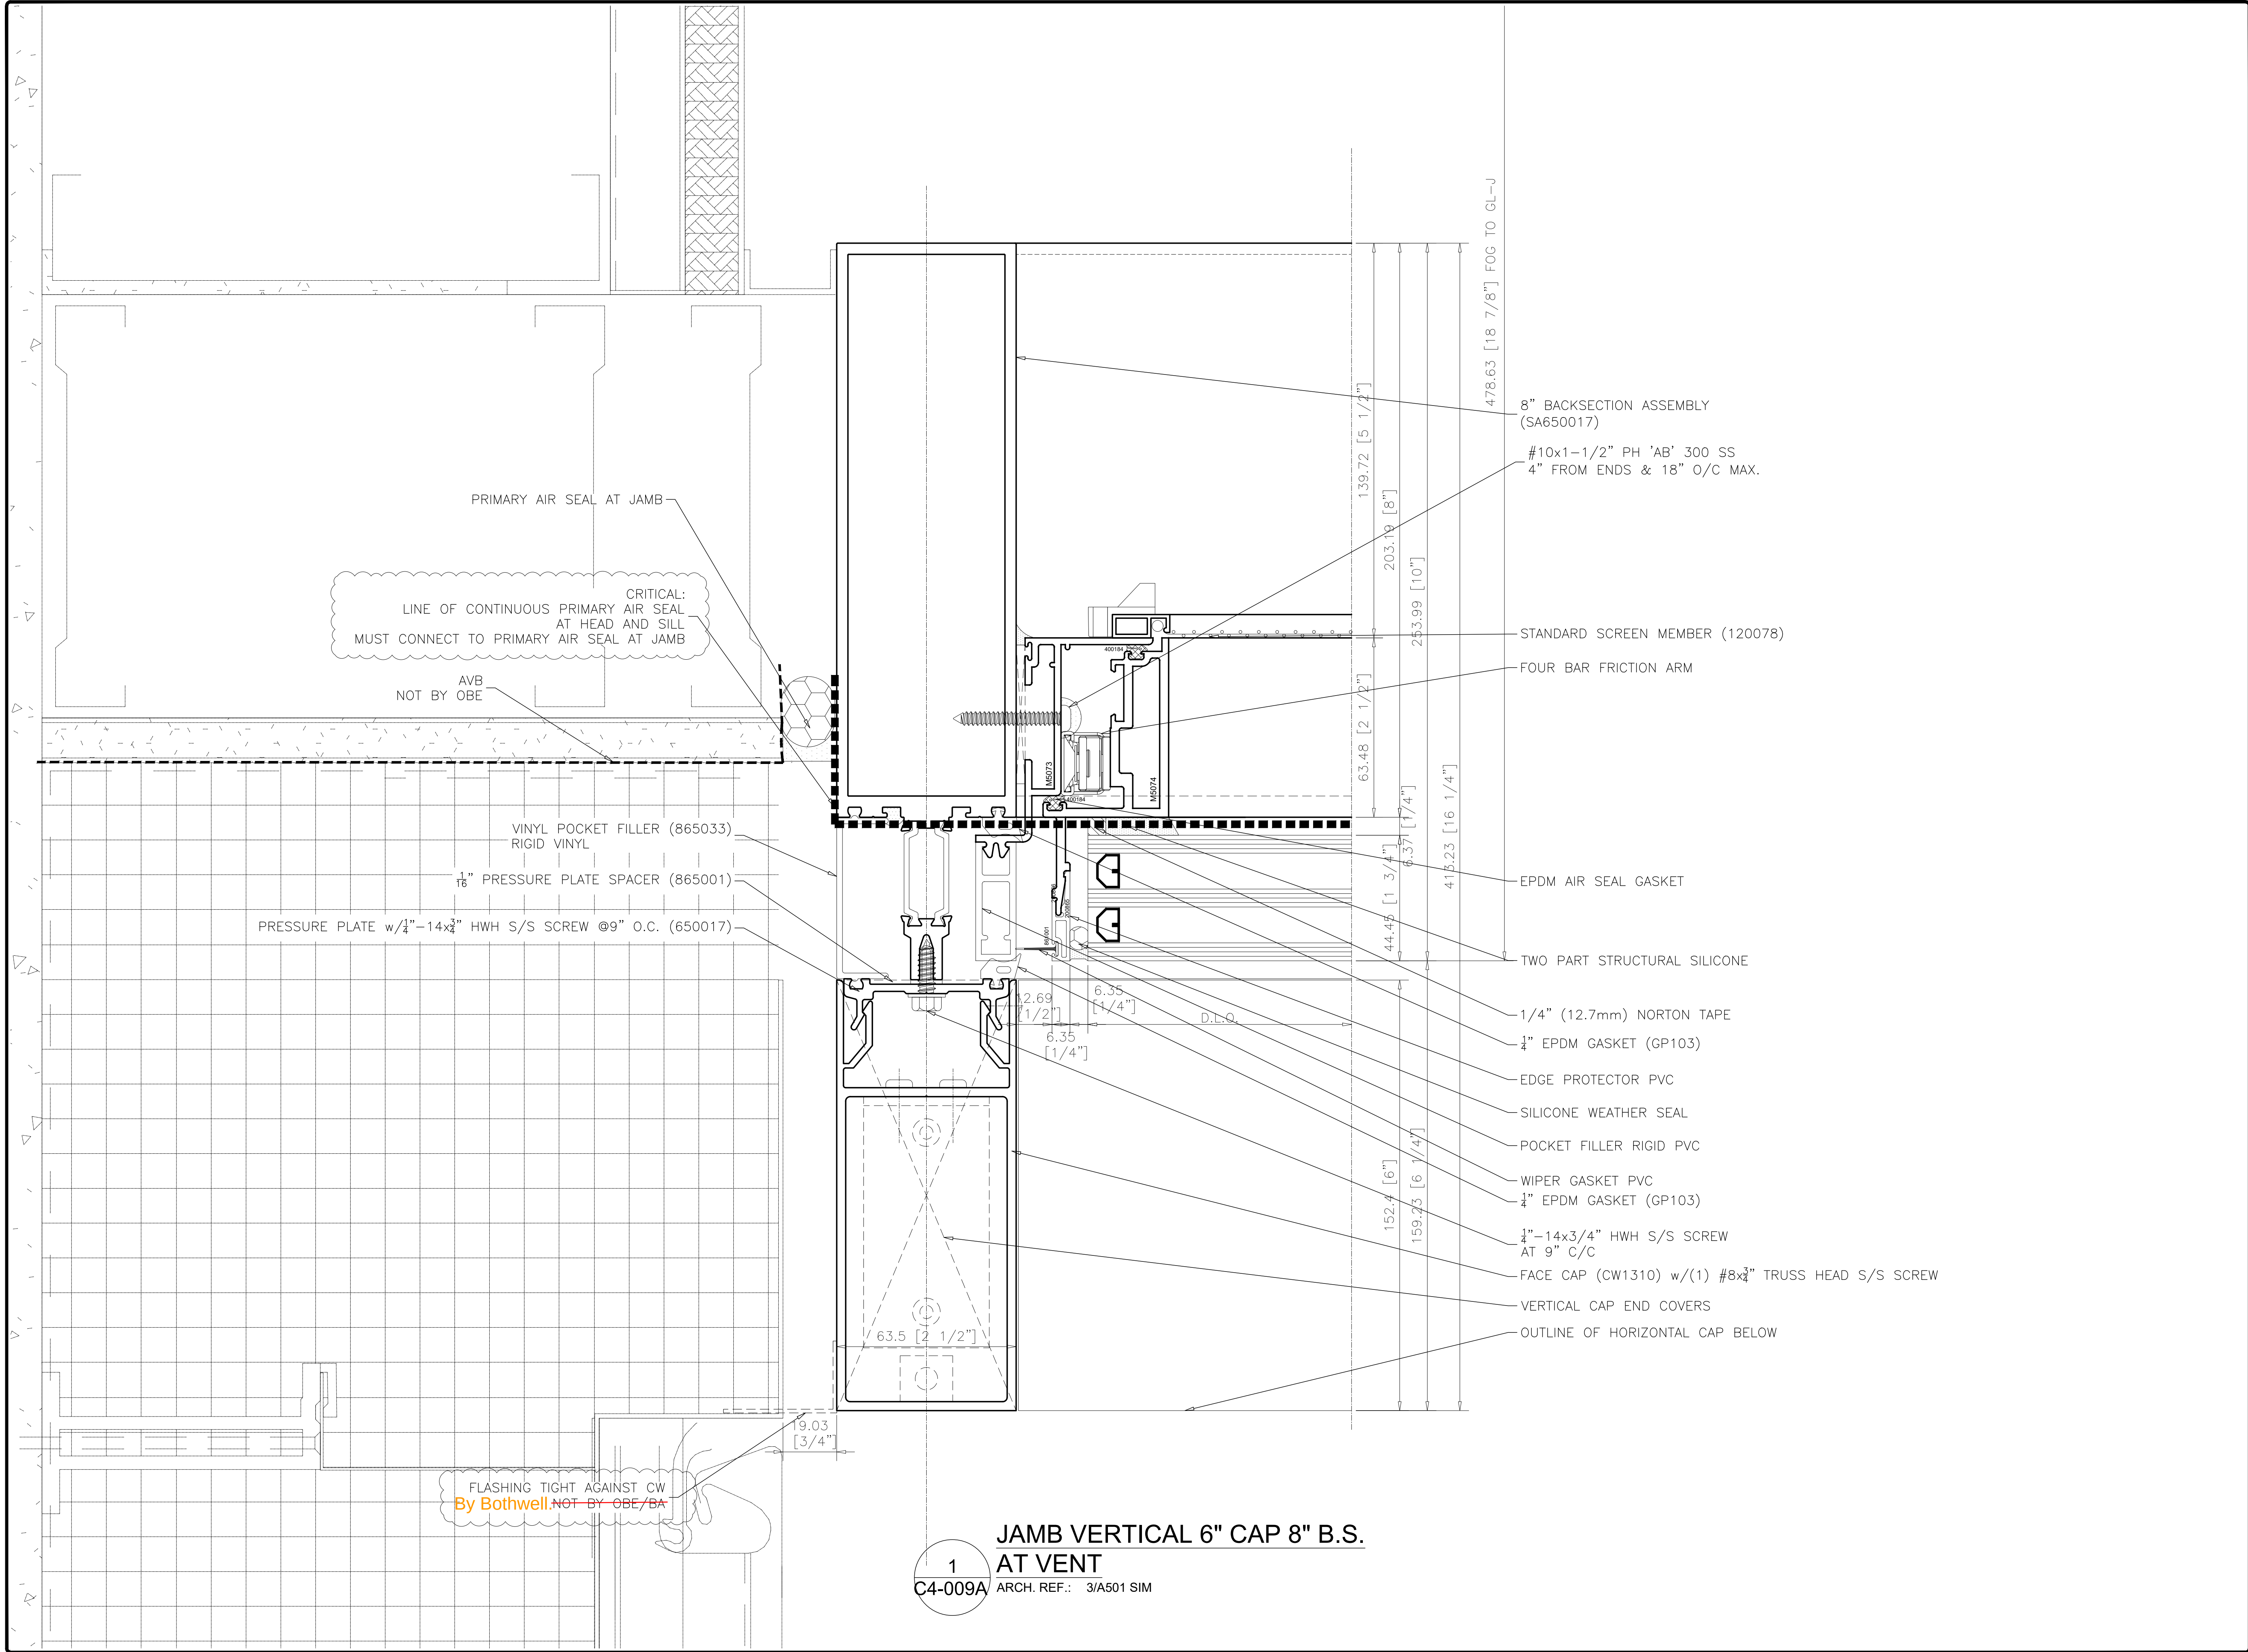


1
C4-009A

JAMB VERTICAL 6" CAP 8" B.S.
AT VENT

ARCH. REF.: 3/A501 SIM


REVISIONS			
No.	Description:	Date:	By:
1	Revised per arch. markups received Feb 11/26	03/03/26	SLR

Project Name: DOCKSTEADER PRPS	Project Location: BRAMPTON, ONTARIO	Architect Name: DIAMOND SCHMITT ARCHITECTS	Customer Name: BOTHWELL ACCURATE GLAZING
-----------------------------------	--	---	---

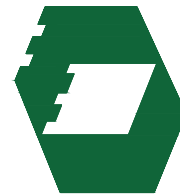**Oldcastle BuildingEnvelope**[®]

275 Britannia Road East • Mississauga • Ontario • Canada • L4Z2E7
905-890-6970 • oldcastlebe.com

Drawing Name: PLAN DETAIL	
Drawn By: SR	Checked By: NP
Drawn Date: 2026/01/12	Issue No.: 1
Scale: 1"=1"	Release Date: 2026/03/03
Drawing Number: C4-009A	

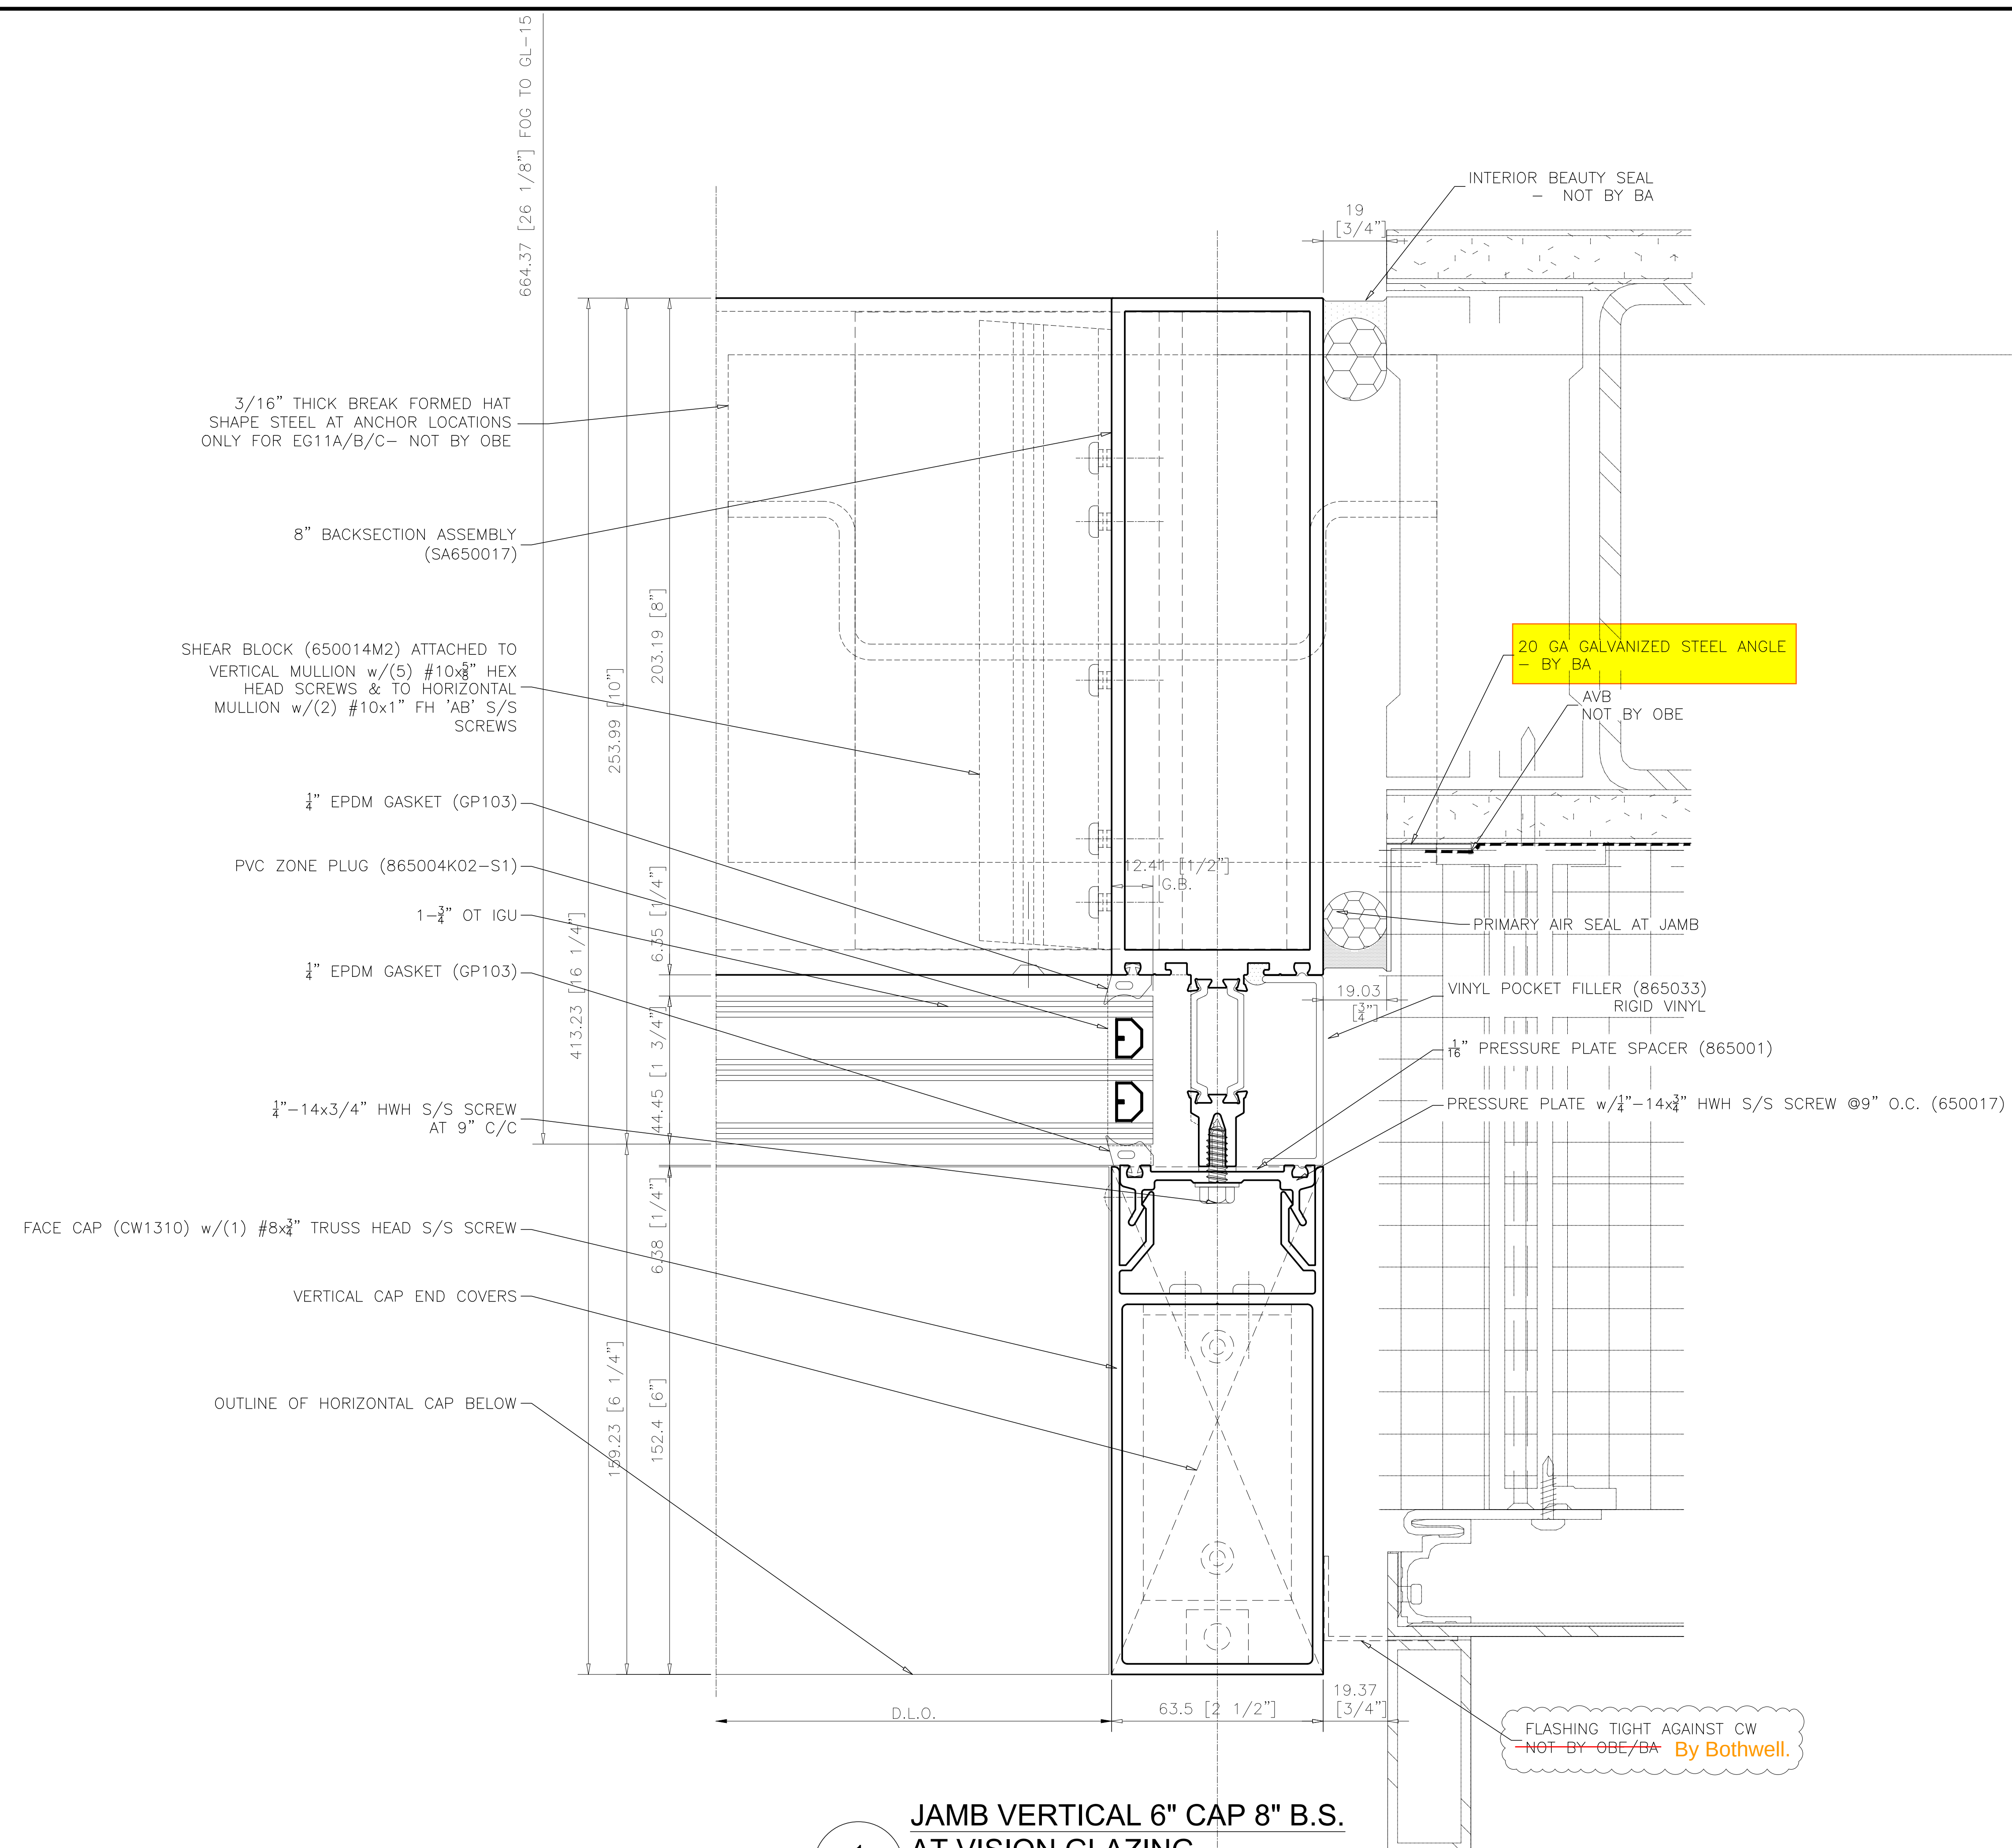

**JAMB VERTICAL 6" CAP 8" B.S.
AT VISION GLAZING**

1
C4-009B

ARCH. REF.: 10/A501

REVISIONS			
No.	Description:	Date:	By:
1	Revised per arch. markups received Feb 11/26	03/03/26	SLR

Project Name: DOCKSTEADER PRPS	Project Location: BRAMPTON, ONTARIO	Architect Name: DIAMOND SCHMITT ARCHITECTS	Customer Name: BOTHWELL ACCURATE GLAZING
-----------------------------------	--	---	---



275 Britannia Road East • Mississauga • Ontario • Canada • L4Z2E7
905-890-6970 • oldcastlebe.com

Drawing Name: PLAN DETAIL	
Drawn By: SR	Checked By: NP
Drawn Date: 2026/01/12	Issue No.: 1
Scale: 1"=1'	Release Date: 2026/03/03
Drawing Number: C4-009B	

REVISIONS			
No.	Description:	Date:	By:
1	Revised per arch. markups received Feb 11/26	03/03/26	SLR

Project Name: DOCKSTEADER PRPS	Project Location: BRAMPTON, ONTARIO	Architect Name: DIAMOND SCHMITT ARCHITECTS	Customer Name: BOTHWELL ACCURATE GLAZING
-----------------------------------	--	---	---




275 Britannia Road East • Mississauga • Ontario • Canada • L4Z2E7
905-890-6970 • oldcastlebe.com

Drawing Name:
PLAN DETAIL

Drawn By: SR	Checked By: NP
Drawn Date: 2026/01/12	Issue No.: 1
Scale: 1"=1'	Release Date: 2026/03/03


Drawing Number:
C4-009C

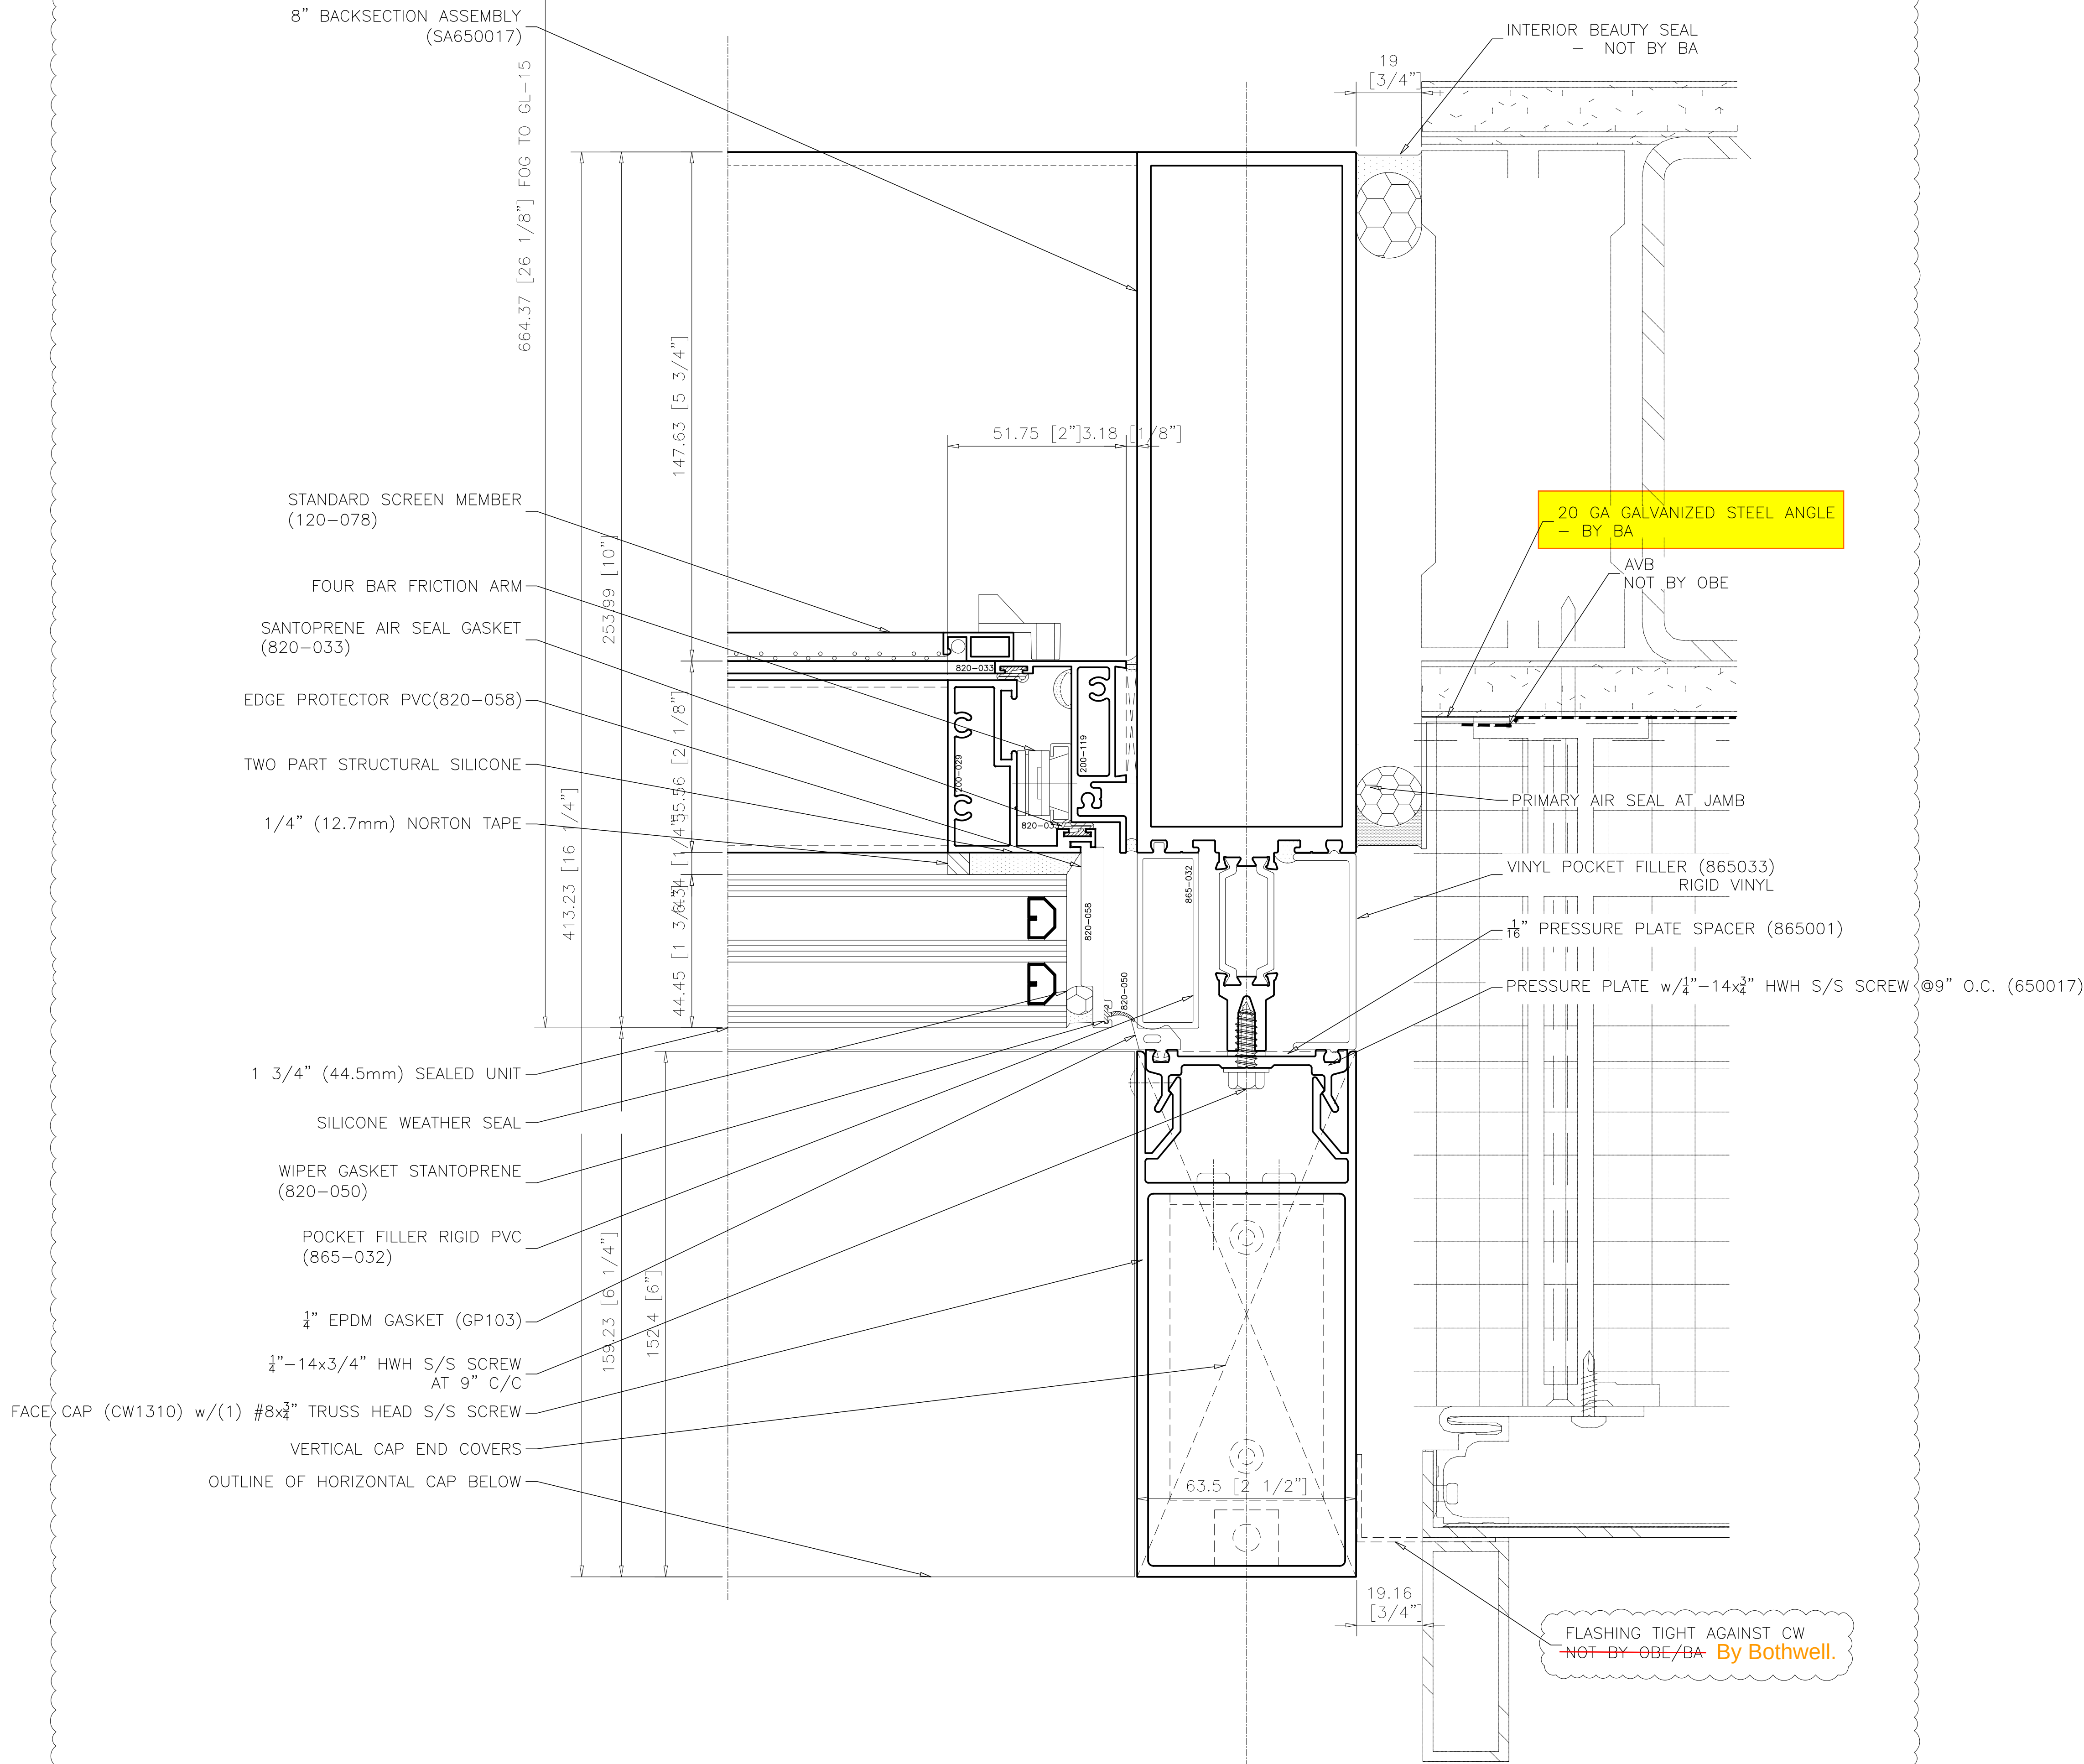

JAMB VERTICAL 6" CAP 8" B.S.

AT VENT


1
C4-009C ARCH. REF.: 10/A501 SIM

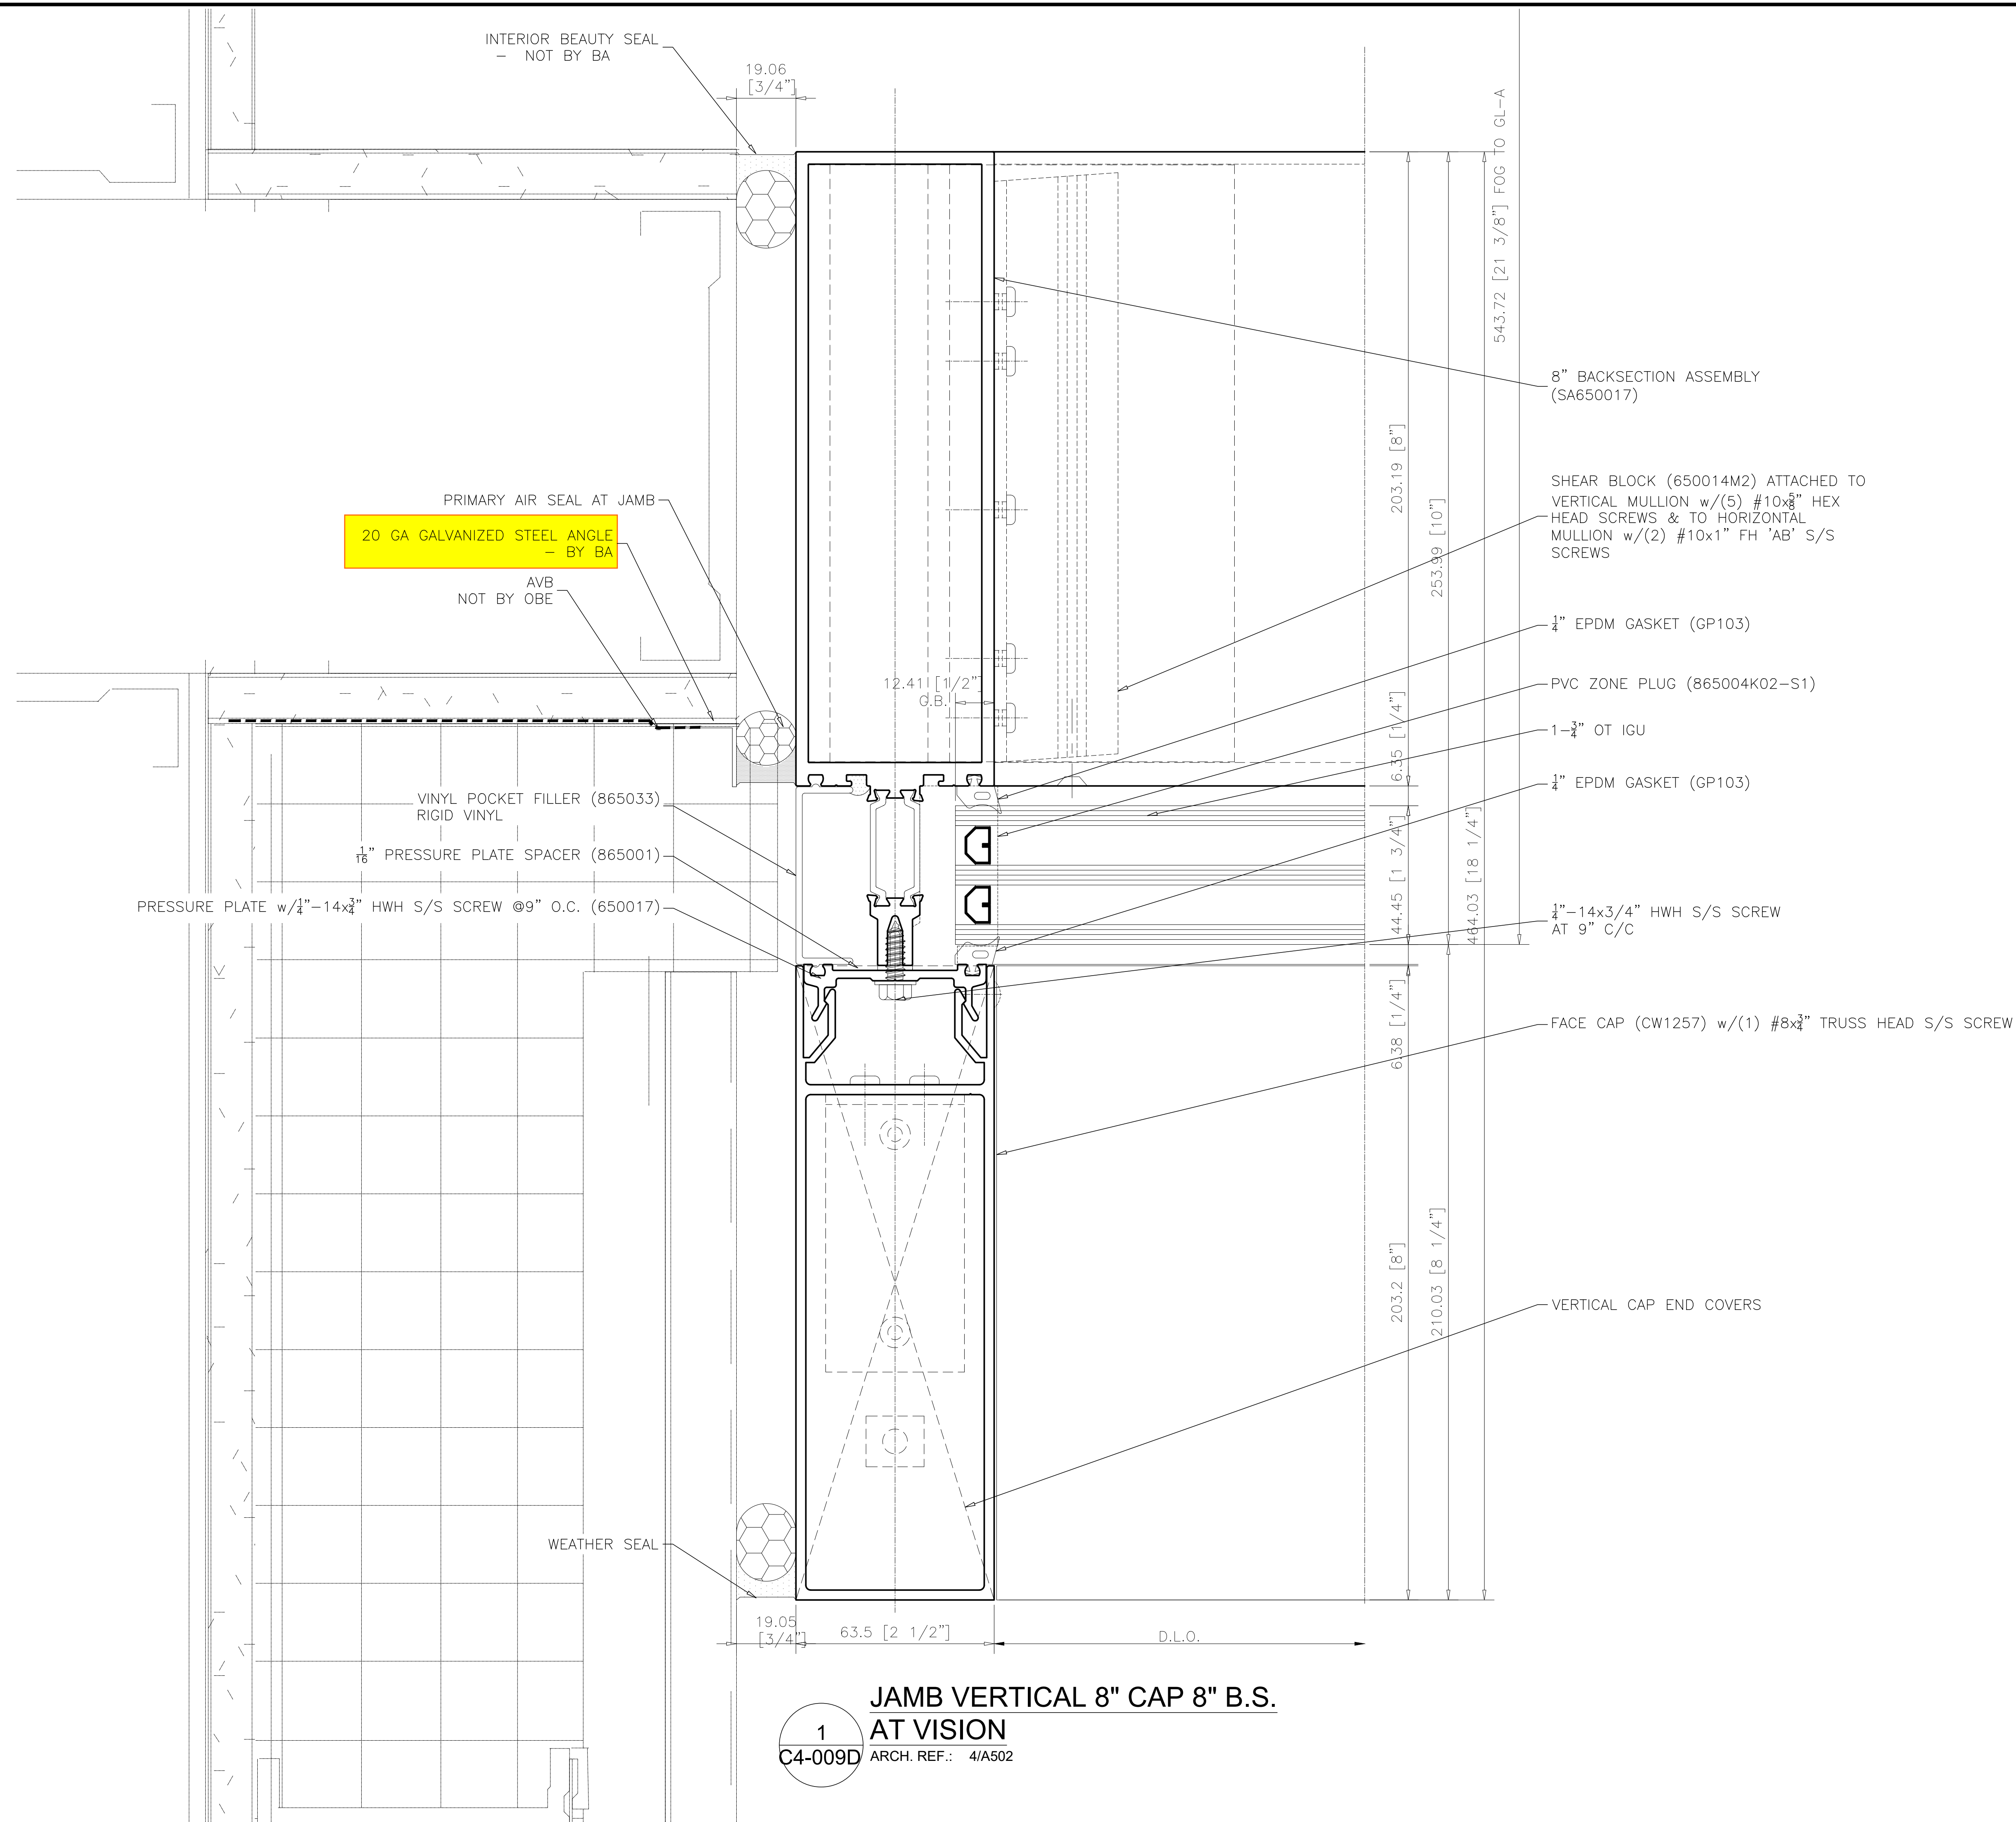

**JAMB VERTICAL 8" CAP 8" B.S.
AT VISION**
C4-009D ARCH. REF.: 4/A502

REVISIONS			
No.	Description:	Date:	By:
1	Revised per arch. markups received Feb 11/26	03/03/26	SLR

Project Name: DOCKSTEADER PRPS	Project Location: BRAMPTON, ONTARIO	Architect Name: DIAMOND SCHMITT ARCHITECTS	Customer Name: BOTHWELL ACCURATE GLAZING
-----------------------------------	--	---	---

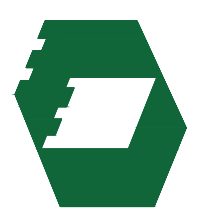**Oldcastle BuildingEnvelope®**

275 Britannia Road East • Mississauga • Ontario • Canada • L4Z2E7
905-890-6970 • oldcastlebe.com

Drawing Name: PLAN DETAIL	
Drawn By: SR	Checked By: NP
Drawn Date: 2026/01/12	Issue No.: 1
Scale: 1"=1'	Release Date: 2026/03/03
Drawing Number: C4-009D	