


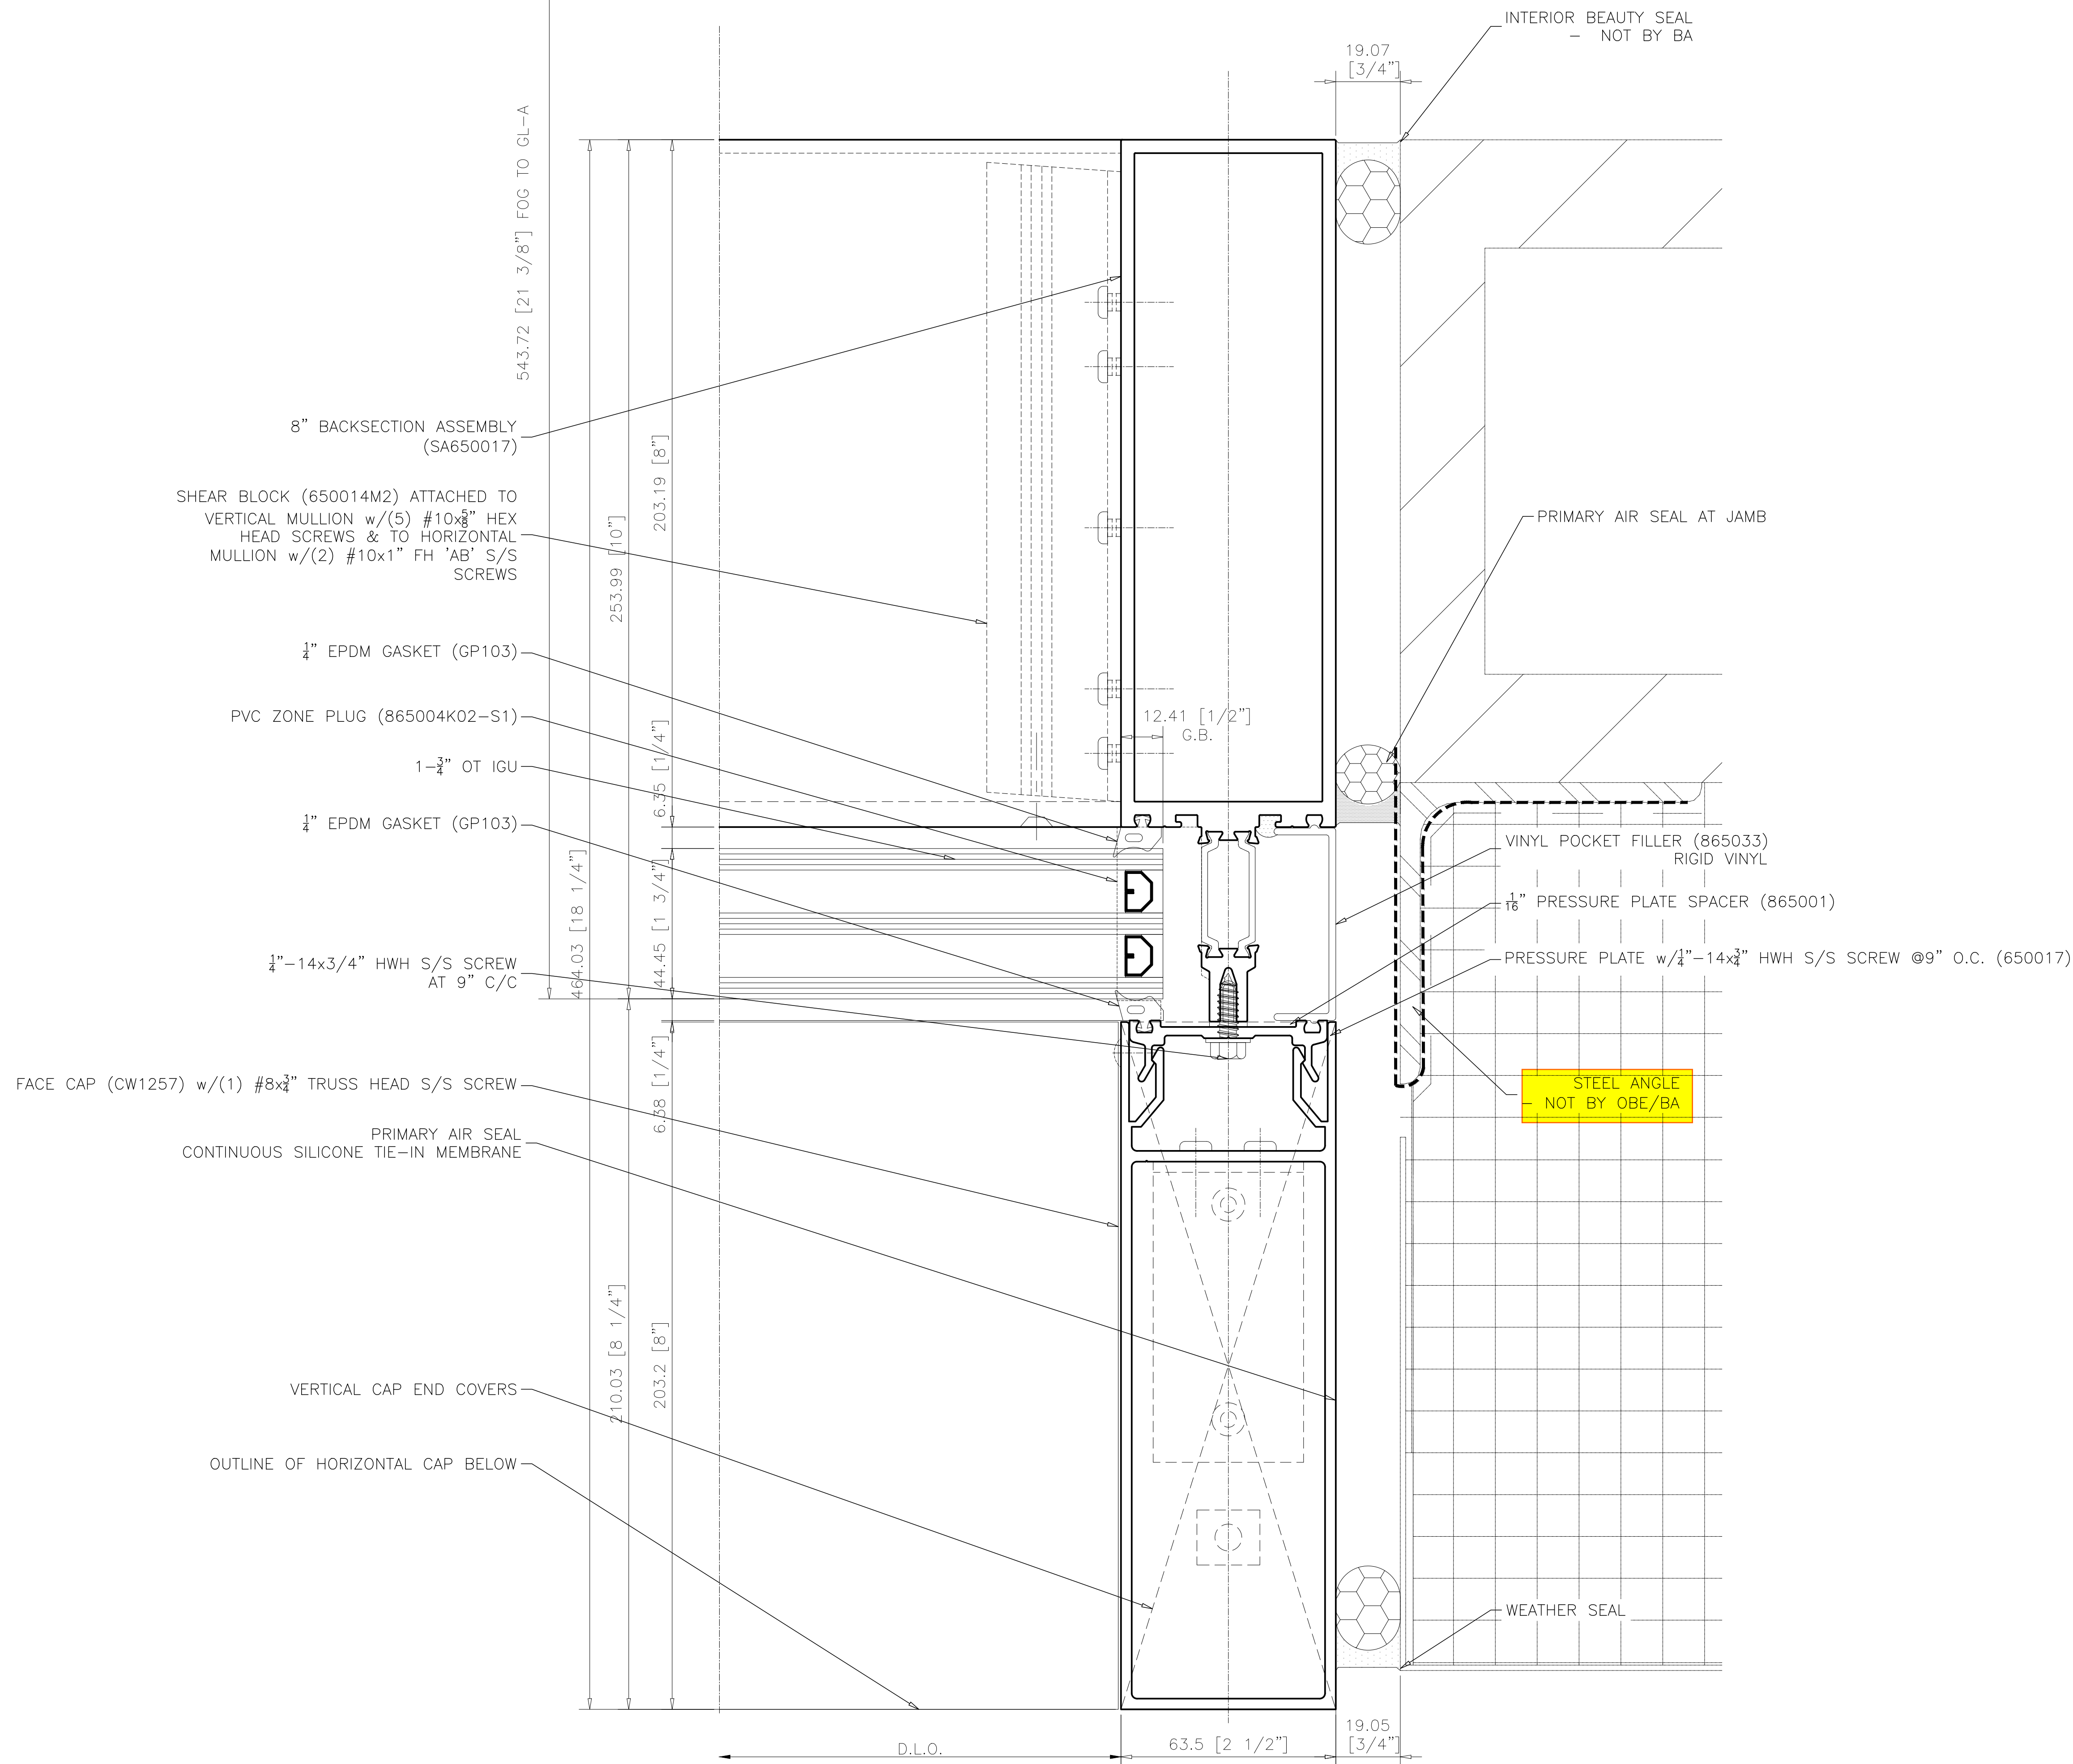


**JAMB VERTICAL 8" CAP 8" B.S.
AT VISION**

1
C4-009E

ARCH. REF.: 1/A561 SIM


REVISIONS			
No.	Description:	Date:	By:
1	Revised per arch. markups received Feb 11/26	03/03/26	SLR

Project Name: DOCKSTEADER PRPS	Project Location: BRAMPTON, ONTARIO	Architect Name: DIAMOND SCHMITT ARCHITECTS	Customer Name: BOTHWELL ACCURATE GLAZING
-----------------------------------	--	---	---

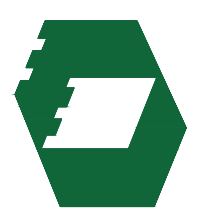**Oldcastle BuildingEnvelope®**

275 Britannia Road East • Mississauga • Ontario • Canada • L4Z2E7
905-890-6970 • oldcastlebe.com

Drawing Name: PLAN DETAIL	
Drawn By: SR	Checked By: NP
Drawn Date: 2026/01/12	Issue No.: 1
Scale: 1"=1"	Release Date: 2026/03/03
Drawing Number: C4-009E	

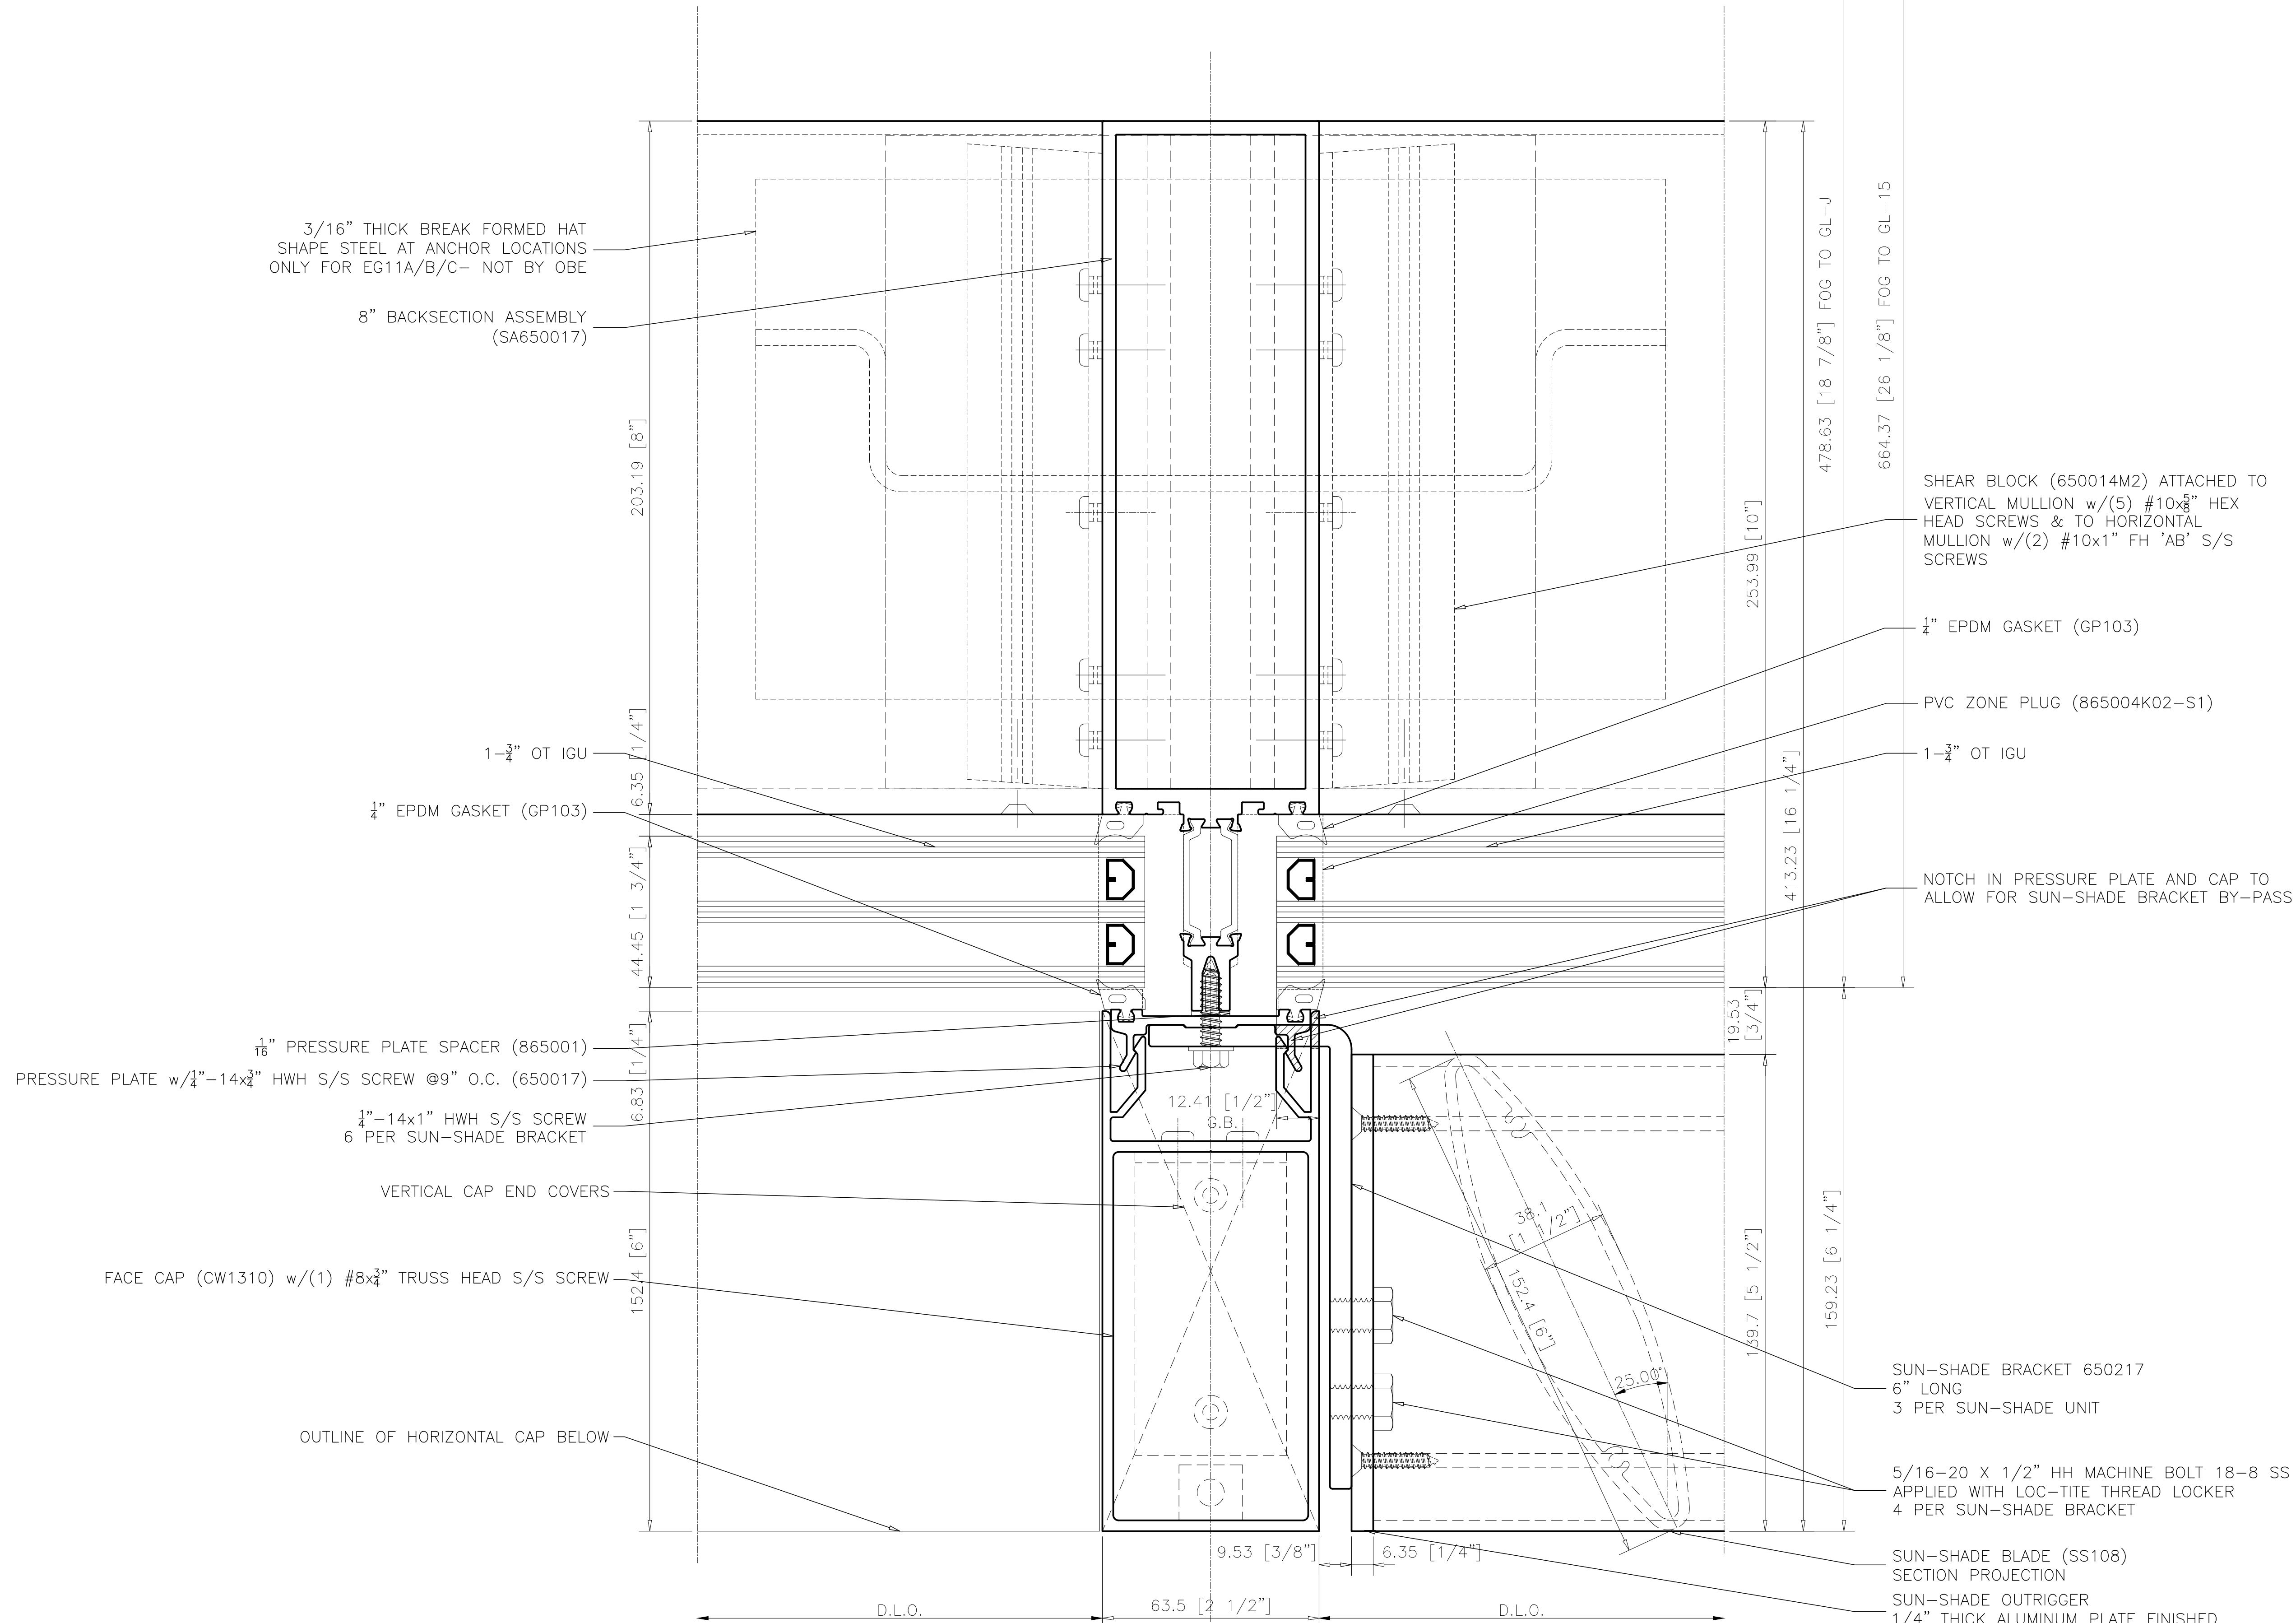


INT. VERTICAL 6" CAP 8" BS
AT VISION BESIDE VISION W/ SUNSHADE

1
C4-010

ARCH. REF.: N/A


REVISIONS			
No.	Description:	Date:	By:
1	Revised per arch. markups received Feb 11/26	03/03/26	SLR

Project Name: DOCKSTEADER PRPS	Project Location: BRAMPTON, ONTARIO	Architect Name: DIAMOND SCHMITT ARCHITECTS	Customer Name: BOTHWELL ACCURATE GLAZING
-----------------------------------	--	---	---

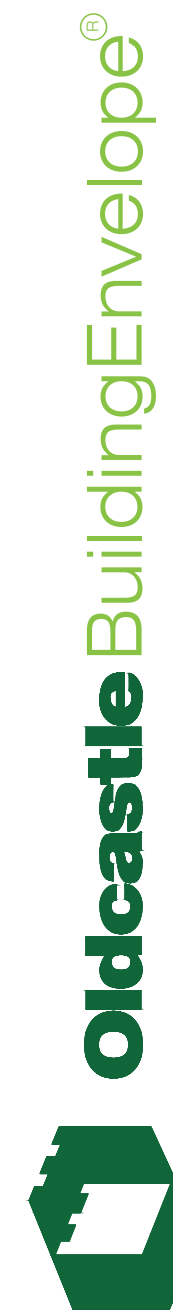

275 Britannia Road East • Mississauga • Ontario • Canada • L4Z2E7
905-890-6970 • oldcastlebe.com

Drawing Name: PLAN DETAIL	
Drawn By: SR	Checked By: NP
Drawn Date: 2026/01/12	Issue No.: 1
Scale: 1"=1"	Release Date: 2026/03/03
Drawing Number: C4-010	

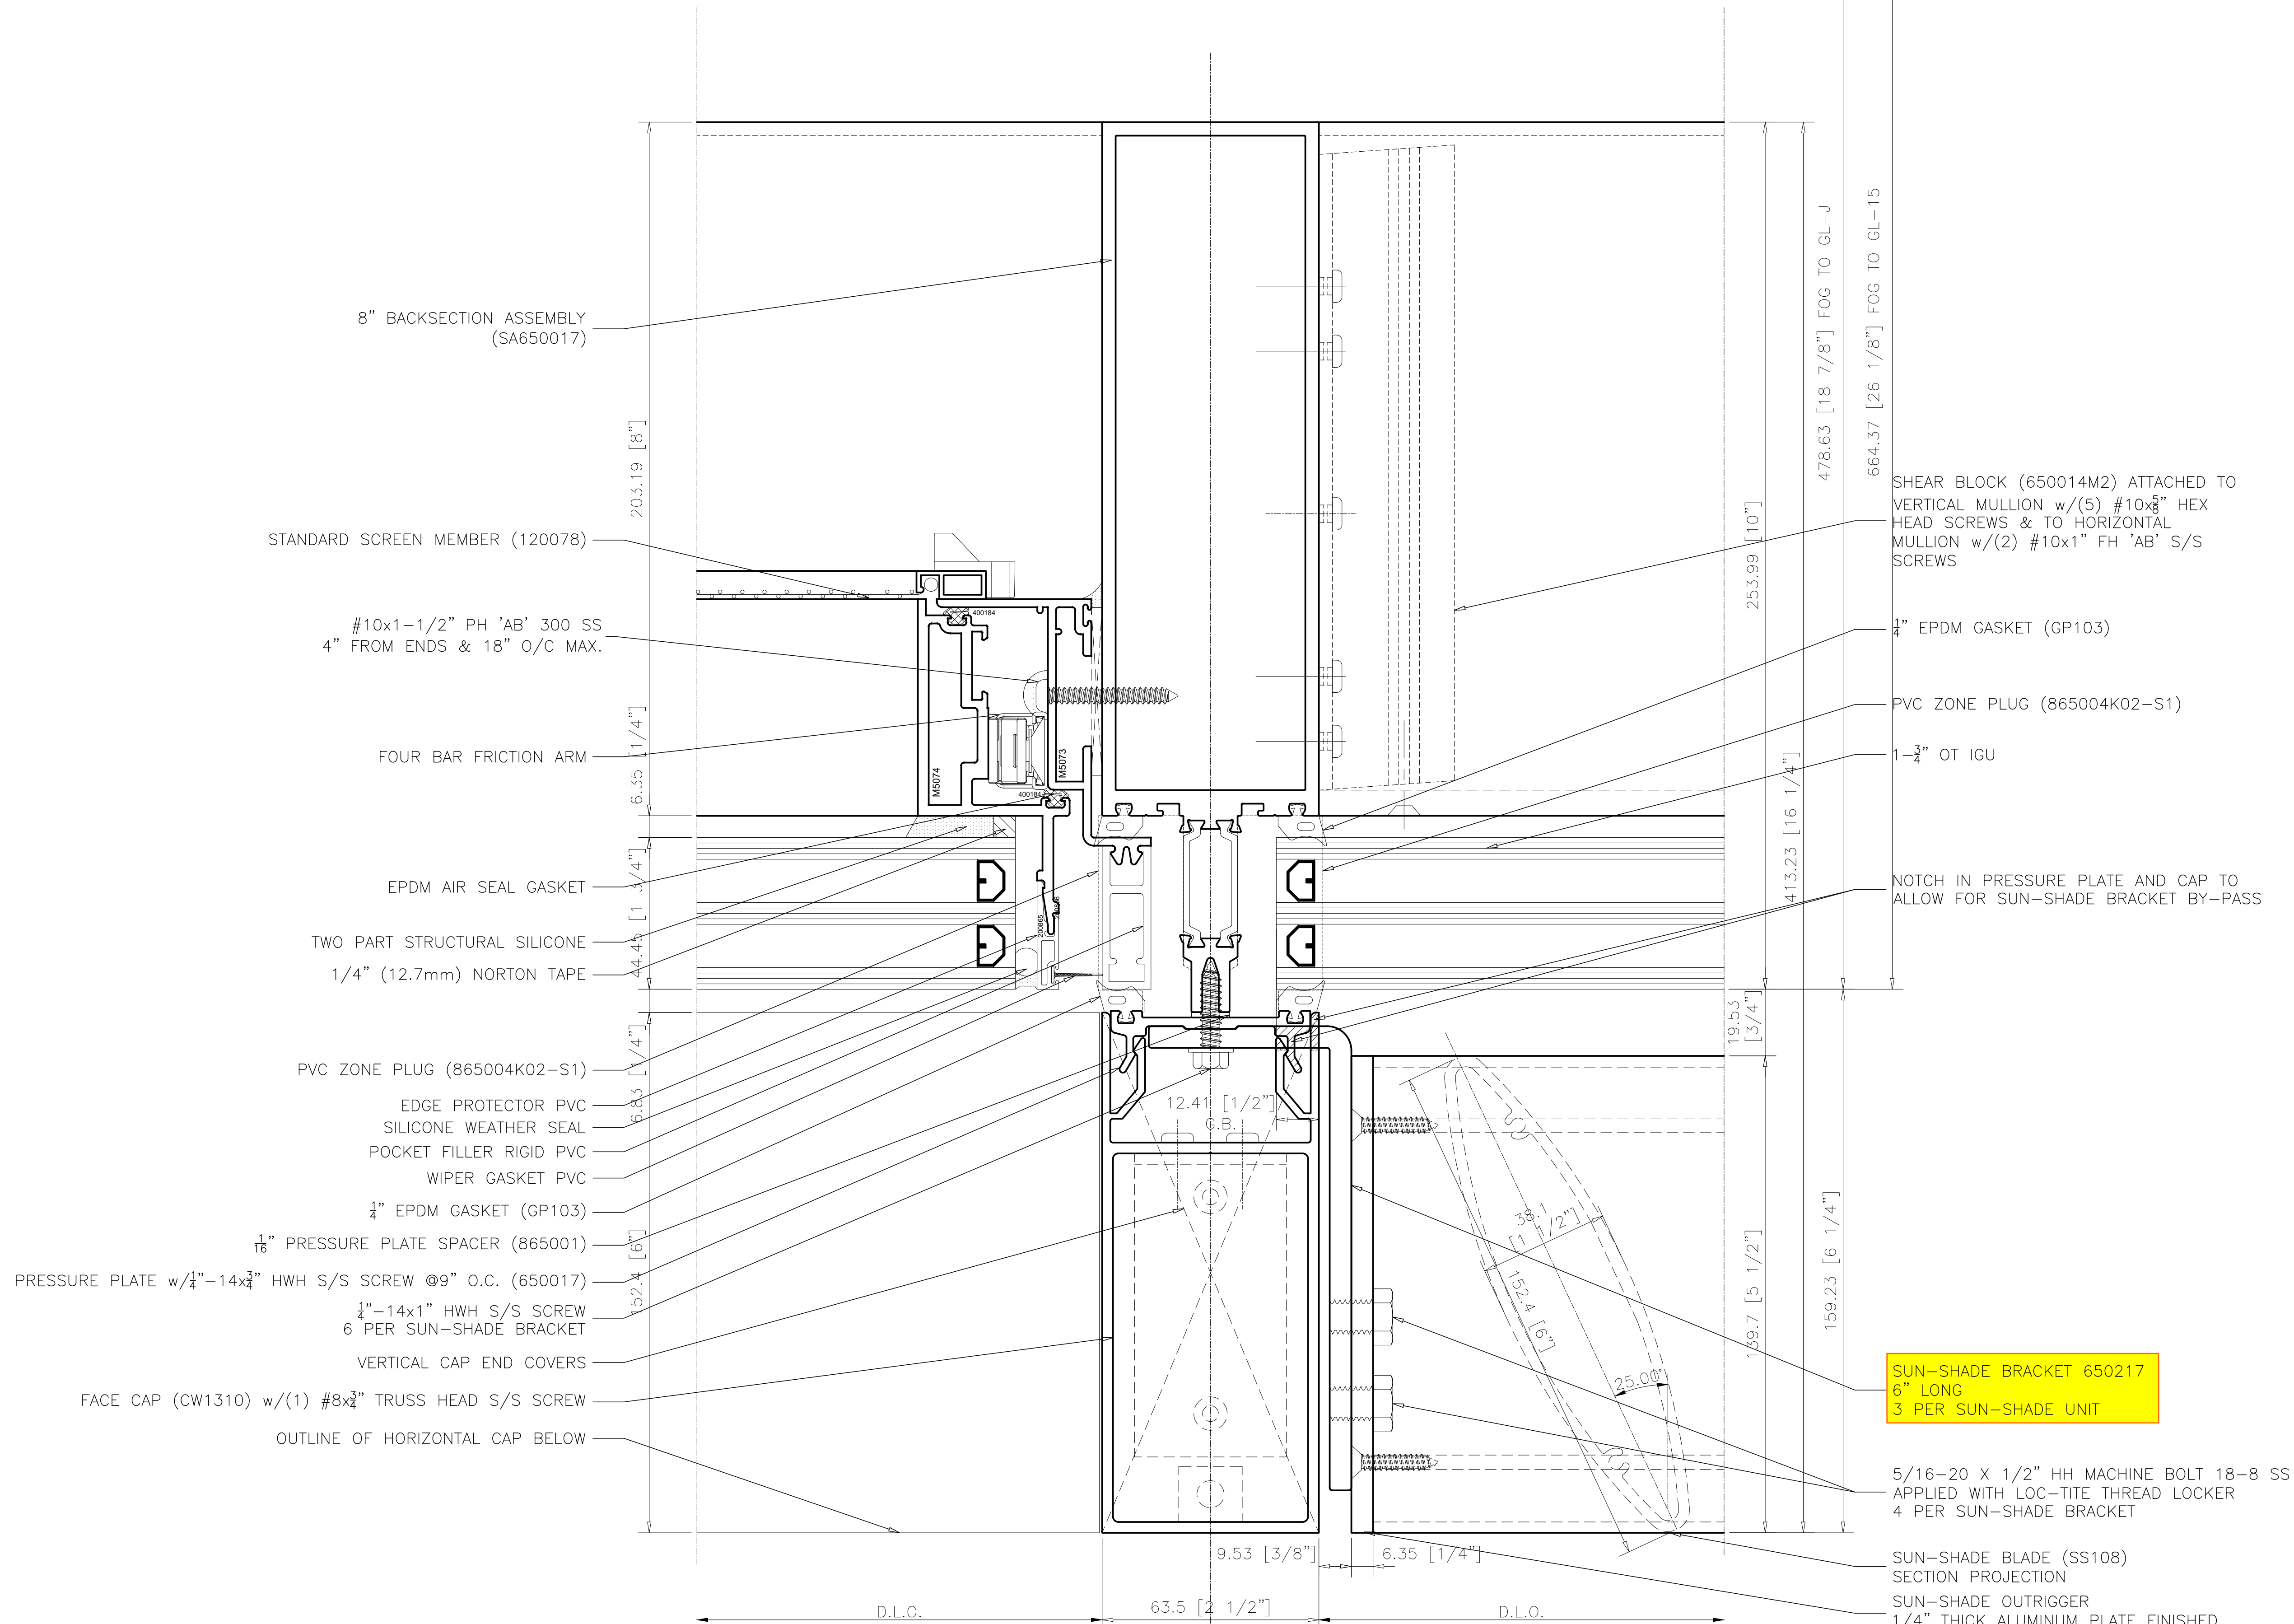

1
C4-010A

INT. VERTICAL 6" CAP 8" BS
AT VENT BESIDE VISION W/ SUNSHADE

ARCH. REF.: N/A


REVISIONS			
No.	Description:	Date:	By:
1	Revised per arch. markups received Feb 11/26	03/03/26	SLR

Project Name: DOCKSTEADER PRPS	Project Location: BRAMPTON, ONTARIO	Architect Name: DIAMOND SCHMITT ARCHITECTS	Customer Name: BOTHWELL ACCURATE GLAZING
-----------------------------------	--	---	---



275 Britannia Road East • Mississauga • Ontario • Canada • L4Z2E7
905-890-6970 • oldcastlebe.com

Drawing Name: PLAN DETAIL	
Drawn By: SR	Checked By: NP
Drawn Date: 2026/01/12	Issue No.: 1
Scale: 1"=1'	Release Date: 2026/03/03
Drawing Number: C4-010A	

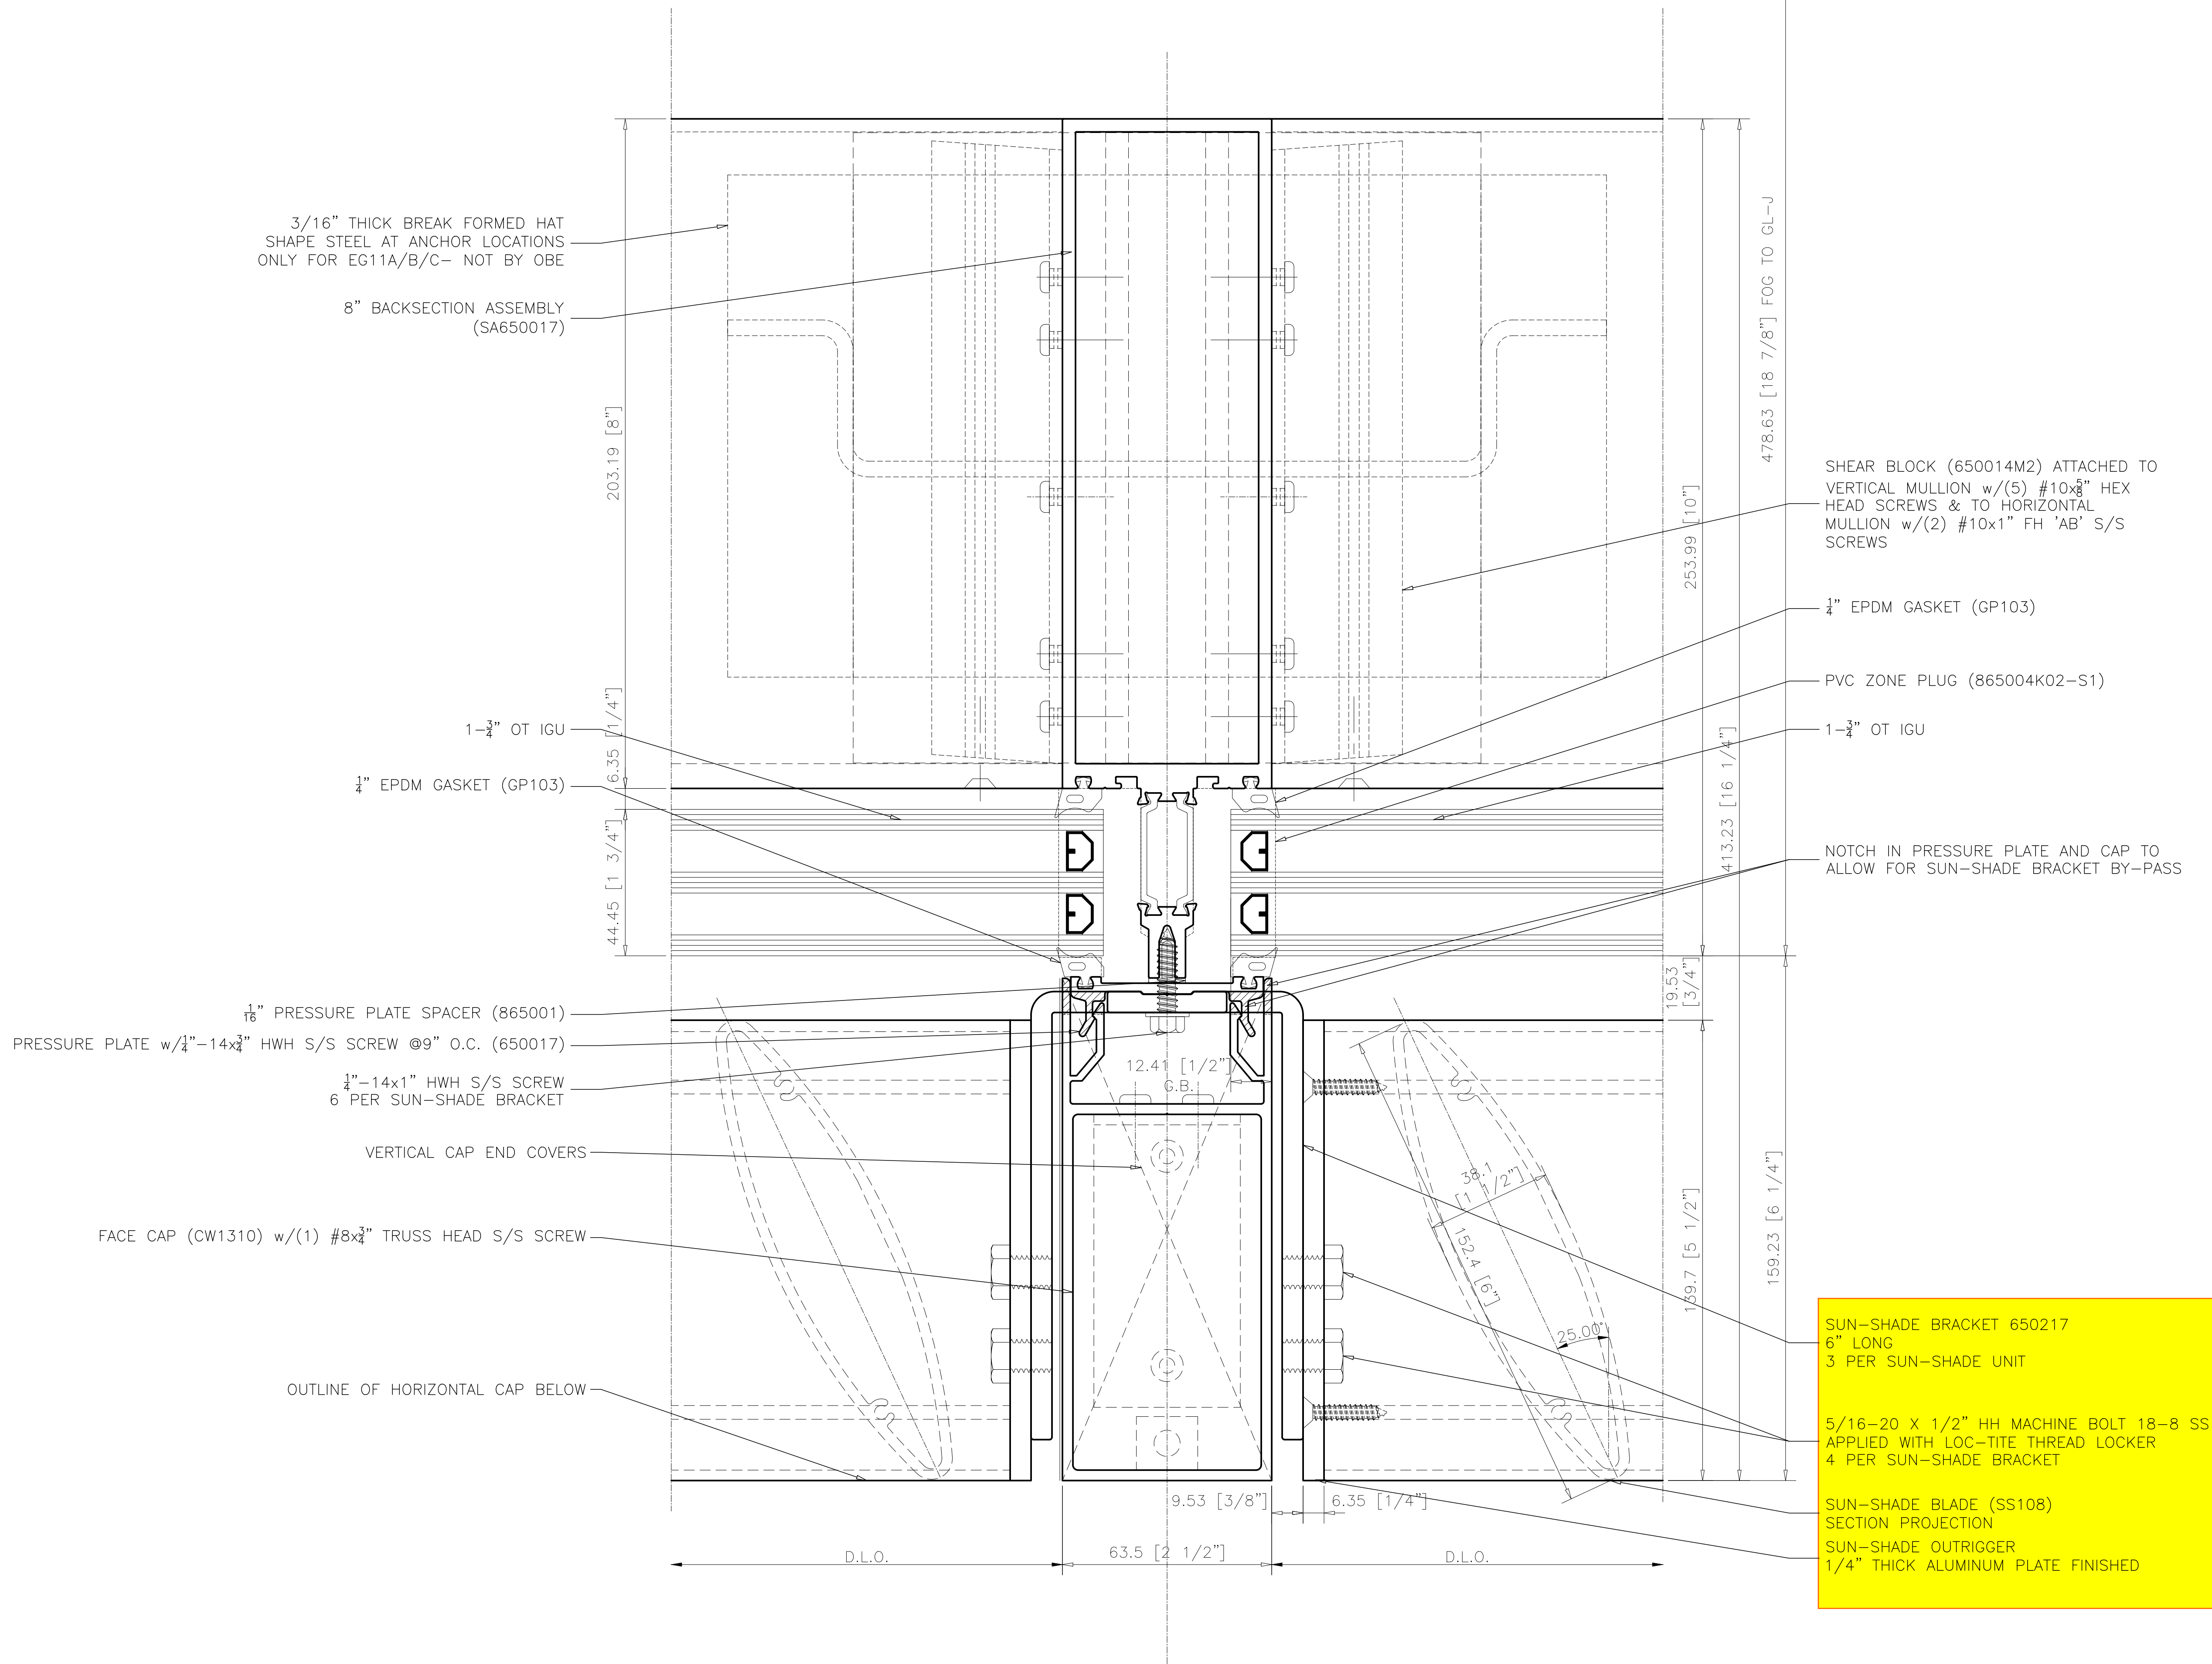

1
C4-010B

INT. VERTICAL 6" CAP 8" BS
AT VISION BESIDE VISION W/ SUNSHADE

ARCH. REF.: N/A


REVISIONS			
No.	Description:	Date:	By:
1	Revised per arch. markups received Feb 11/26	03/03/26	SLR

Project Name: DOCKSTEADER PRPS	Project Location: BRAMPTON, ONTARIO	Architect Name: DIAMOND SCHMITT ARCHITECTS	Customer Name: BOTHWELL ACCURATE GLAZING
-----------------------------------	--	---	---



275 Britannia Road East • Mississauga • Ontario • Canada • L4Z2E7
905-890-6970 • oldcastlebe.com

Drawing Name: PLAN DETAIL	
Drawn By: SR	Checked By: NP
Drawn Date: 2026/01/12	Issue No.: 1
Scale: 1"=1'	Release Date: 2026/03/03
Drawing Number: C4-010B	

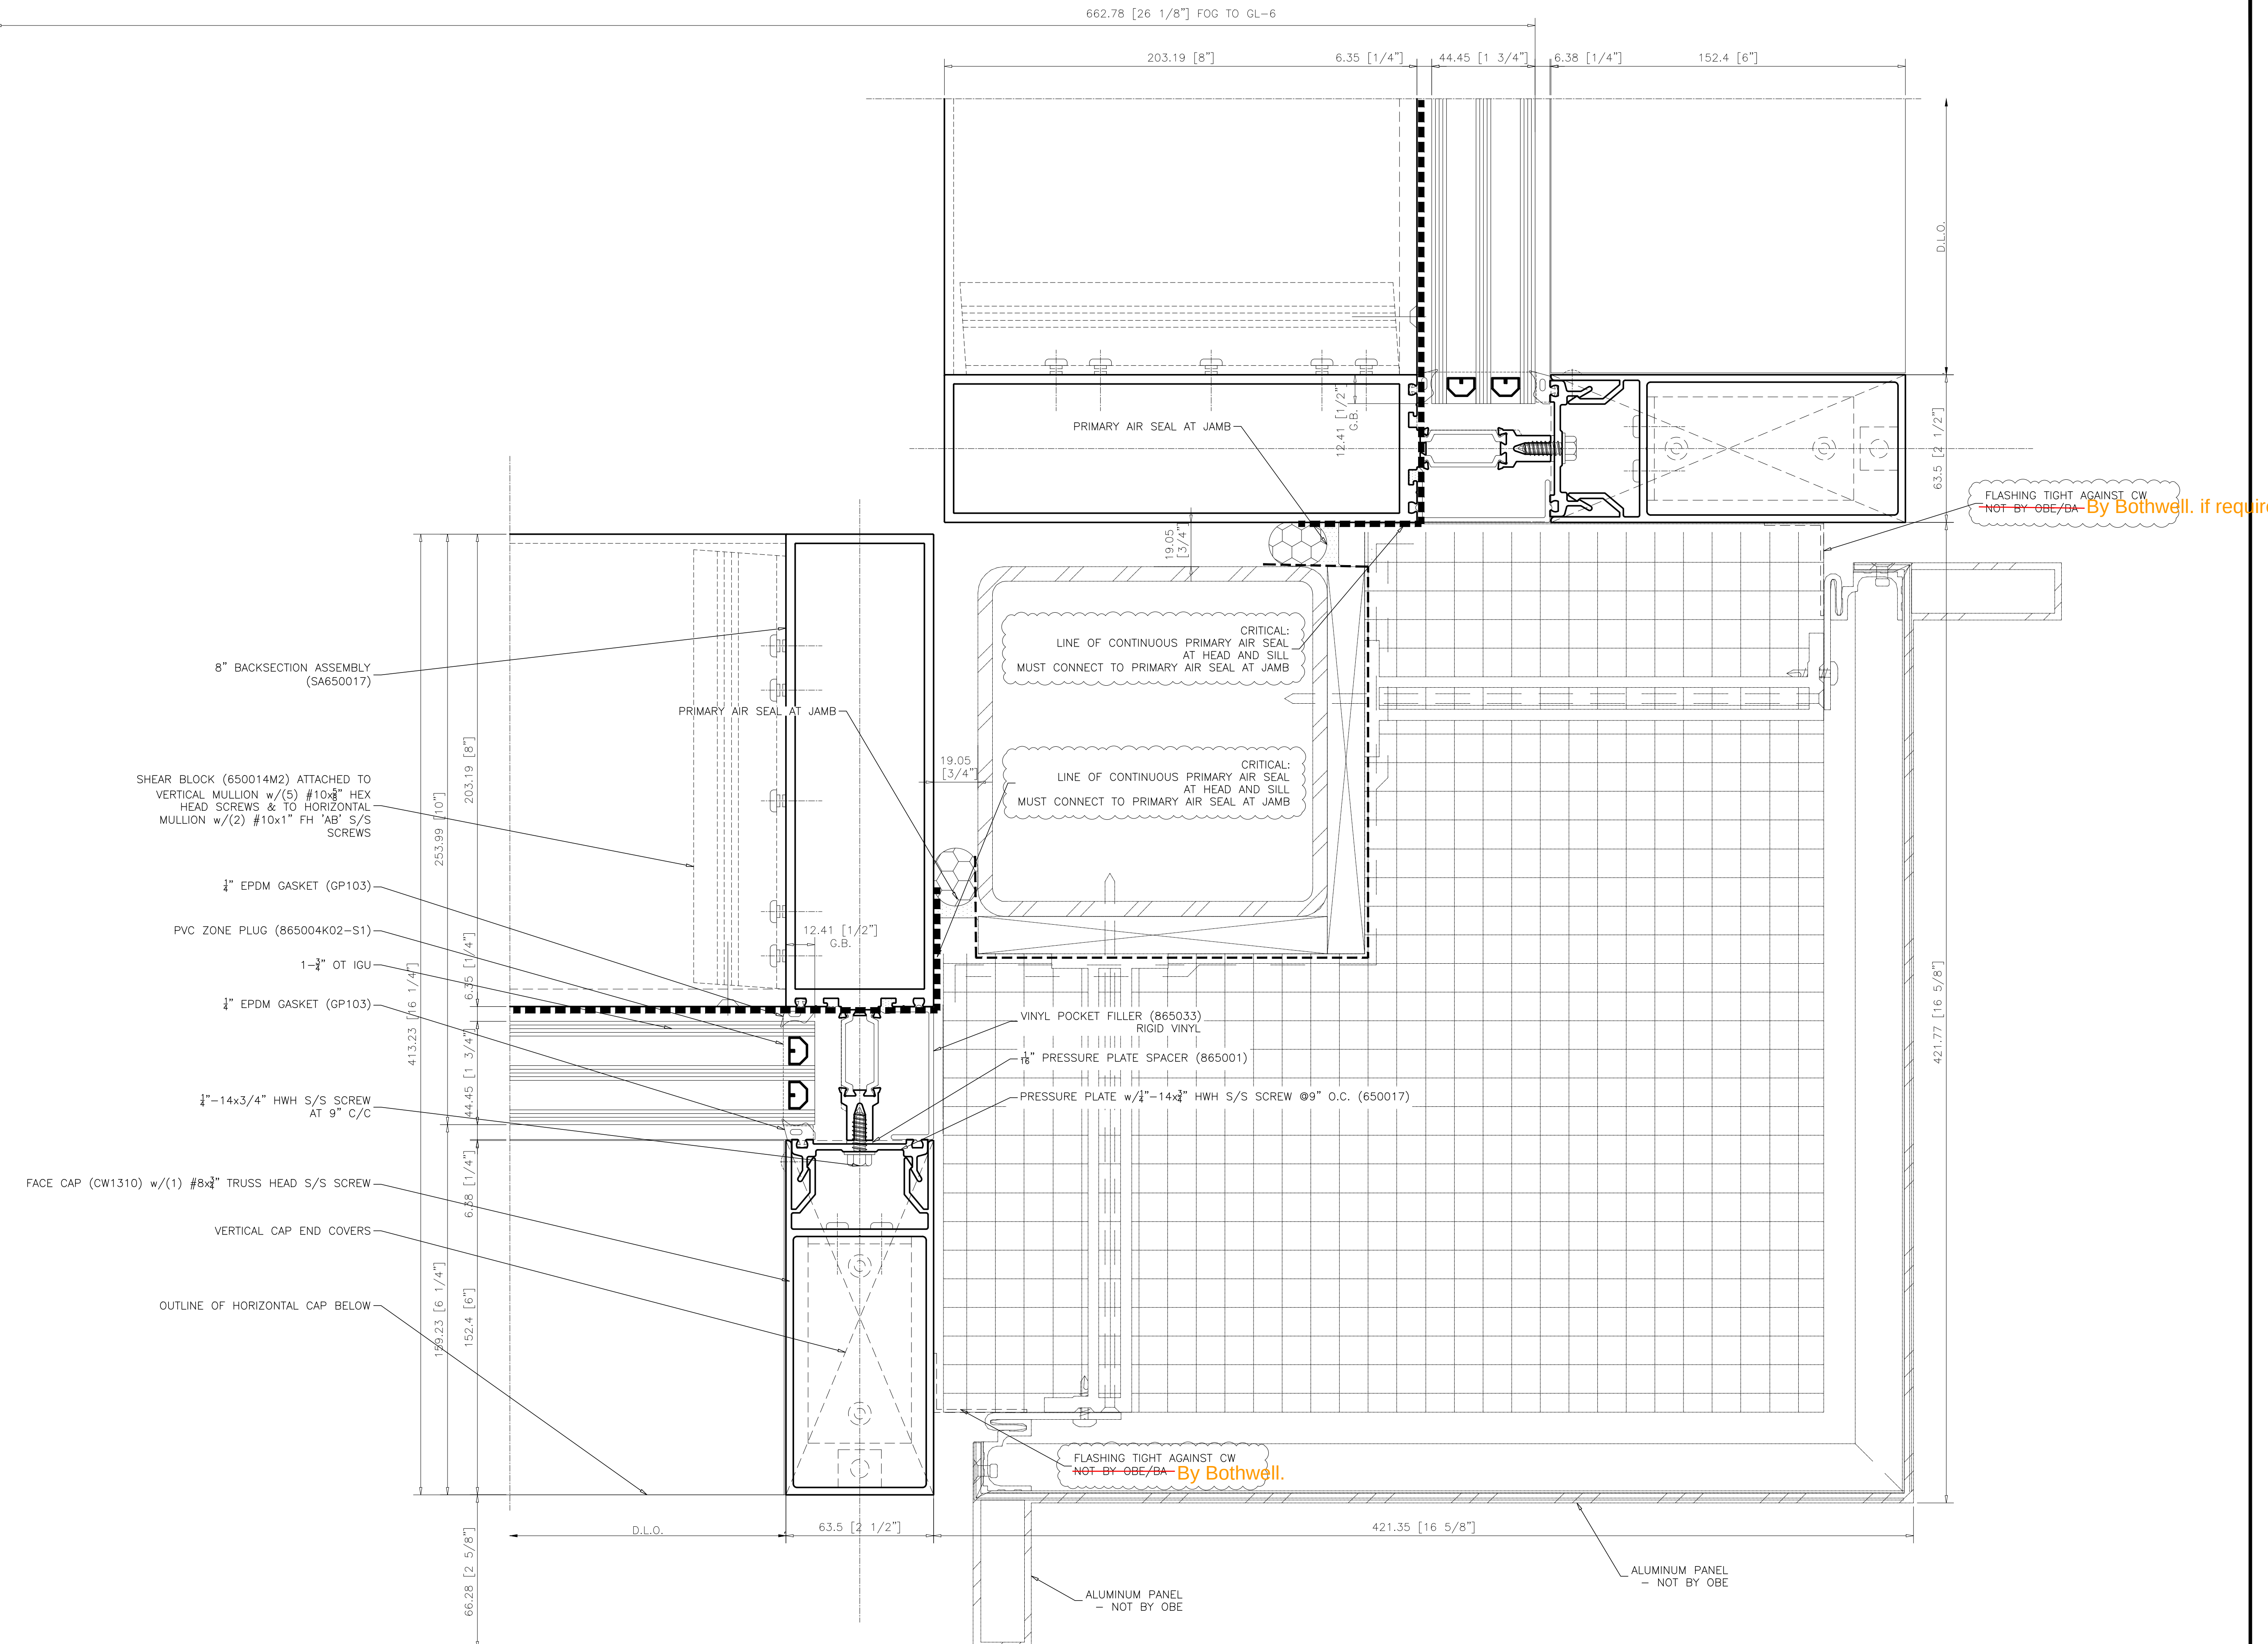

**JAMB VERTICAL 6" CAP 8" B.S.
AT VISION GLAZING GL1A**
ARCH. REF.: 11/A501

REVISIONS			
No.	Description:	Date:	By:
1	Revised per arch. markups received Feb 11/26	03/03/26	SLR

Project Name: DOCKSTEADER PRPS
Project Location: BRAMPTON, ONTARIO
Architect Name: DIAMOND SCHMITT ARCHITECTS
Customer Name: BOTHWELL ACCURATE GLAZING



275 Britannia Road East • Mississauga • Ontario • Canada • L4Z2E7
905-890-6970 • oldcastlebe.com

Drawing Name: PLAN DETAIL	
Drawn By: SR	Checked By: NP
Drawn Date: 2026/01/12	Issue No.: 1
Scale: 1"=1"	Release Date: 2026/03/03
Drawing Number: C4-011	



Project Name:	DOCKSTEADER PRPS
Project Location:	BRAMPTON, ONTARIO
Architect Name:	DIAMOND SCHMITT ARCHITECTS
Customer Name:	BOTHWELL ACCURATE GLAZING



Oldcastle BuildingEnvelope®


275 Britannia Road East • Mississauga • Canada • L4Z2E7
905-890-6970 • oldcastlebe.com

Drawing Name:

PLAN DETAIL

Drawn By: SR	Checked By: NP
Drawn Date: 2026/01/12	Issue No.: 1
Scale: 1"=1"	Release Date: 2026/03/03
Drawing Number:	


C4-011A

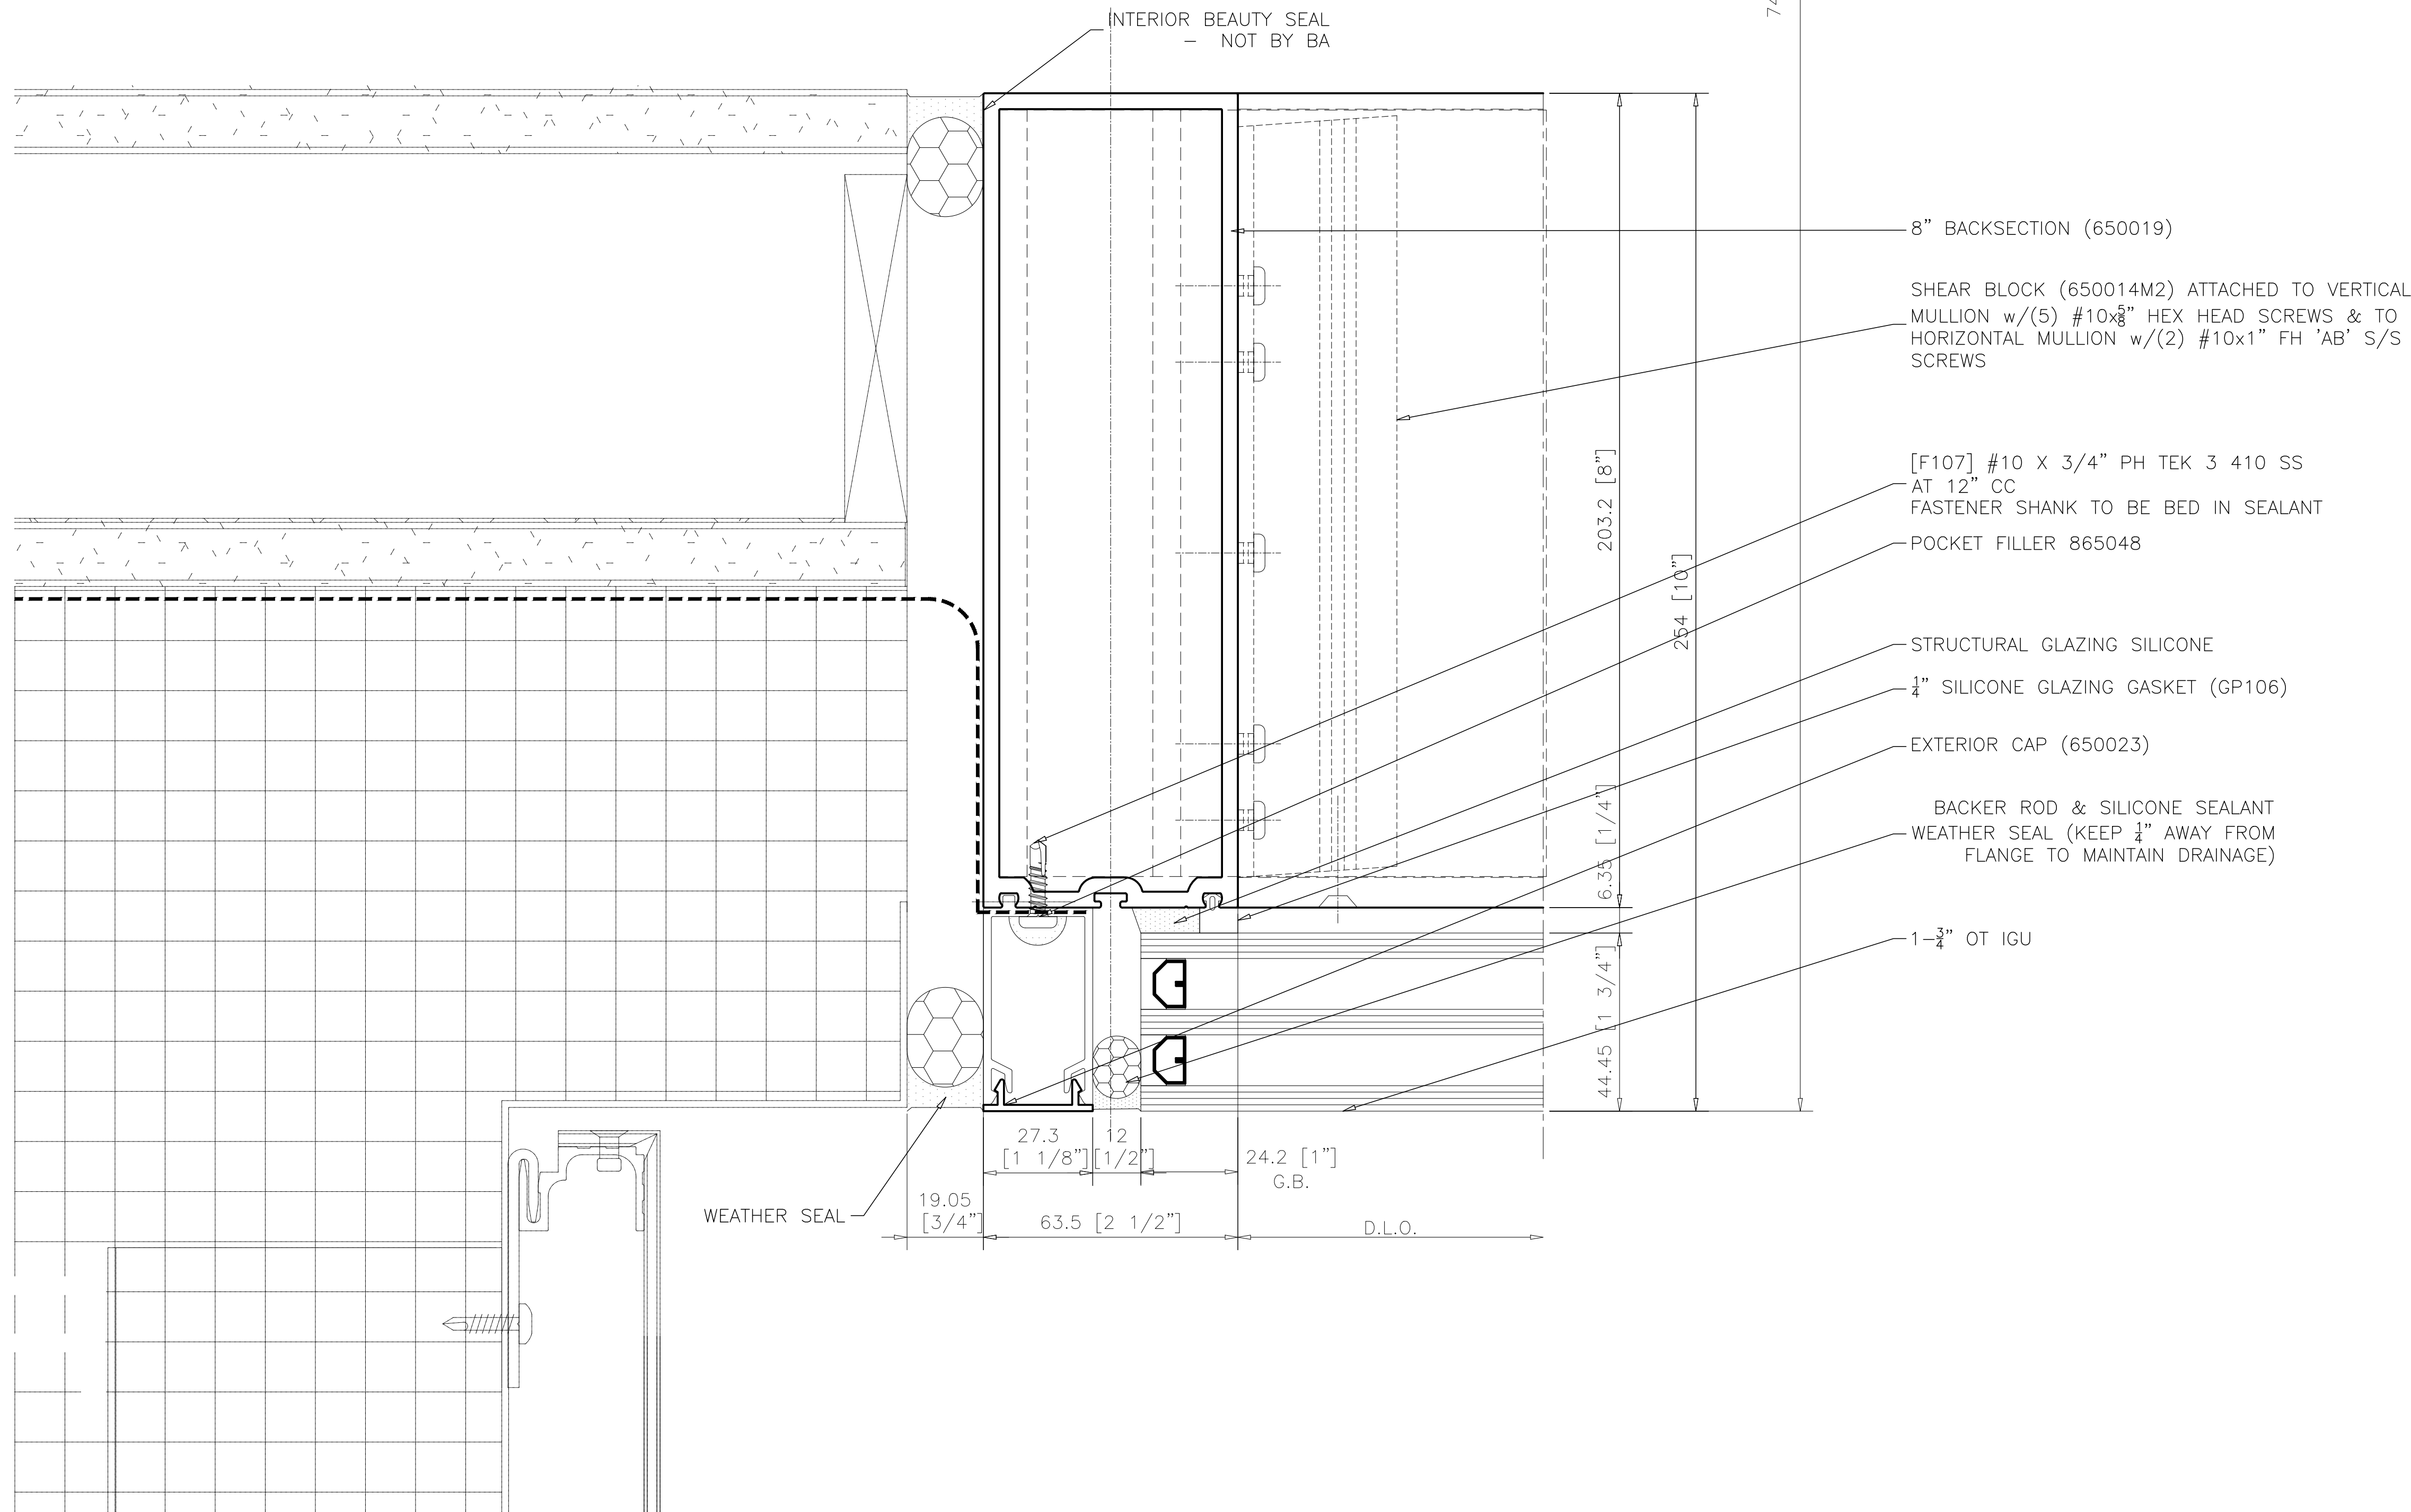

**JAMB VERTICAL SSG 8" B.S.
AT VISION GLAZING**
ARCH. REF.: 13/A501


REVISIONS			
No.	Description:	Date:	By:
1	Revised per arch. markups received Feb 11/26	03/03/26	SLR

Project Name: DOCKSTEADER PRPS	Project Location: BRAMPTON, ONTARIO	Architect Name: DIAMOND SCHMITT ARCHITECTS	Customer Name: BOTHWELL ACCURATE GLAZING
-----------------------------------	--	---	---

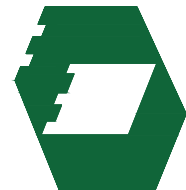**Oldcastle BuildingEnvelope®**

275 Britannia Road East • Mississauga • Ontario • Canada • L4Z2E7
905-890-6970 • oldcastlebe.com


Drawing Name: PLAN DETAIL	
Drawn By: SR	Checked By: NP
Drawn Date: 2026/01/12	Issue No.: 1
Scale: 1"=1"	Release Date: 2026/03/03
Drawing Number: C4-012	

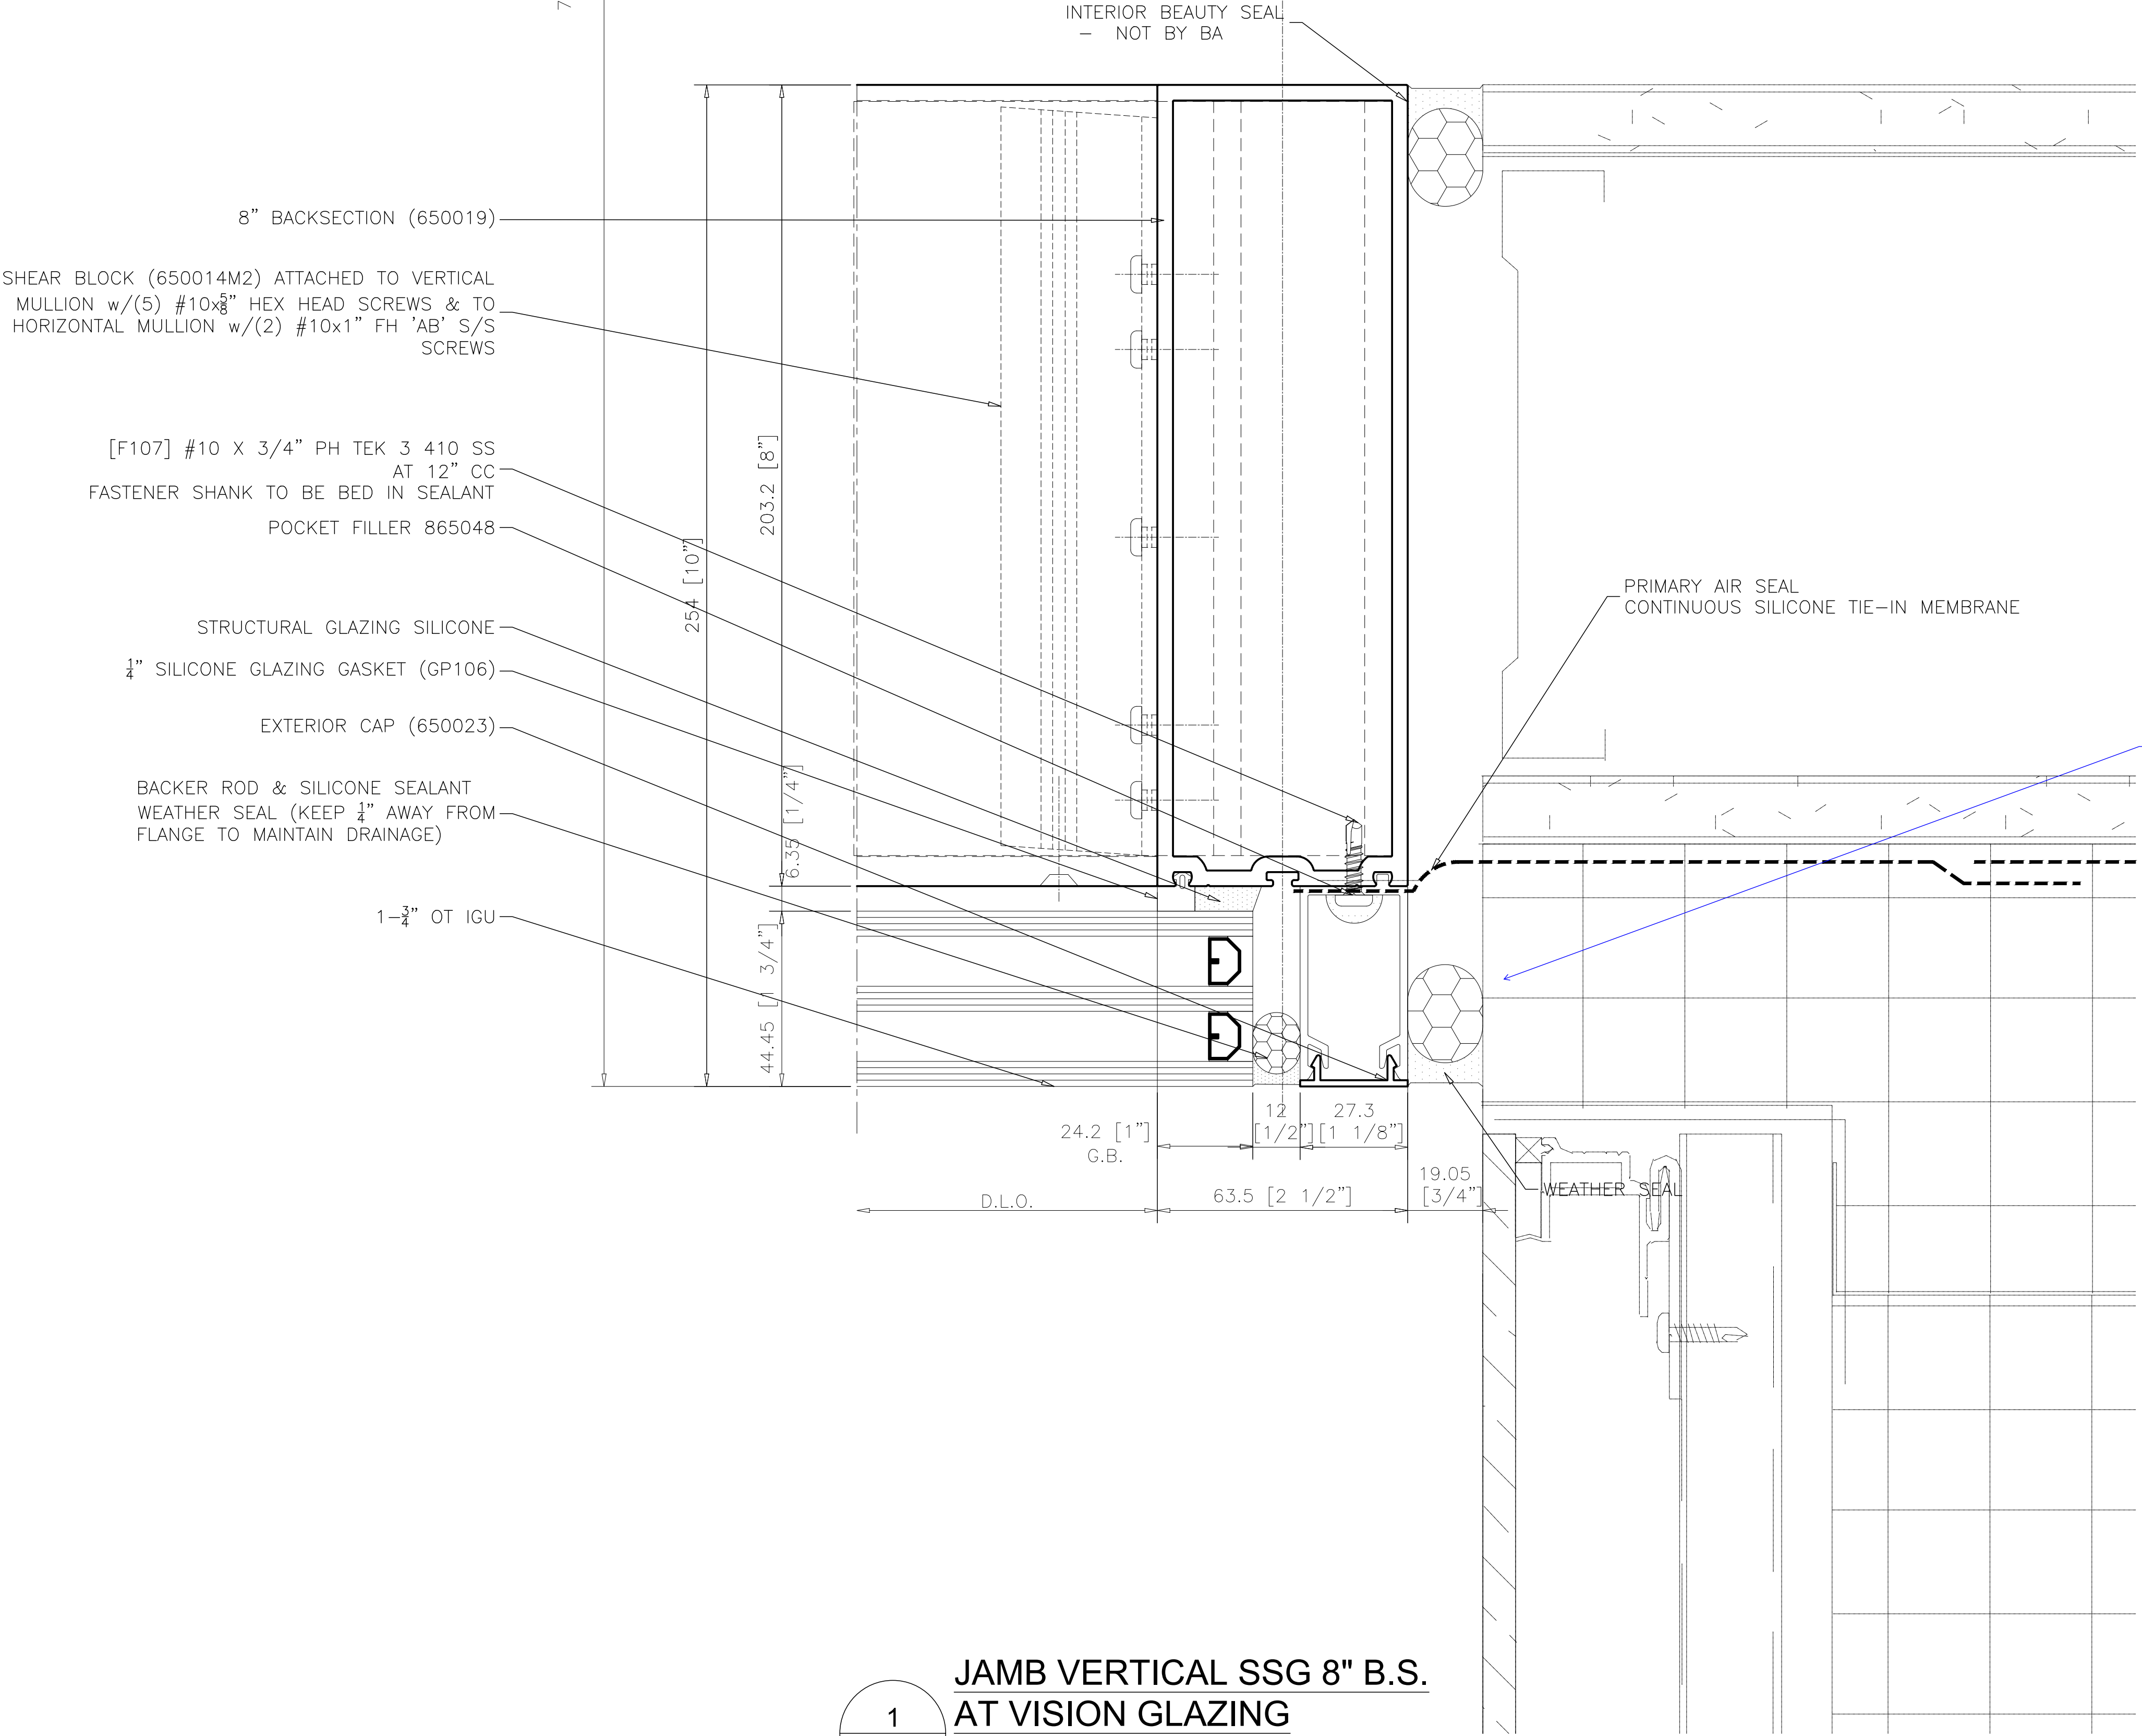

**JAMB VERTICAL SSG 8" B.S.
AT VISION GLAZING**
ARCH. REF.: 2/A502


REVISIONS			
No.	Description:	Date:	By:
1	Revised per arch. markups received Feb 11/26	03/03/26	SLR

Project Name: DOCKSTEADER PRPS	Project Location: BRAMPTON, ONTARIO	Architect Name: DIAMOND SCHMITT ARCHITECTS	Customer Name: BOTHWELL ACCURATE GLAZING
-----------------------------------	--	---	---

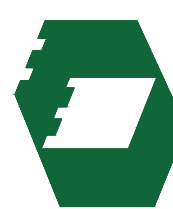**Oldcastle BuildingEnvelope®**

275 Britannia Road East • Mississauga • Ontario • Canada • L4Z2E7
905-890-6970 • oldcastlebe.com

Drawing Name: PLAN DETAIL	
Drawn By: SR	Checked By: NP
Drawn Date: 2026/01/12	Issue No.: 1
Scale: 1"=1"	Release Date: 2026/03/03
Drawing Number: C4-012A	

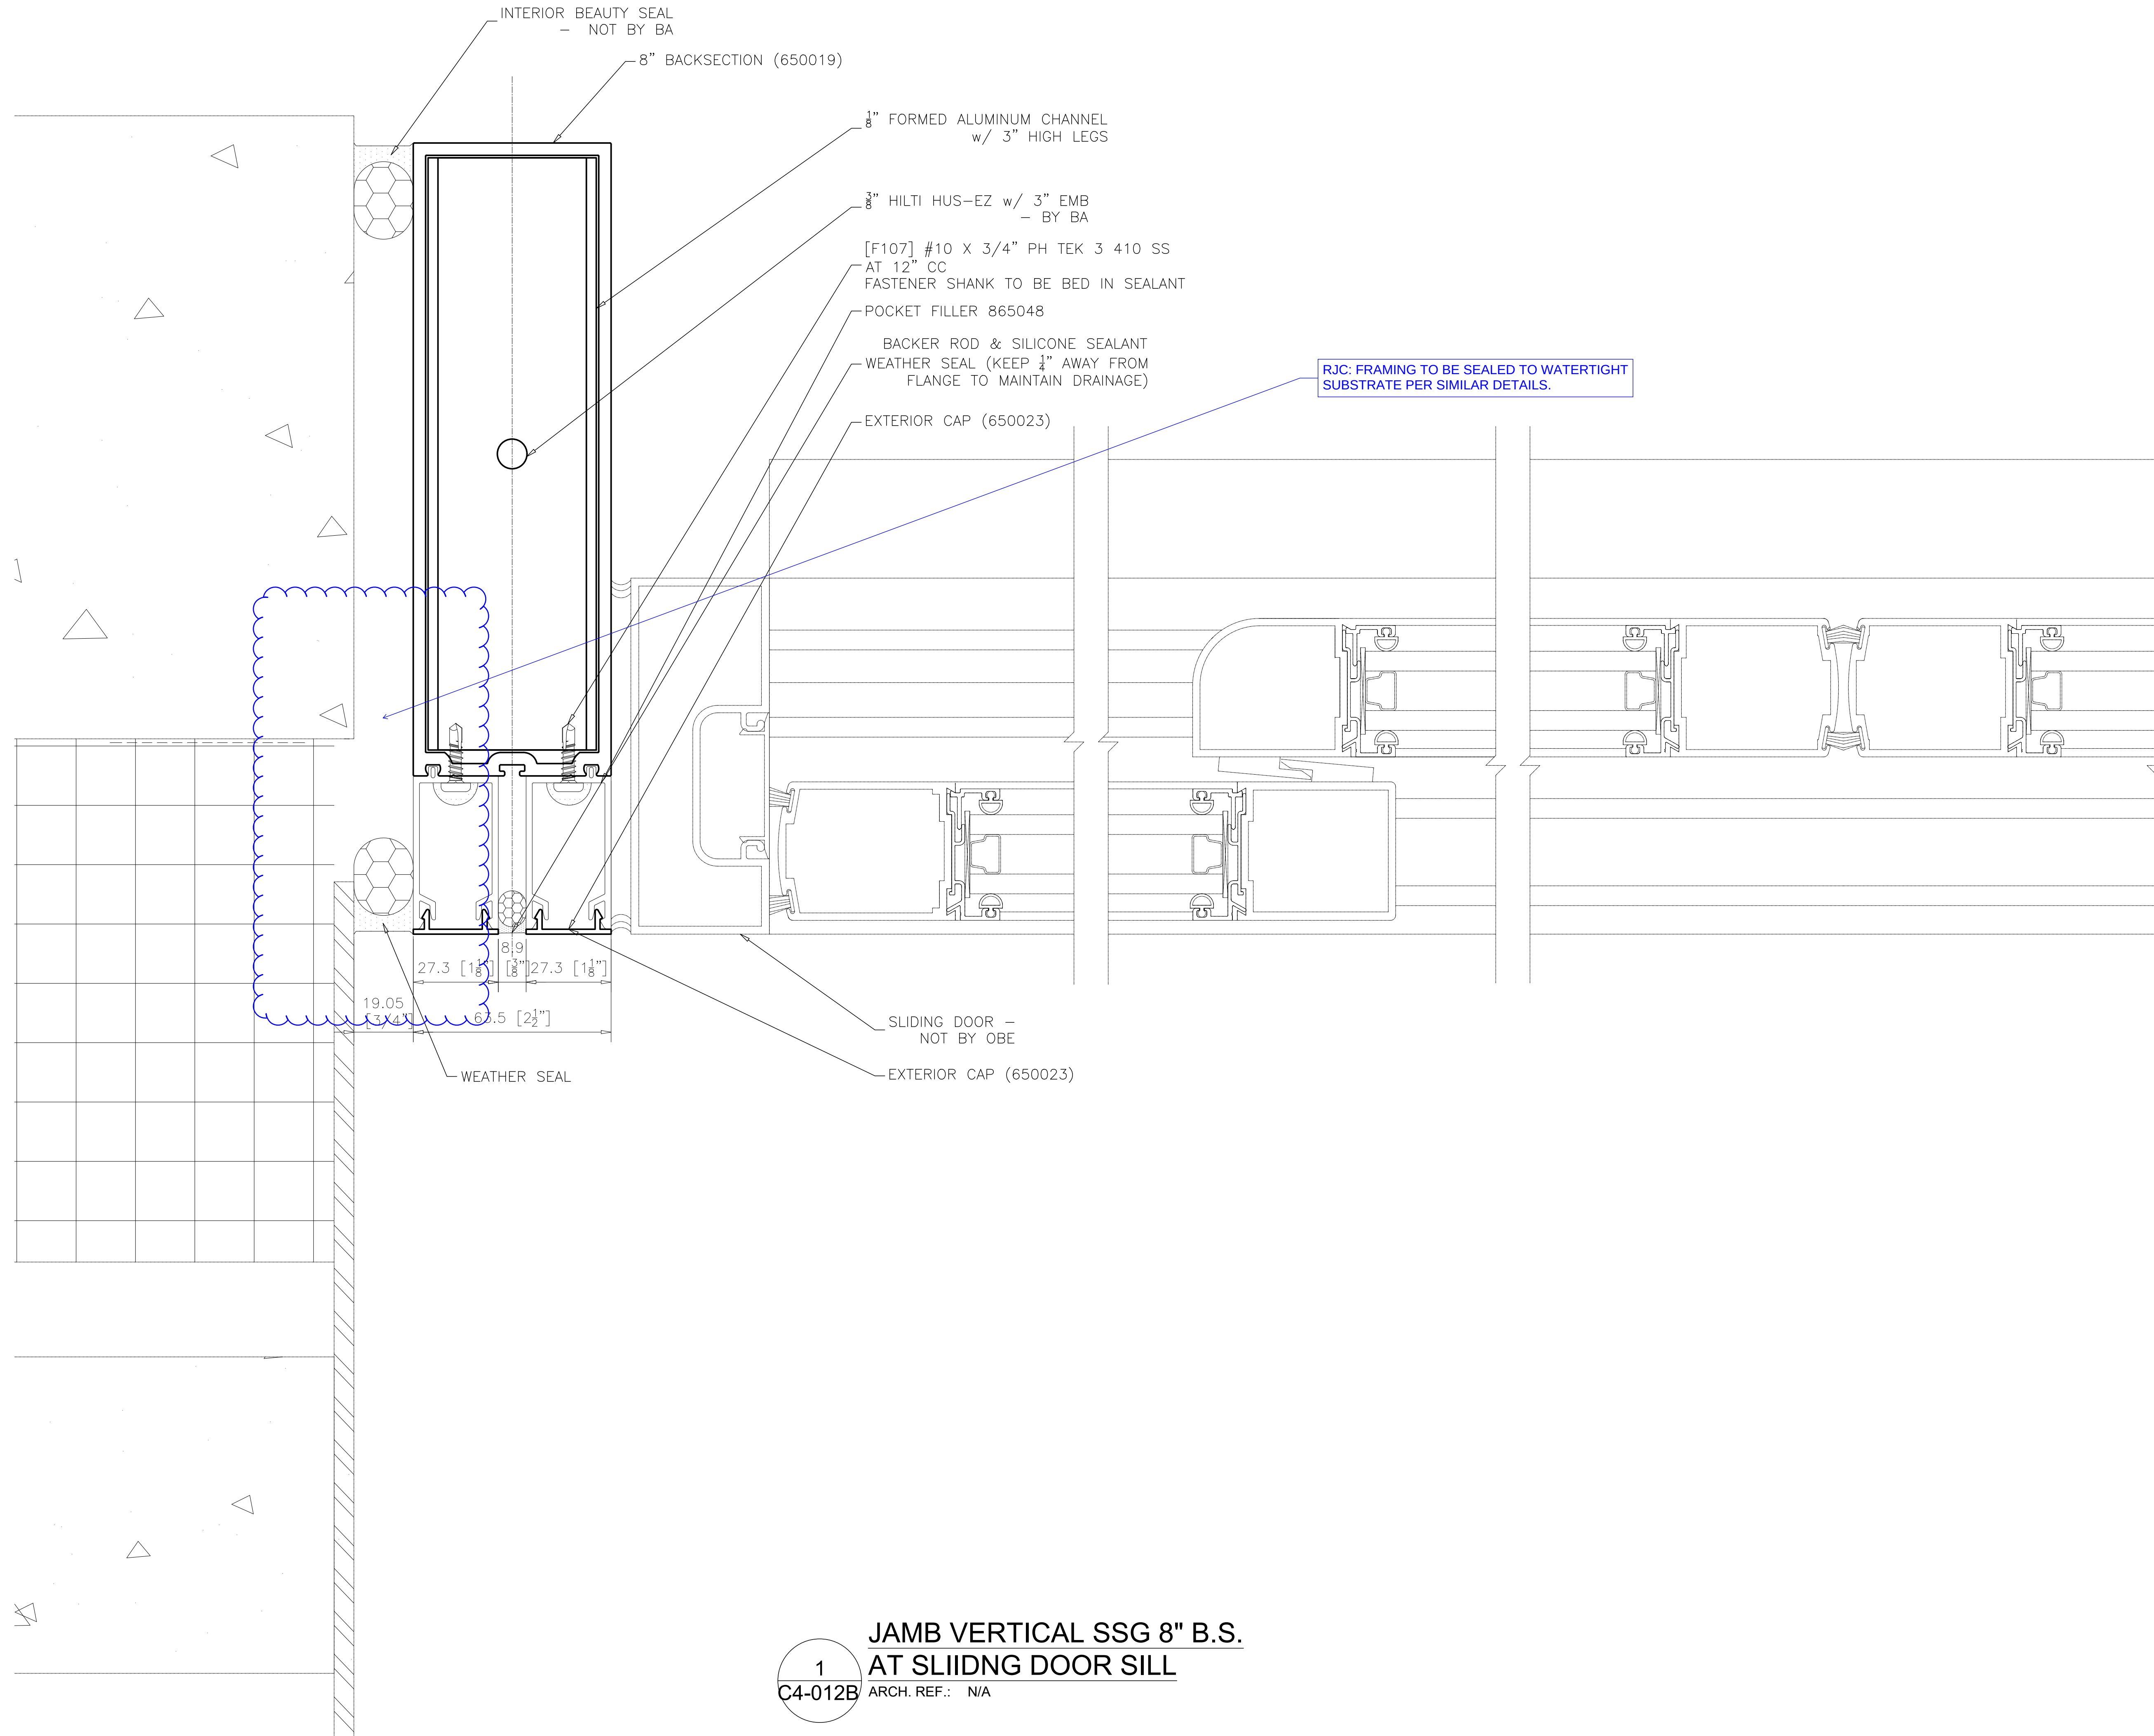

**JAMB VERTICAL SSG 8" B.S.
AT SLIDING DOOR SILL**
ARCH. REF.: N/A


REVISIONS			
No.	Description:	Date:	By:
1	Revised per arch. markups received Feb 11/26	03/03/26	SLR

Project Name: DOCKSTEADER PRPS	Project Location: BRAMPTON, ONTARIO	Architect Name: DIAMOND SCHMITT ARCHITECTS	Customer Name: BOTHWELL ACCURATE GLAZING
-----------------------------------	--	---	---



275 Britannia Road East • Mississauga • Ontario • Canada • L4Z2E7
905-890-6970 • oldcastlebe.com

Drawing Name: PLAN DETAIL	
Drawn By: SR	Checked By: NP
Drawn Date: 2026/01/12	Issue No.: 1
Scale: 1"=1"	Release Date: 2026/03/03
Drawing Number: C4-012B	

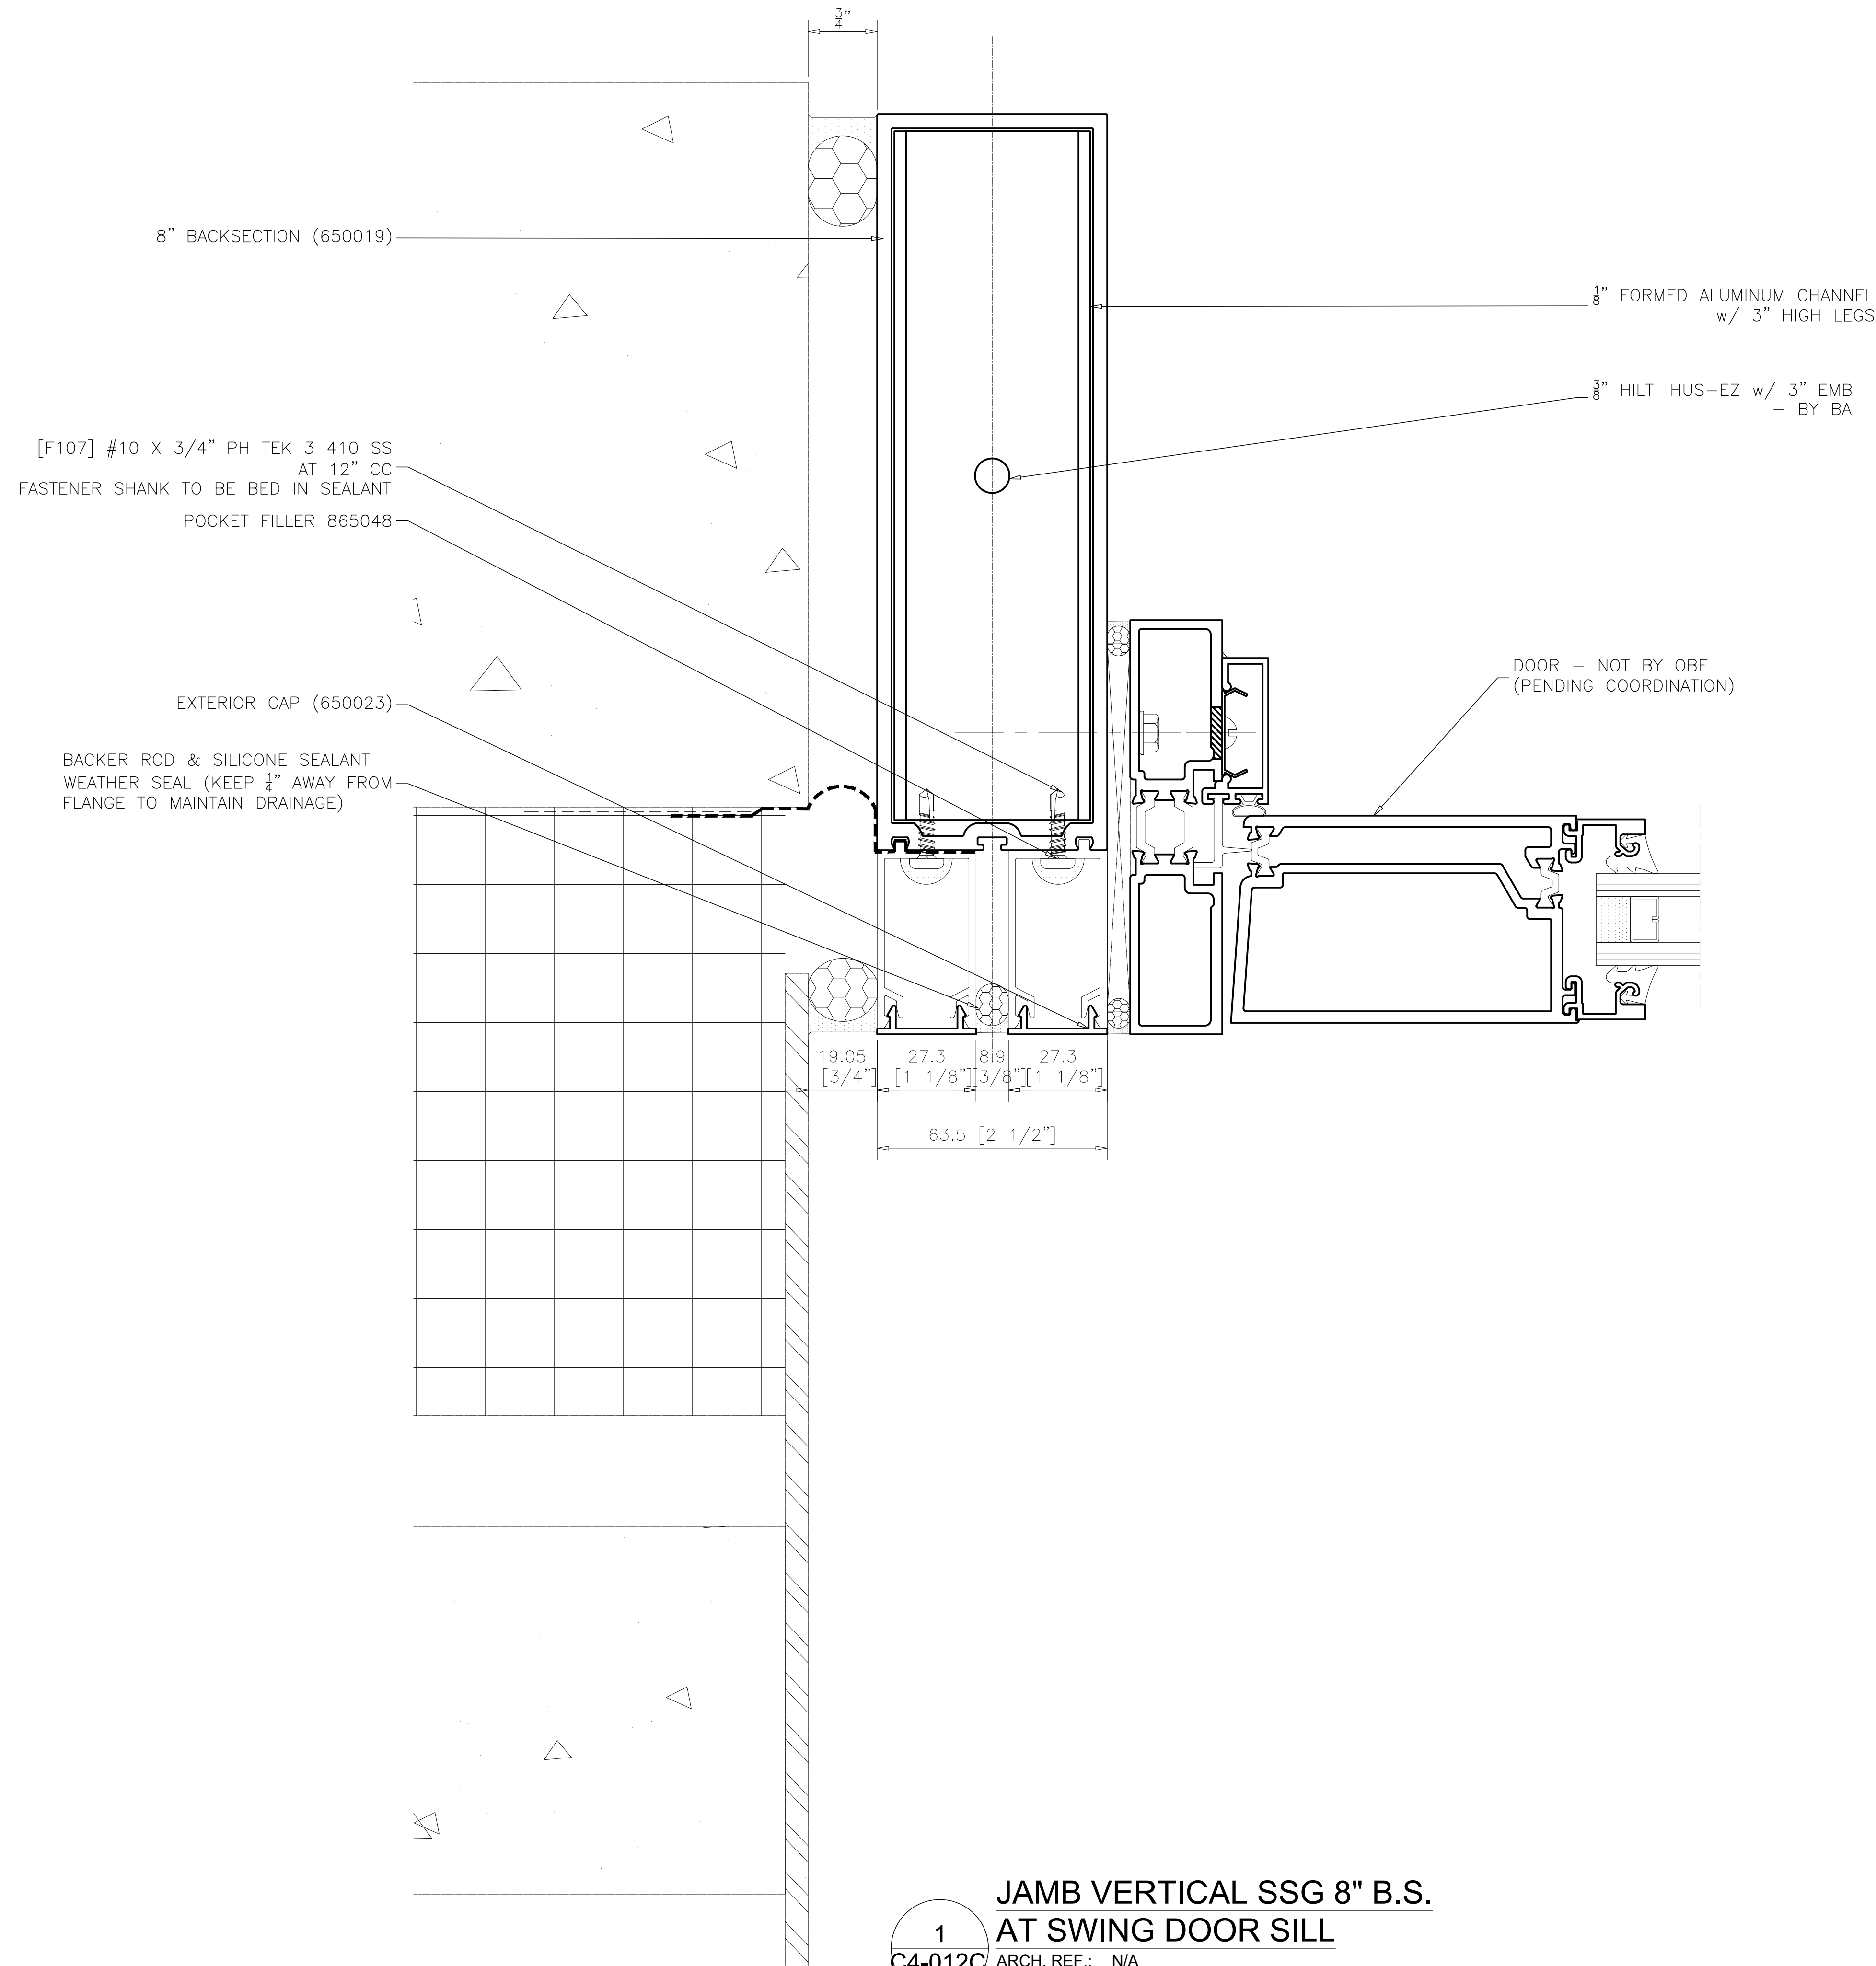

**JAMB VERTICAL SSG 8" B.S.
AT SWING DOOR SILL**
ARCH. REF.: N/A


REVISIONS			
No.	Description:	Date:	By:
1	Revised per arch. markups received Feb 11/26	03/03/26	SLR

Project Name:	DOCKSTEADER PRPS
Project Location:	BRAMPTON, ONTARIO
Architect Name:	DIAMOND SCHMITT ARCHITECTS
Customer Name:	BOTHWELL ACCURATE GLAZING



275 Britannia Road East • Mississauga • Ontario • Canada • L4Z2E7
905-890-6970 • oldcastlebe.com

Drawing Name: PLAN DETAIL	
Drawn By: SR	Checked By: NP
Drawn Date: 2026/01/12	Issue No.: 1
Scale: 1"=1"	Release Date: 2026/03/03
Drawing Number: C4-012C	

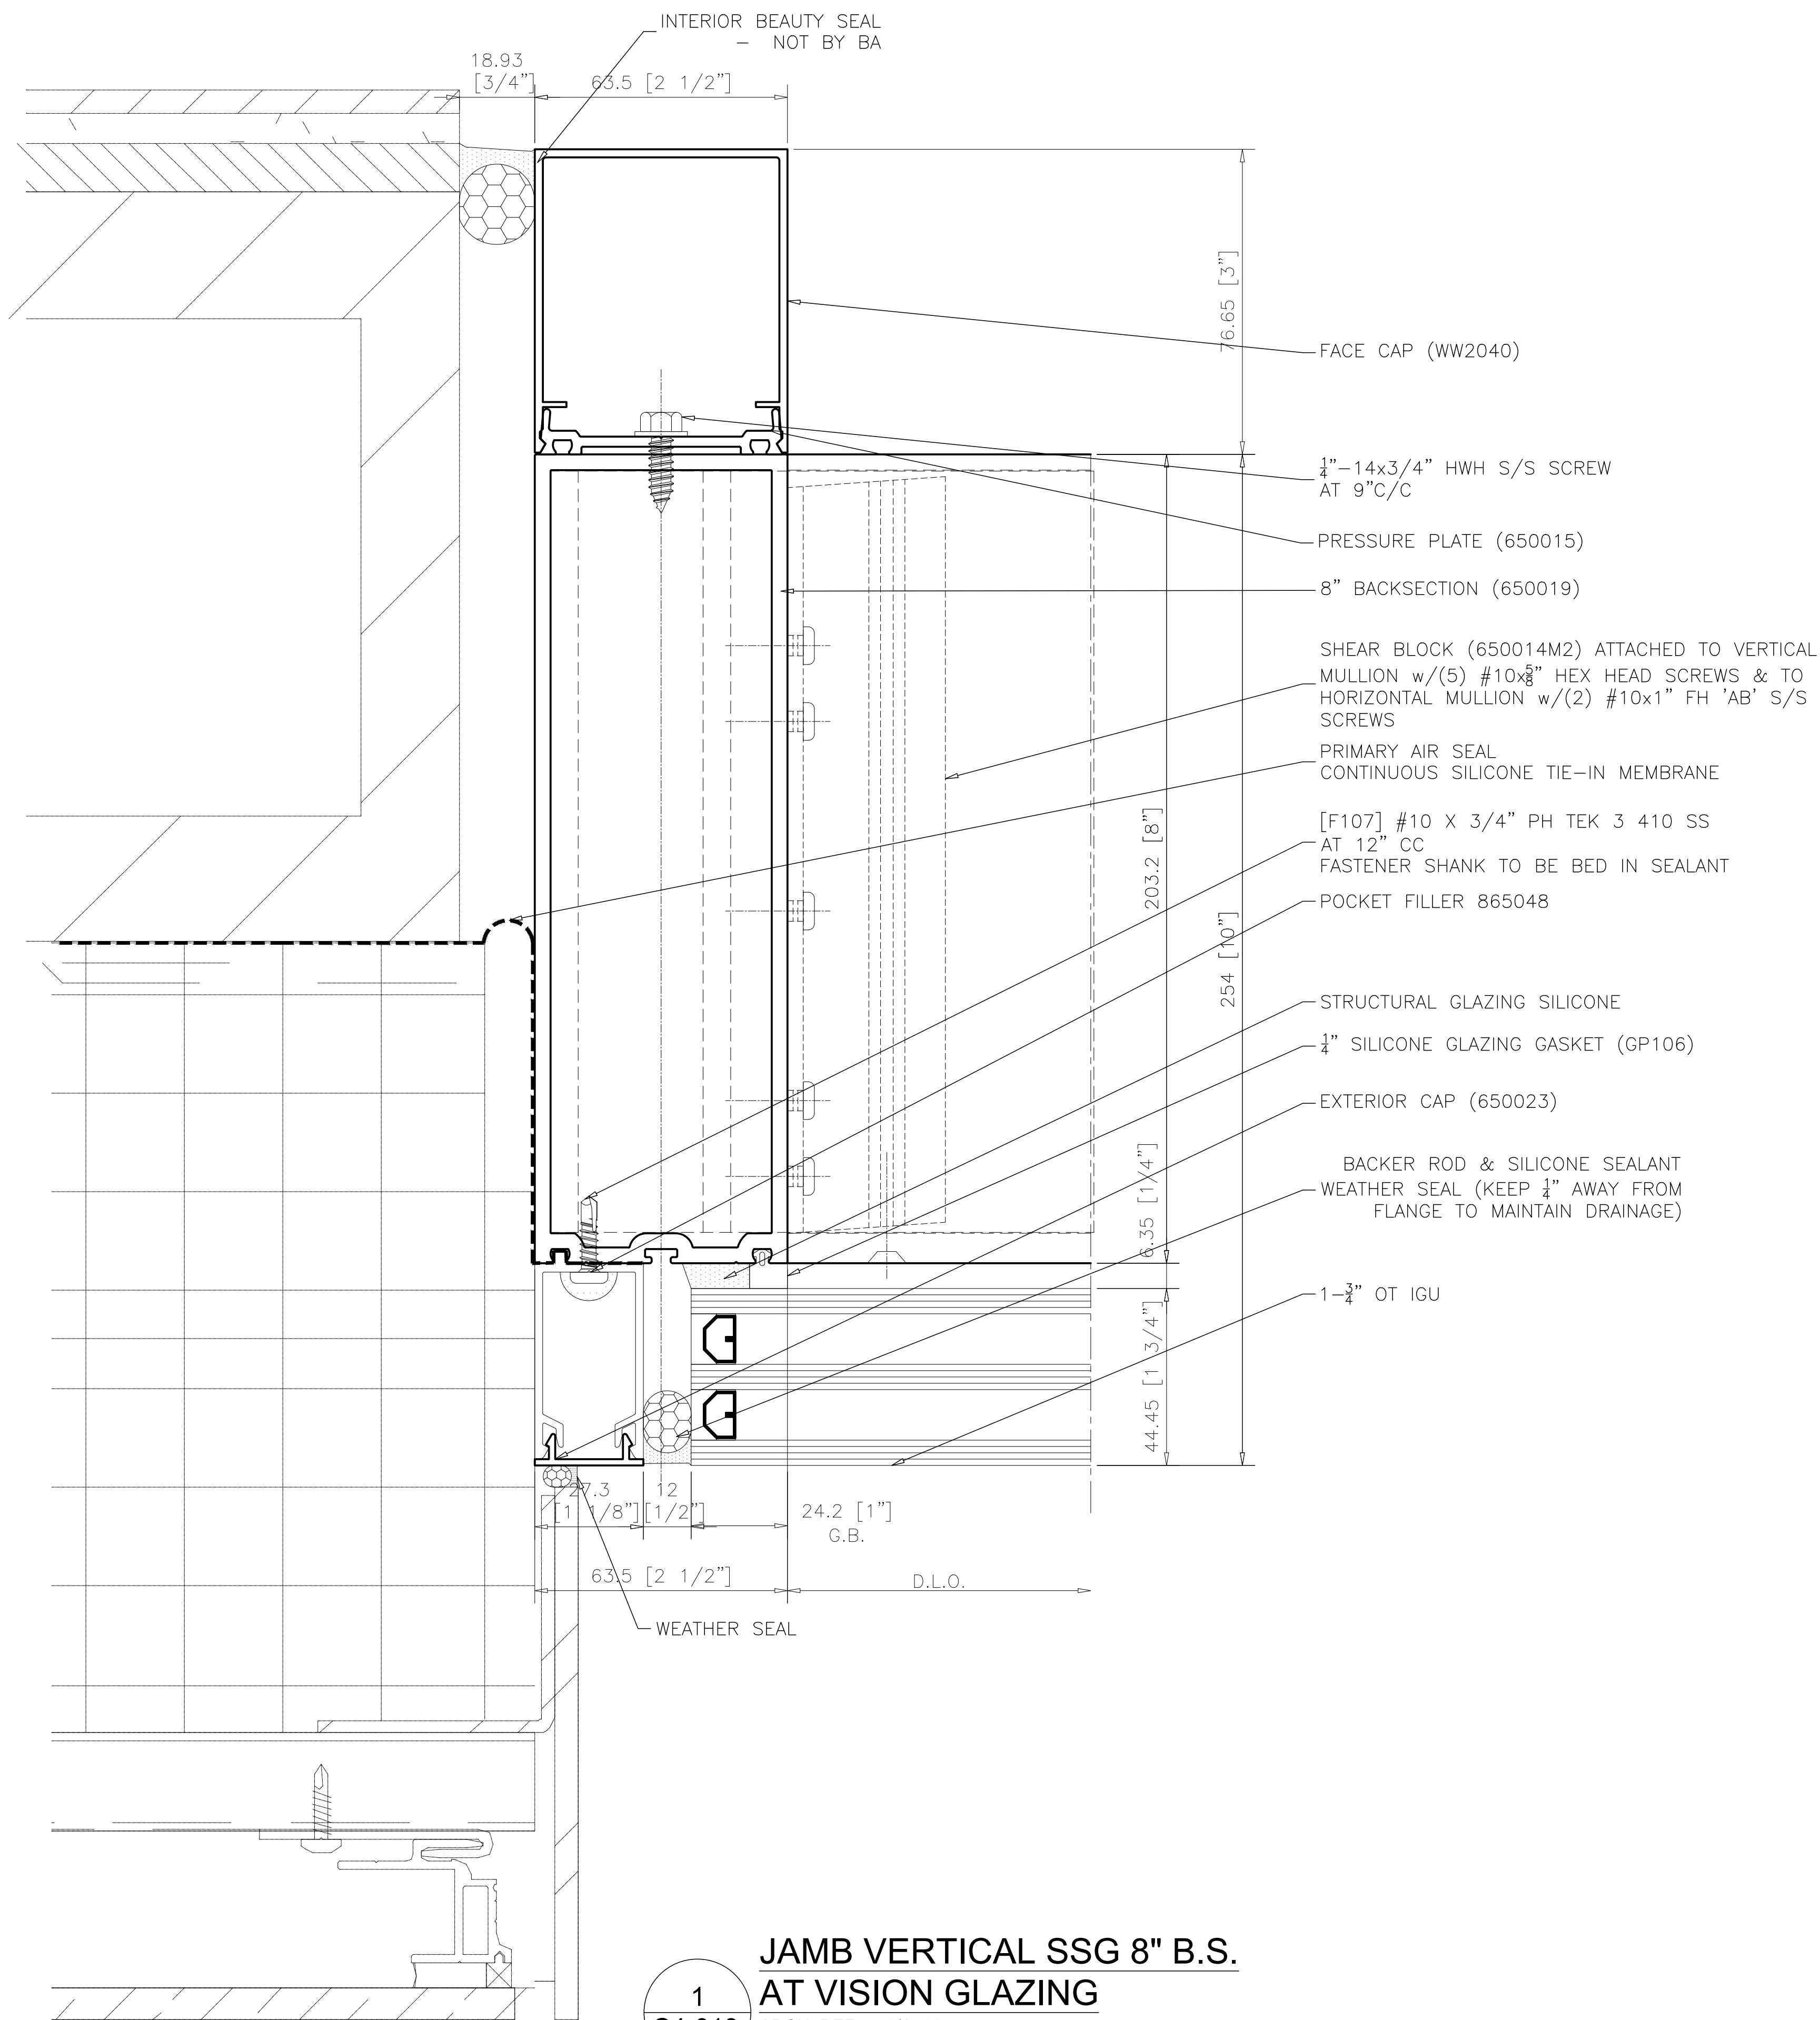

1
C4-013

**JAMB VERTICAL SSG 8" B.S.
AT VISION GLAZING**

ARCH. REF.: 8/A502


REVISIONS			
No.	Description:	Date:	By:
1	Revised per arch. markups received Feb 11/26	03/03/26	SLR

Project Name: DOCKSTEADER PRPS	Project Location: BRAMPTON, ONTARIO	Architect Name: DIAMOND SCHMITT ARCHITECTS	Customer Name: BOTHWELL ACCURATE GLAZING
-----------------------------------	--	---	---



275 Britannia Road East • Mississauga • Ontario • Canada • L4Z2E7
905-890-6970 • oldcastlebe.com

Drawing Name: PLAN DETAIL	
Drawn By: SR	Checked By: NP
Drawn Date: 2026/01/12	Issue No.: 1
Scale: 1"=1"	Release Date: 2026/03/03
Drawing Number: C4-013	

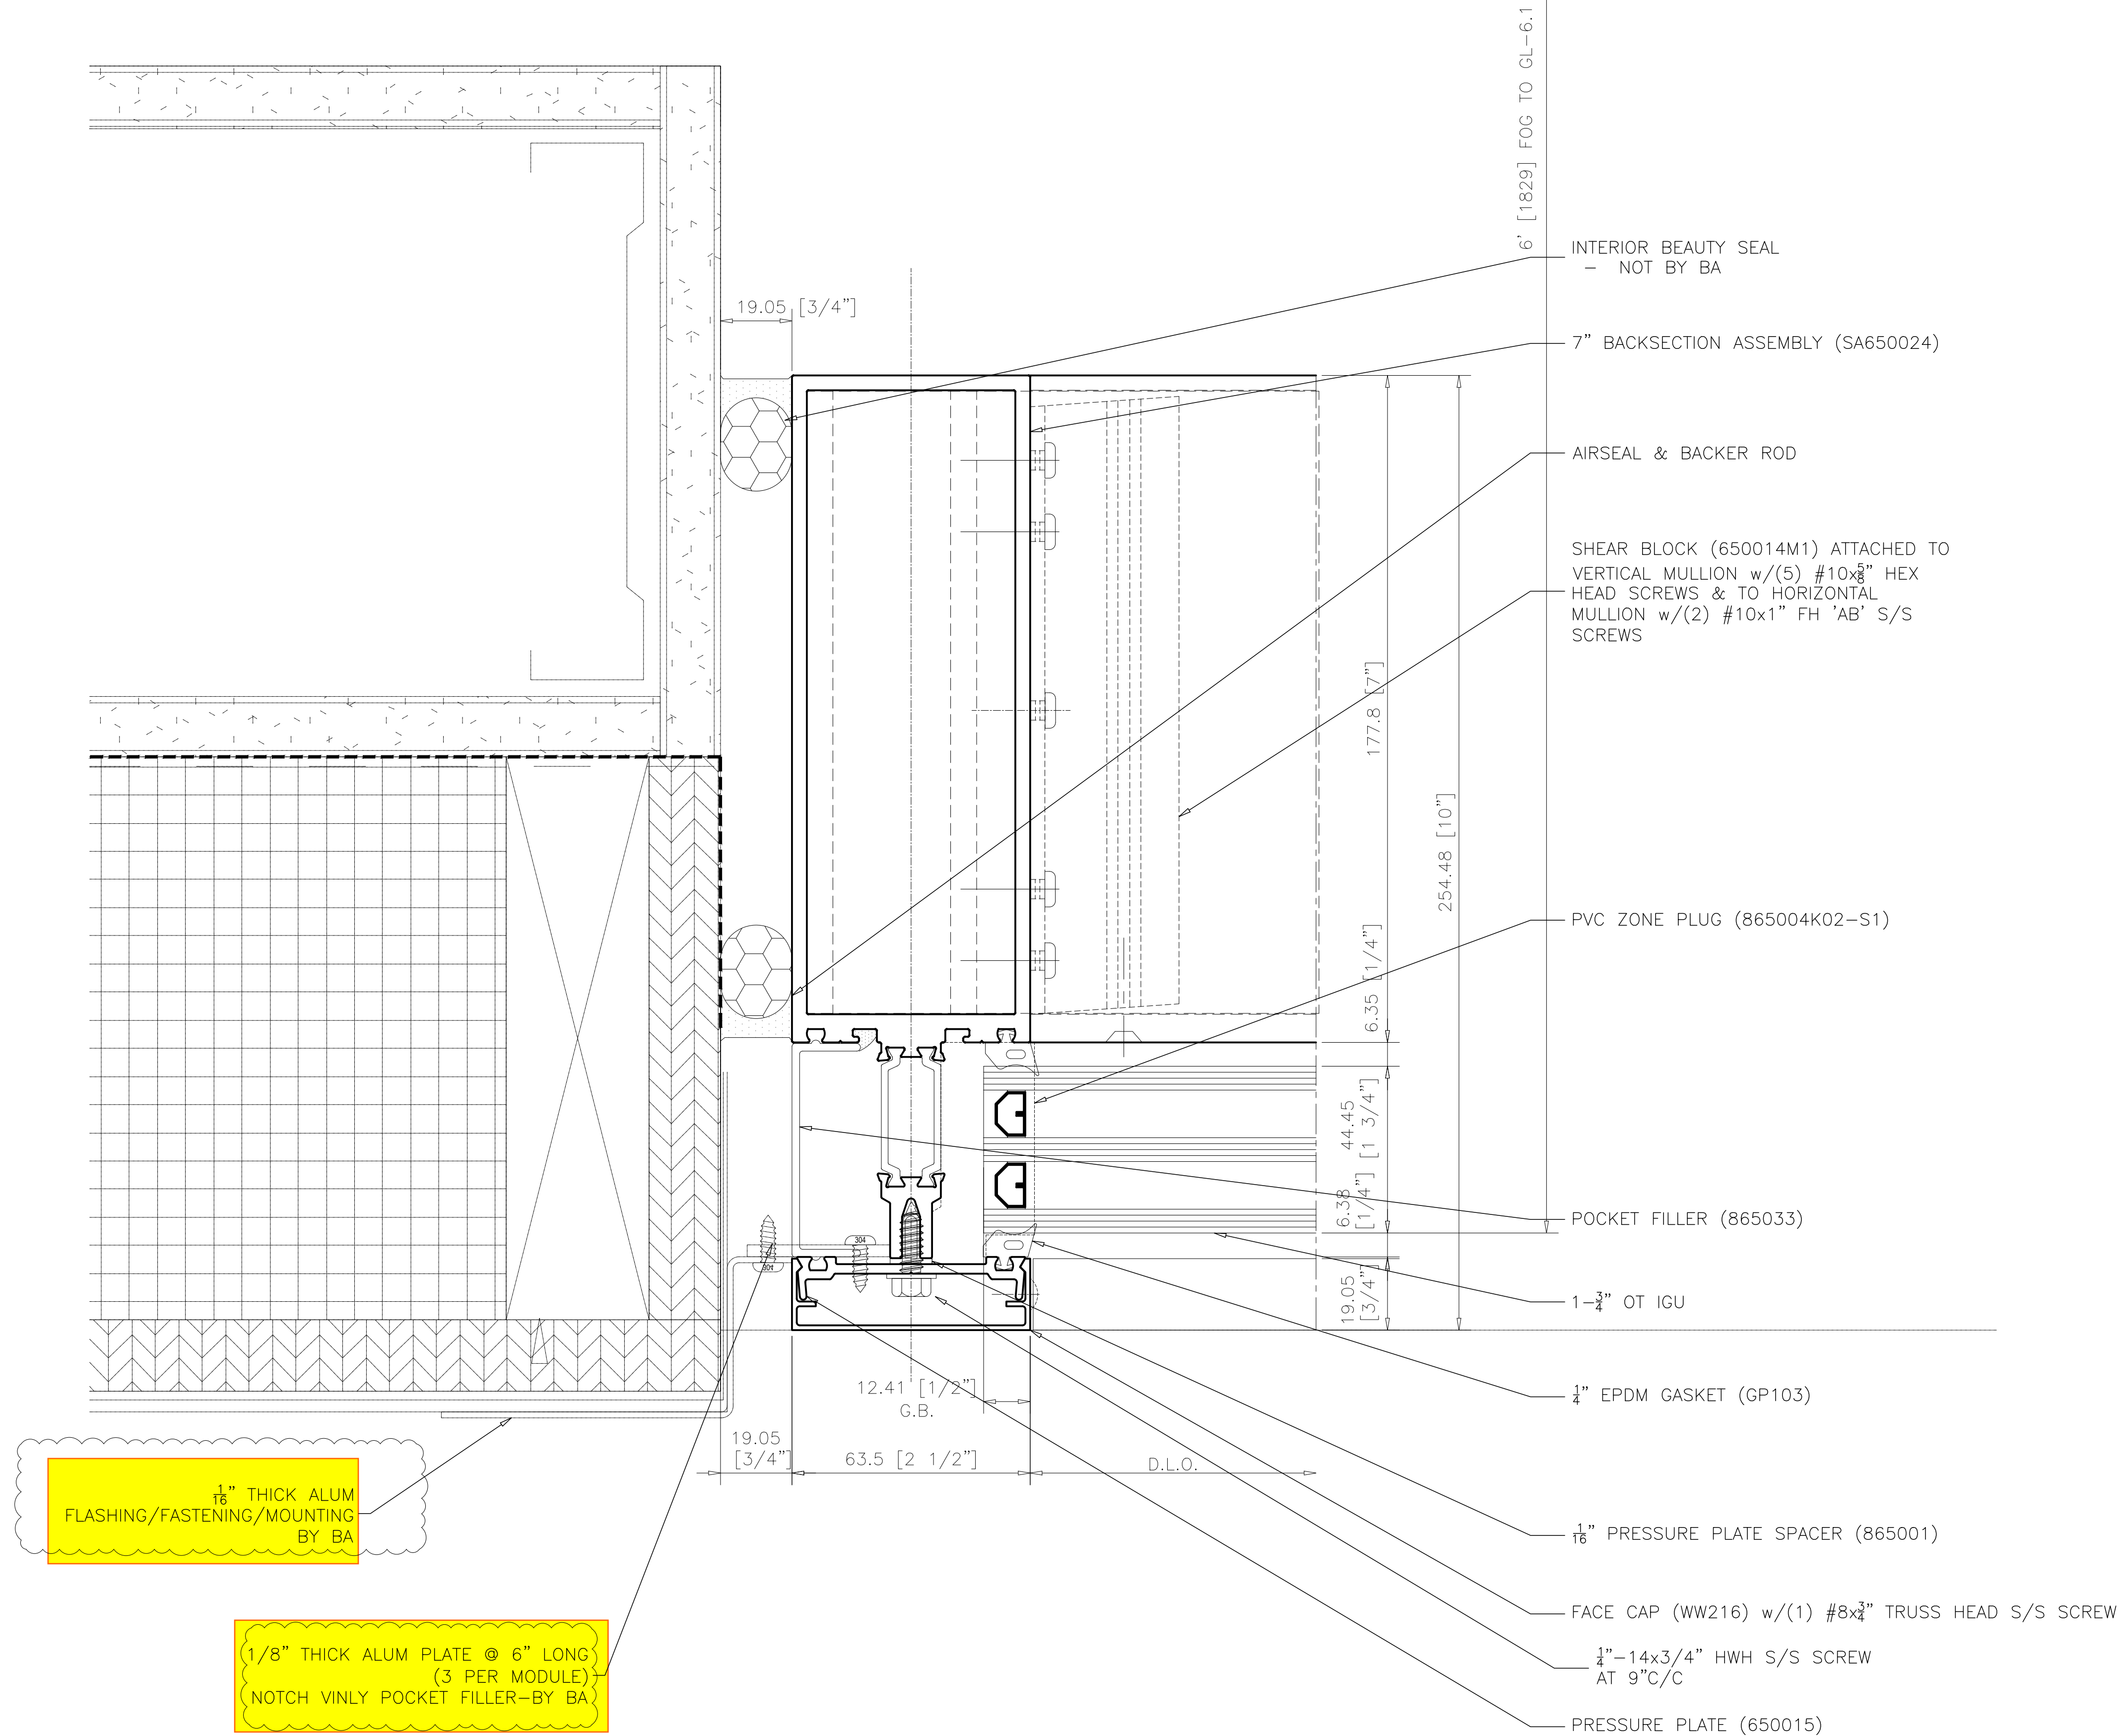

1
C4-014

**JAMB VERTICAL 3/4" CAP 7" B.S.
AT VISION GLAZING**

ARCH. REF.: 4/A503

REVISIONS			
No.	Description:	Date:	By:
1	Revised per arch. markups received Feb 11/26	03/03/26	SLR


Project Name: DOCKSTEADER PRPS	Project Location: BRAMPTON, ONTARIO	Architect Name: DIAMOND SCHMITT ARCHITECTS	Customer Name: BOTHWELL ACCURATE GLAZING
-----------------------------------	--	---	---



275 Britannia Road East • Mississauga • Ontario • Canada • L4Z2E7
905-890-6970 • oldcastlebe.com

Drawing Name: PLAN DETAIL	
Drawn By: SR	Checked By: NP
Drawn Date: 2026/01/12	Issue No.: 1
Scale: 1"=1"	Release Date: 2026/03/03
Drawing Number: C4-014	

6' [1829] FOG TO GL-6.1

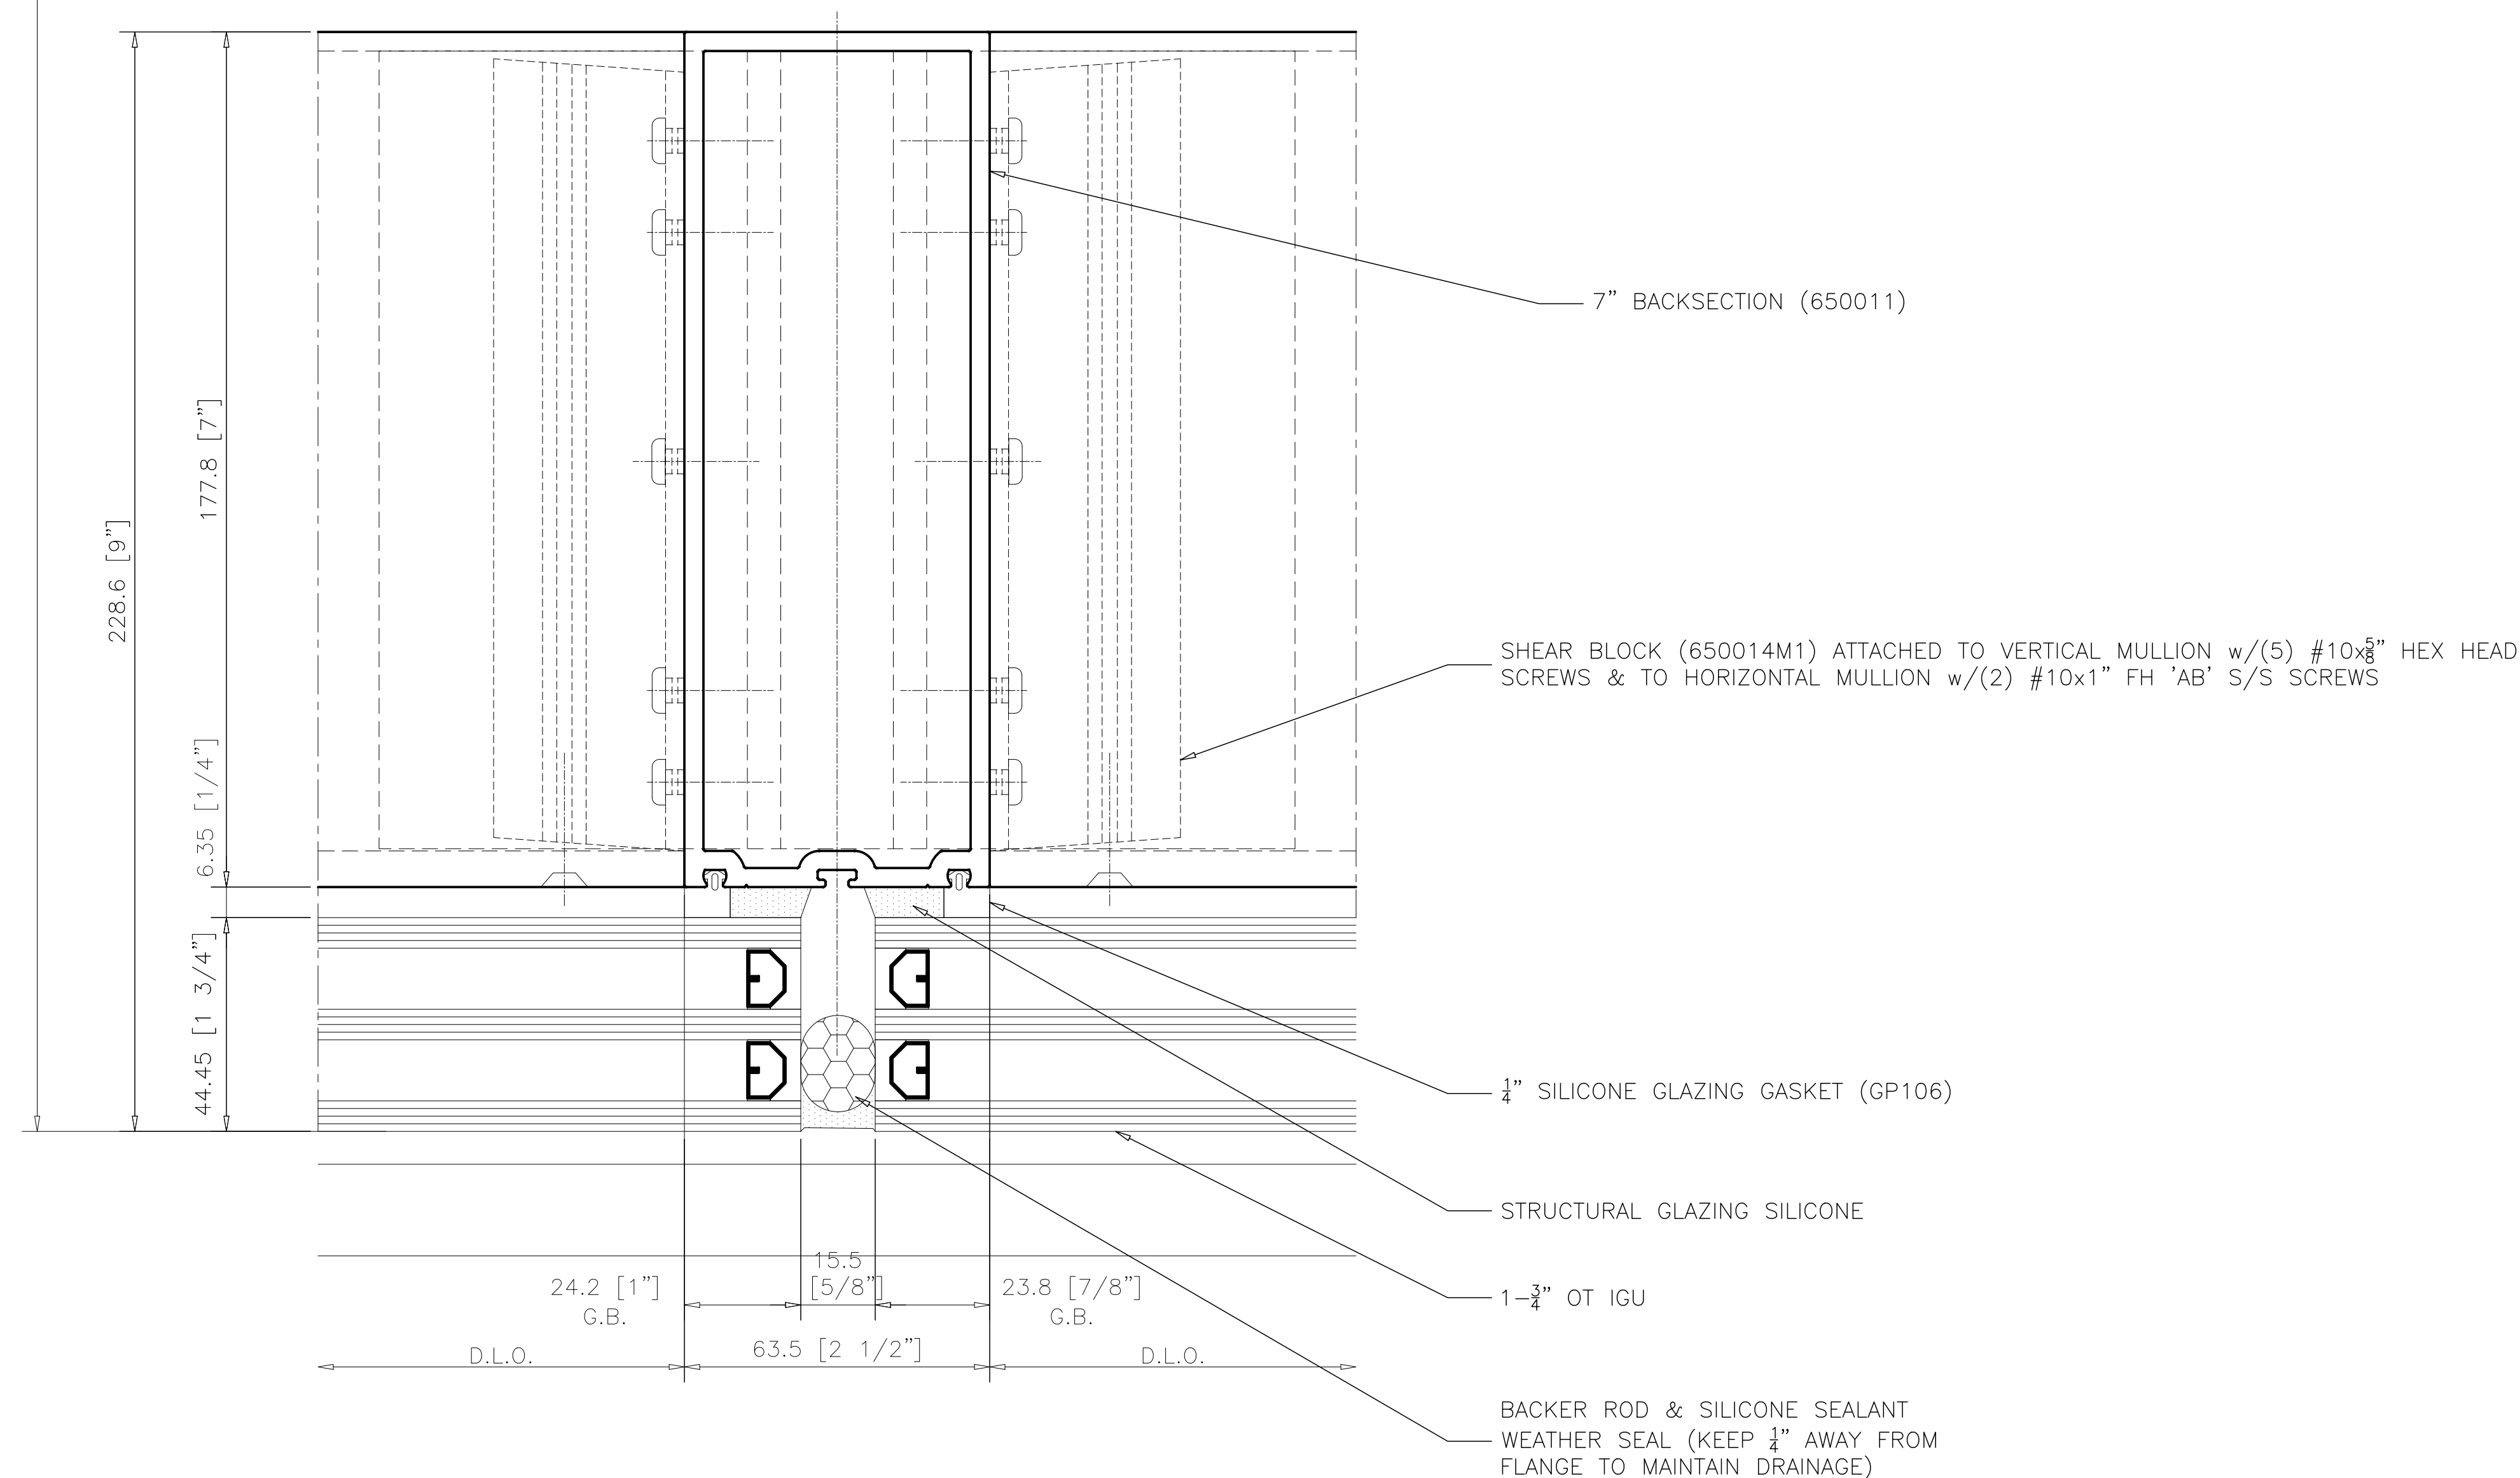


1
C4-015

INT. VERTICAL SSG 7" B.S.
AT VISION BESIDE VISION GLAZING
ARCH. REF.: N/A


REVISIONS			
No.	Description:	Date:	By:
1	Revised per arch. markups received Feb 11/26	03/03/26	SLR

Project Name: DOCKSTEADER PRPS	Project Location: BRAMPTON, ONTARIO	Architect Name: DIAMOND SCHMITT ARCHITECTS	Customer Name: BOTHWELL ACCURATE GLAZING
-----------------------------------	--	---	---

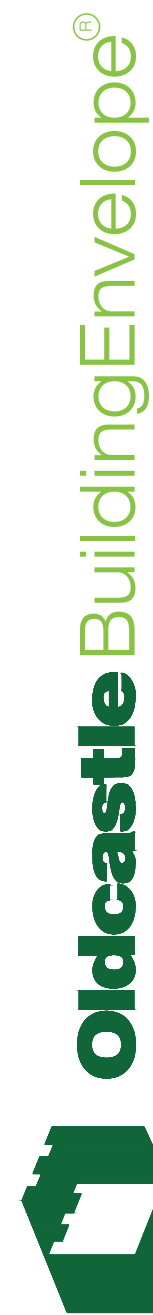

275 Britannia Road East • Mississauga • Ontario • Canada • L4Z2E7
905-890-6970 • oldcastlebe.com

Drawing Name: PLAN DETAIL	
Drawn By: SR	Checked By: NP
Drawn Date: 2026/01/12	Issue No.: 1
Scale: 1"=1'	Release Date: 2026/03/03
Drawing Number: C4-015	

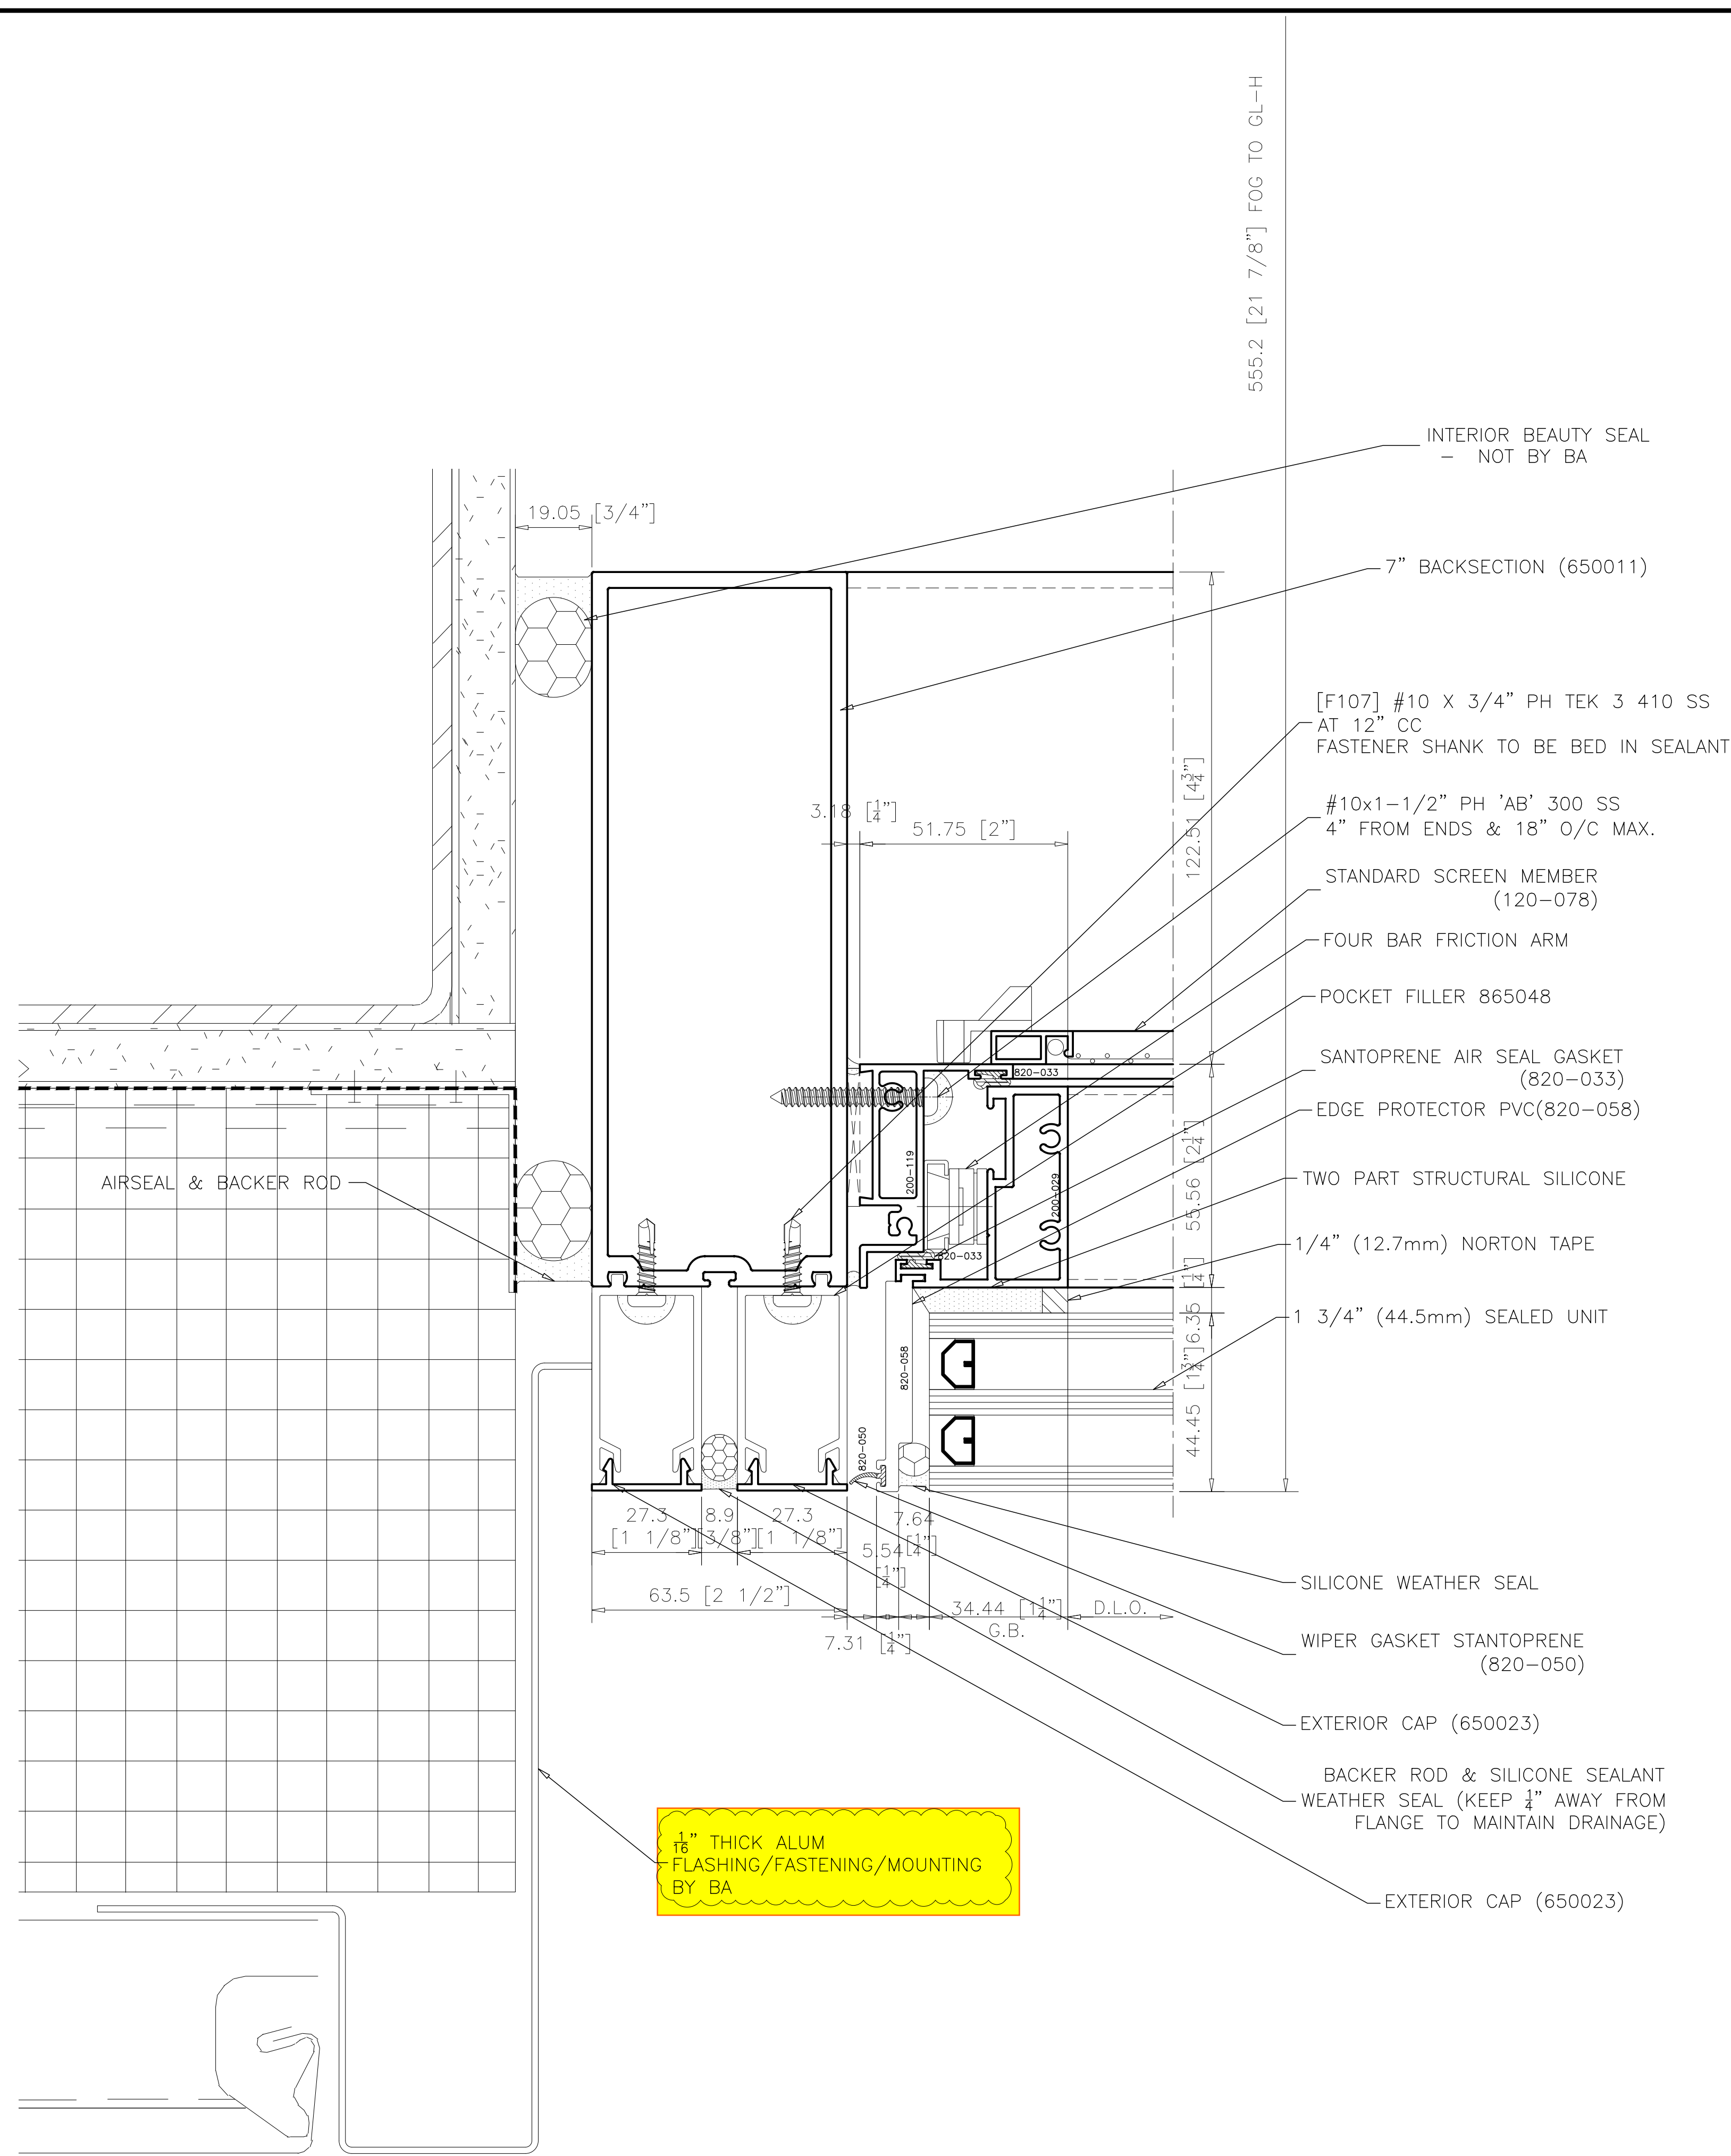


**JAMB VERTICAL SSG 7" B.S.
AT VENT**
ARCH. REF.: 3/A503

Project Name:
DOCKSTEADER PRPS

Project Location:
BRAMPTON, ONTARIO

Architect Name:
DIAMOND SCHMITT ARCHITECTS

Customer Name:
BOTHWELL ACCURATE GLAZING

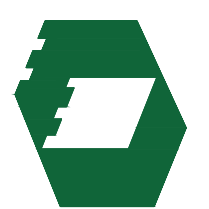

Oldcastle BuildingEnvelope®

275 Britannia Road East • Mississauga • Ontario • Canada • L4Z2E7
905-890-6970 • oldcastlebe.com

REVISIONS			
No.	Description:	Date:	By:
1	Revised per arch. markups received Feb 11/26	03/03/26	SLR

Drawing Name:
PLAN DETAIL

Drawn By:
SR

Checked By:
NP

Drawn Date:
2026/01/12


Issue No.:
1

Scale:
1"=1"

Release Date:
2026/03/03

Drawing Number:

C4-016

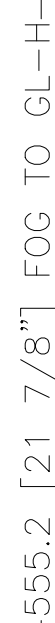


1
C4-017

Project Name:	DOCKSTEADER PRPS
Project Location:	BRAMPTON, ONTARIO
Architect Name:	DIAMOND SCHMITT ARCHITECTS
Customer Name:	BOTHWELL ACCURATE GLAZING



Drawing Name: PLAN DETAIL	
Drawn By: SR	Checked By: NP
Drawn Date: 2026/01/12	Issue No.: 1
Scale: 1"=1"	Release Date: 2026/03/03
Drawing Number: C4-017	

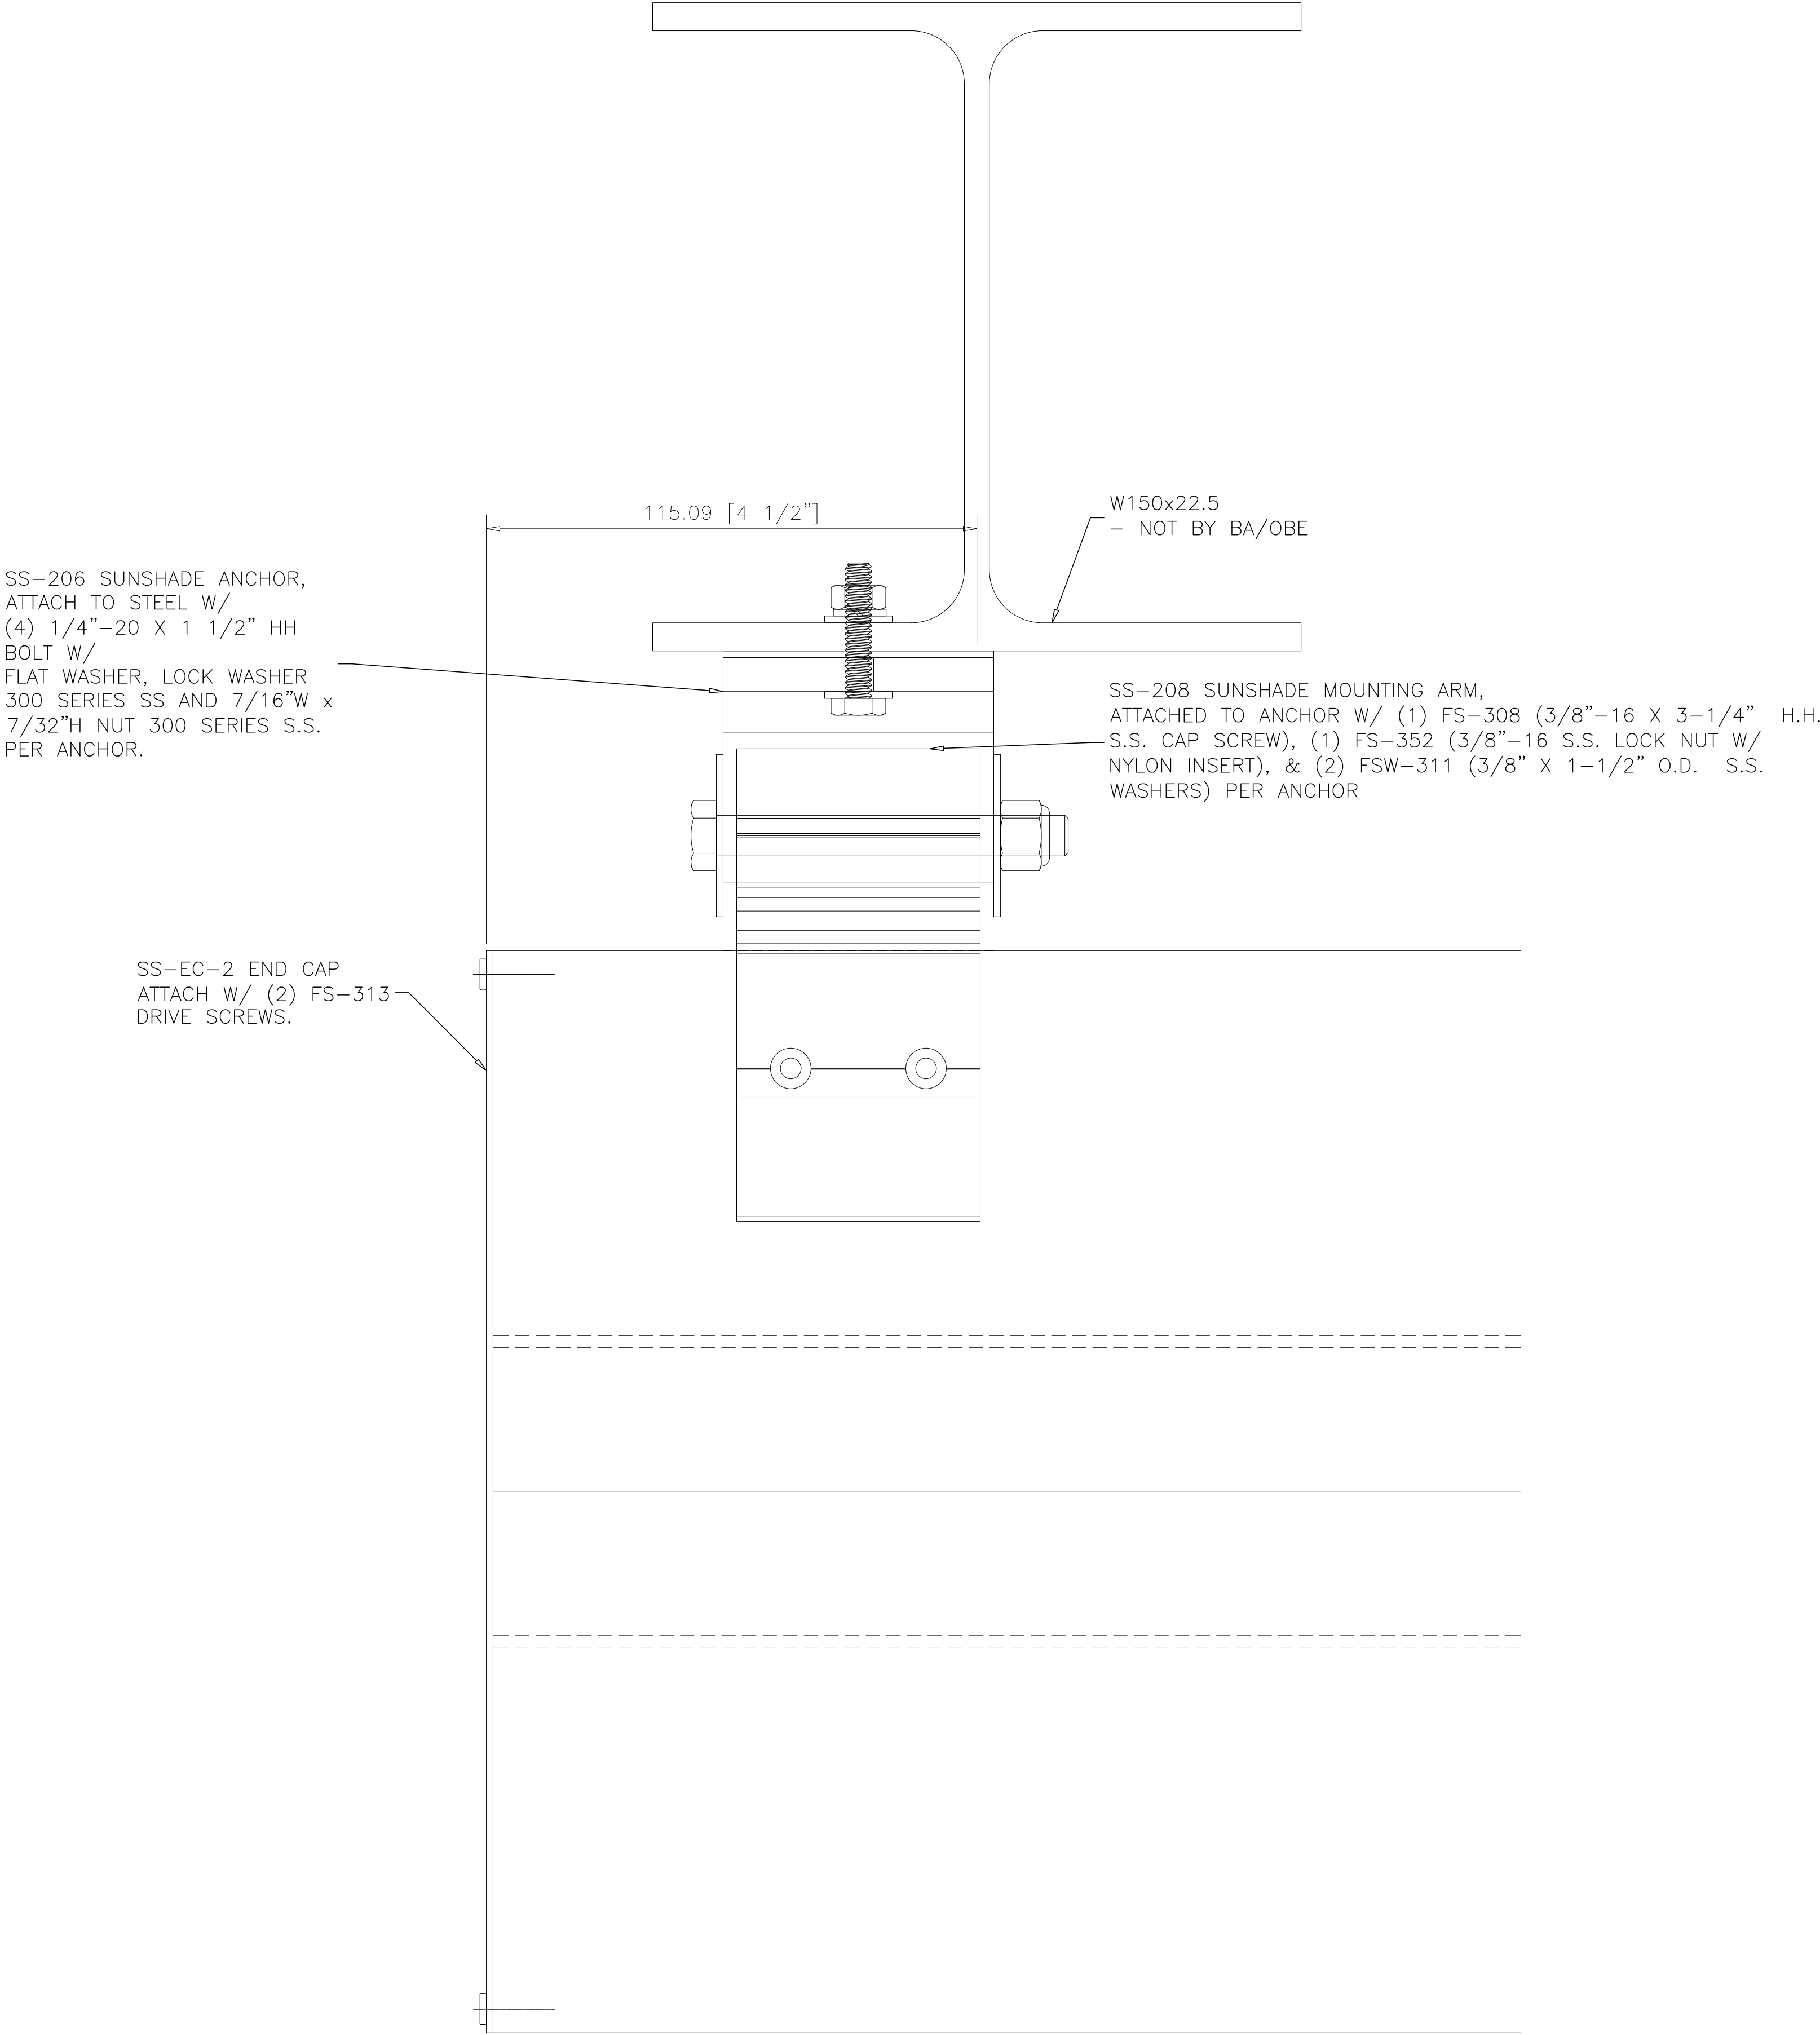

1
C4-018

JAMB VERTICAL
AT SUNSHADE

ARCH. REF.: N/A

REVISIONS			
No.	Description:	Date:	By:
1	Revised per arch. markups received Feb 11/26	03/03/26	SLR

Project Name: DOCKSTEADER PRPS	Project Location: BRAMPTON, ONTARIO	Architect Name: DIAMOND SCHMITT ARCHITECTS	Customer Name: BOTHWELL ACCURATE GLAZING
-----------------------------------	--	---	---




275 Britannia Road East • Mississauga • Ontario • Canada • L4Z2E7
905-890-6970 • oldcastlebe.com

Drawing Name:
PLAN DETAIL

Drawn By: SR	Checked By: NP
Drawn Date: 2026/01/12	Issue No.: 1
Scale: 1"=1"	Release Date: 2026/03/03

Drawing Number: C4-018

SS-206 SUNSHADE ANCHOR,
ATTACH TO STEEL W/
(4) 1/4"-20 X 1 1/2" HH
BOLT W/
FLAT WASHER, LOCK WASHER
300 SERIES SS AND 7/16"W x
7/32"H NUT 300 SERIES S.S.
PER ANCHOR.

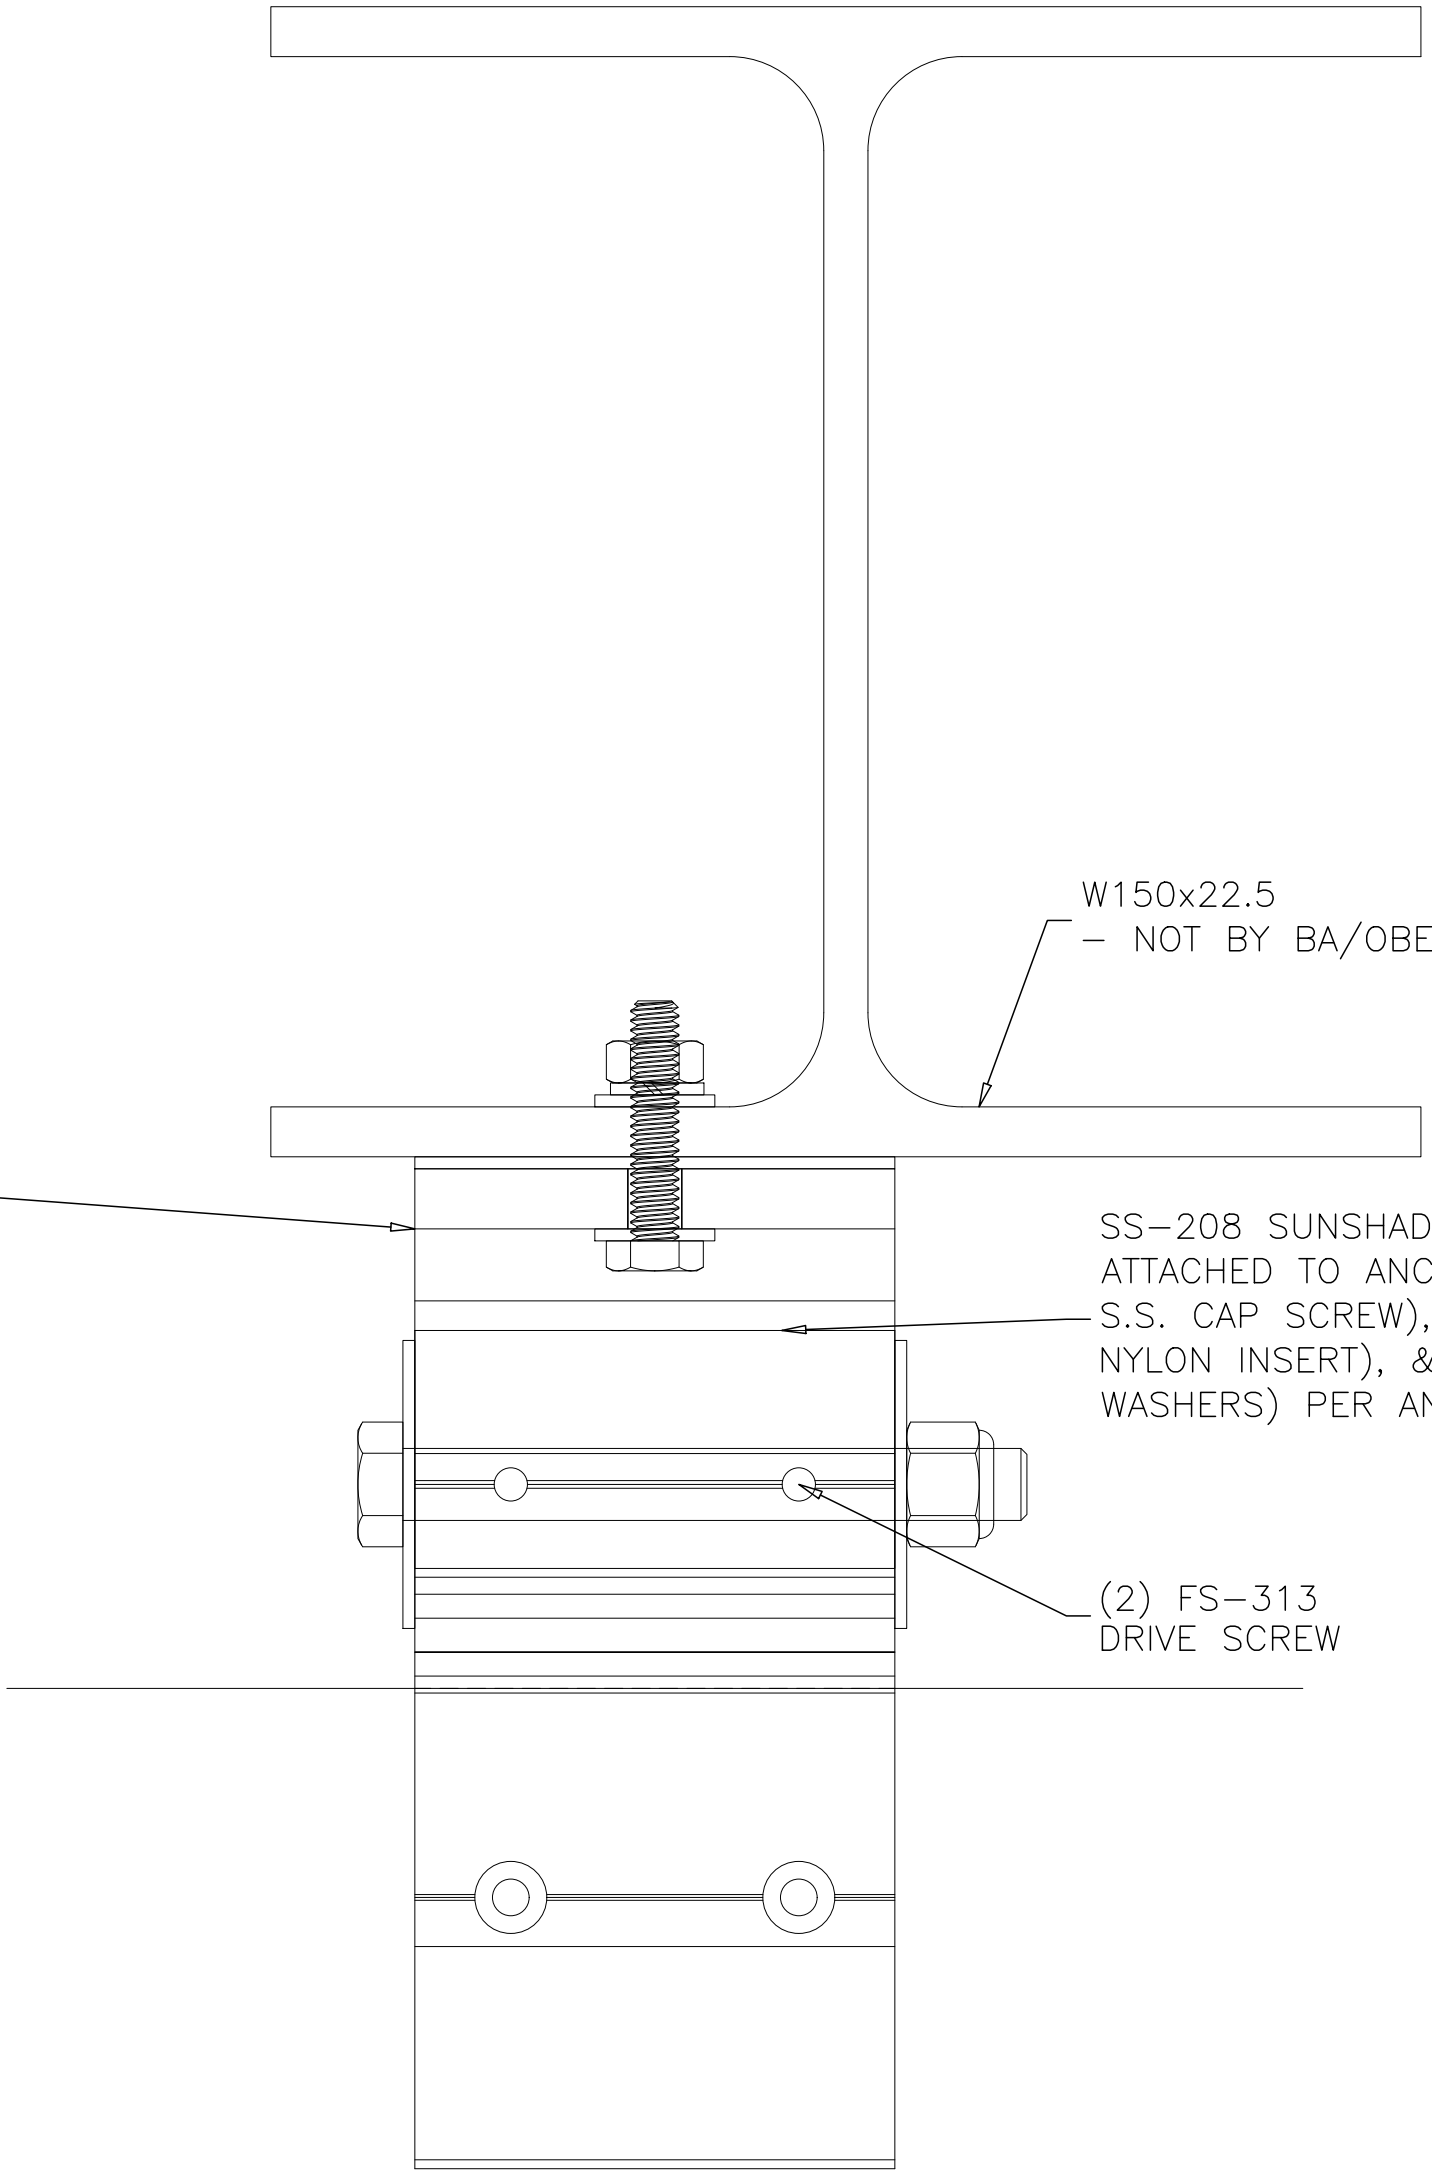

W150x22.5
- NOT BY BA/OBE

SS-208 SUNSHADE MOUNTING ARM,
ATTACHED TO ANCHOR W/ (1) FS-308 (3/8"-16 X 3-1/4" H.H.
S.S. CAP SCREW), (1) FS-352 (3/8"-16 S.S. LOCK NUT W/
NYLON INSERT), & (2) FSW-311 (3/8" X 1-1/2" O.D. S.S.
WASHERS) PER ANCHOR

(2) FS-313
DRIVE SCREW



1
C4-018A


INT. VERTICAL
AT SUNSHADE

ARCH. REF.: N/A

REVISIONS			
No.	Description:	Date:	By:
1	Revised per arch. markups received Feb 11/26	03/03/26	SLR

Project Name: DOCKSTEADER PRPS	Project Location: BRAMPTON, ONTARIO	Architect Name: DIAMOND SCHMITT ARCHITECTS	Customer Name: BOTHWELL ACCURATE GLAZING
-----------------------------------	--	---	---

Oldcastle BuildingEnvelope®

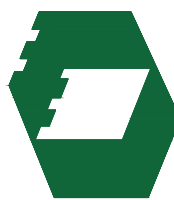


275 Britannia Road East • Mississauga • Ontario • Canada • L4Z2E7
905-890-6970 • oldcastlebe.com

Drawing Name:
PLAN DETAIL

Drawn By: SR	Checked By: NP
Drawn Date: 2026/01/12	Issue No.: 1
Scale: 1"=1"	Release Date: 2026/03/03

Drawing Number: C4-018A

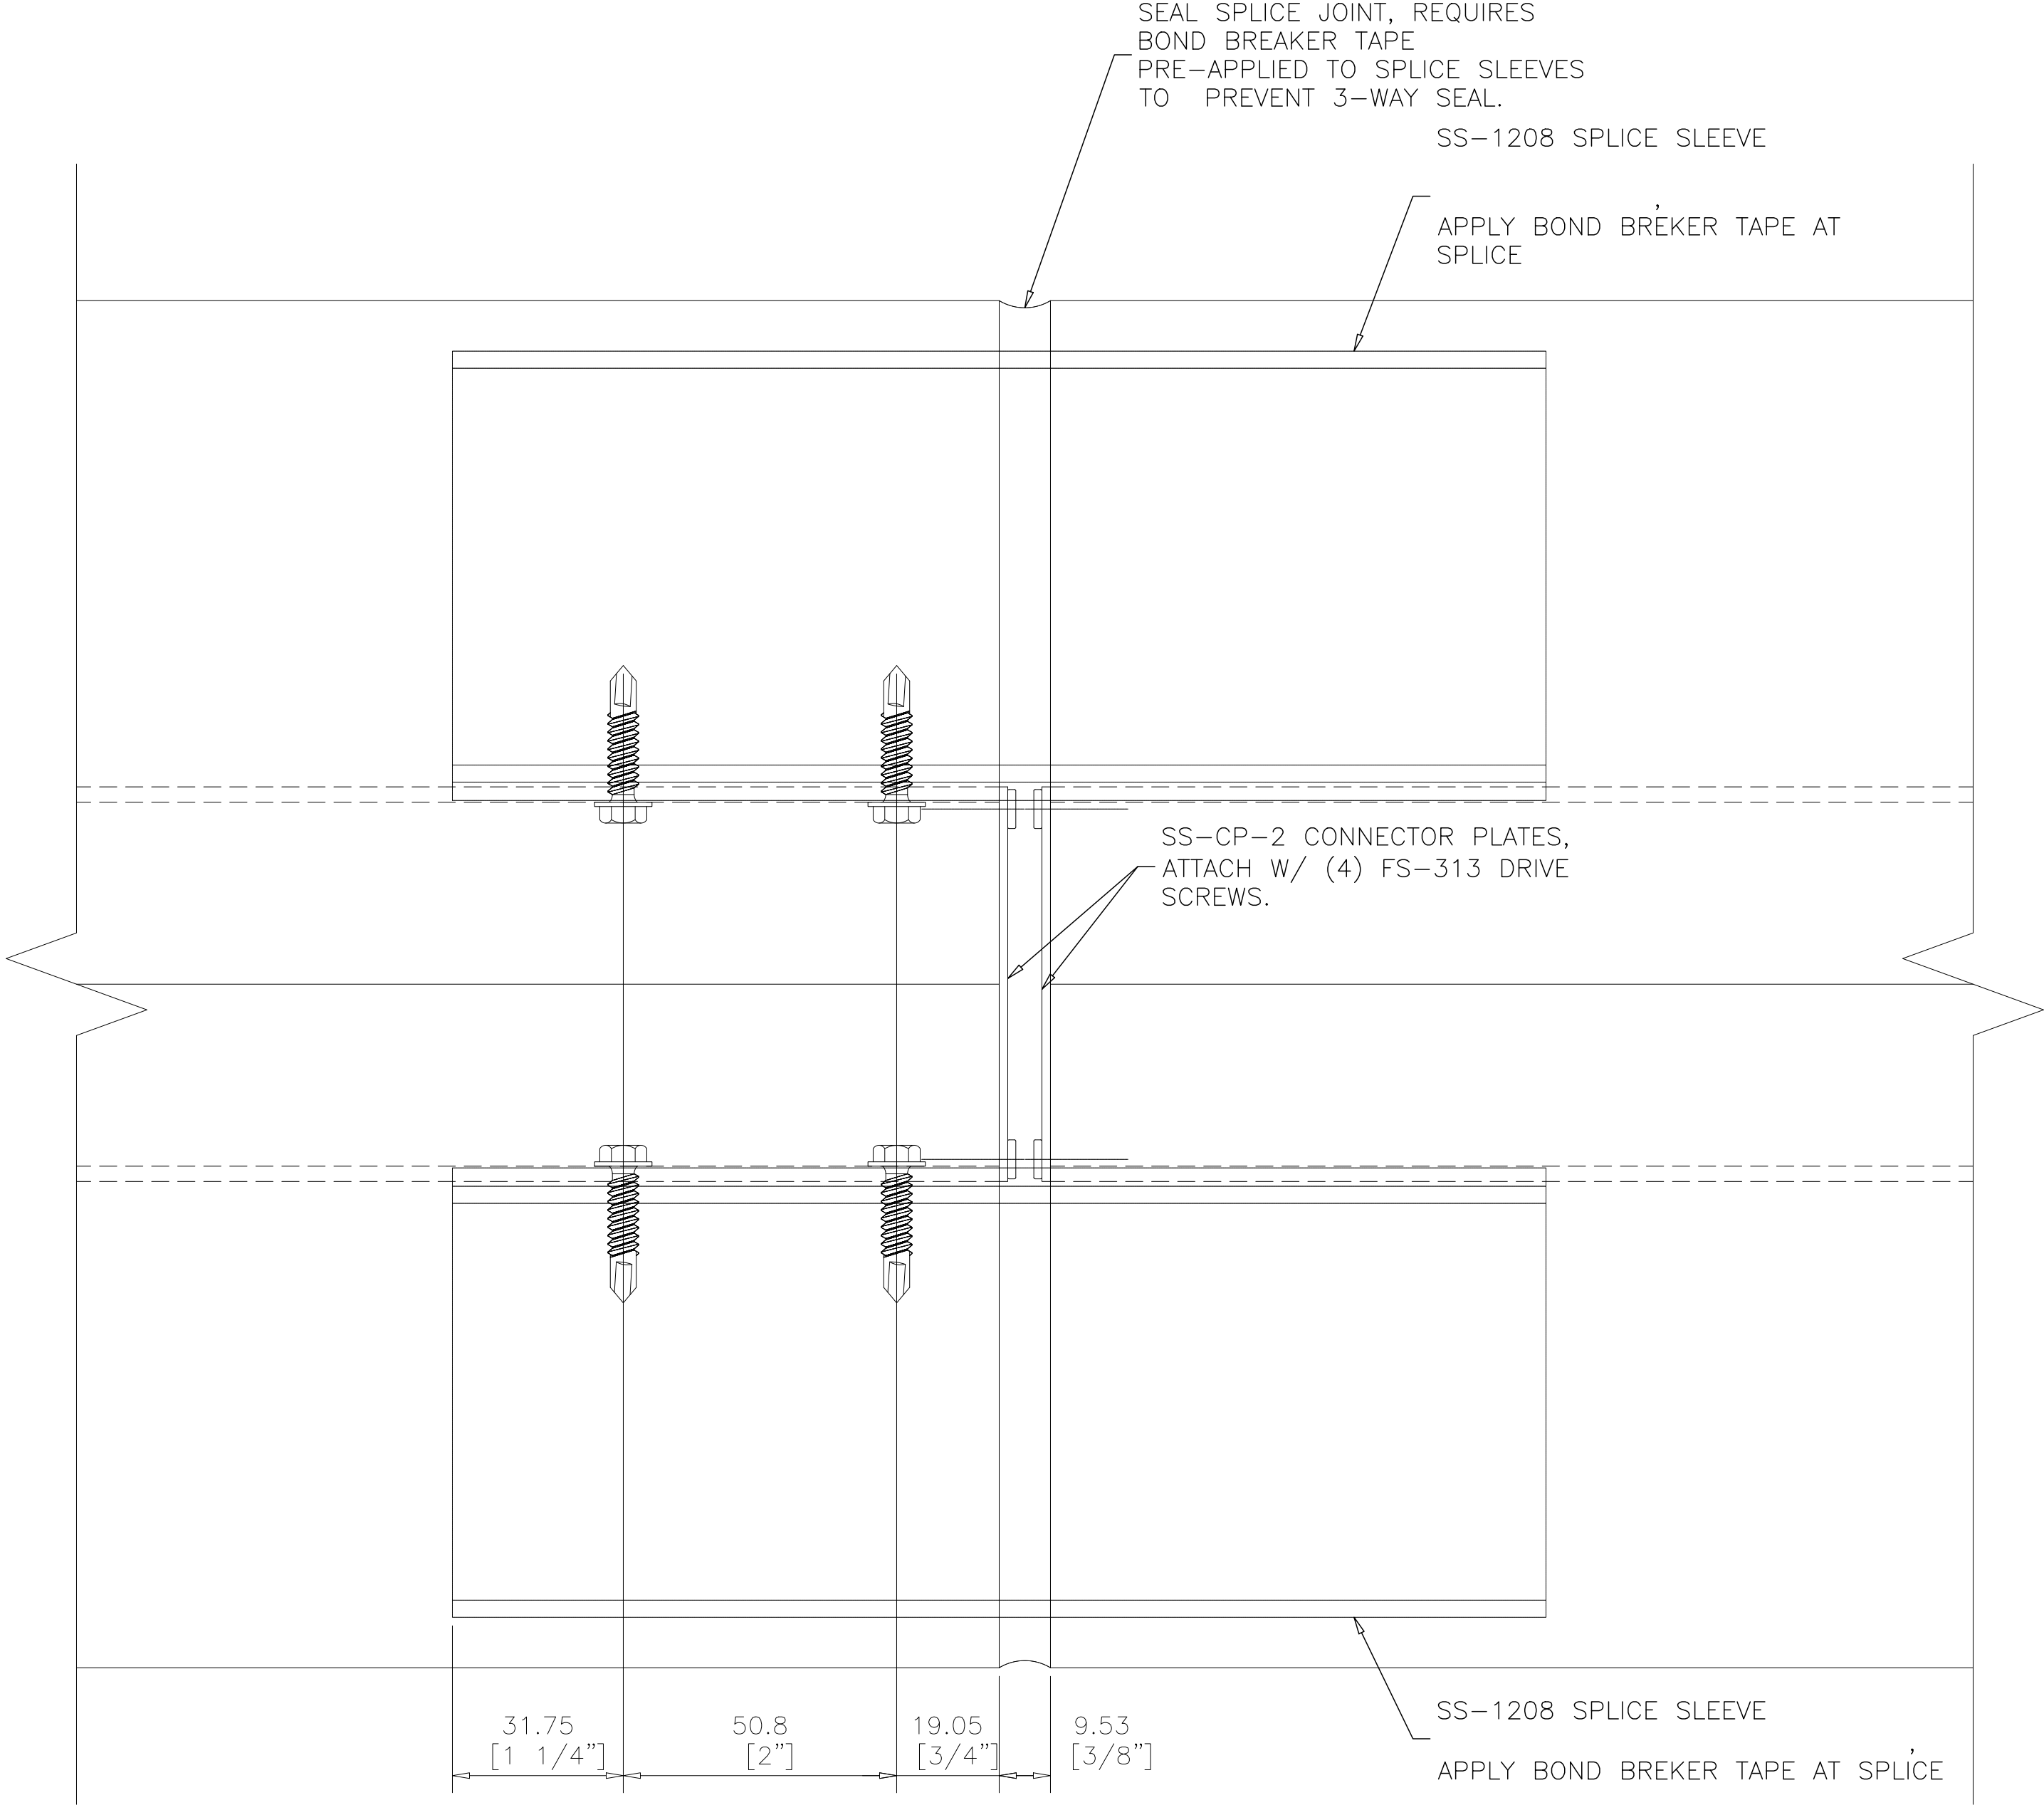

1
C4-018B

INT. VERTICAL
AT SUNSHADE SPLICE

ARCH. REF.: N/A

REVISIONS			
No.	Description:	Date:	By:
1	Revised per arch. markups received Feb 11/26	03/03/26	SLR

Project Name: DOCKSTEADER PRPS	Project Location: BRAMPTON, ONTARIO	Architect Name: DIAMOND SCHMITT ARCHITECTS	Customer Name: BOTHWELL ACCURATE GLAZING
-----------------------------------	--	---	---




275 Britannia Road East • Mississauga • Ontario • Canada • L4Z2E7
905-890-6970 • oldcastlebe.com

Drawing Name:
PLAN DETAIL

Drawn By: SR	Checked By: NP
Drawn Date: 2026/01/12	Issue No.: 1
Scale: 1"=1"	Release Date: 2026/03/03

Drawing Number: C4-018B

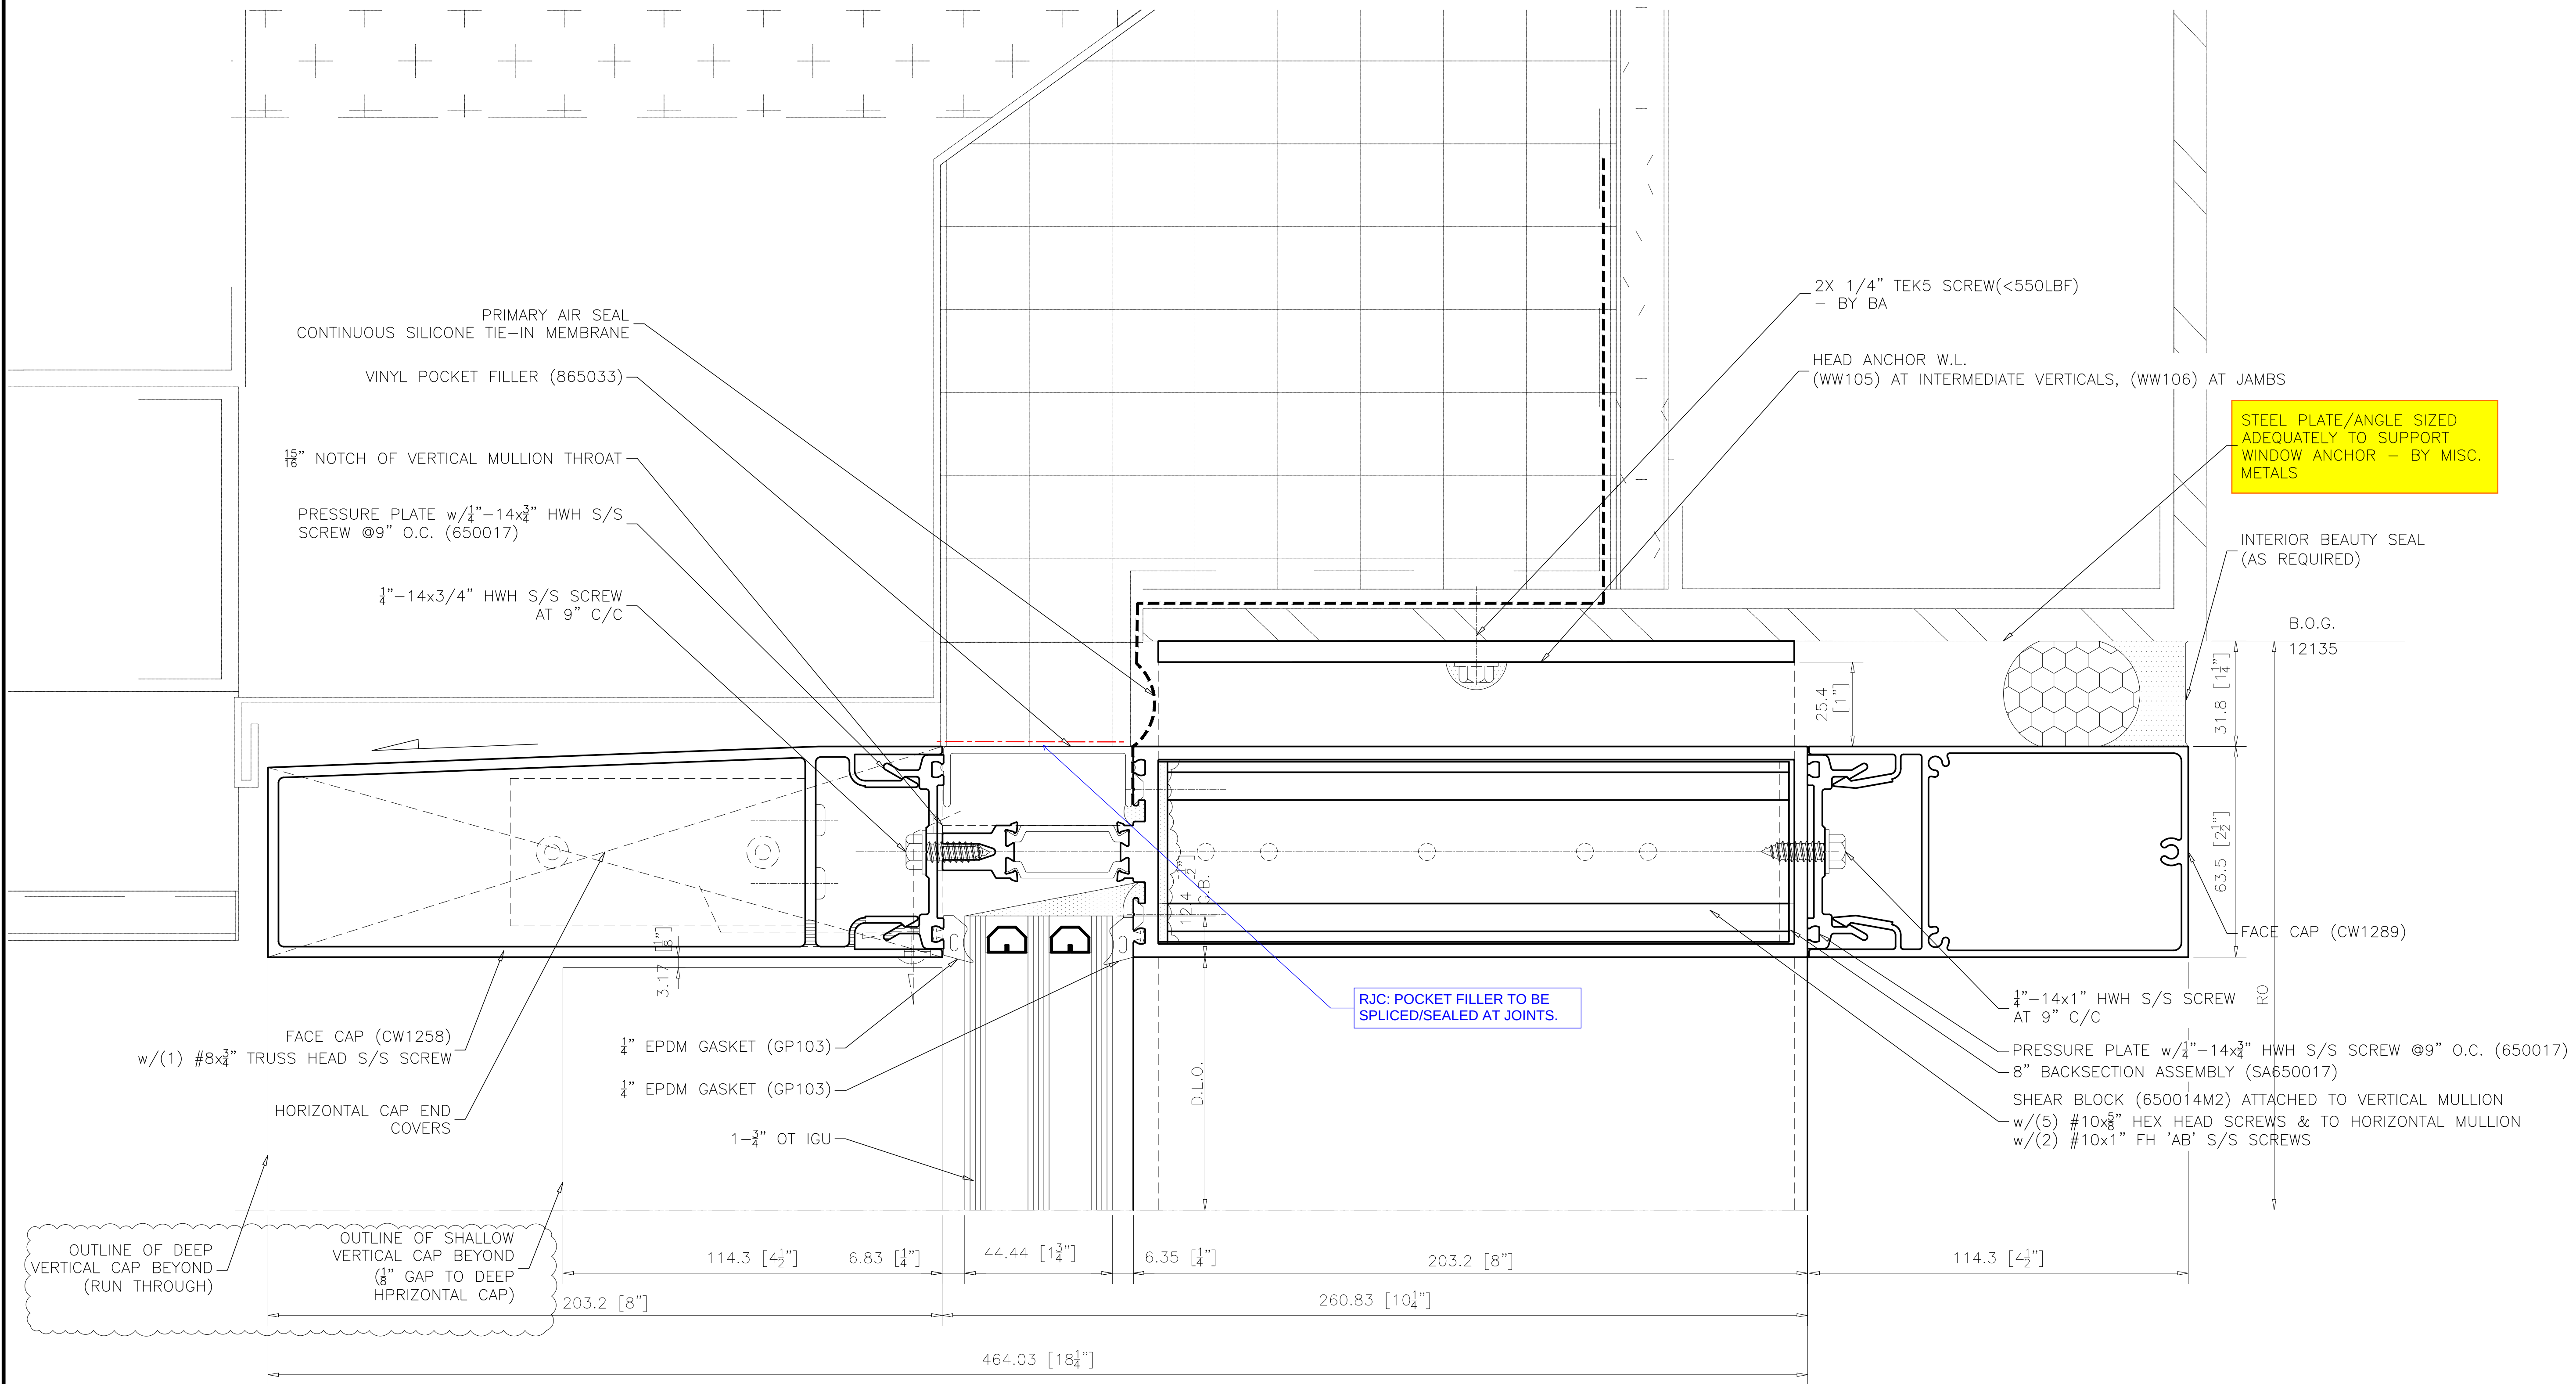

1
C5-001

HEAD HORIZONTAL 8" CAP 8" B.S.
AT VISION GLAZING

ARCH. REF.: 4/A454

REVISIONS


No.	Description:	Date:	By:
1	Revised per arch. markups received Feb 11/26	03/03/26	SLR

Project Name: DOCKSTEADER PRPS	Project Location: BRAMPTON, ONTARIO	Architect Name: DIAMOND SCHMITT ARCHITECTS	Customer Name: BOTHWELL ACCURATE GLAZING
-----------------------------------	--	---	---

Oldcastle BuildingEnvelope®

275 Britannia Road East • Mississauga • Ontario • Canada • L4Z2E7
905-890-6970 • oldcastlebe.com

Drawing Name: SECTION DETAIL			
Drawn By: SR	Checked By: NP		
Drawn Date: 2026/01/12	Issue No.: 1		
Scale: 1"=1'	Release Date: 2026/03/03		
Drawing Number:		C5-001	

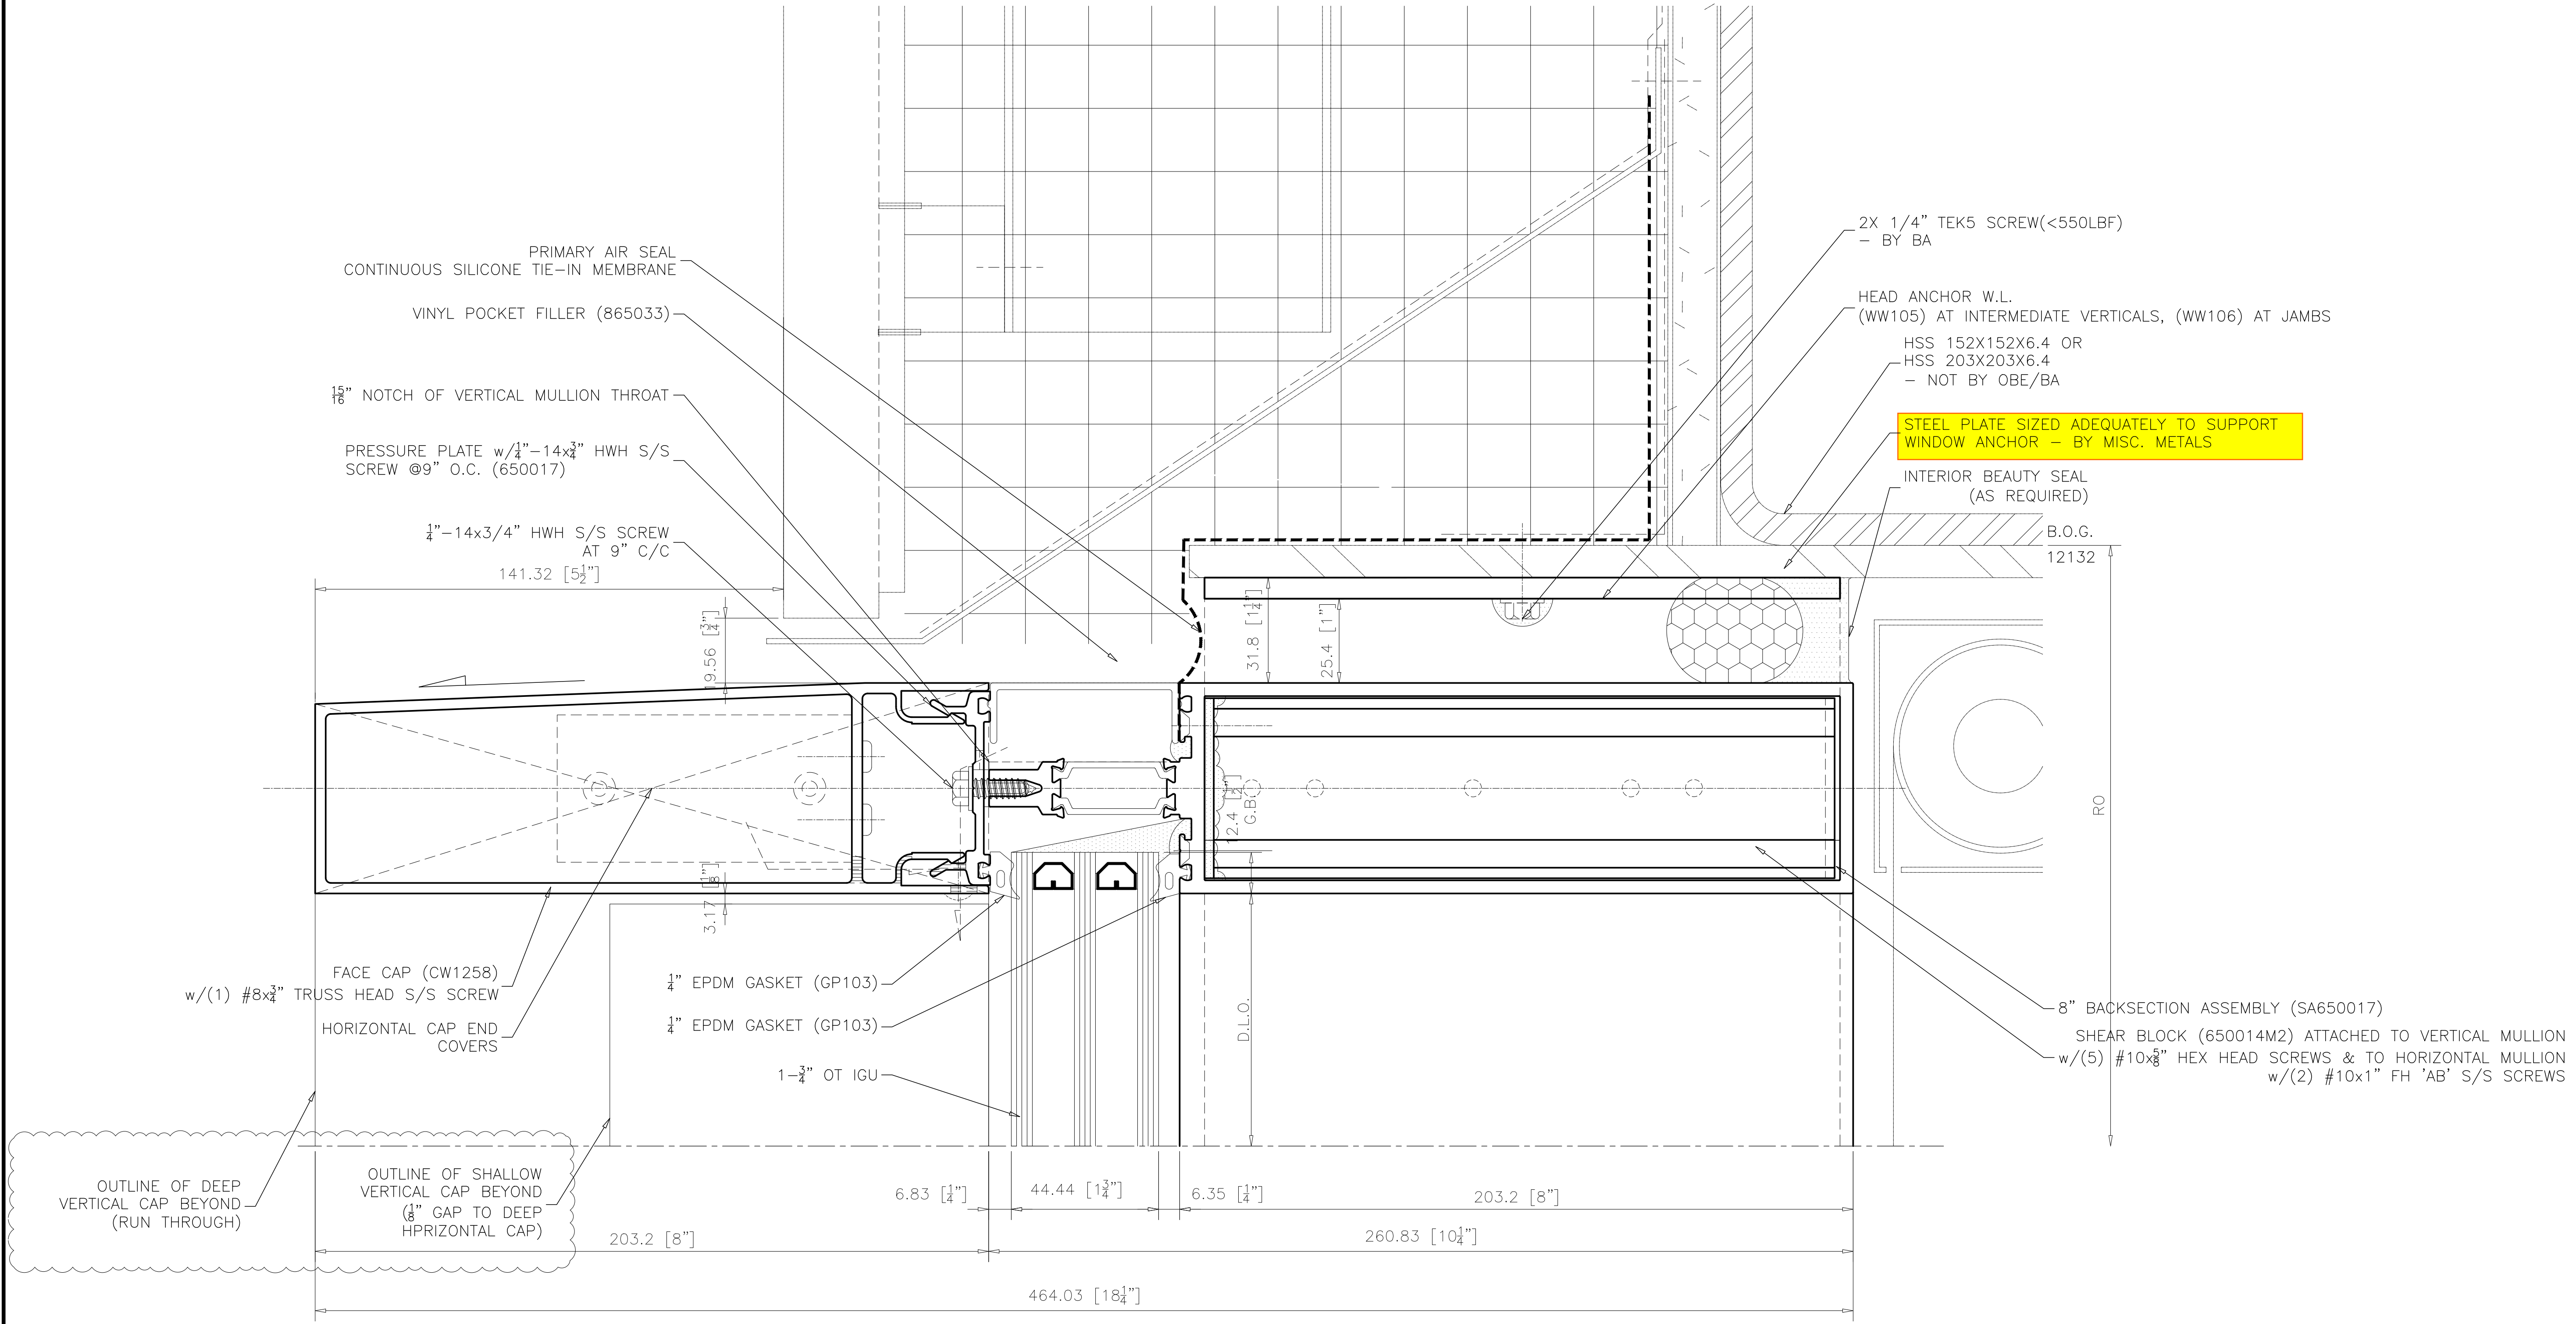

1
C5-001A

HEAD HORIZONTAL 8" CAP 8" B.S.
AT VISION GLAZING

ARCH. REF.: 4/A454

REVISIONS				
No.	Description:	Date:	By:	
1	Revised per arch. markups received Feb 11/26	03/03/26	SLR	

Project Name: DOCKSTEADER PRPS	Project Location: BRAMPTON, ONTARIO	Architect Name: DIAMOND SCHMITT ARCHITECTS	Customer Name: BOTHWELL ACCURATE GLAZING
-----------------------------------	--	---	---

Oldcastle BuildingEnvelope®

275 Britannia Road East • Mississauga • Ontario • Canada • L4Z2E7
905-890-6970 • oldcastlebe.com

Drawing Name: SECTION DETAIL			
Drawn By: SR	Checked By: NP		
Drawn Date: 2026/01/12	Issue No.: 1		
Scale: 1"=1'	Release Date: 2026/03/03		
Drawing Number:		C5-001A	