


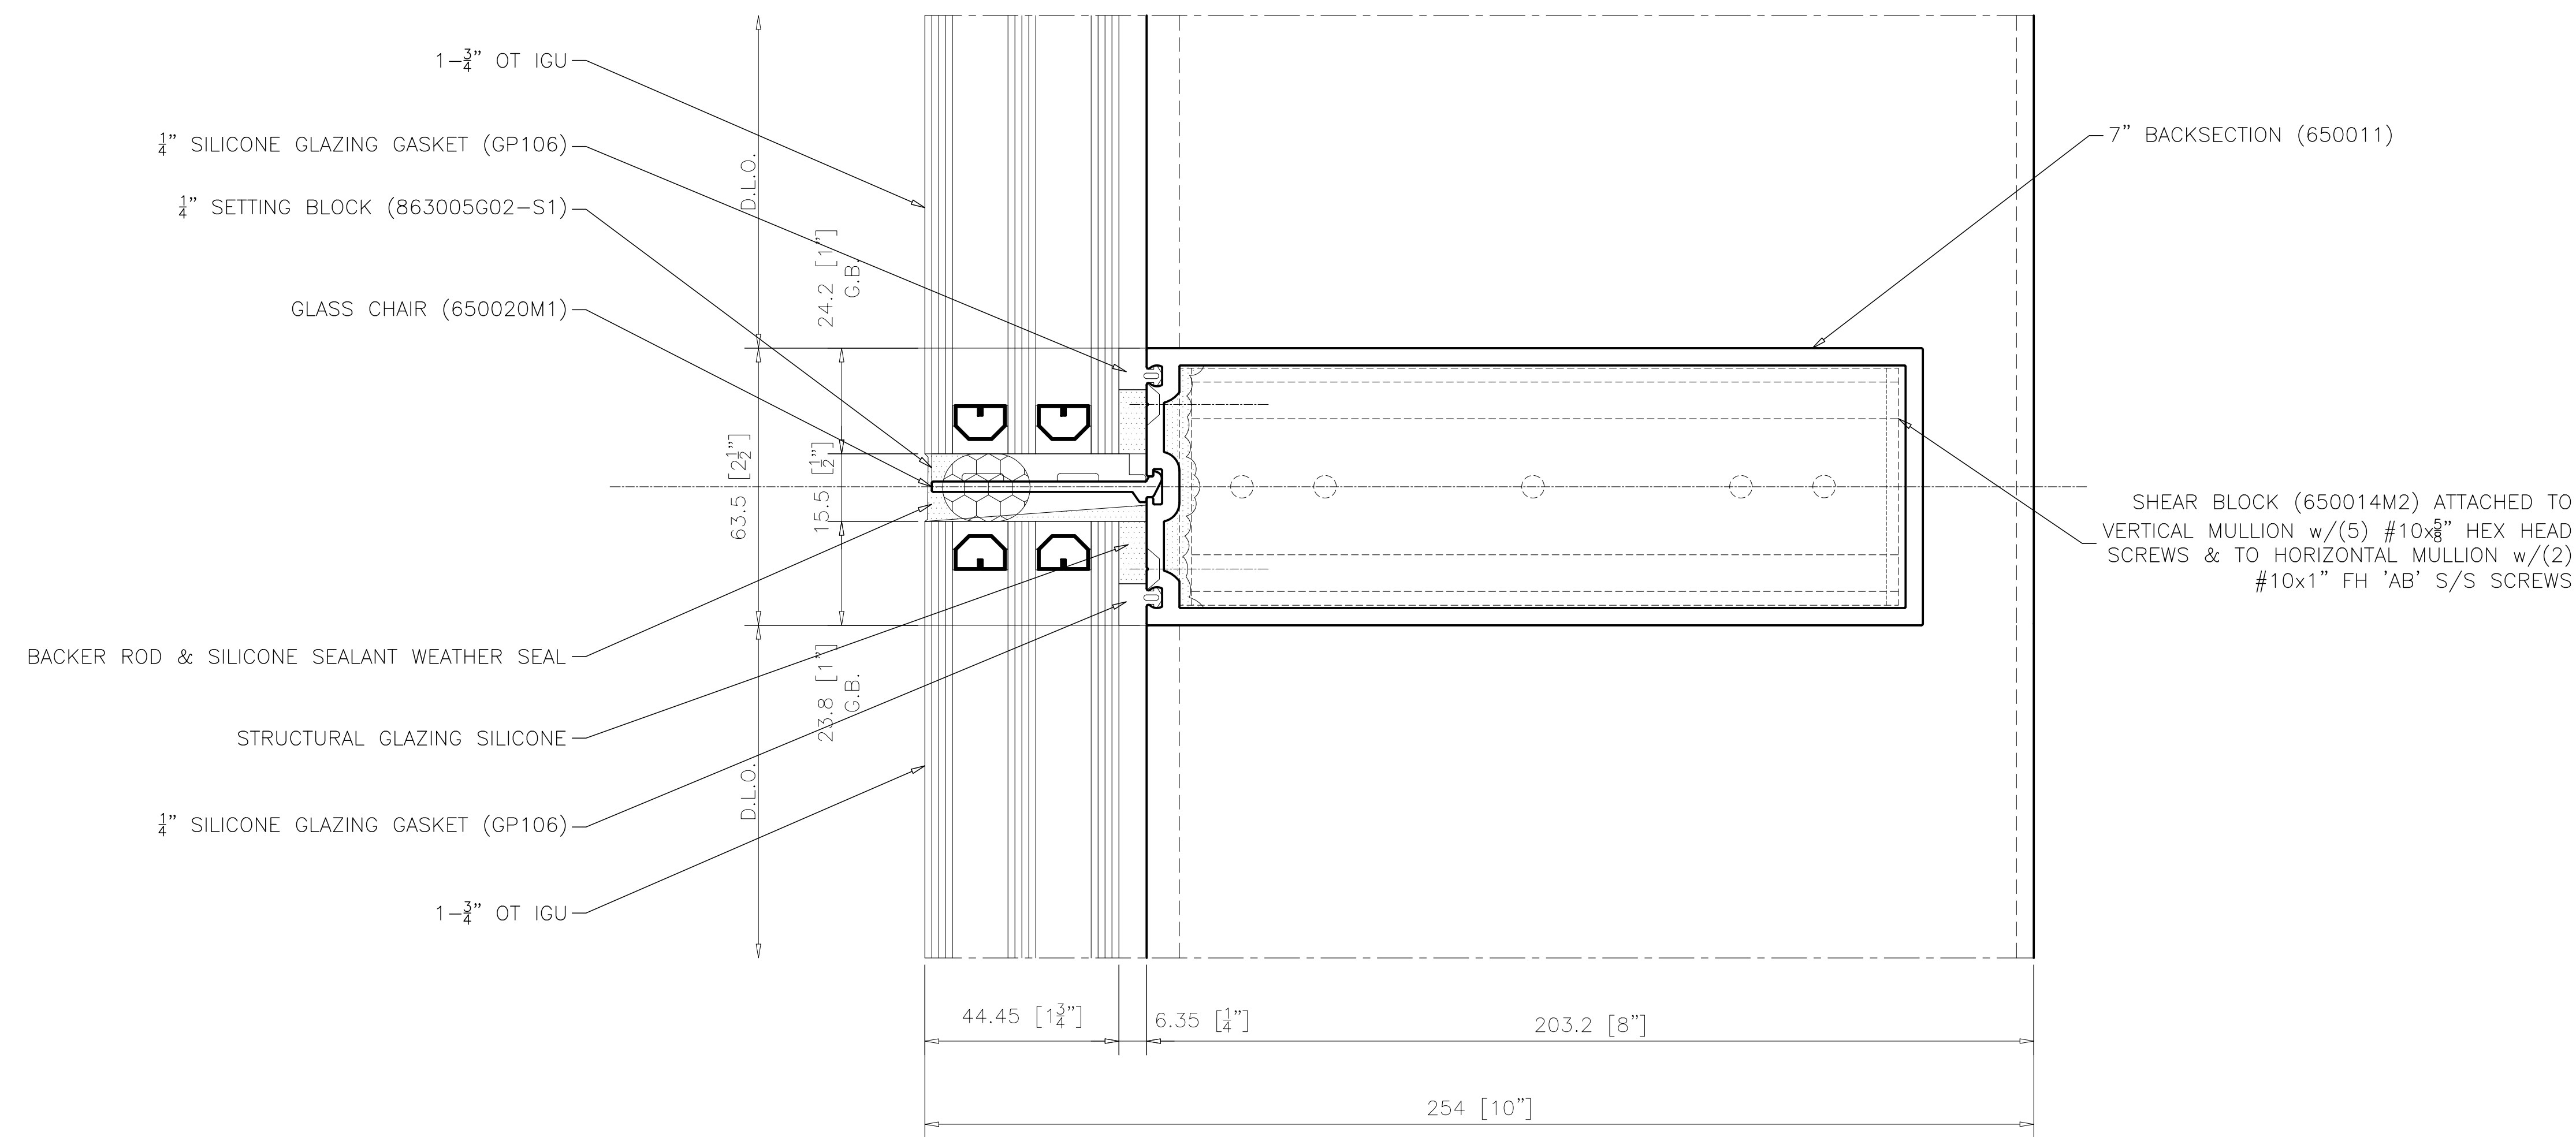

1
C5-002

INTERMEDIATE HORIZONTAL SSG 7" B.S.
AT VISION GL-1A ABOVE VISION GL-1A

ARCH. REF.: N/A

REVISIONS			
No.	Description:	Date:	By:
1	Revised per arch. markups received Feb 11/26	03/03/26	SLR

Project Name:
DOCKSTEADER PRPS

Project Location:
BRAMPTON, ONTARIO

Architect Name:
DIAMOND SCHMITT ARCHITECTS

Customer Name:
BOTHWELL ACCURATE GLAZING




275 Britannia Road East • Mississauga • Ontario • Canada • L4Z2E7
905-890-6970 • oldcastlebe.com

Drawing Name:
SECTION DETAIL

Drawn By: SR	Checked By: NP
Drawn Date: 2026/01/12	Issue No.: 1
Scale: 1/2"=1"	Release Date: 2026/03/03

Drawing Number:
C5-002

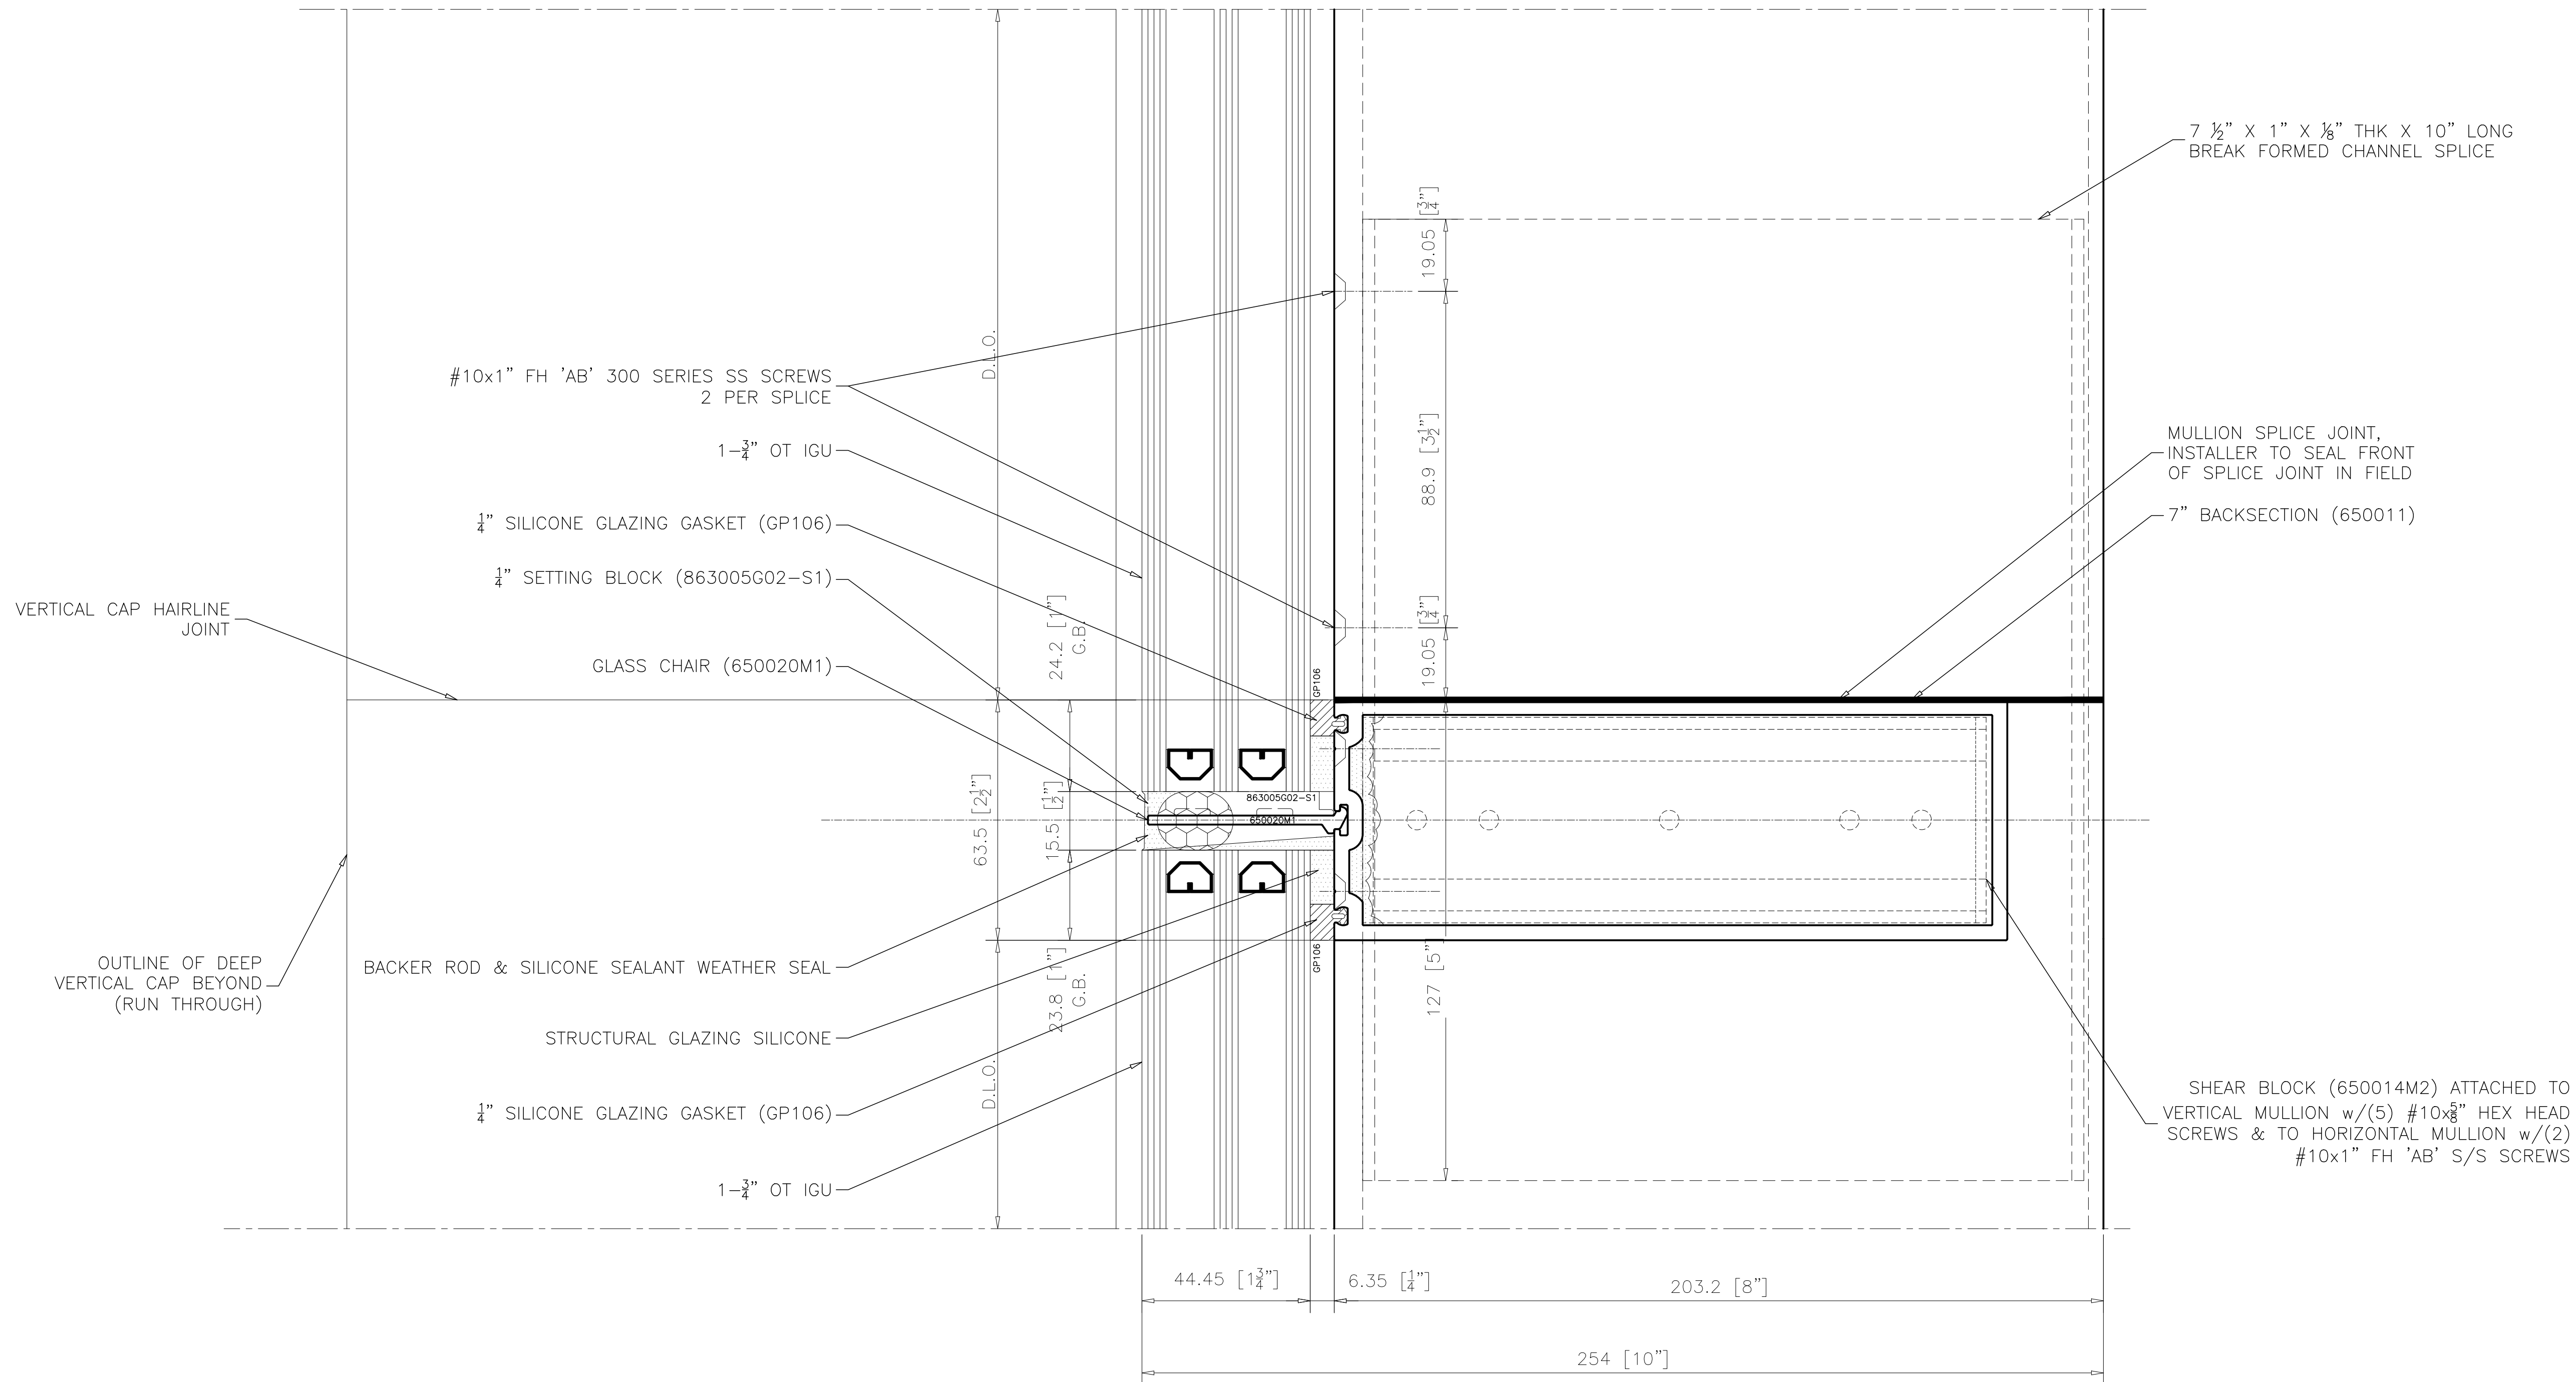

1
C5-002A

INTERMEDIATE HORIZONTAL SSG 7" B.S. @ SPLICE
AT VISION GL-1A ABOVE VISION GL-1A

ARCH. REF.: N/A


REVISIONS			
No.	Description:	Date:	By:
1	Revised per arch. markups received Feb 11/26	03/03/26	SLR

Project Name: DOCKSTEADER PRPS	Project Location: BRAMPTON, ONTARIO	Architect Name: DIAMOND SCHMITT ARCHITECTS	Customer Name: BOTHWELL ACCURATE GLAZING
-----------------------------------	--	---	---



275 Britannia Road East • Mississauga • Ontario • Canada • L4Z2E7
905-890-6970 • oldcastlebe.com

Drawing Name: SECTION DETAIL	
Drawn By: SR	Checked By: NP
Drawn Date: 2026/01/12	Issue No.: 1
Scale: 1/2"=1"	Release Date: 2026/03/03
Drawing Number: C5-002A	

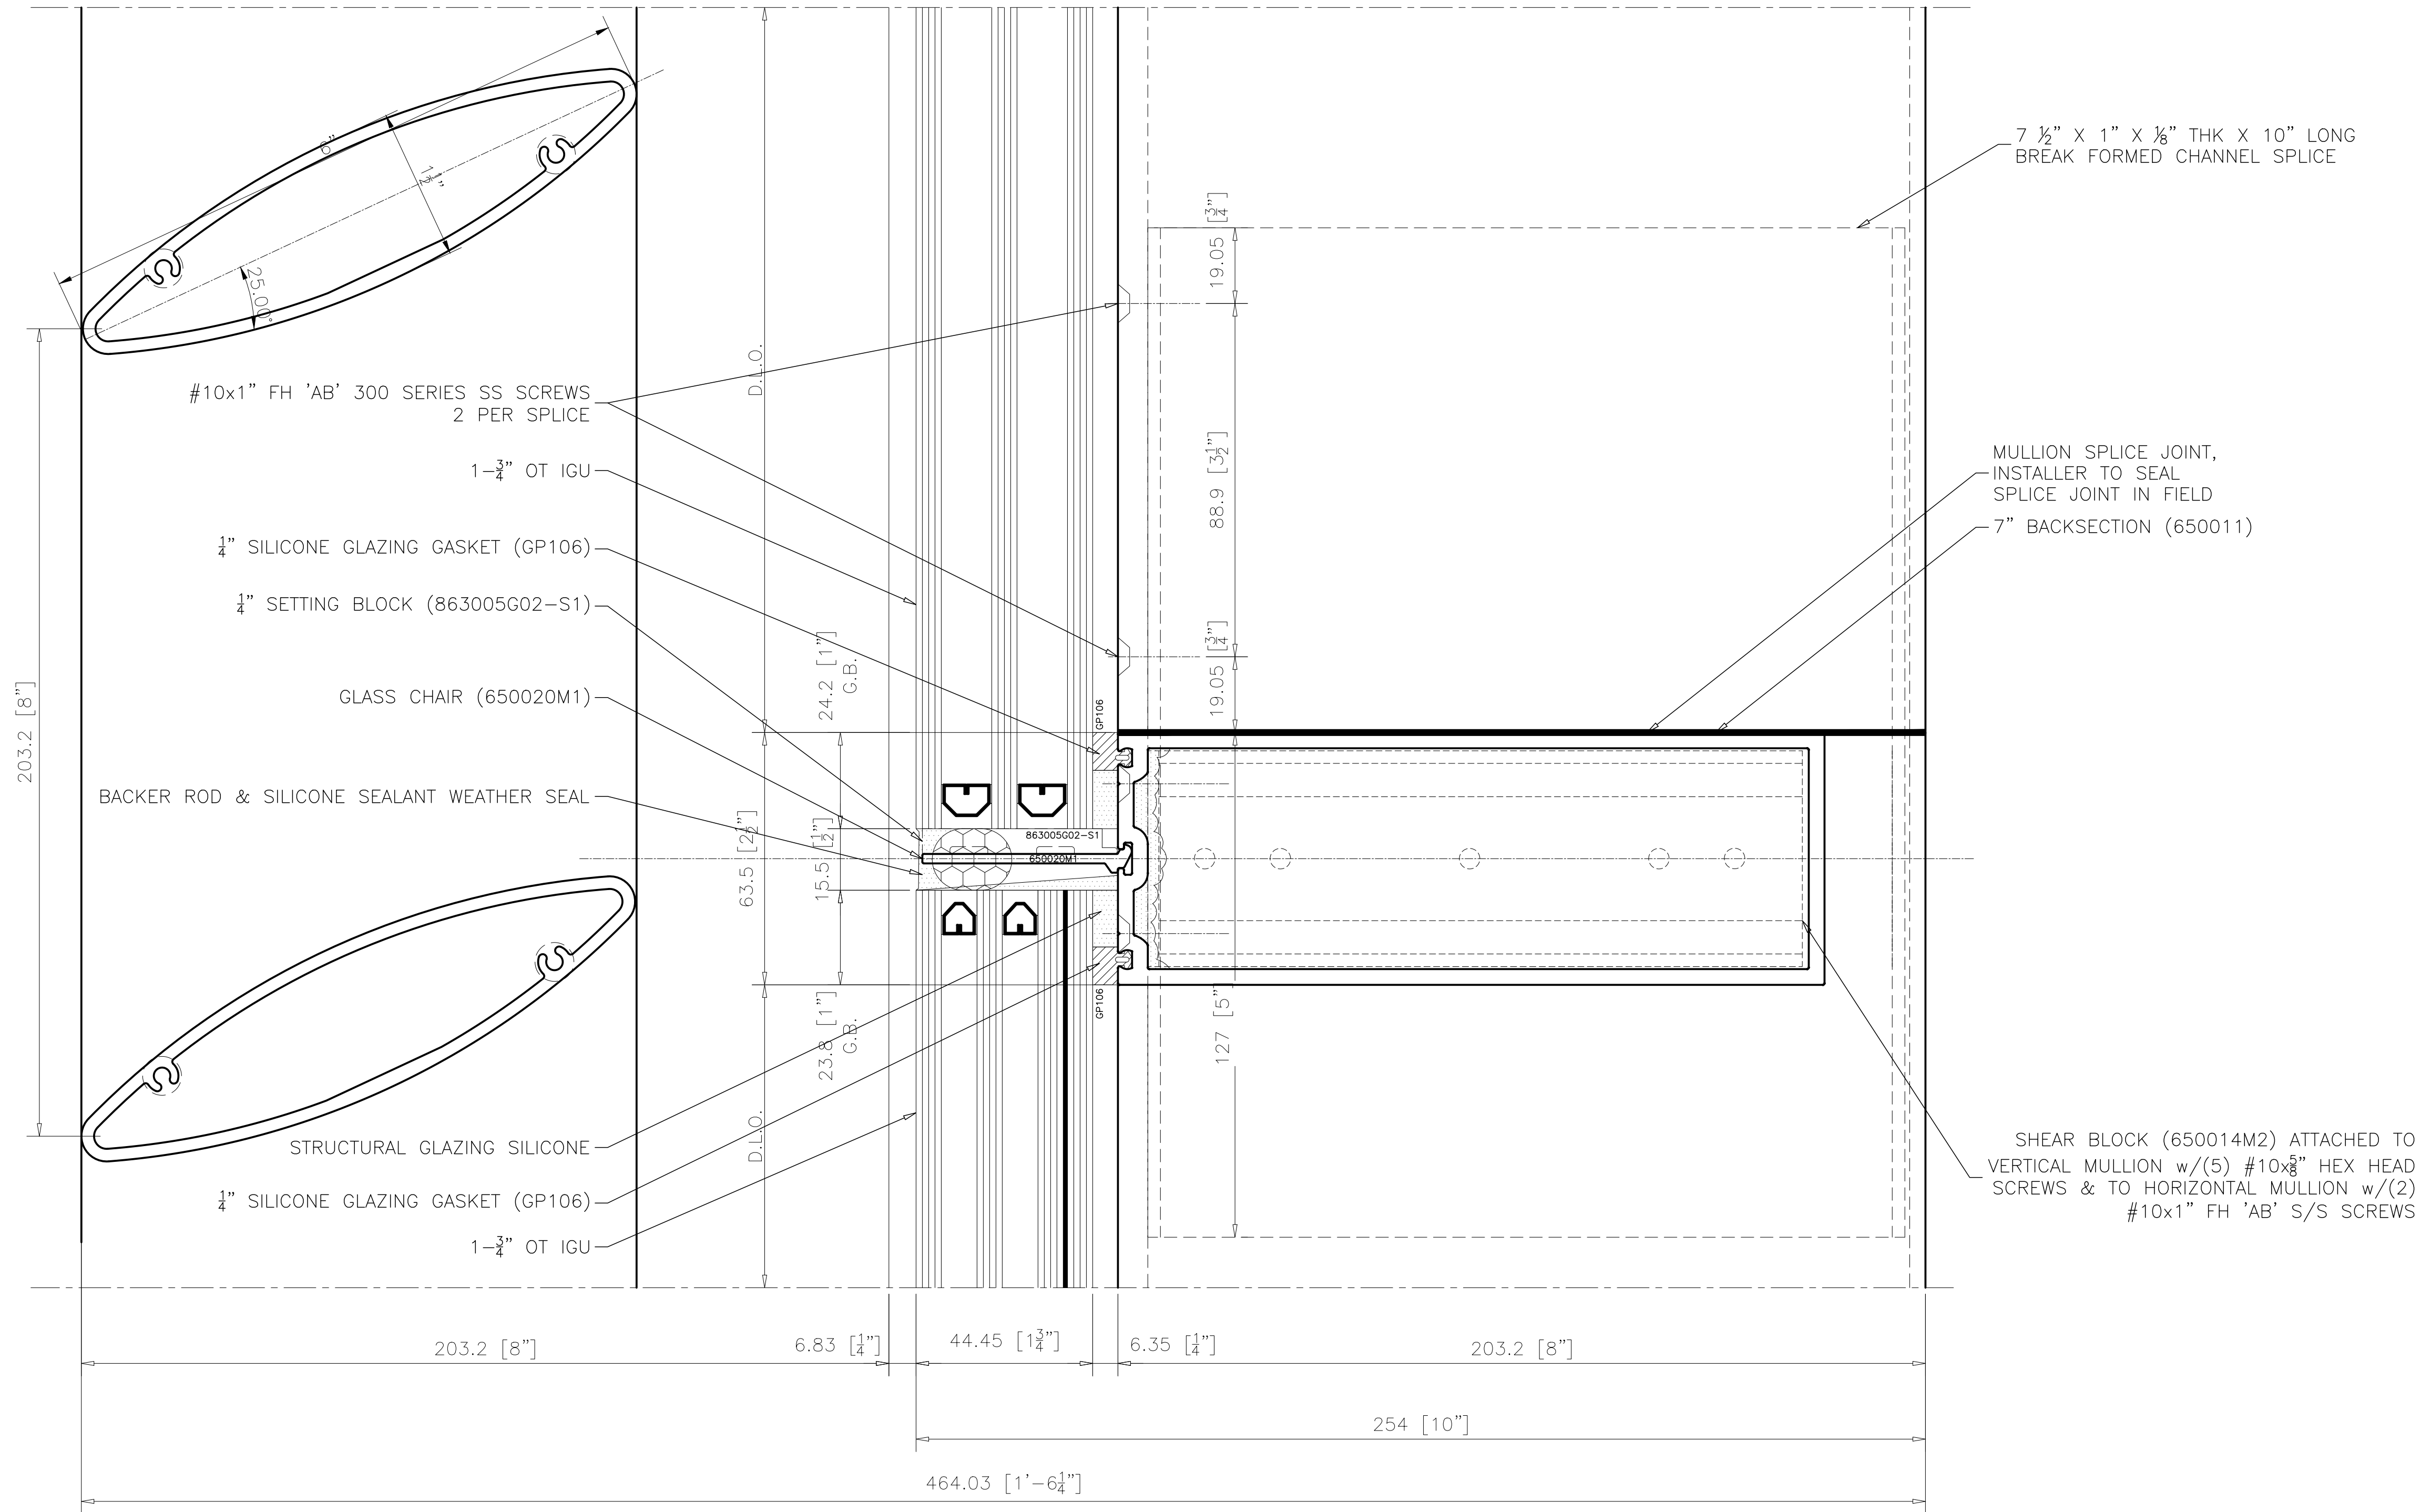


**INTERMEDIATE HORIZONTAL SSG 7" B.S. @ SPLICE
AT VISION GL-1A ABOVE VISION GL-1B**

C5-002B ARCH. REF.: 3/A703


REVISIONS			
No.	Description:	Date:	By:
1	Revised per arch. markups received Feb 11/26	03/03/26	SLR

Project Name: DOCKSTEADER PRPS	Project Location: BRAMPTON, ONTARIO	Architect Name: DIAMOND SCHMITT ARCHITECTS	Customer Name: BOTHWELL ACCURATE GLAZING
-----------------------------------	--	---	---

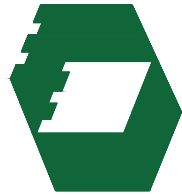**oldcastle** BuildingEnvelope[®]

275 Britannia Road East • Mississauga • Ontario • Canada • L4Z2E7
905-890-6970 • oldcastlebe.com

Drawing Name: SECTION DETAIL	
Drawn By: SR	Checked By: NP
Drawn Date: 2026/01/12	Issue No.: 1
Scale: 1/2"=1"	Release Date: 2026/03/03
Drawing Number: C5-002B	

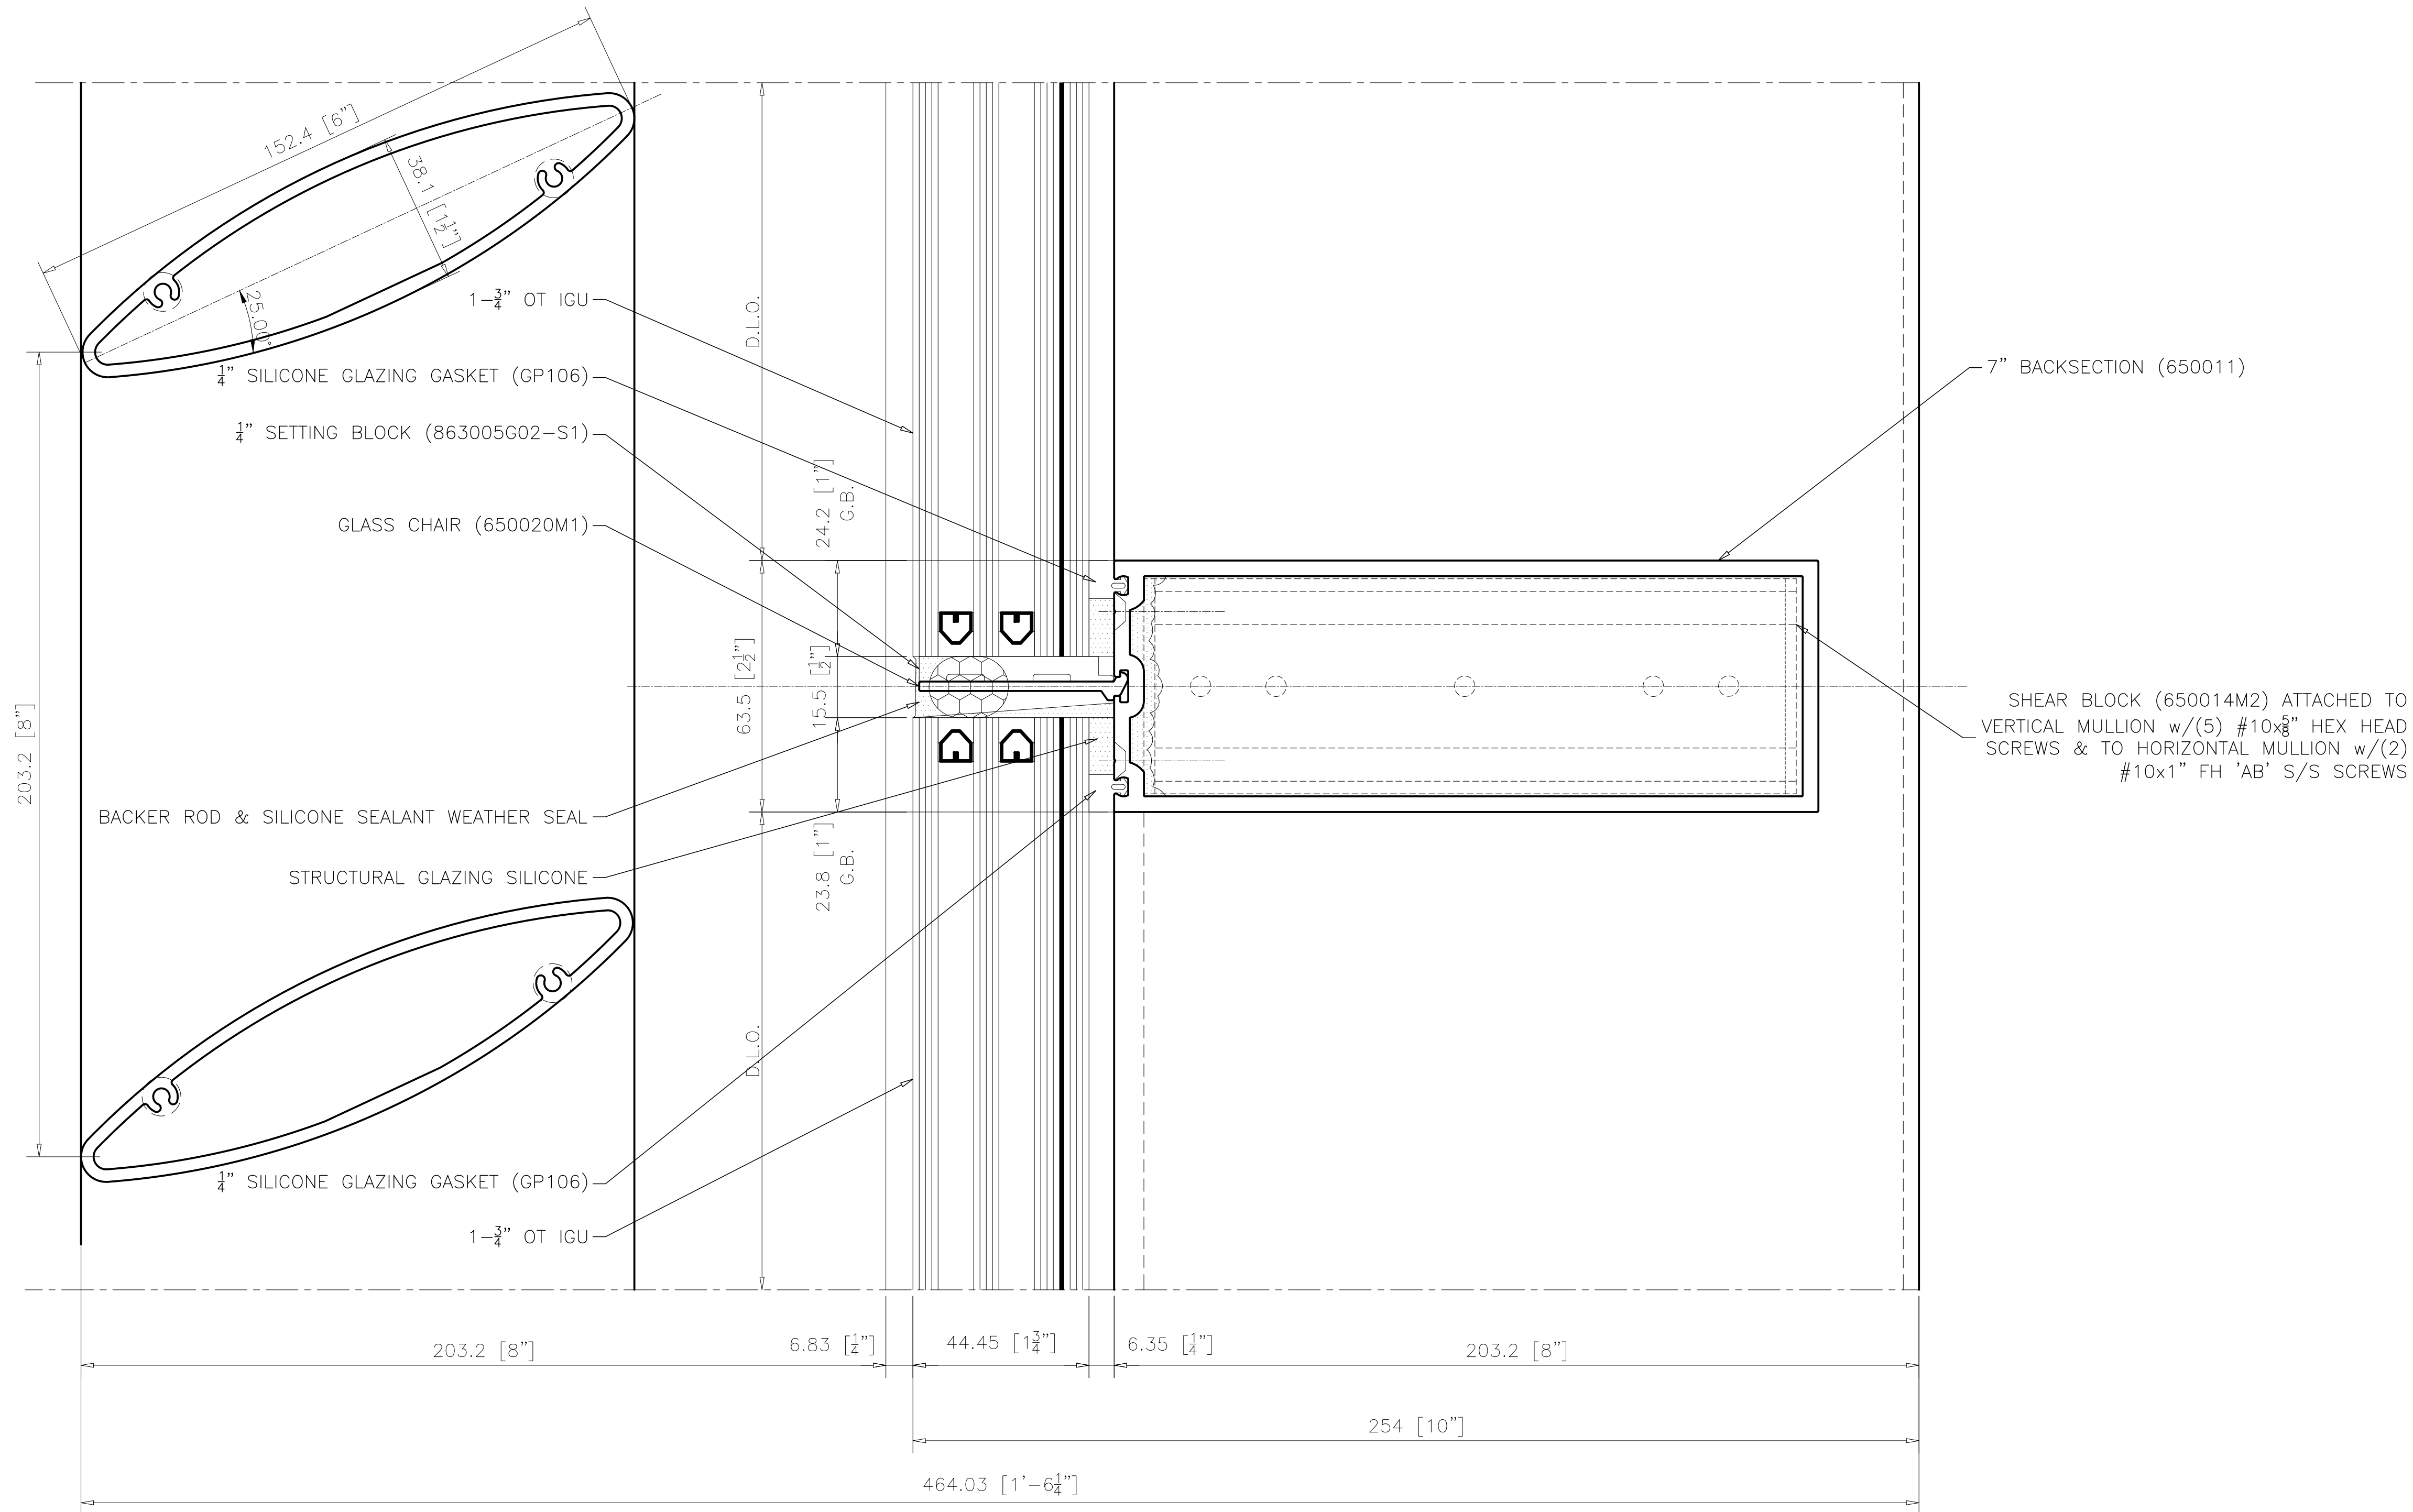


1
C5-002C

INTERMEDIATE HORIZONTAL SSG 7" B.S. @ SPLICE
AT VISION GL-1B ABOVE VISION GL-1B

ARCH. REF.: 3/A703


REVISIONS			
No.	Description:	Date:	By:
1	Revised per arch. markups received Feb 11/26	03/03/26	SLR

Project Name: DOCKSTEADER PRPS	Project Location: BRAMPTON, ONTARIO	Architect Name: DIAMOND SCHMITT ARCHITECTS	Customer Name: BOTHWELL ACCURATE GLAZING
-----------------------------------	--	---	---

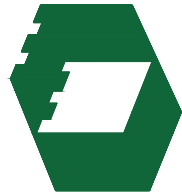**oldcastle BuildingEnvelope®**

275 Britannia Road East • Mississauga • Ontario • Canada • L4Z2E7
905-890-6970 • oldcastlebe.com

Drawing Name: SECTION DETAIL	
Drawn By: SR	Checked By: NP
Drawn Date: 2026/01/12	Issue No.: 1
Scale: 1/2"=1"	Release Date: 2026/03/03
Drawing Number: C5-002C	

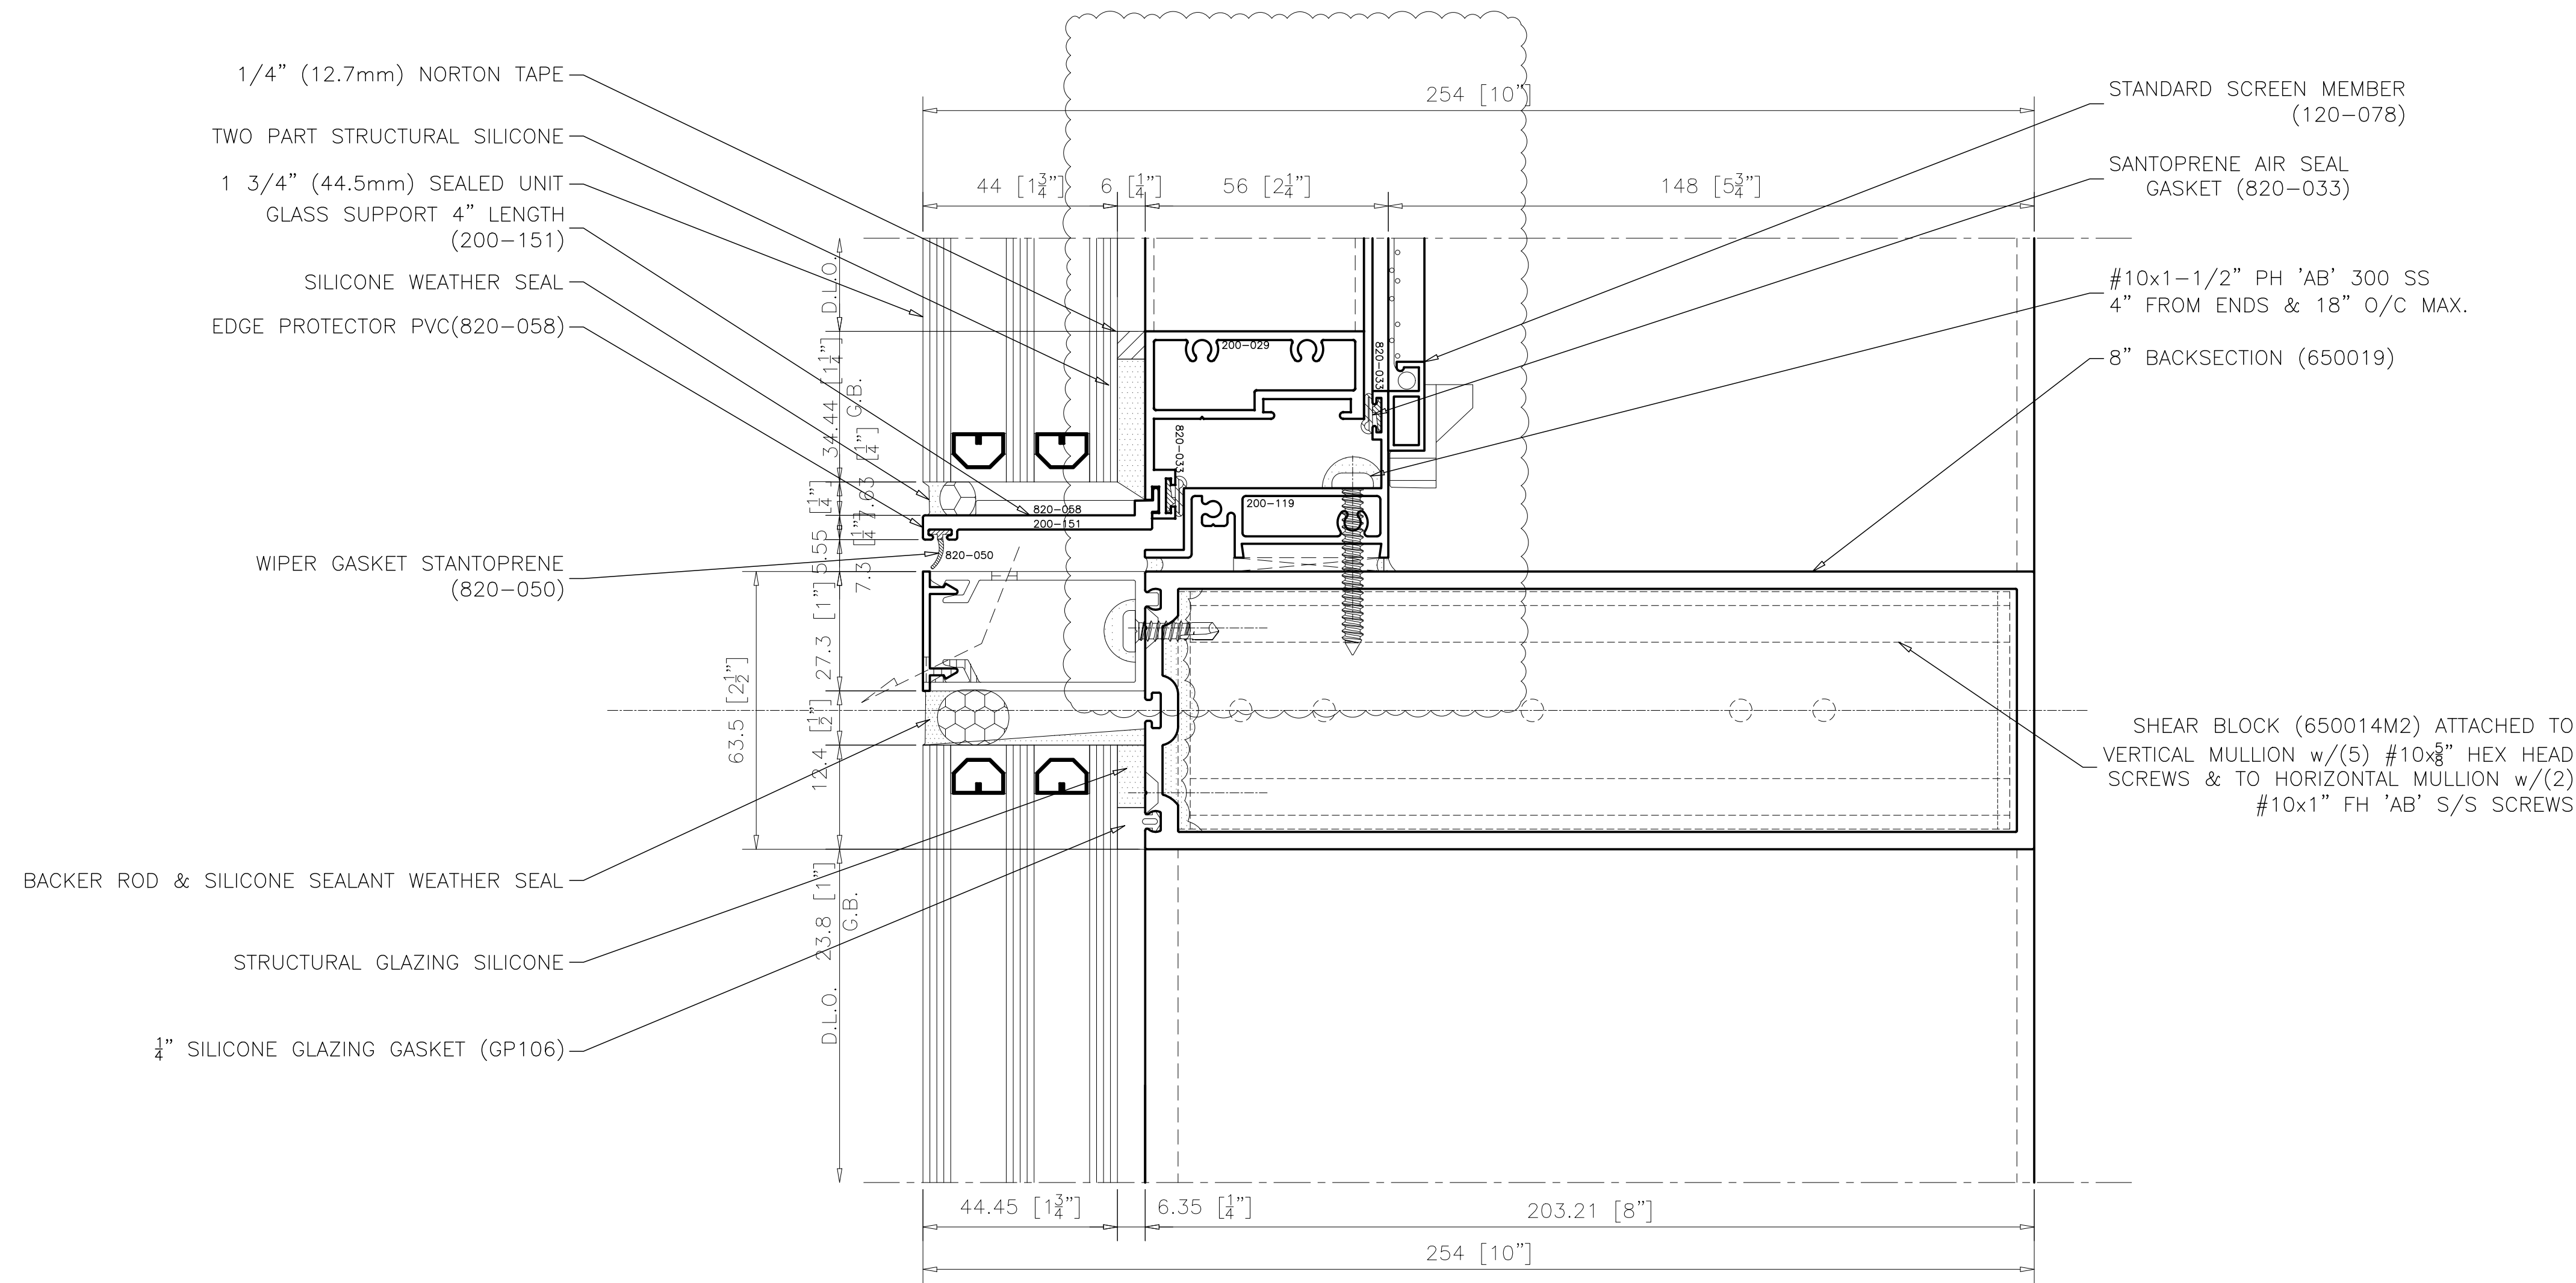


1
C5-002D

INTERMEDIATE HORIZONTAL SSG 8" B.S.
AT VENT ABOVE VISION GL-1A
ARCH. REF.: N/A


REVISIONS			
No.	Description:	Date:	By:
1	Revised per arch. markups received Feb 11/26	03/03/26	SLR

Project Name: DOCKSTEADER PRPS	Project Location: BRAMPTON, ONTARIO	Architect Name: DIAMOND SCHMITT ARCHITECTS	Customer Name: BOTHWELL ACCURATE GLAZING
-----------------------------------	--	---	---

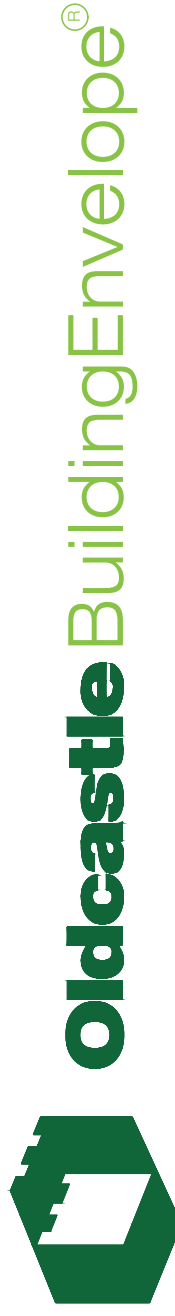

275 Britannia Road East • Mississauga • Ontario • Canada • L4Z2E7
905-890-6970 • oldcastlebe.com

Drawing Name: SECTION DETAIL	
Drawn By: SR	Checked By: NP
Drawn Date: 2026/01/12	Issue No.: 1
Scale: 1/2"=1"	Release Date: 2026/03/03
Drawing Number: C5-002D	

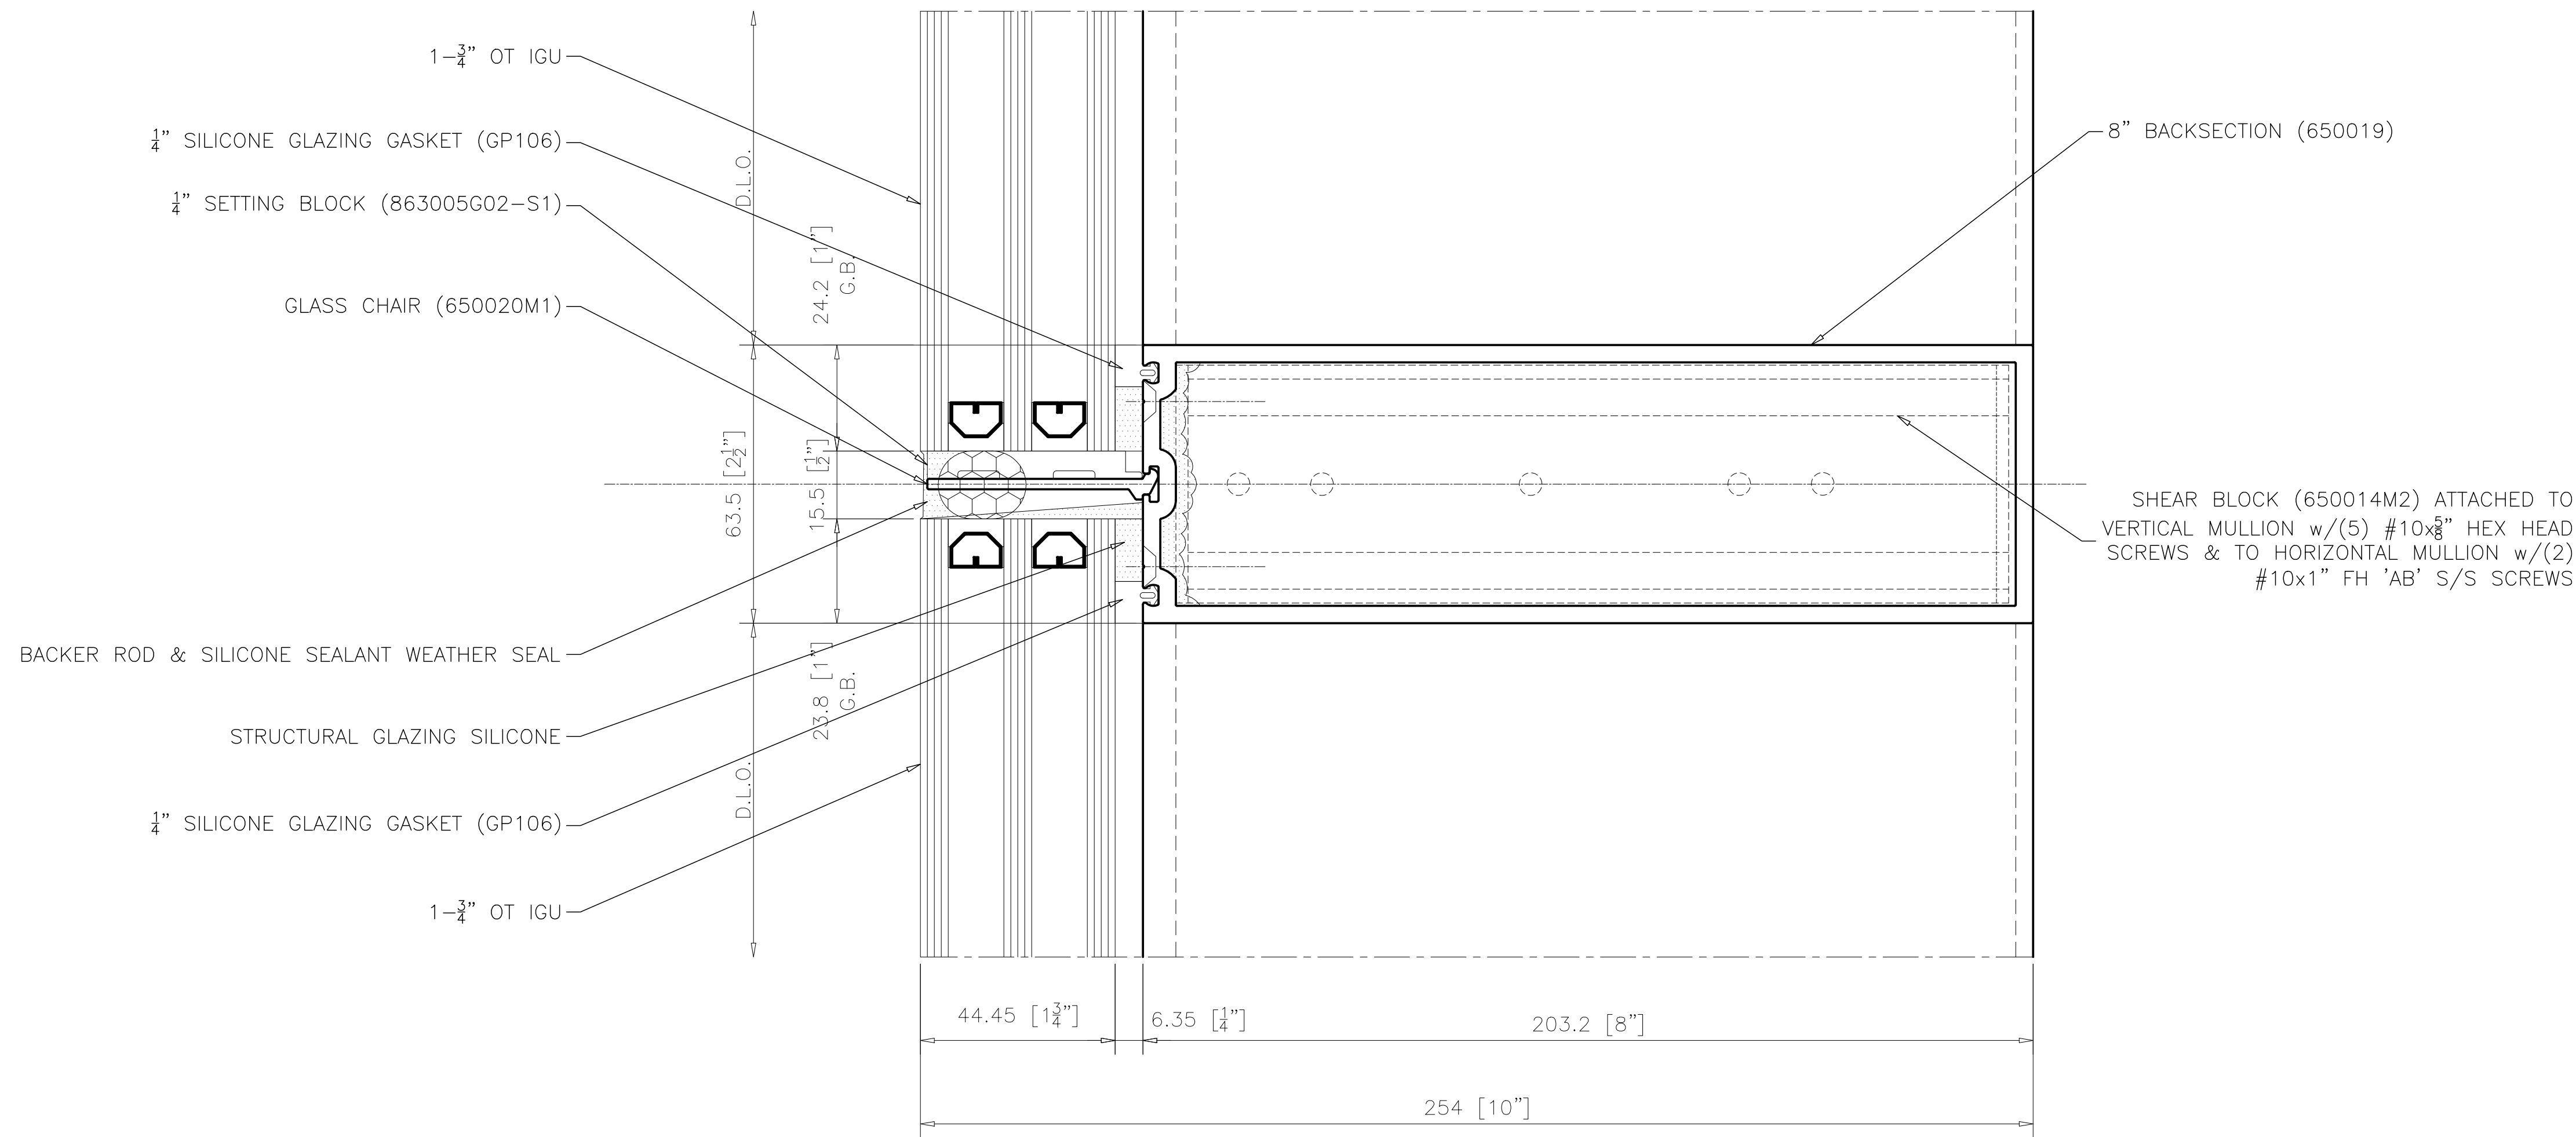


1
C5-002E

INTERMEDIATE HORIZONTAL SSG 8" B.S.
AT VISION ABOVE VISION GL-1B

ARCH. REF.: N/A


REVISIONS			
No.	Description:	Date:	By:
1	Revised per arch. markups received Feb 11/26	03/03/26	SLR

Project Name: DOCKSTEADER PRPS	Project Location: BRAMPTON, ONTARIO	Architect Name: DIAMOND SCHMITT ARCHITECTS	Customer Name: BOTHWELL ACCURATE GLAZING
-----------------------------------	--	---	---

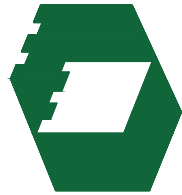**oldcastle** BuildingEnvelope®

275 Britannia Road East • Mississauga • Ontario • Canada • L4Z2E7
905-890-6970 • oldcastlebe.com

Drawing Name: SECTION DETAIL	
Drawn By: SR	Checked By: NP
Drawn Date: 2026/01/12	Issue No.: 1
Scale: 1/2"=1"	Release Date: 2026/03/03
Drawing Number: C5-002E	

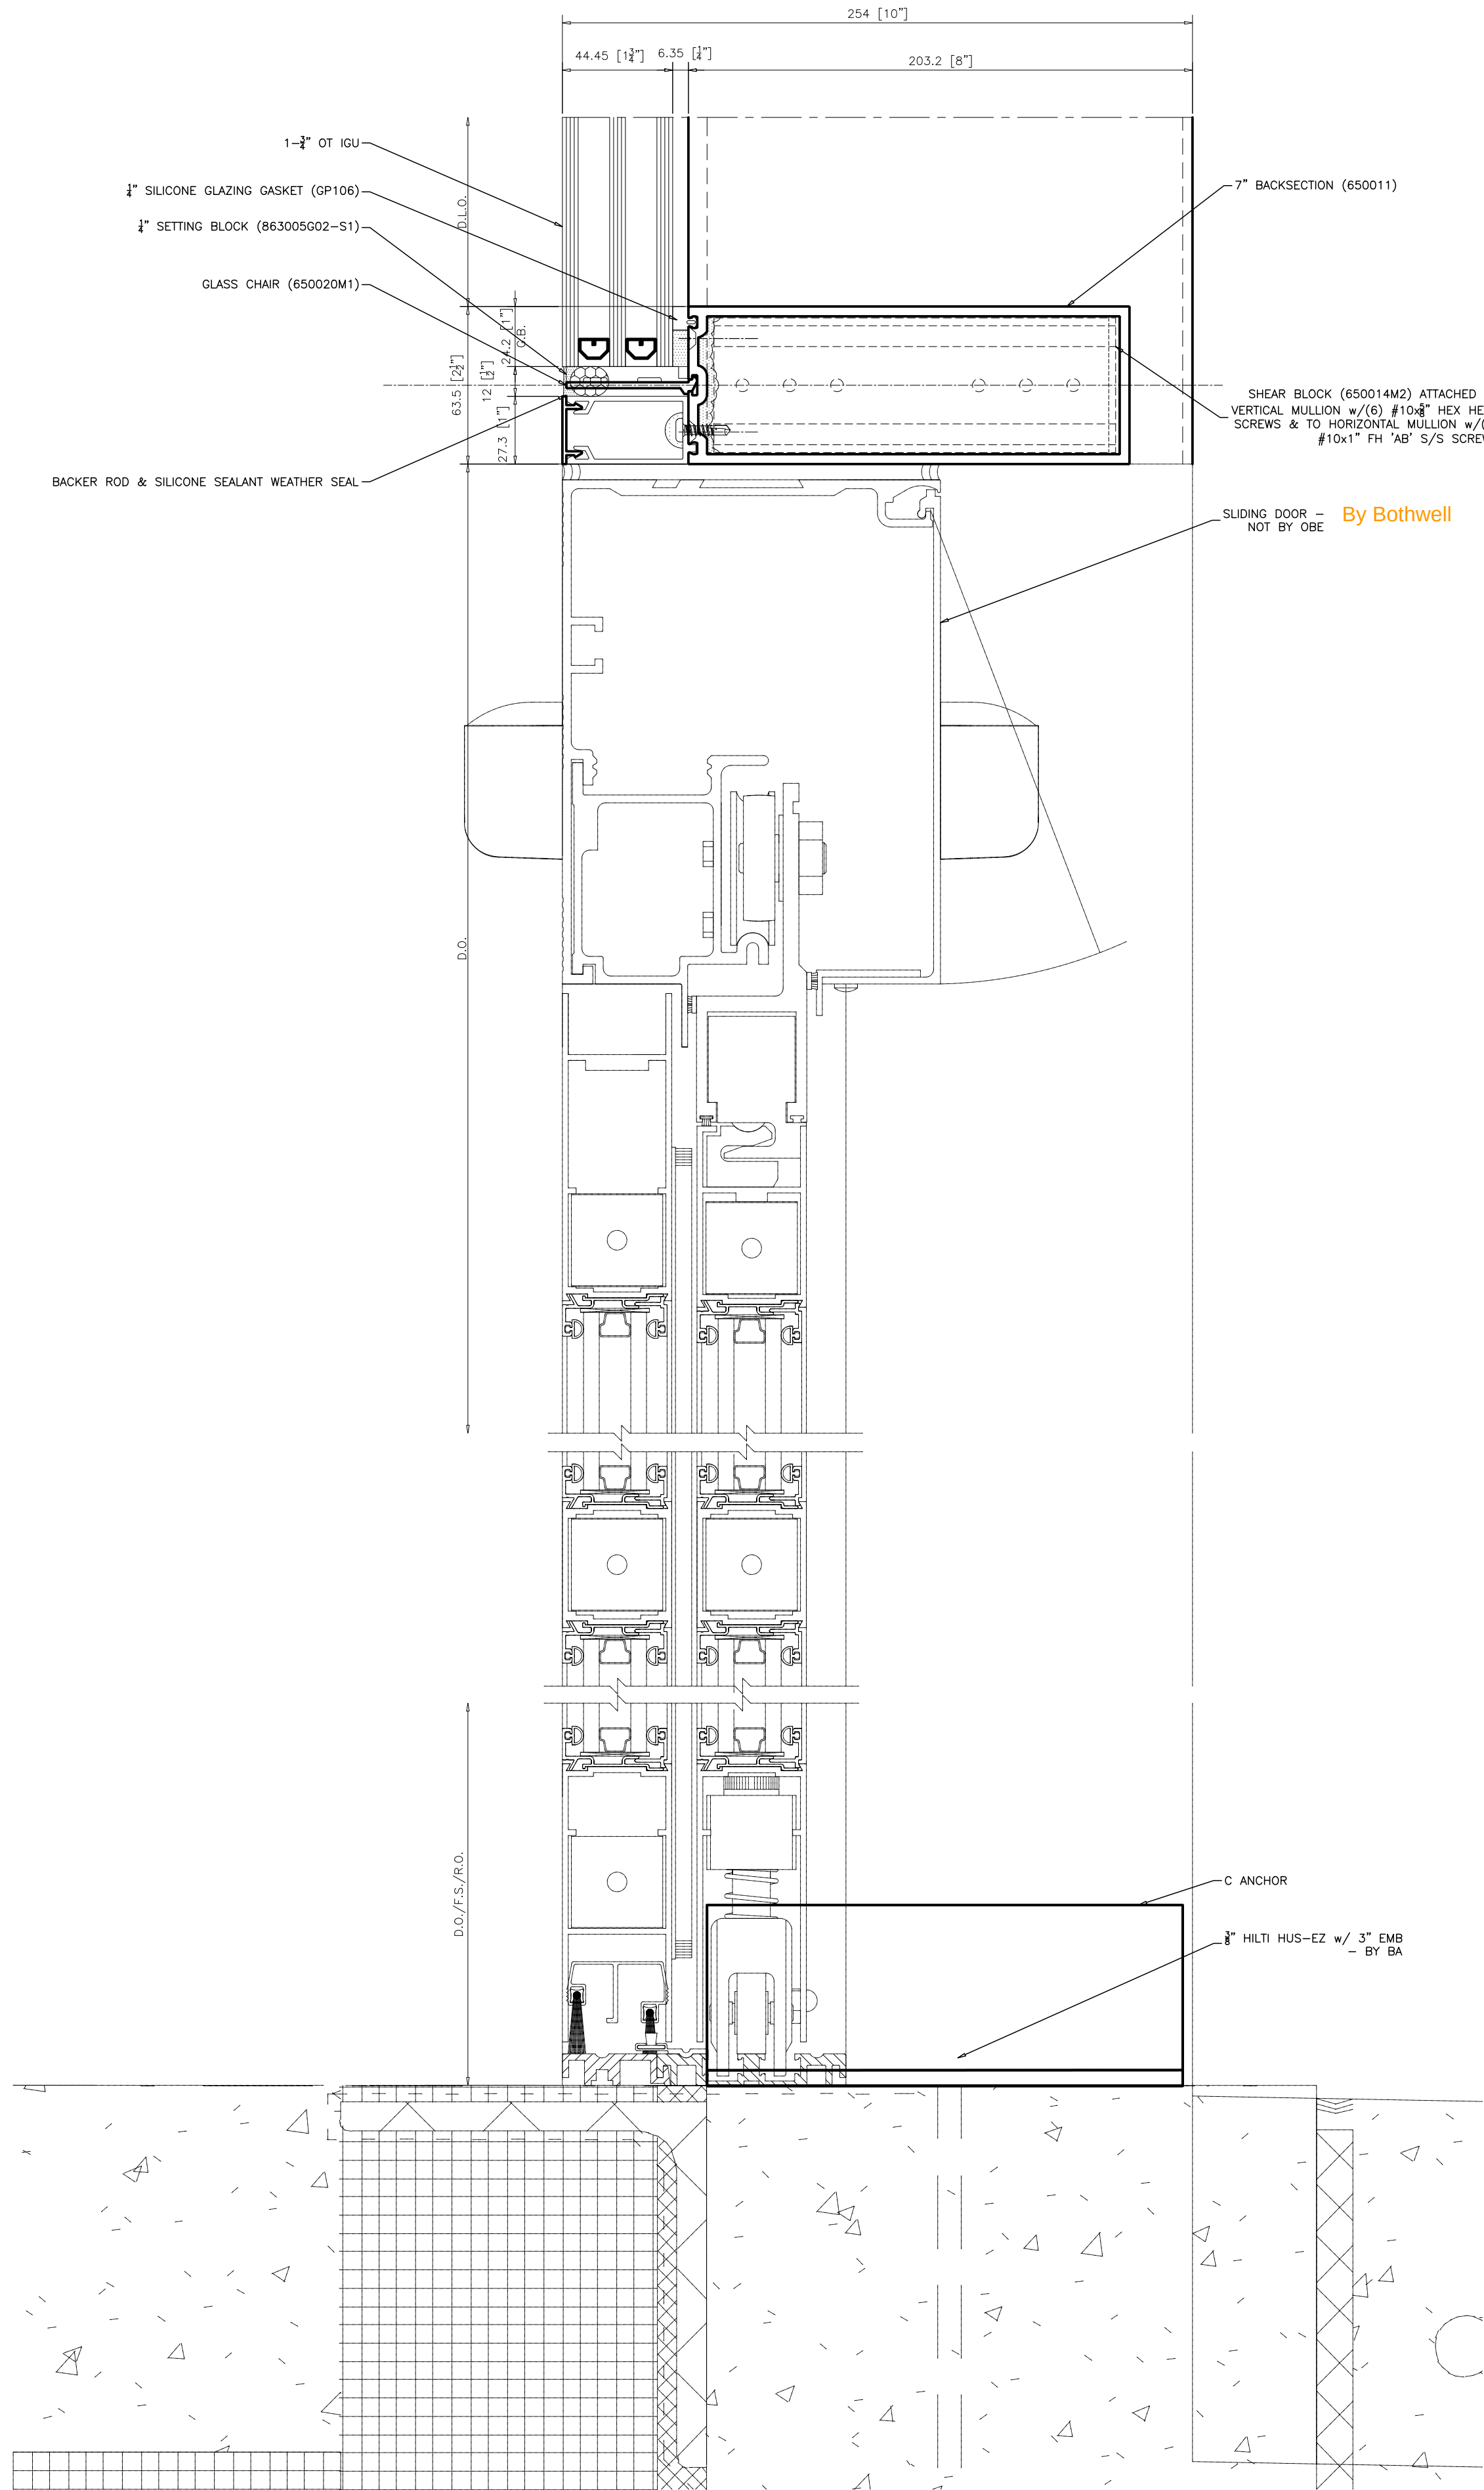


1
C5-002F

**INTERMEDIATE HORIZONTAL SSG 7" B.S.
AT VISION ABOVE SLIDING DOOR**

ARCH. REF.: N/A

REVISIONS			
No.	Description:	Date:	By:
1	Revised per arch. markups received Feb 11/26	03/03/26	SLR

Project Name: DOCKSTEADER PRPS	Project Location: BRAMPTON, ONTARIO	Architect Name: DIAMOND SCHMITT ARCHITECTS	Customer Name: BOTHWELL ACCURATE GLAZING
-----------------------------------	--	---	---

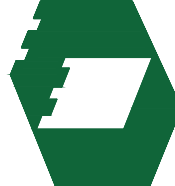
**oldcastle** BuildingEnvelope[®]

275 Britannia Road East • Mississauga • Ontario • Canada • L4Z2E7
905-890-6970 • oldcastlebe.com

Drawing Name:
SECTION DETAIL

Drawn By: SR	Checked By: NP
Drawn Date: 2026/01/12	Issue No.: 1
Scale: 1/2"=1"	Release Date: 2026/03/03

Drawing Number:
C5-002F

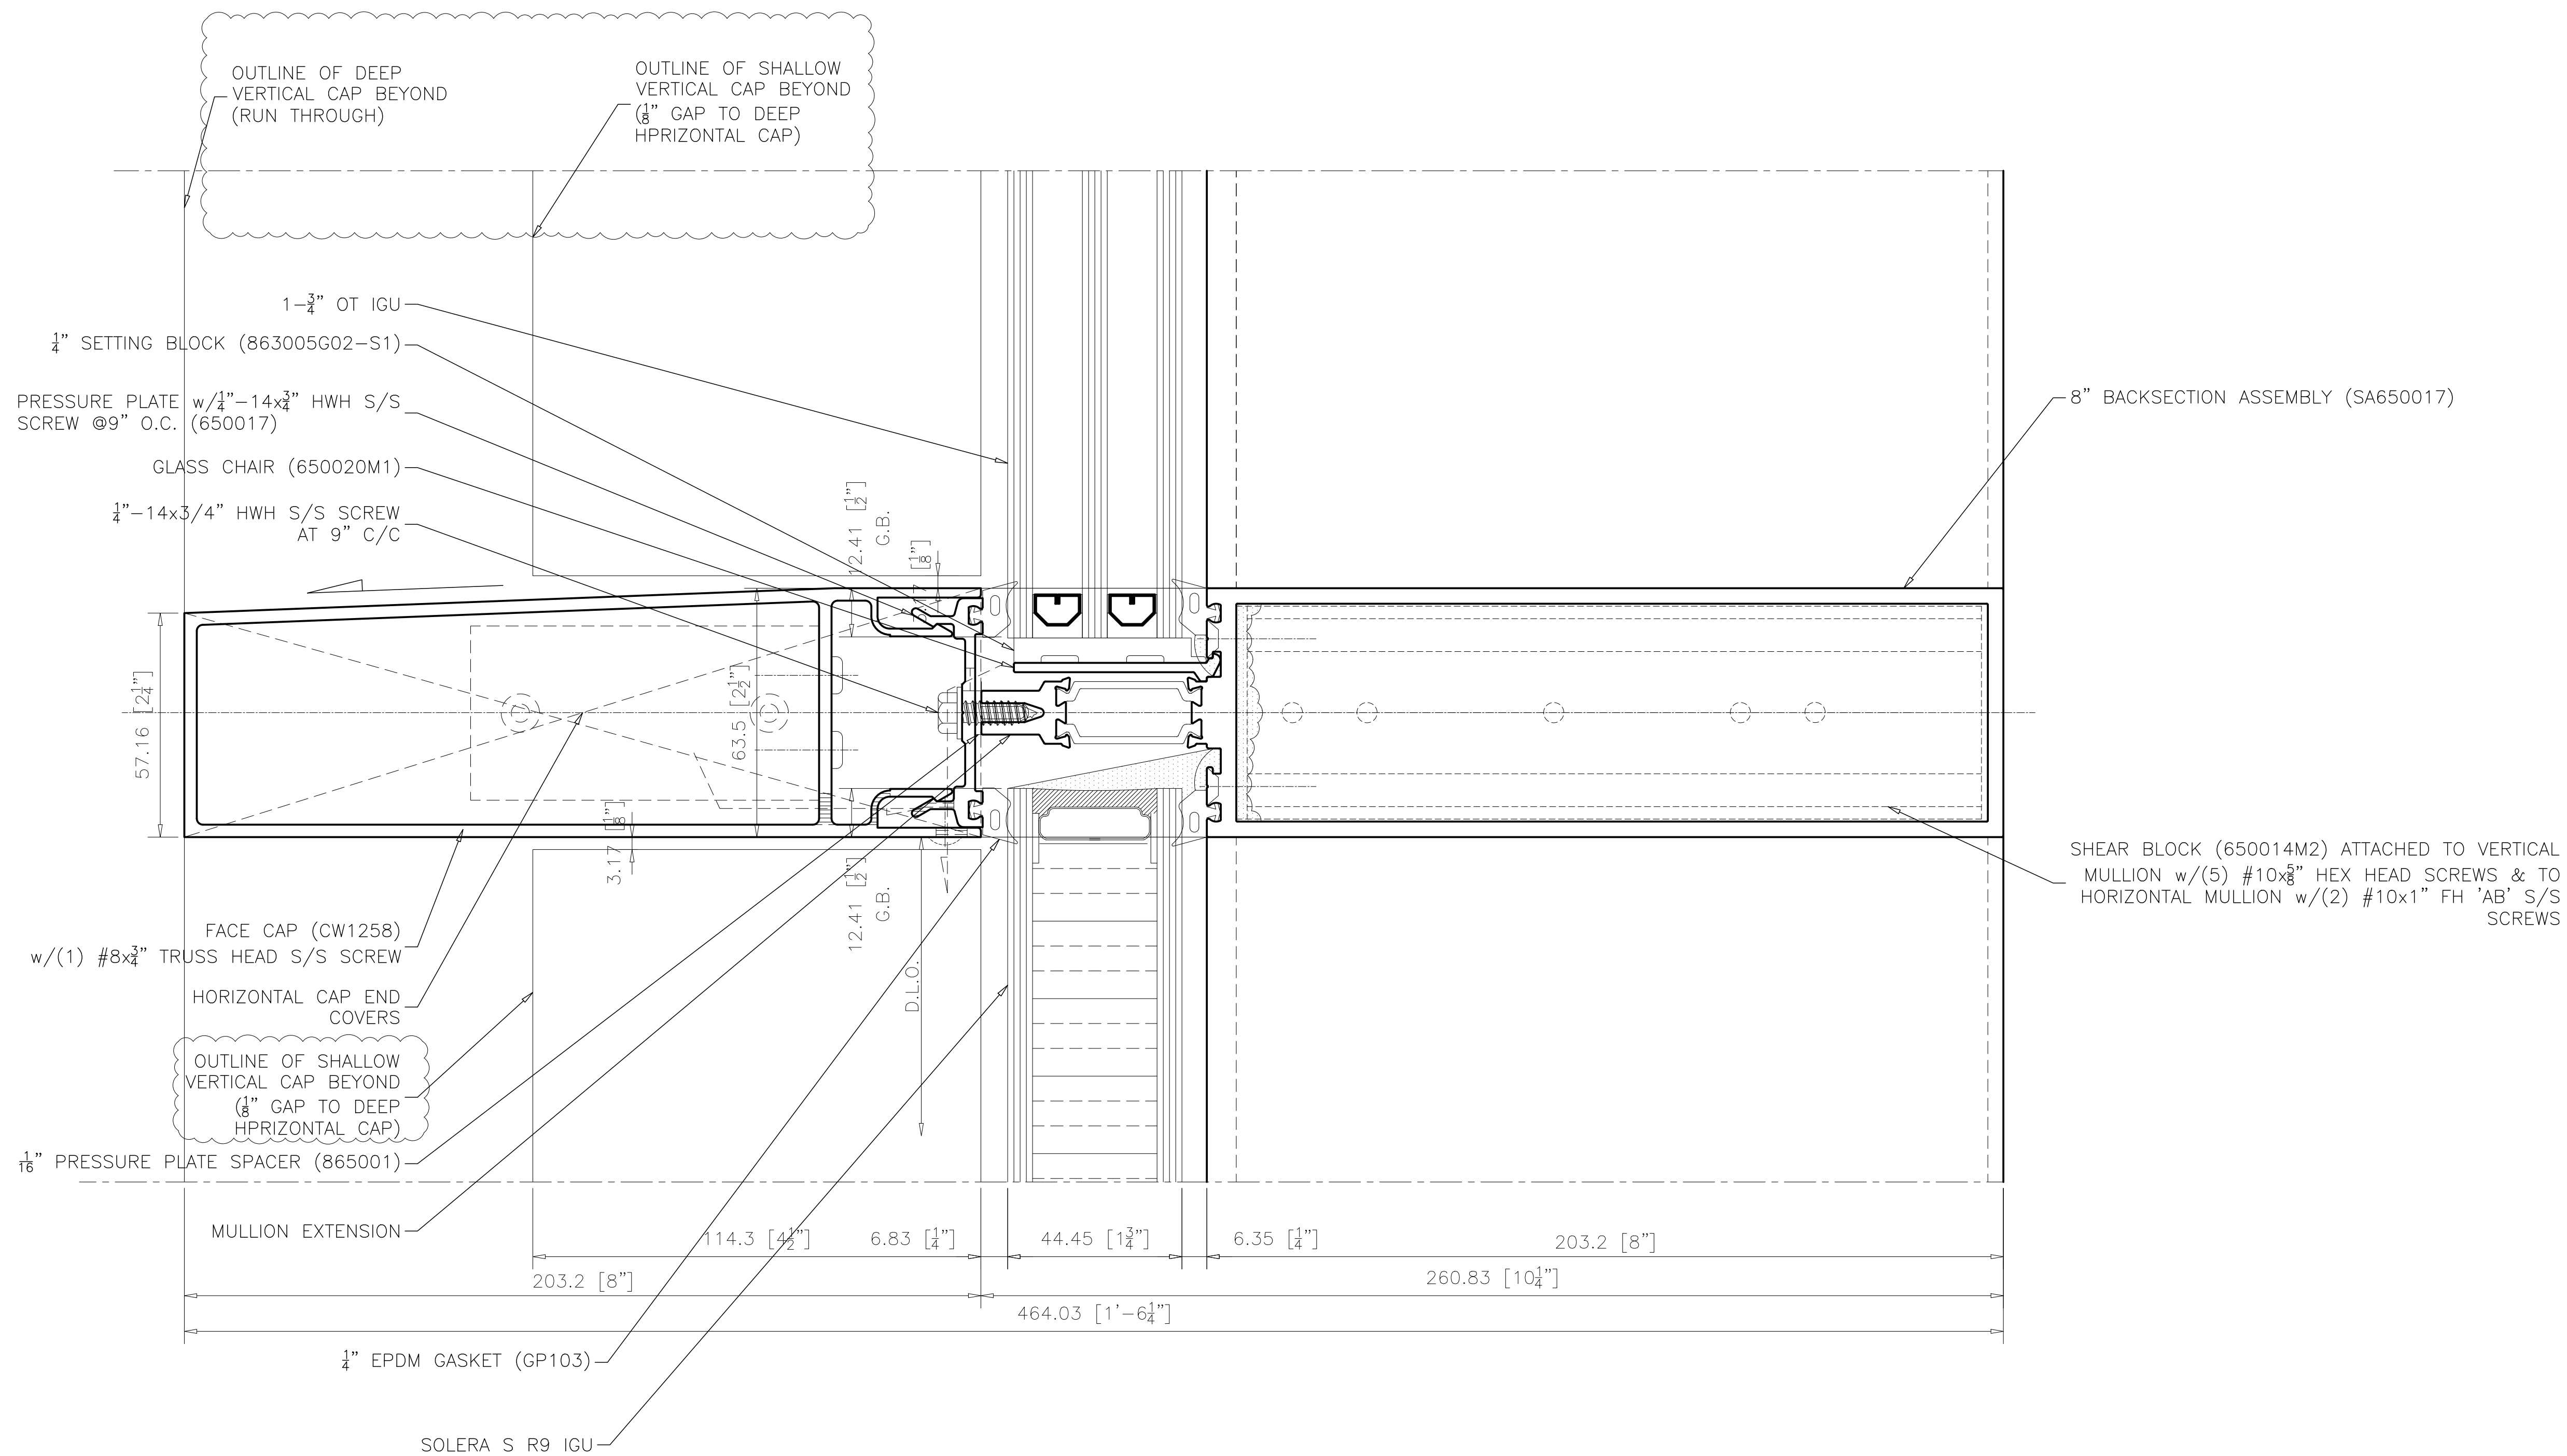

1
C5-003

INTERMEDIATE HORIZONTAL 8" CAP 8" B.S.
AT VISION ABOVE SOLERA GLAZING

ARCH. REF.: N/A

REVISIONS

No.	Description:	Date:	By:
1	Revised per arch. markups received Feb 11/26	03/03/26	SLR

Project Name:
DOCKSTEADER PRPS

Project Location:
BRAMPTON, ONTARIO

Architect Name:
DIAMOND SCHMITT ARCHITECTS

Customer Name:
BOTHWELL ACCURATE GLAZING

oldcastle BuildingEnvelope®



275 Britannia Road East • Mississauga • Ontario • Canada • L4Z2E7

905-890-8970 • oldcastlebe.com

Drawing Name:

SECTION DETAIL

Drawn By:

Checked By:

SR

NP

Drawn Date:

Issue No.:

2026/01/12

1

Scale:


Release Date:

1"=1"

2026/03/03

Drawing Number:

C5-003

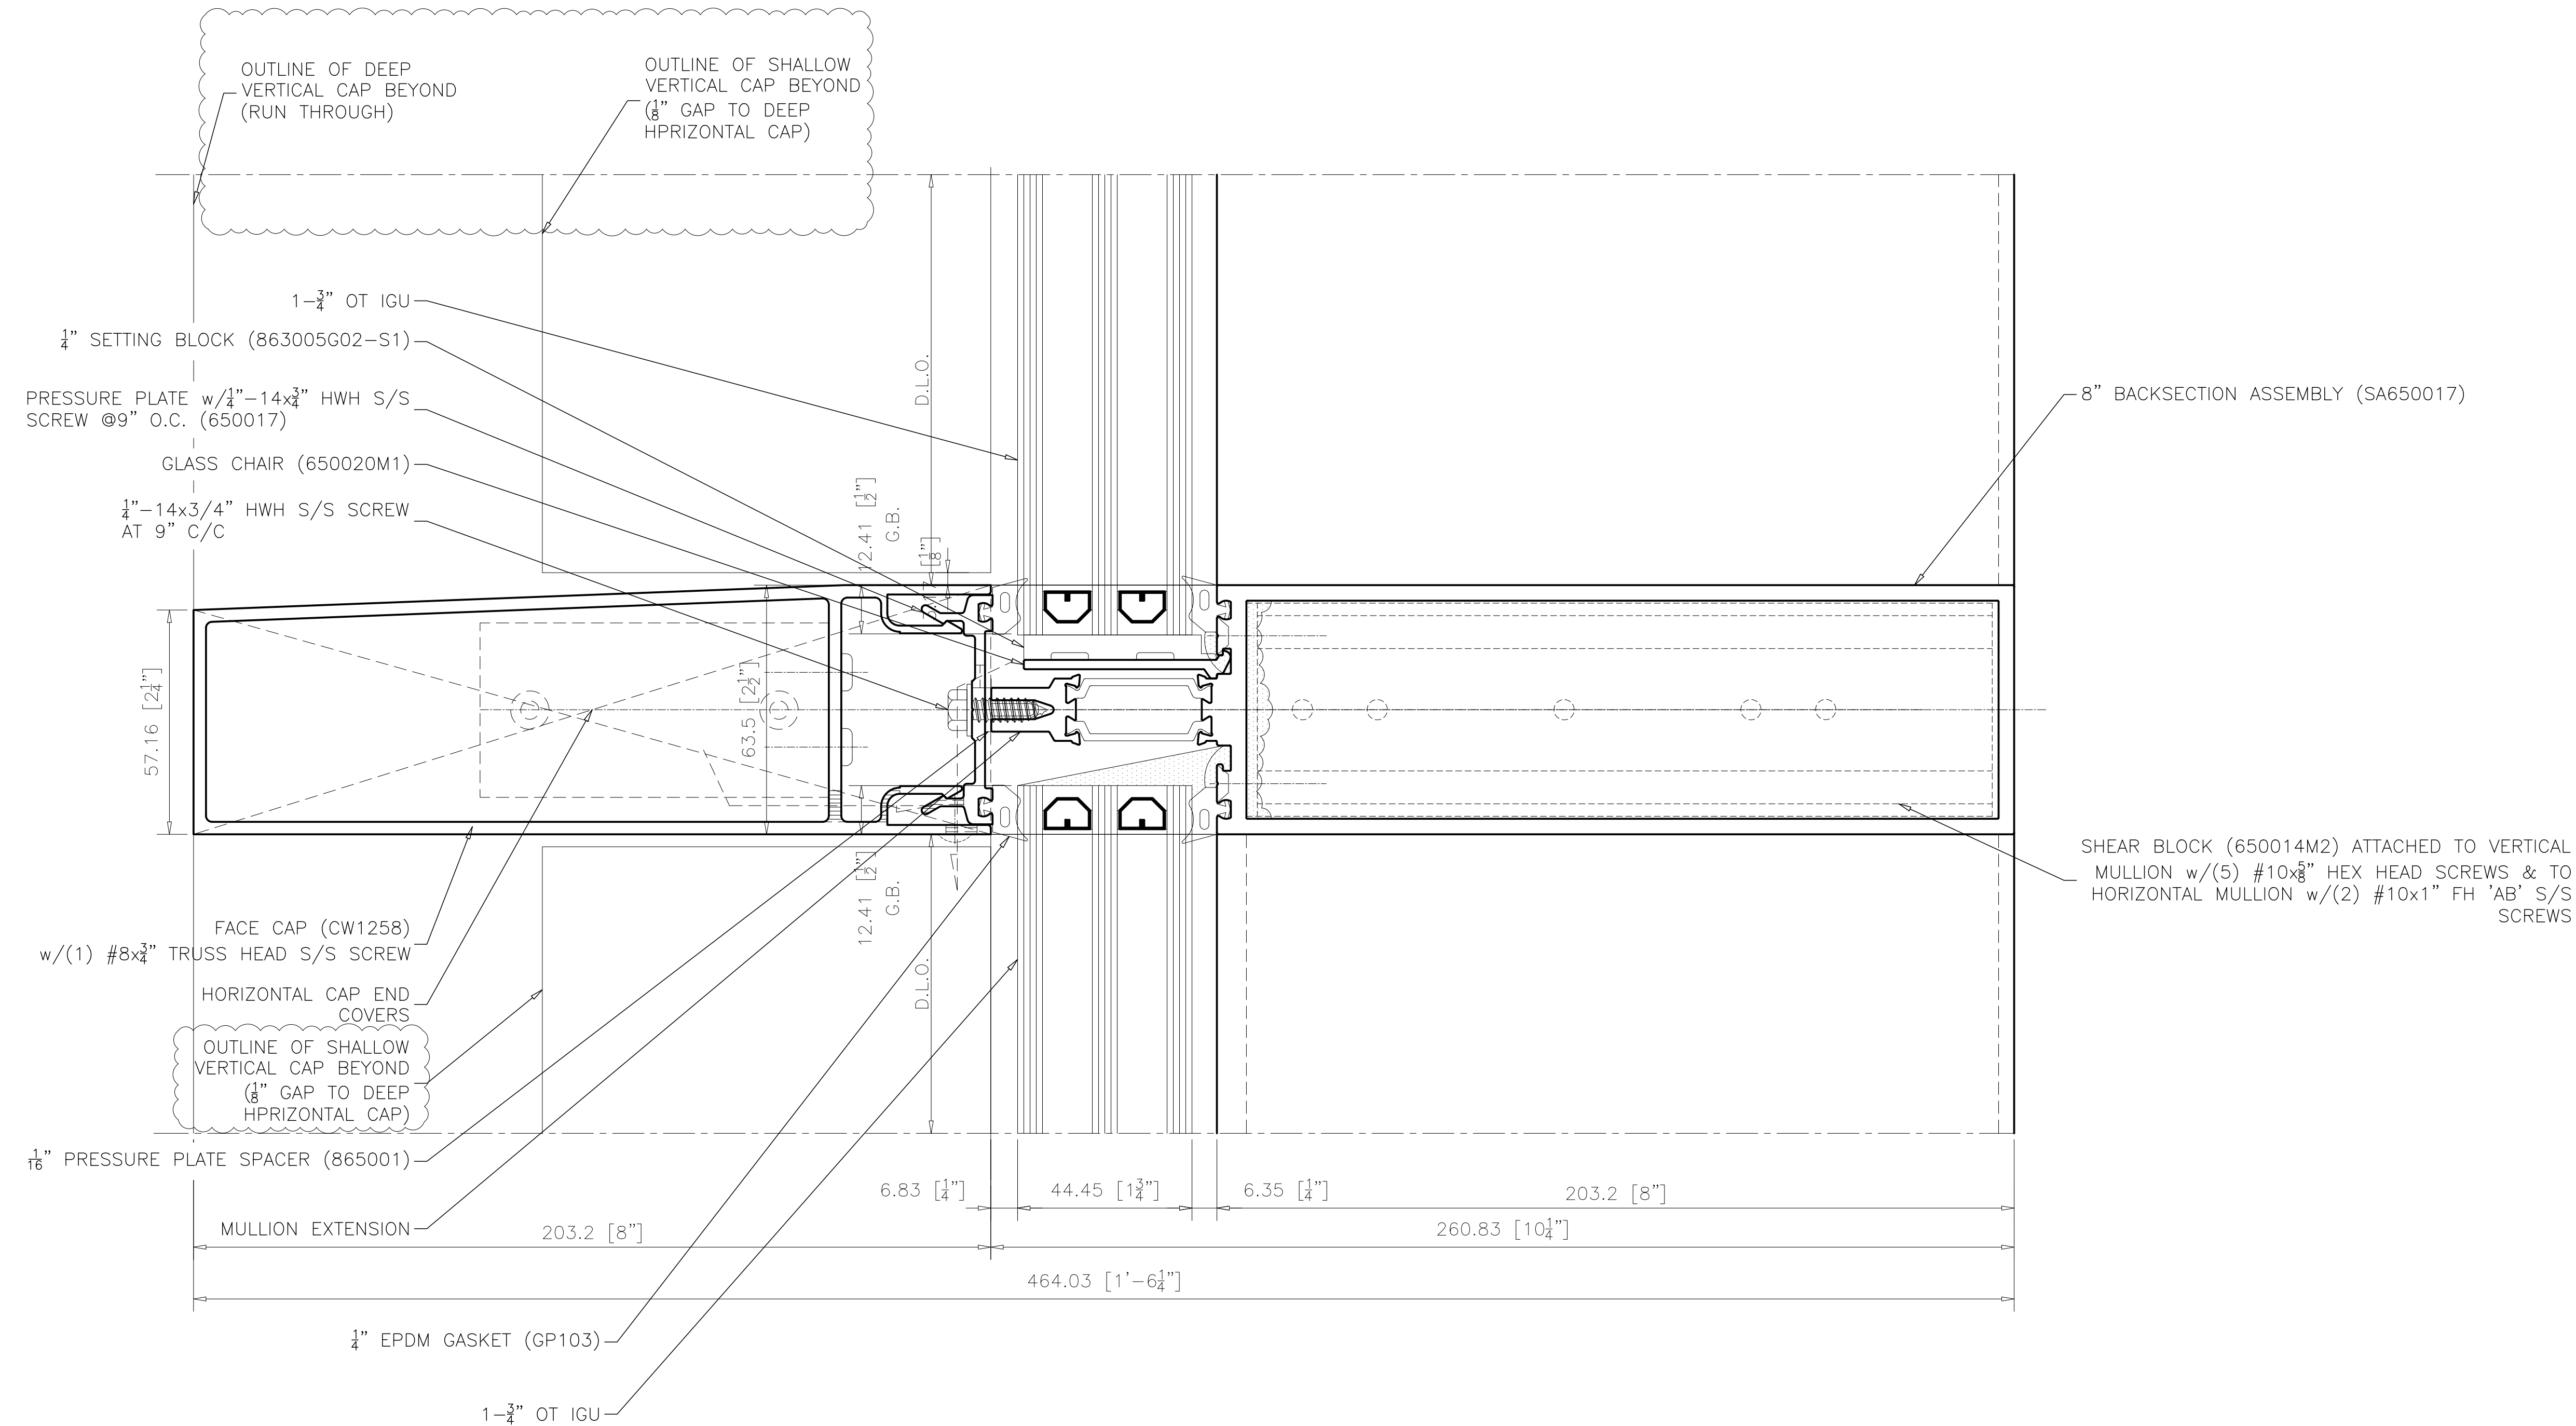

1
C5-003A

INTERMEDIATE HORIZONTAL 4-1/2" CAP 8" B.S.
AT VISION ABOVE VISION GLAZING

ARCH. REF.: N/A


REVISIONS			
No.	Description:	Date:	By:
1	Revised per arch. markups received Feb 11/26	03/03/26	SLR

Project Name: DOCKSTEADER PRPS	Project Location: BRAMPTON, ONTARIO	Architect Name: DIAMOND SCHMITT ARCHITECTS	Customer Name: BOTHWELL ACCURATE GLAZING
-----------------------------------	--	---	---

oldcastle BuildingEnvelope®

275 Britannia Road East • Mississauga • Ontario • Canada • L4Z2E7
905-890-8970 • oldcastlebe.com

Drawing Name: SECTION DETAIL	
Drawn By: SR	Checked By: NP
Drawn Date: 2026/01/12	Issue No.: 1
Scale: 1"=1"	Release Date: 2026/03/03
Drawing Number: C5-003A	

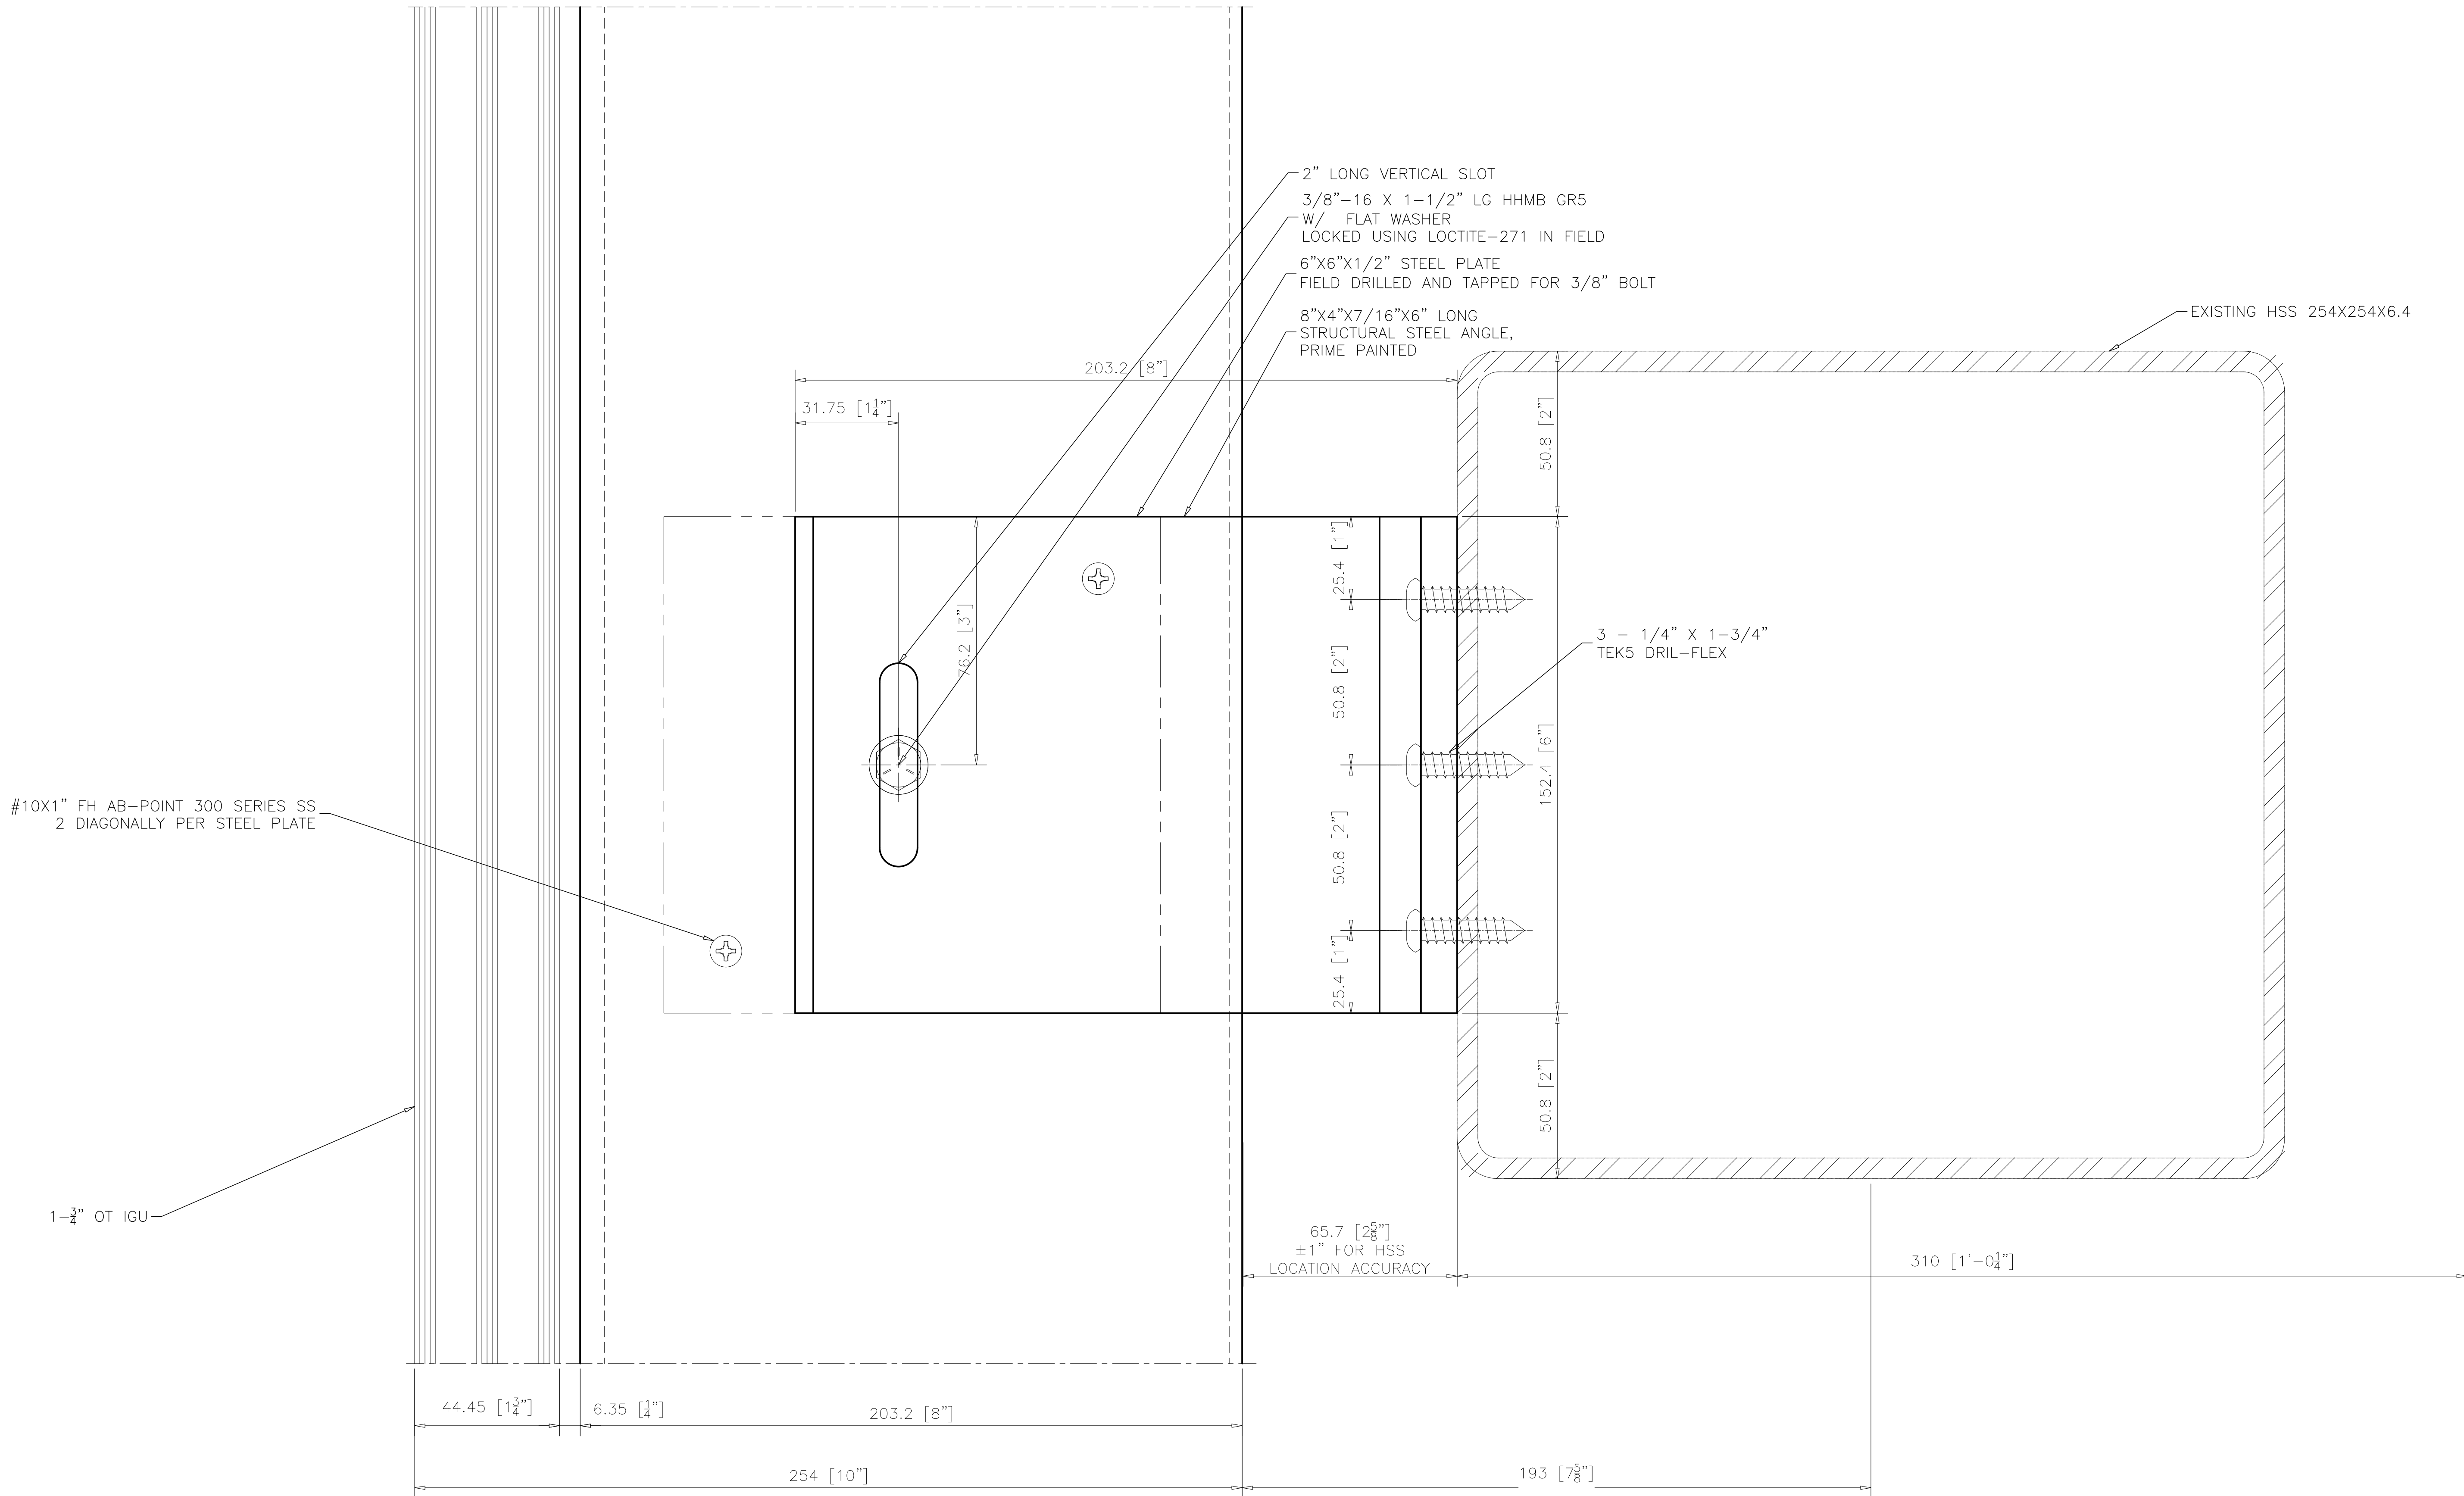


1
C5-004

INTERMEDIATE
AT ANCHOR

ARCH. REF.: N/A

REVISIONS			
No.	Description:	Date:	By:
1	Revised per arch. markups received Feb 11/26	03/03/26	SLR

Project Name: DOCKSTEADER PRPS	Project Location: BRAMPTON, ONTARIO	Architect Name: DIAMOND SCHMITT ARCHITECTS	Customer Name: BOTHWELL ACCURATE GLAZING
-----------------------------------	--	---	---

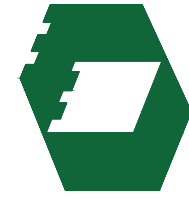

Oldcastle BuildingEnvelope[®]
275 Britannia Road East • Mississauga • Ontario • Canada • L4Z2E7
905-890-6970 • oldcastlebe.com

Drawing Name:
SECTION DETAIL

Drawn By: SR	Checked By: NP
Drawn Date: 2026/01/12	Issue No.: 1
Scale: 1"=1"	Release Date: 2026/03/03

Drawing Number:
C5-004





Oldcastle BuildingEnvelope®

275 Britannia Road East • Mississauga • Ontario • Canada • L4Z2E7
905-890-6970 • oldcastlebe.com


Drawing Name:

SECTION DETAIL

Drawn By: SR	Checked By: NP
Drawn Date: 2026/01/12	Issue No.: 1
Scale: 1"=1"	Release Date: 2026/03/03

Drawing Number:

C5-004A

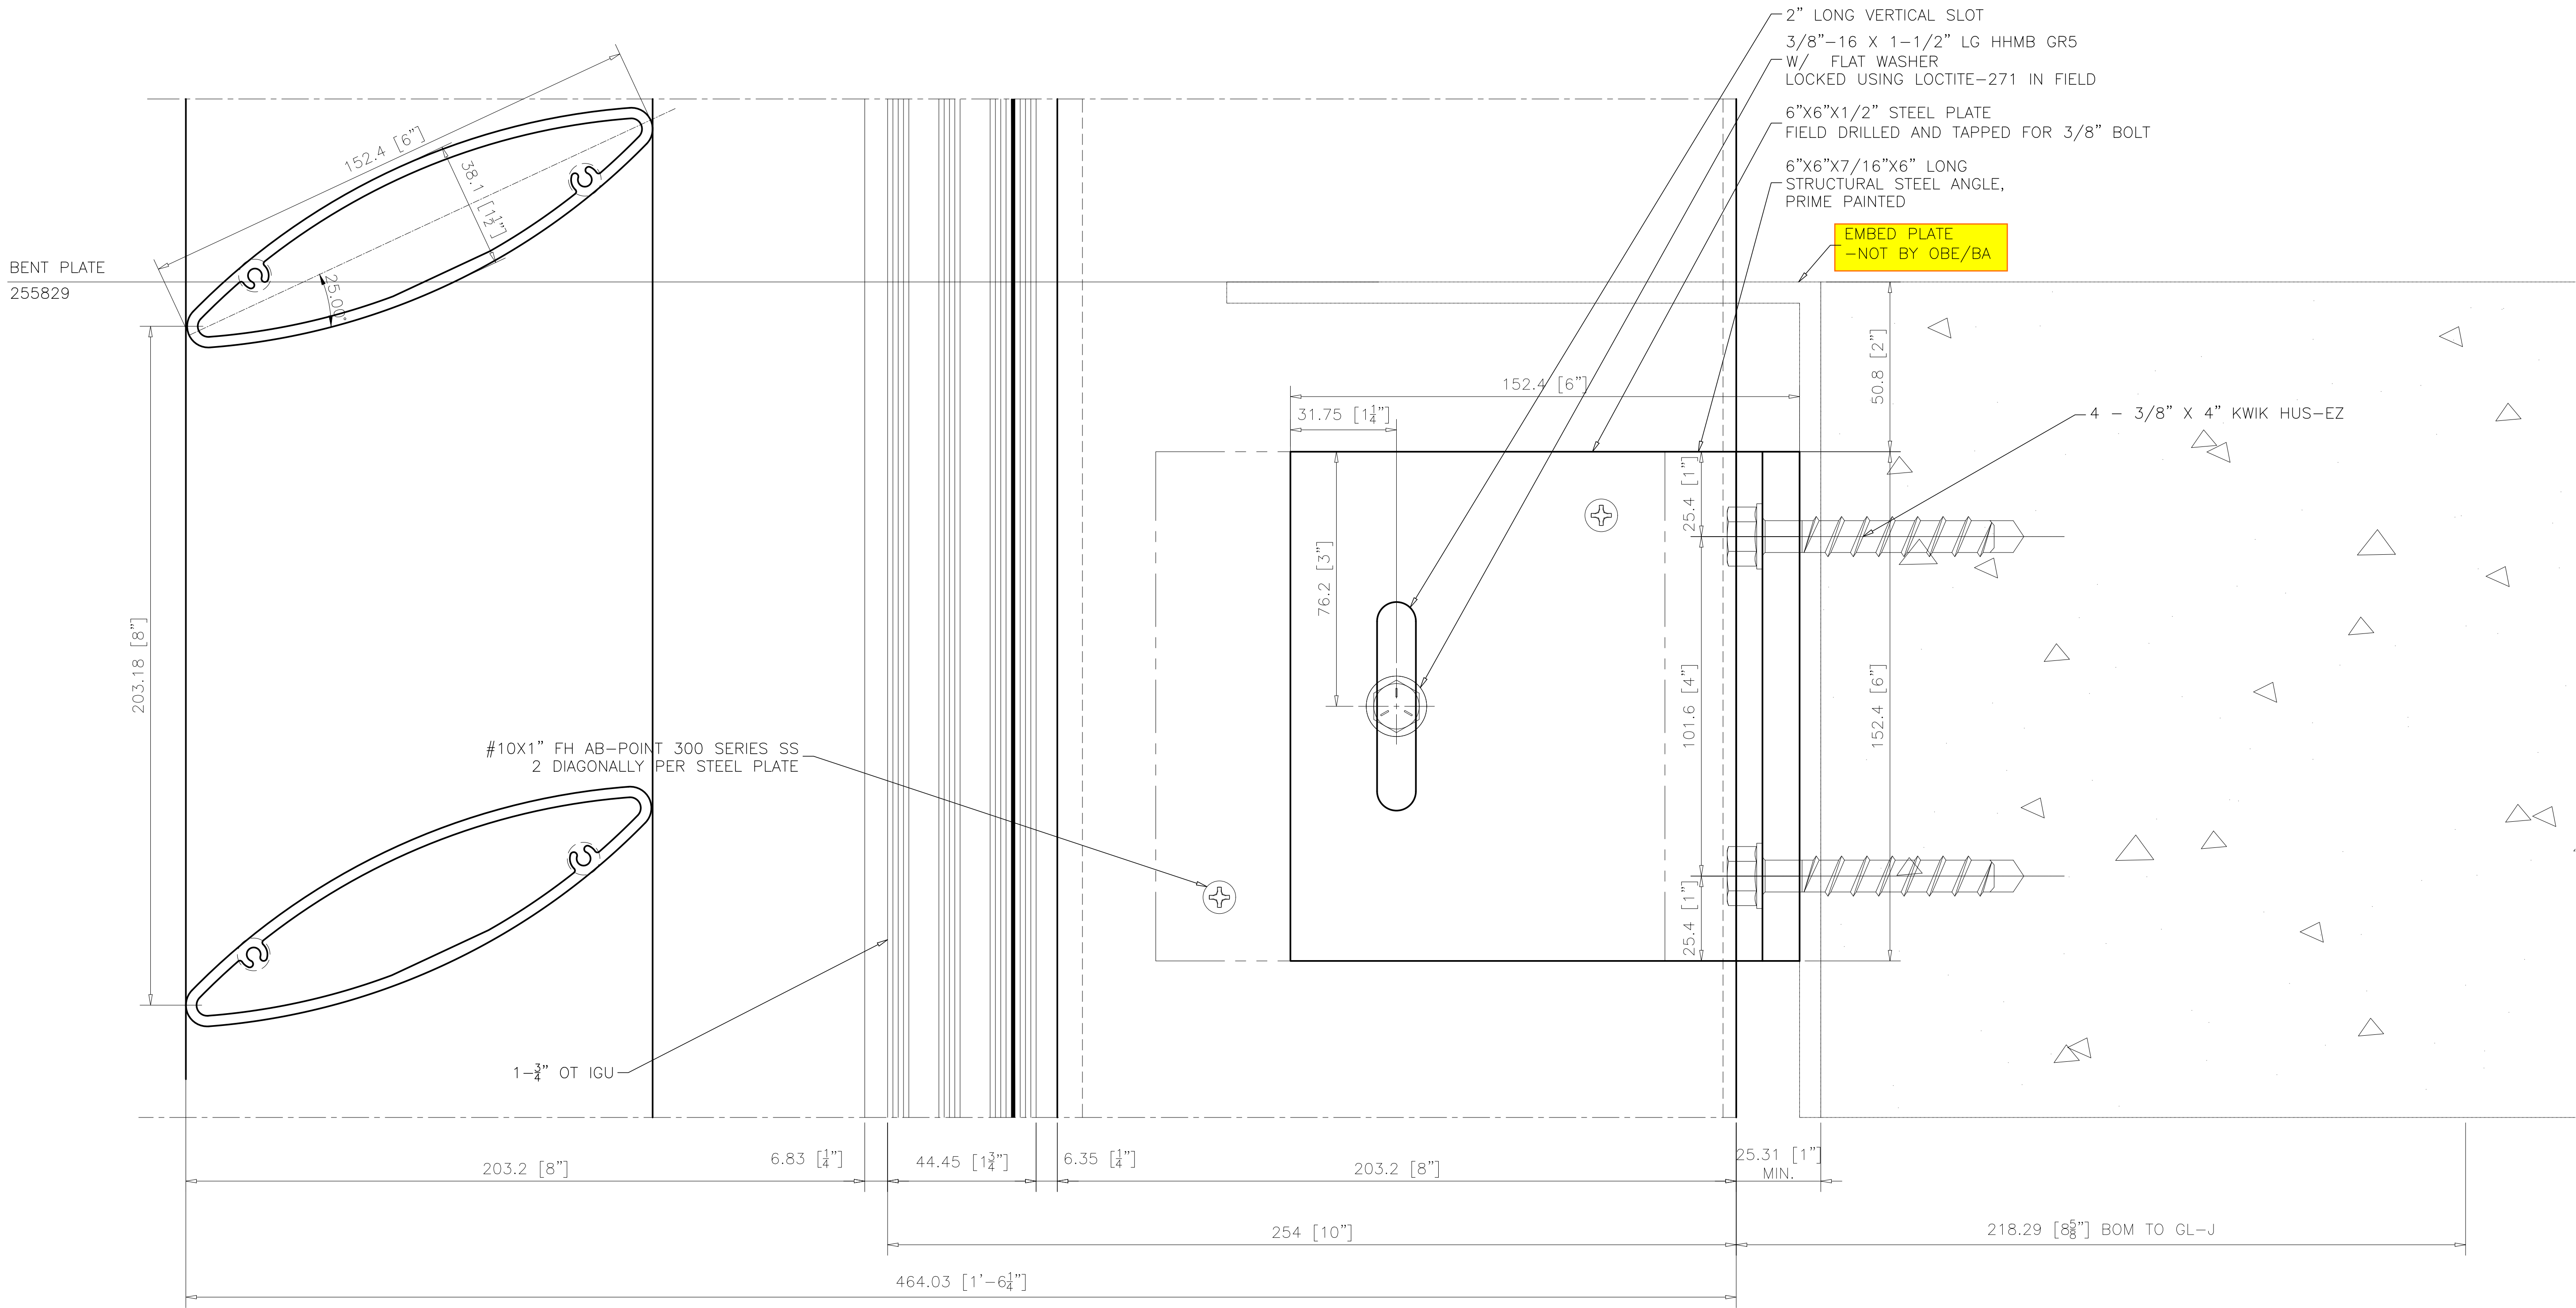


1
C5-004B

INTERMEDIATE
AT ANCHOR

ARCH. REF.: N/A

REVISIONS			
No.	Description:	Date:	By:
1	Revised per arch. markups received Feb 11/26	03/03/26	SLR

Project Name: DOCKSTEADER PRPS	Project Location: BRAMPTON, ONTARIO	Architect Name: DIAMOND SCHMITT ARCHITECTS	Customer Name: BOTHWELL ACCURATE GLAZING
-----------------------------------	--	---	---

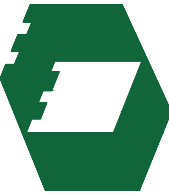


Oldcastle BuildingEnvelope®

275 Britannia Road East • Mississauga • Ontario • Canada • L4Z2E7
905-890-6970 • oldcastlebe.com

Drawing Name:
SECTION DETAIL

Drawn By: SR	Checked By: NP
Drawn Date: 2026/01/12	Issue No.: 1
Scale: 1"=1"	Release Date: 2026/03/03

Drawing Number:
C5-004B

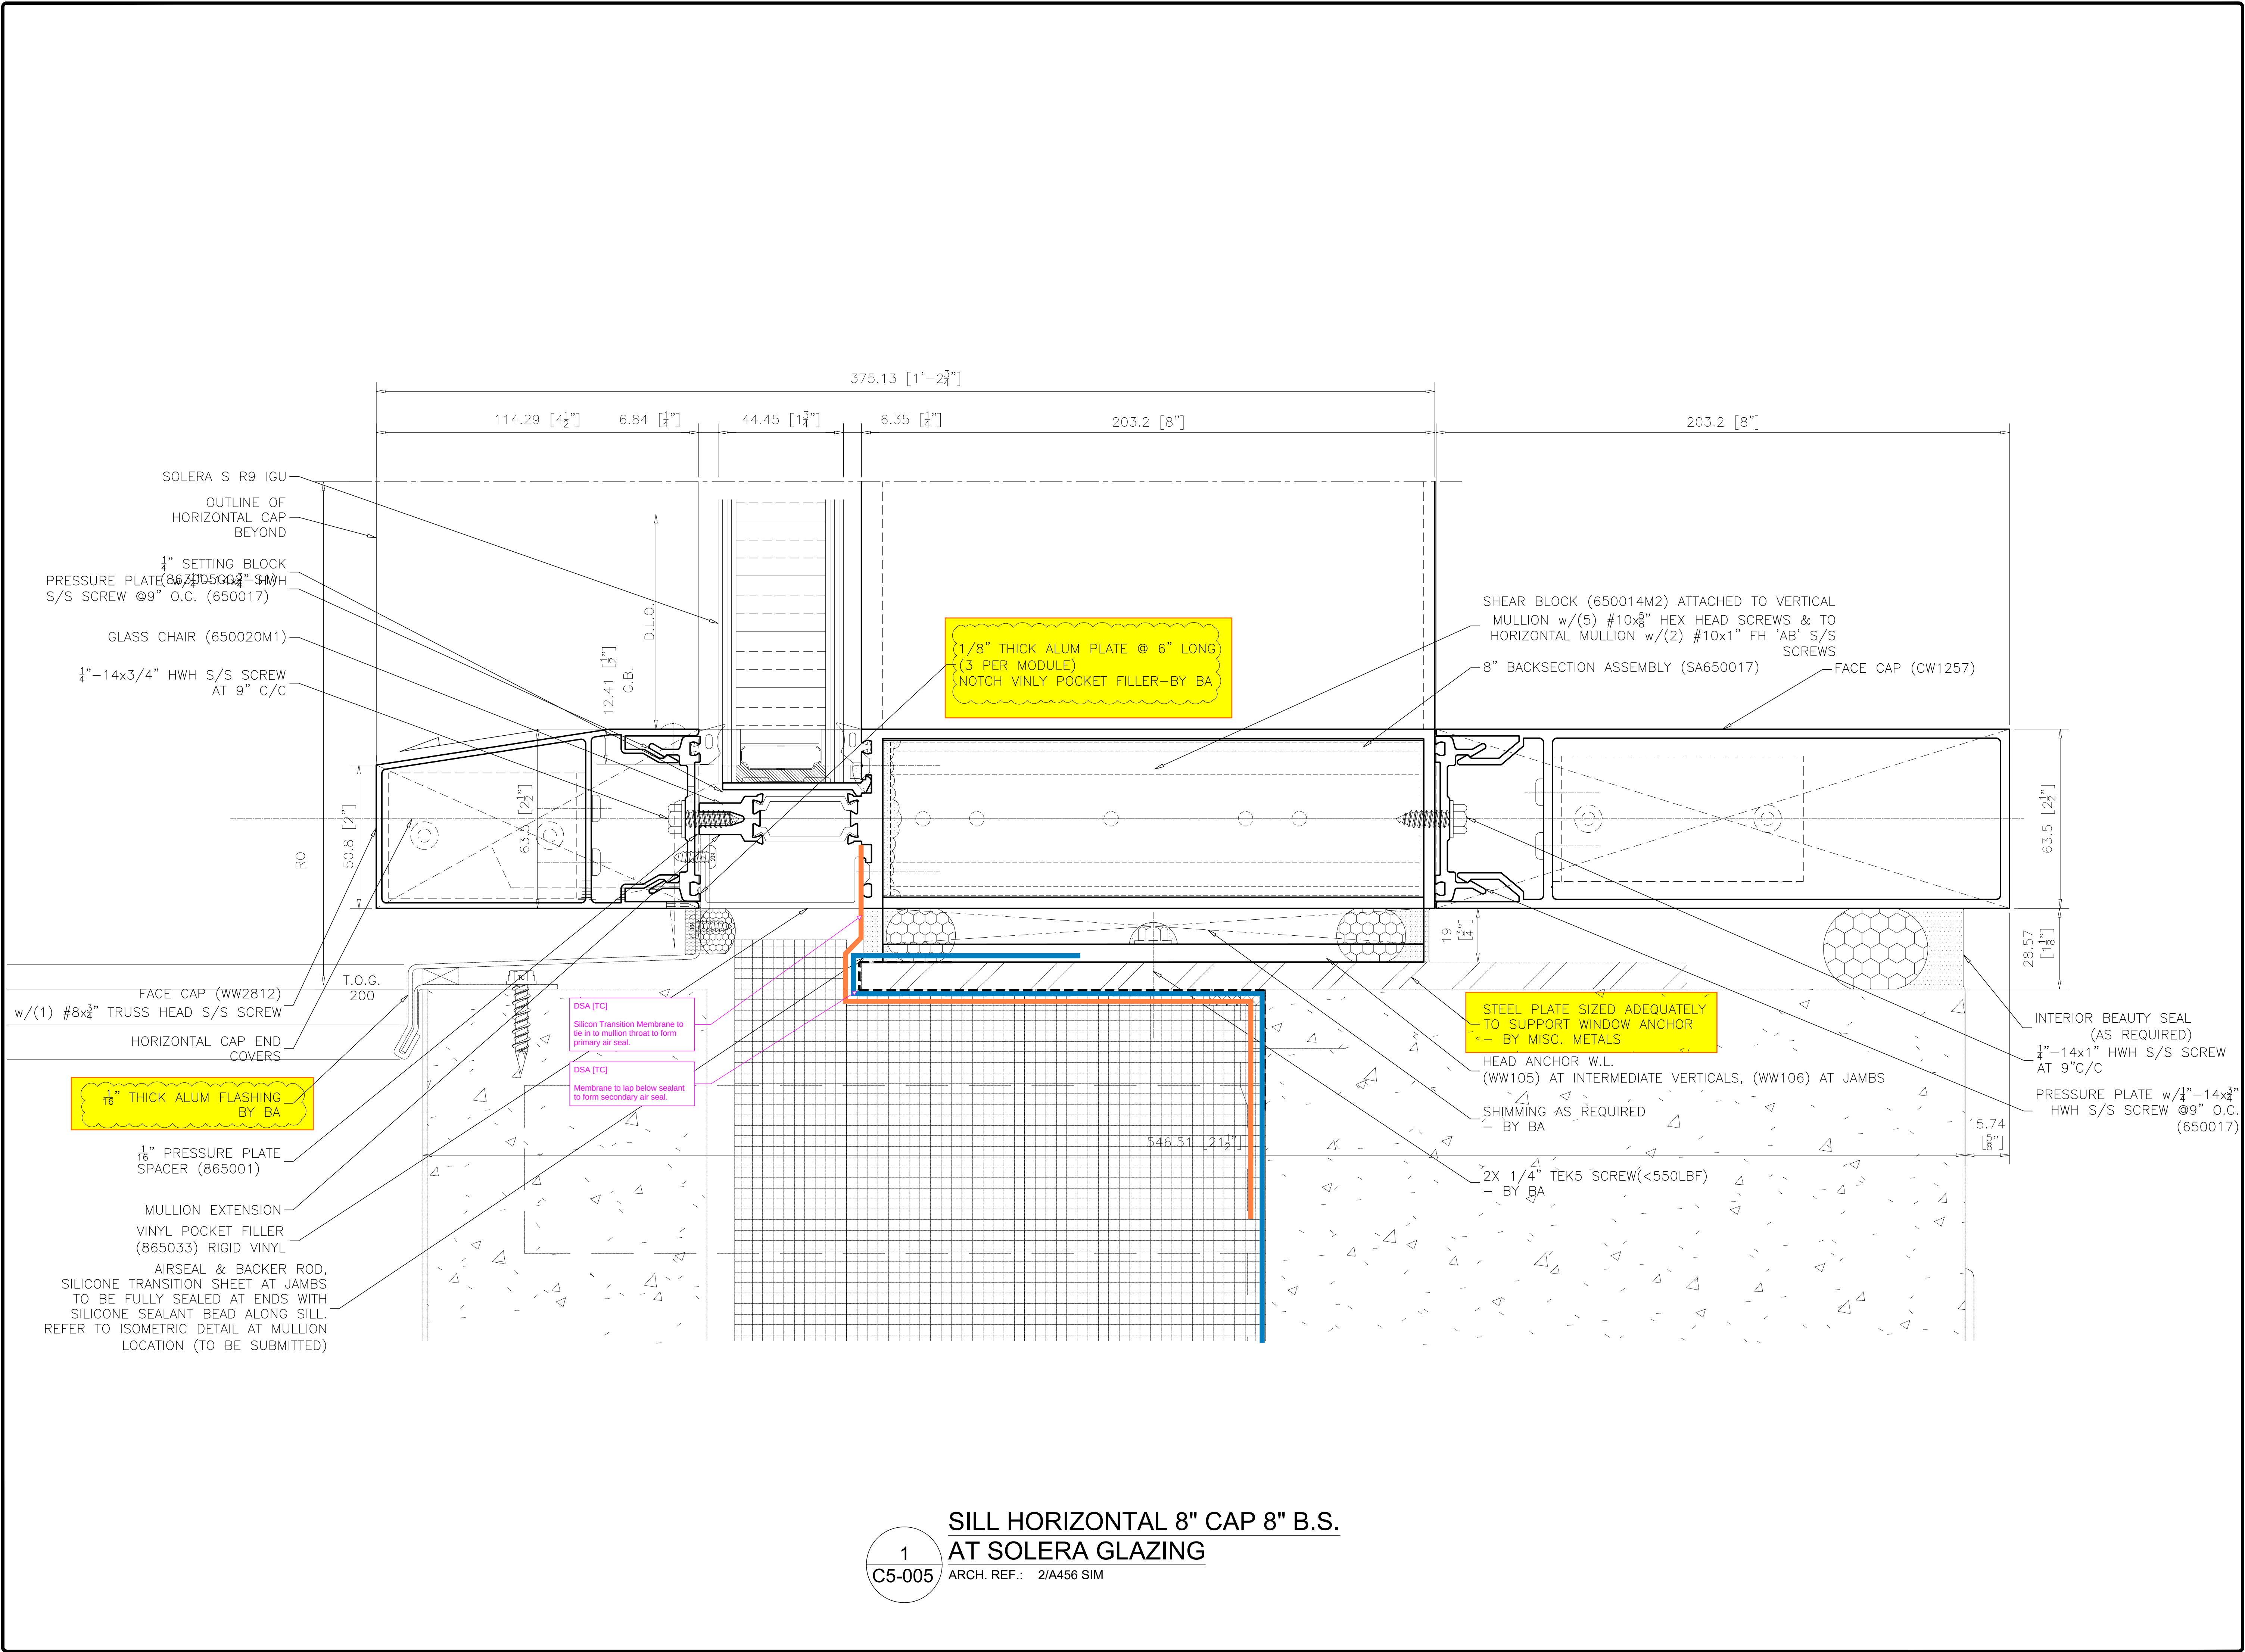

SILL HORIZONTAL 8" CAP 8" B.S.
AT SOLERA GLAZING

1
C5-005
ARCH. REF.: 2/A456 SIM

REVISIONS


No.	Description:	Date:	By:
1	Revised per arch. markups received Feb 11/26	03/03/26	SLR

Project Name:	DOCKSTEADER PRPS
Project Location:	BRAMPTON, ONTARIO
Architect Name:	DIAMOND SCHMITT ARCHITECTS
Customer Name:	BOTHWELL ACCURATE GLAZING

oldcastle BuildingEnvelope®

275 Britannia Road East • Mississauga • Ontario • Canada • L4Z2E7
905-890-6970 • oldcastlebe.com

Drawing Name: SECTION DETAIL	
Drawn By: SR	Checked By: NP
Drawn Date: 2026/01/12	Issue No.: 1
Scale: 1"=1"	Release Date: 2026/03/03
Drawing Number: C5-005	

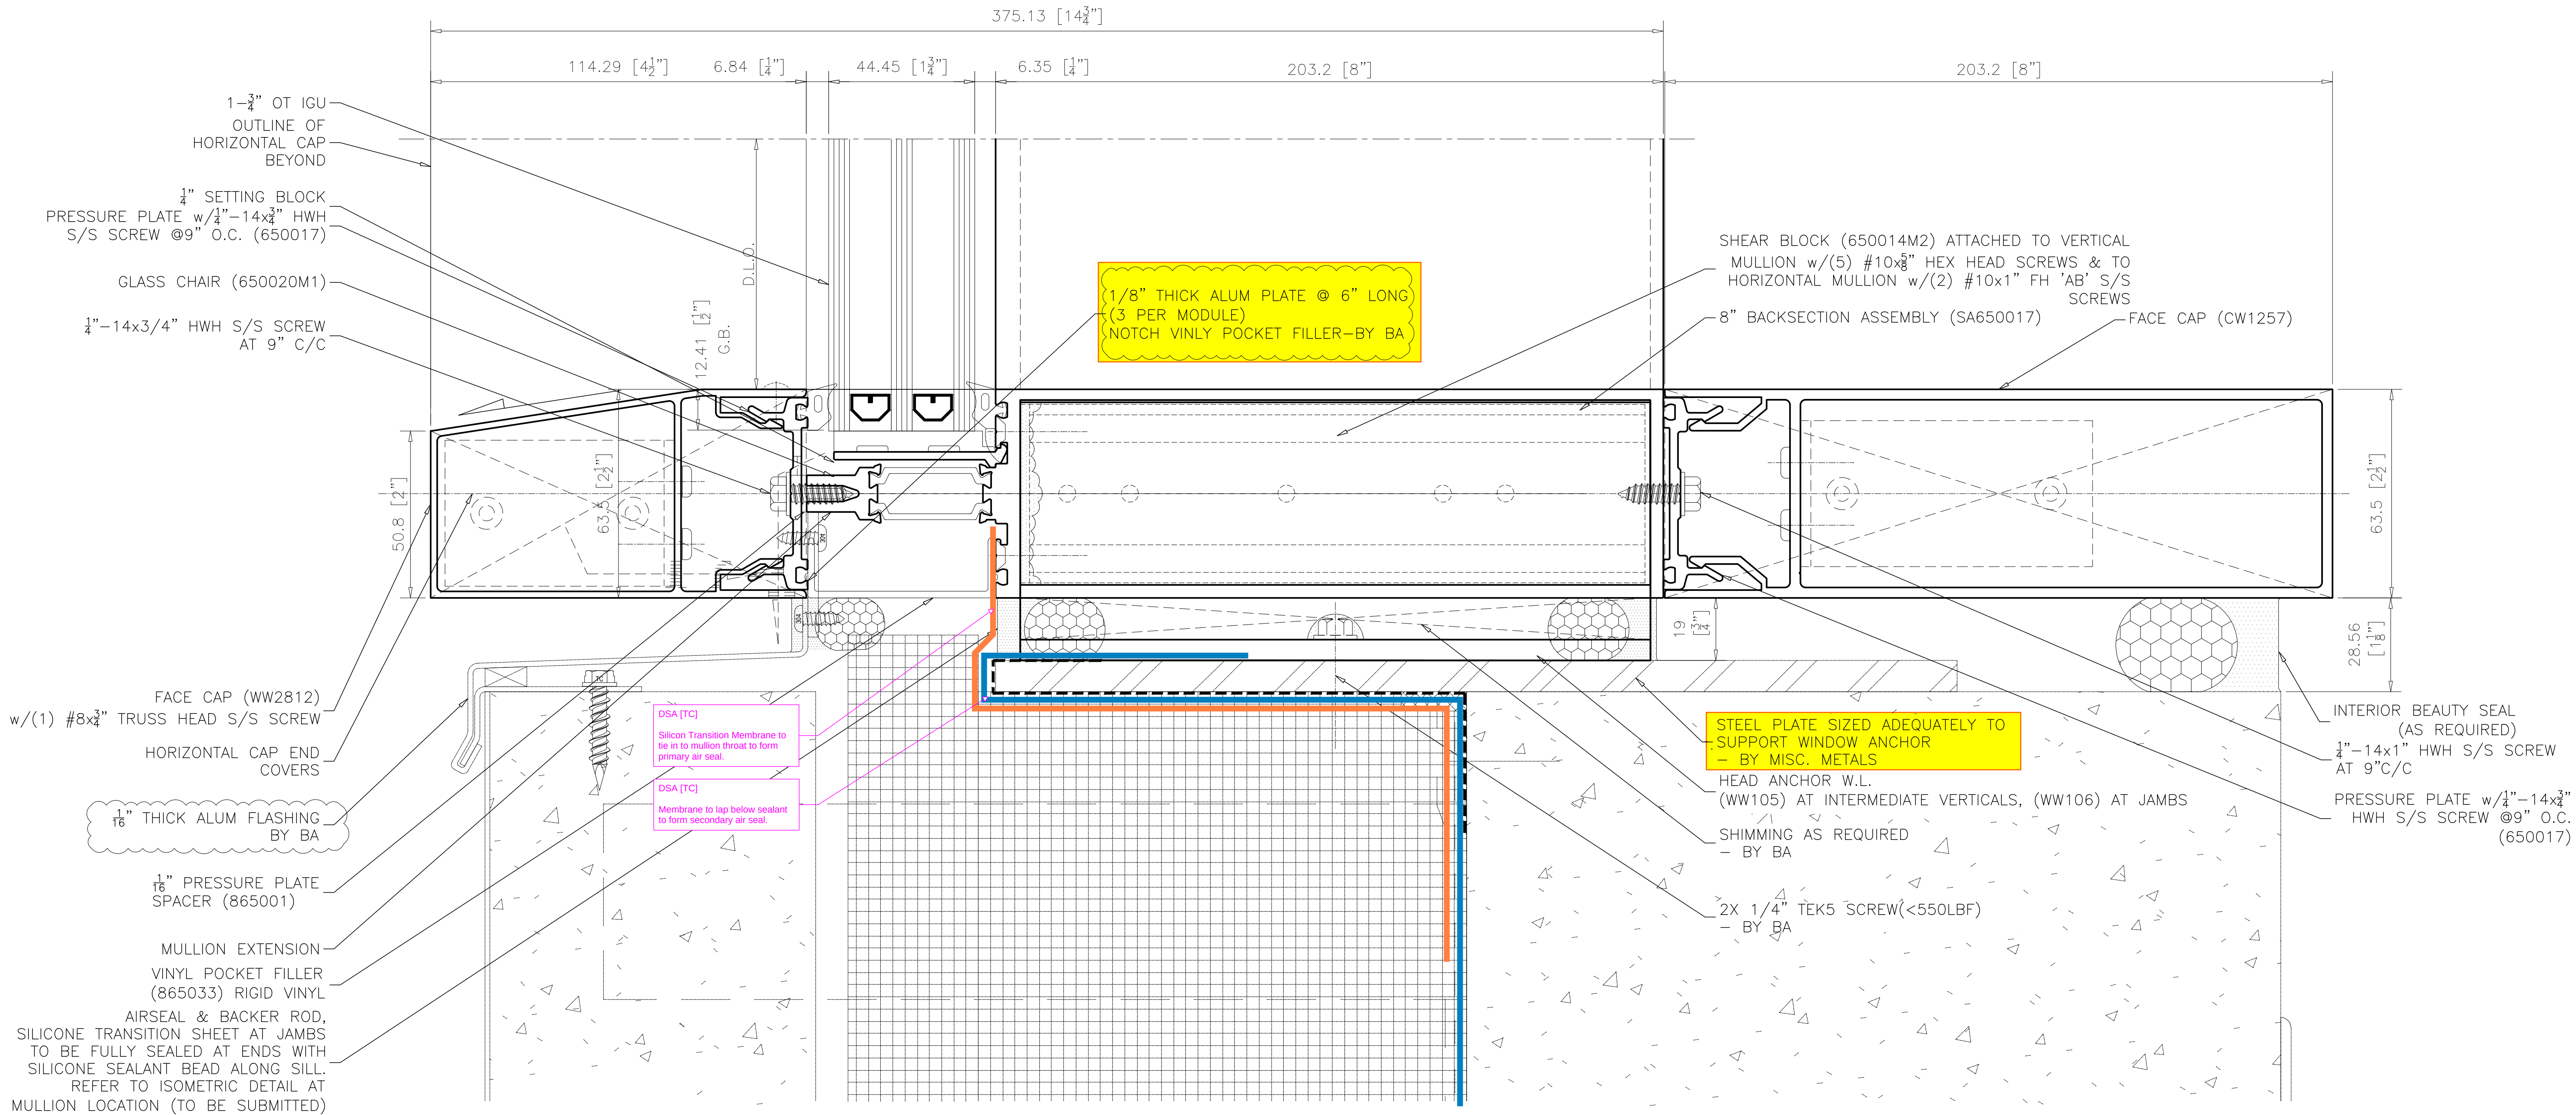

1
C5-005A

SILL HORIZONTAL 4-1/2" CAP 8" B.S.
AT VISION GLAZING

ARCH. REF.: 2/A456 SIM

REVISIONS

No.	Description:	Date:	By:
1	Revised per arch. markups received Feb 11/26	03/03/26	SLR

Misc metals


Project Name:
DOCKSTEADER PRPS

Project Location:
BRAMPTON, ONTARIO

Architect Name:
DIAMOND SCHMITT ARCHITECTS

Customer Name:
BOTHWELL ACCURATE GLAZING

oldcastle BuildingEnvelope®

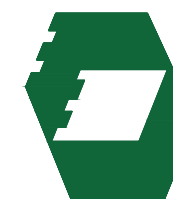

275 Britannia Road East • Mississauga • Ontario • Canada • L4Z2E7
905-890-6970 • oldcastlebe.com

Drawing Name:

SECTION DETAIL

Drawn By:

Checked By:

SR

NP

Drawn Date:

Issue No.:

2026/01/12

1

Scale:


Release Date:

1"=1"

2026/03/03

Drawing Number:

C5-005A

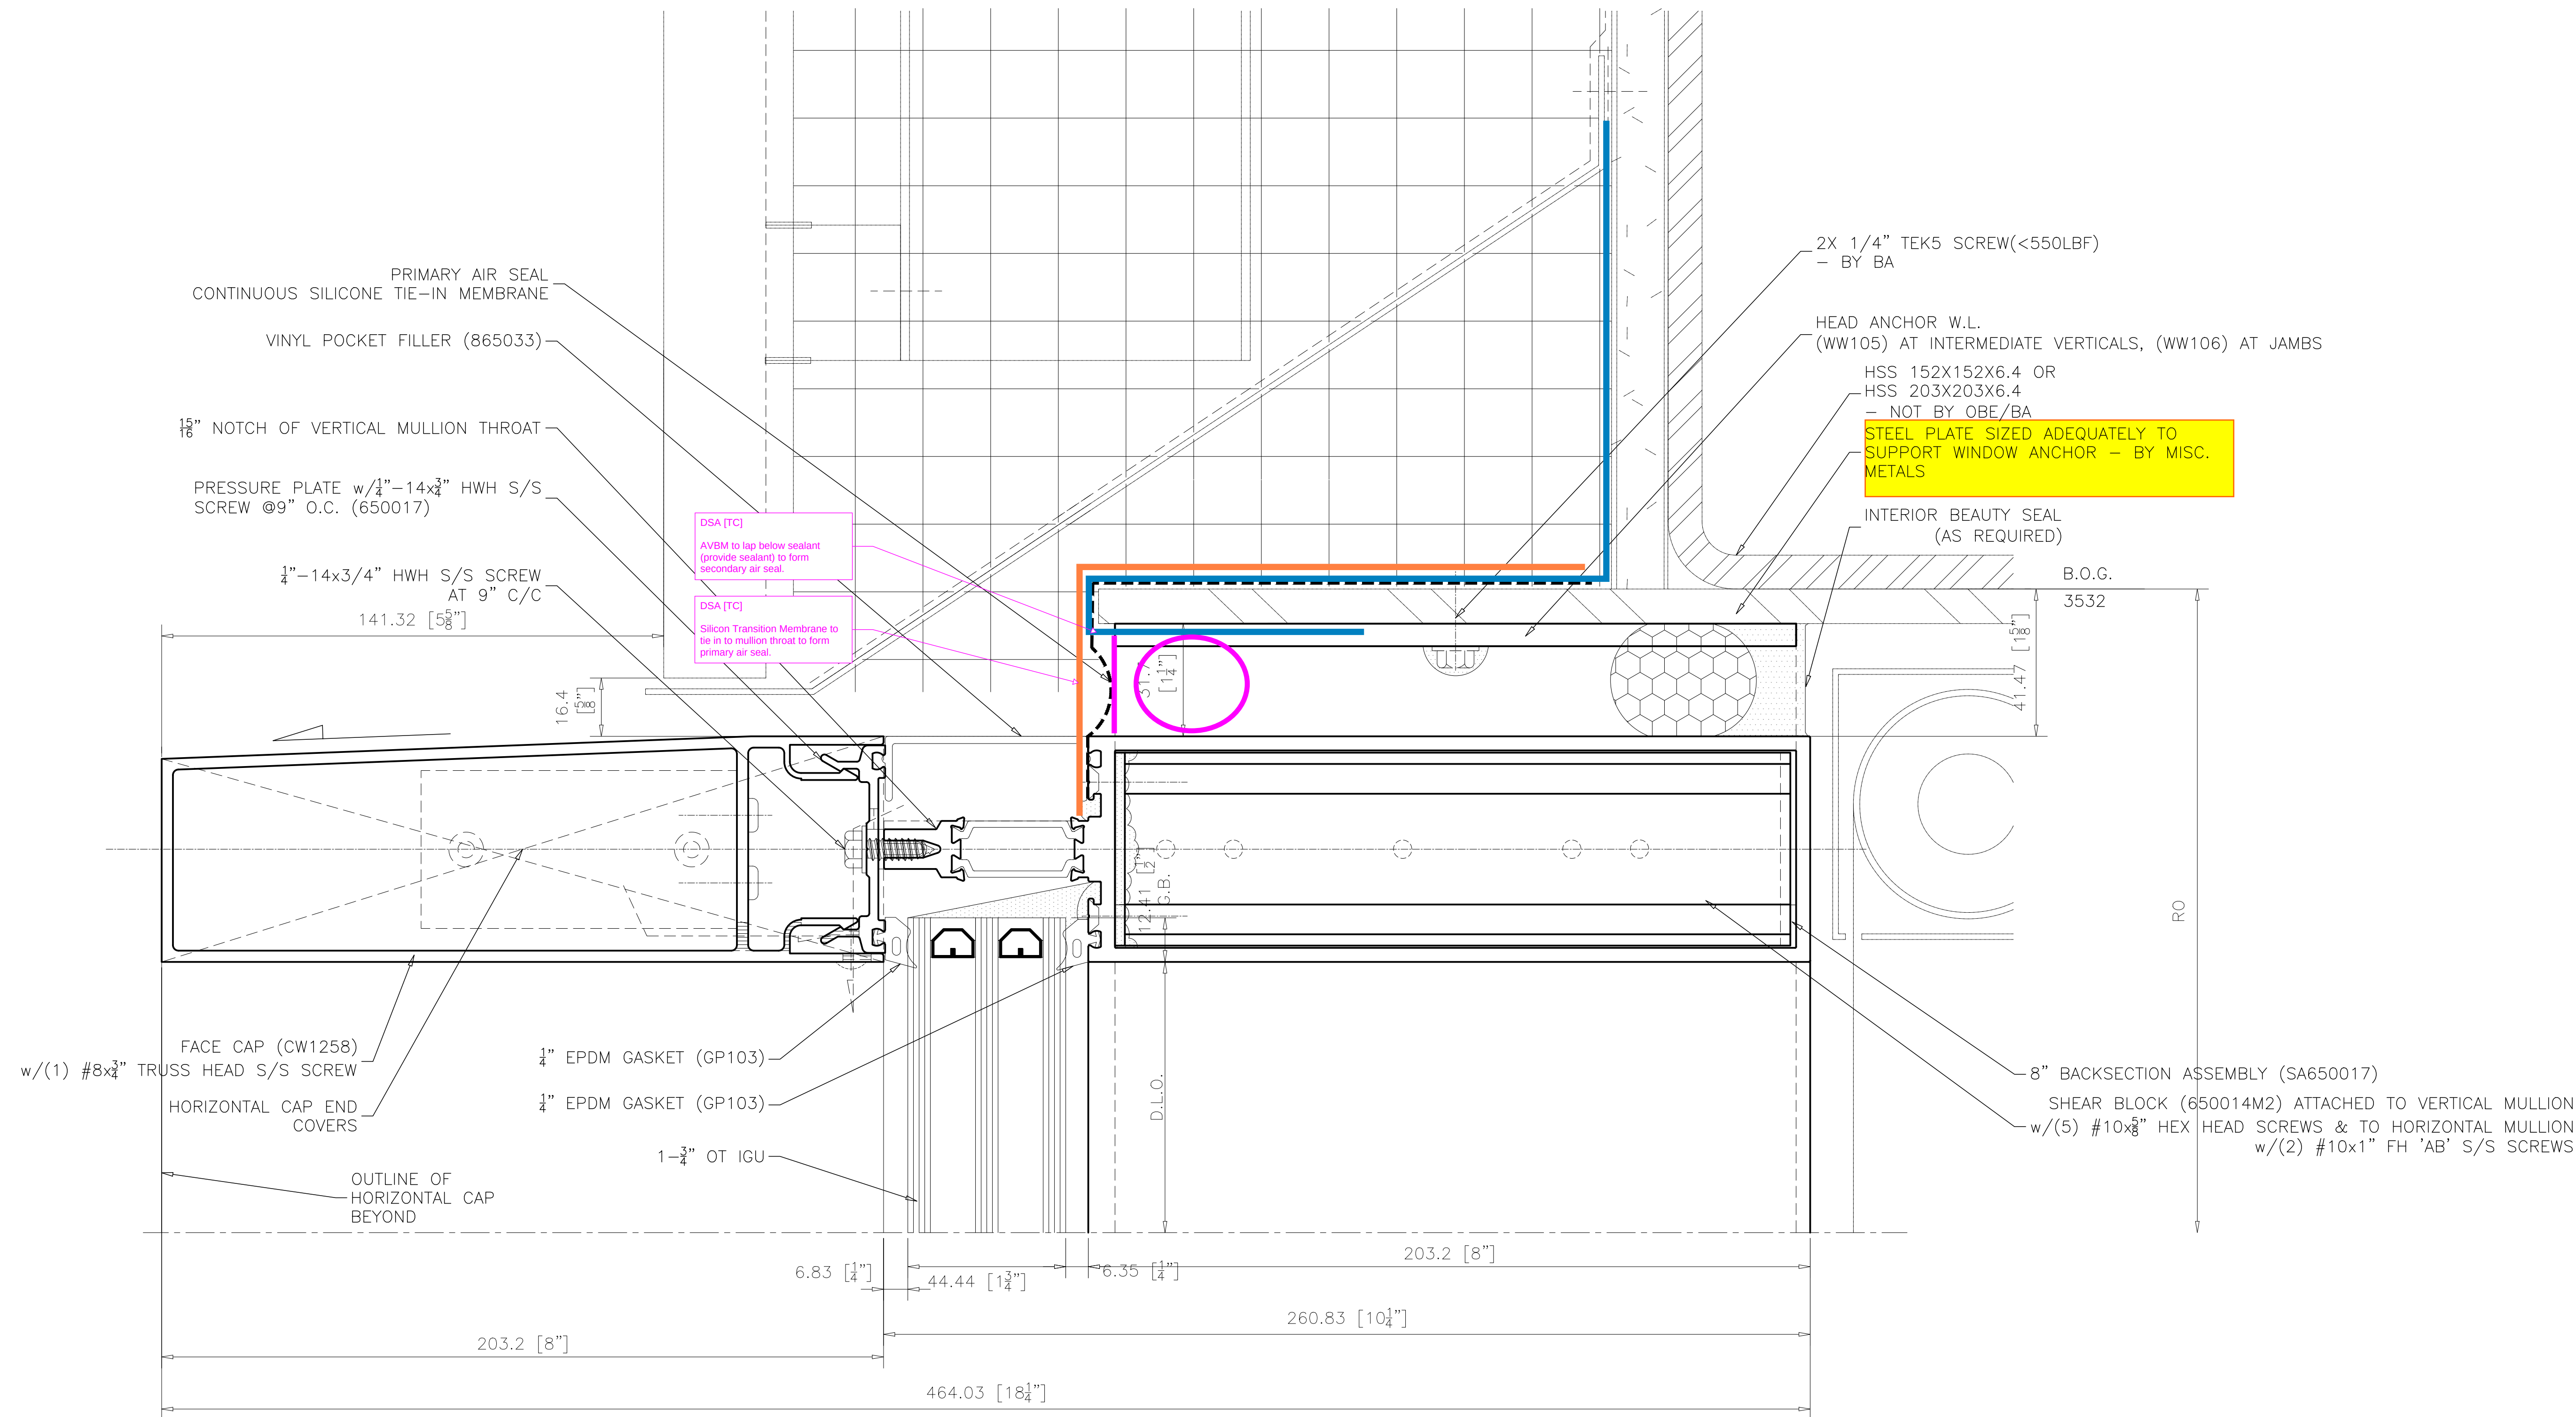

1
C5-006

HEAD HORIZONTAL 8" CAP 8" B.S.
AT VISION GLAZING

ARCH. REF.: 4/A455

REVISIONS

No.	Description:	Date:	By:
1	Revised per arch. markups received Feb 11/26	03/03/26	SLR

Misc metals

Project Name:
DOCKSTEADER PRPS

Project Location:
BRAMPTON, ONTARIO

Architect Name:
DIAMOND SCHMITT ARCHITECTS

Customer Name:
BOTHWELL ACCURATE GLAZING

oldcastle BuildingEnvelope®

275 Britannia Road East • Mississauga • Ontario • Canada • L4Z2E7
905-890-6970 • oldcastlebe.com

Drawing Name:

SECTION DETAIL

Drawn By: SR

Checked By: NP

Drawn Date: 2026/01/12


Issue No.: 1

Scale: 1"=1"

Release Date: 2026/03/03

Drawing Number:

C5-006

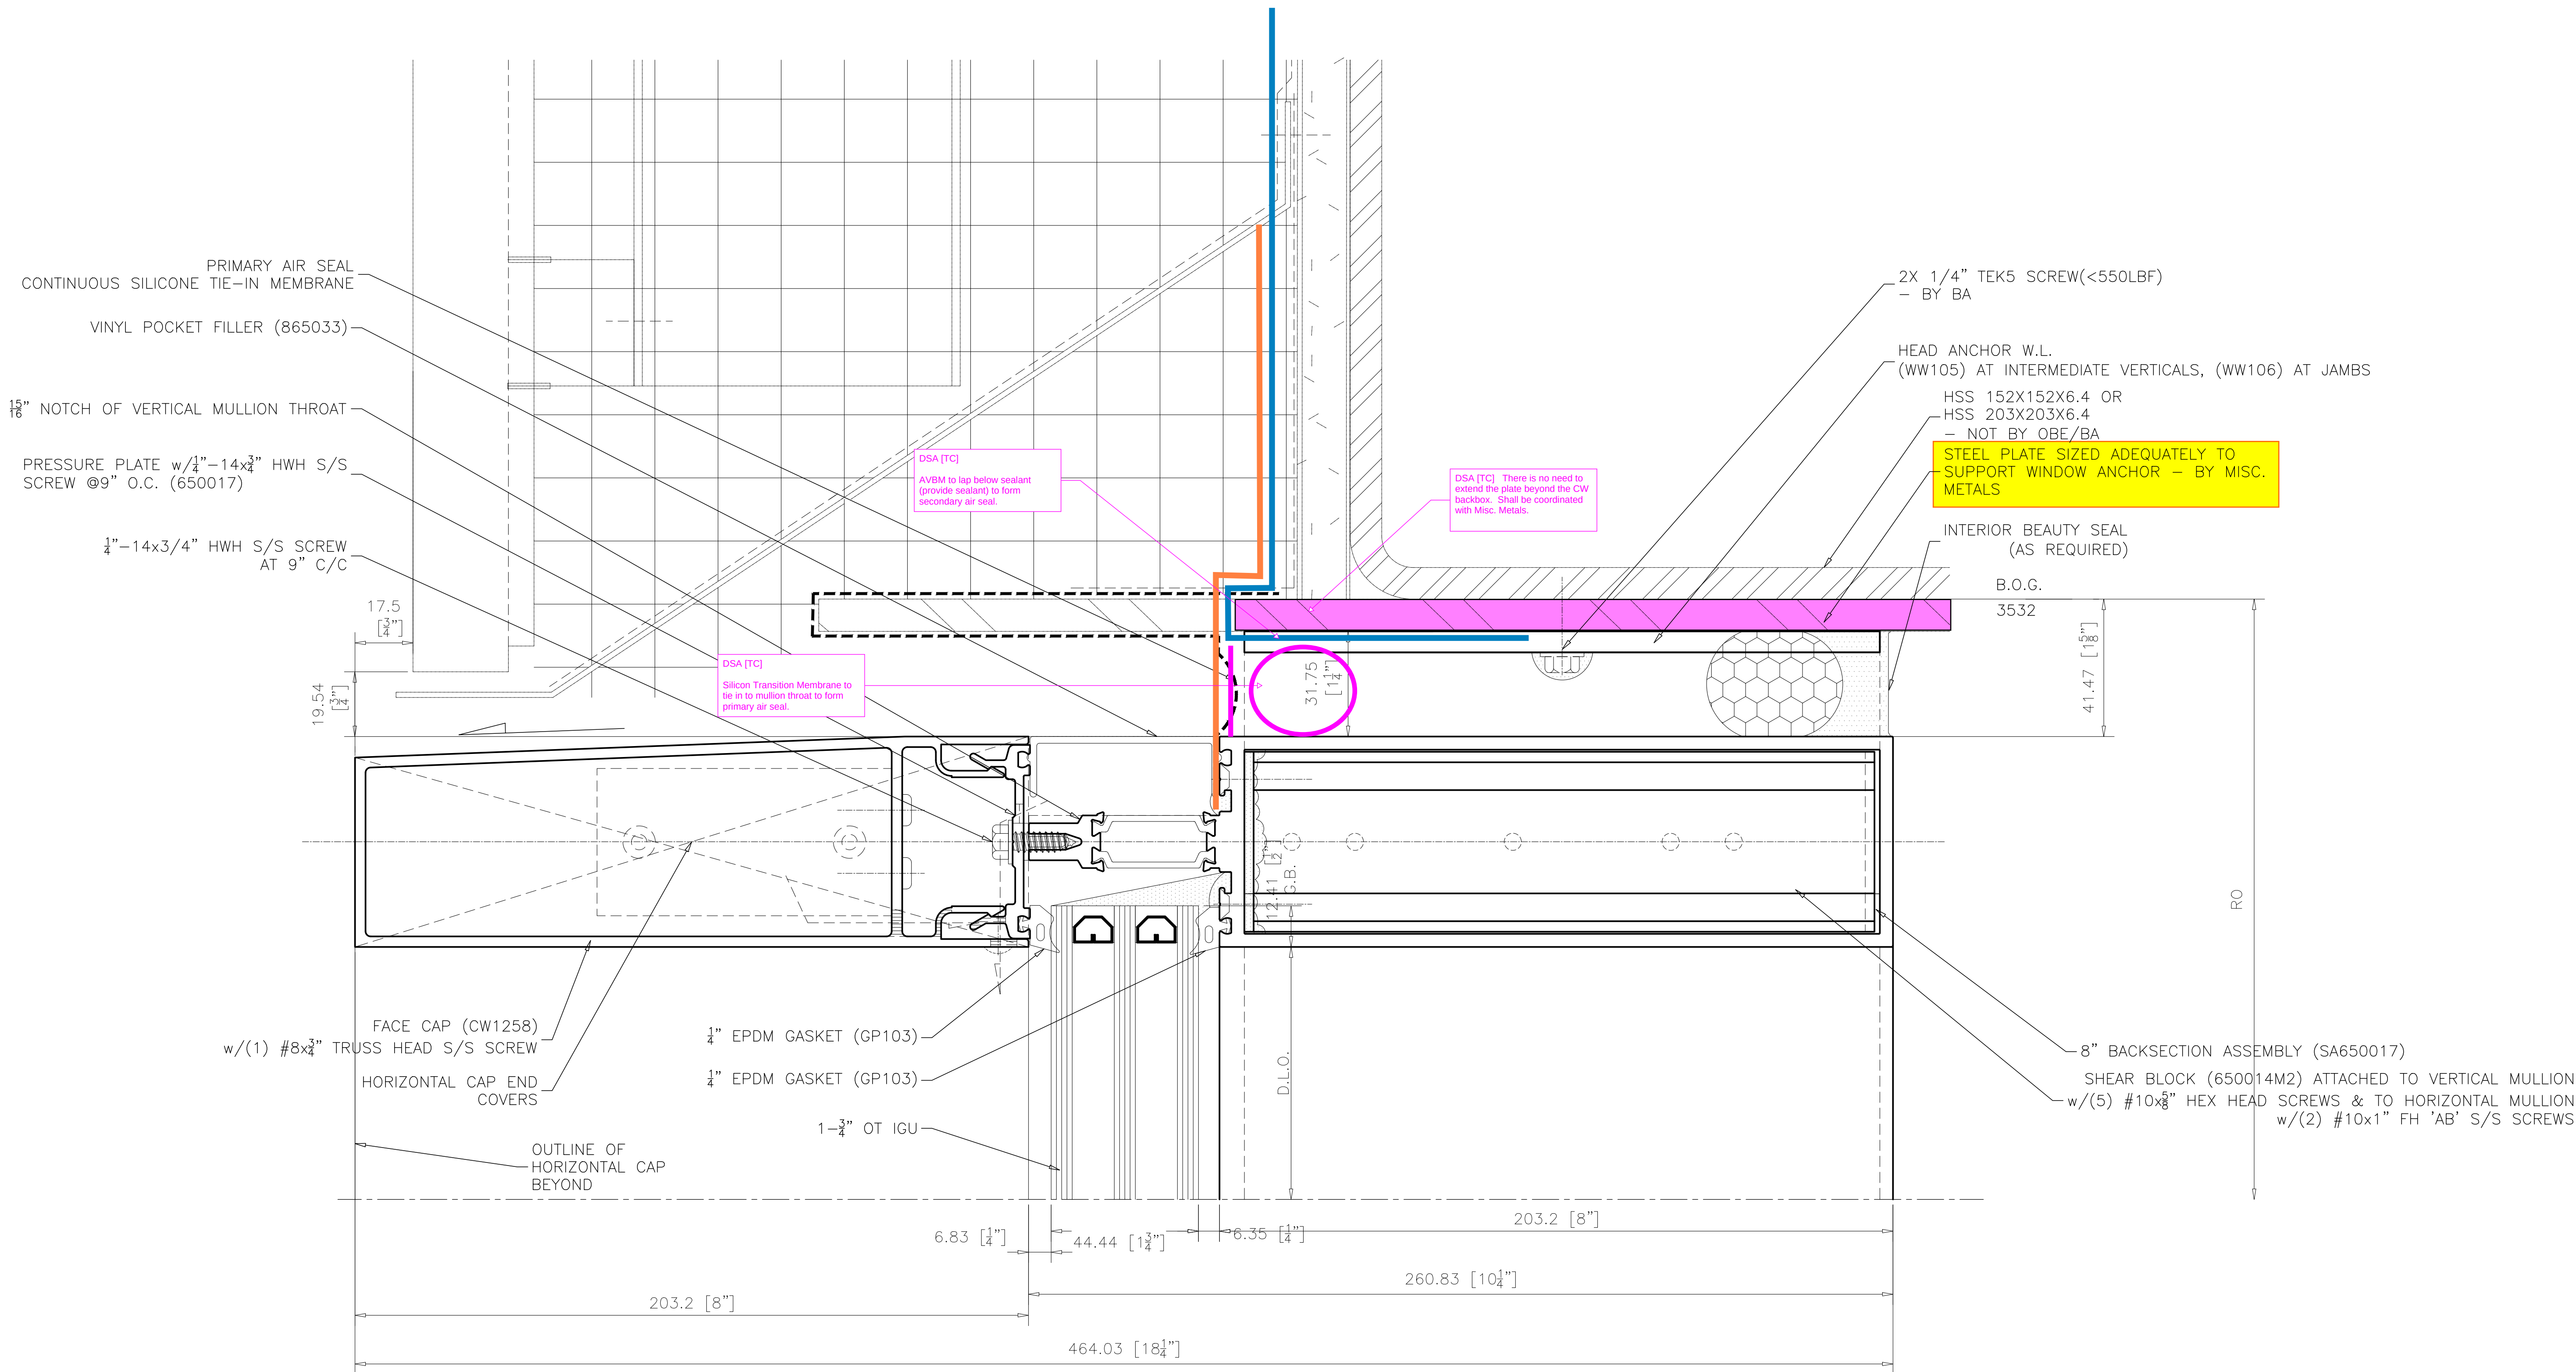

1
C5-006A

HEAD HORIZONTAL 8" CAP 8" B.S.
AT VISION GLAZING

ARCH. REF.: 3/A451

REVISIONS


No.	Description:	Date:	By:
1	Revised per arch. markups received Feb 11/26	03/03/26	SLR

Project Name: DOCKSTEADER PRPS	Project Location: BRAMPTON, ONTARIO	Architect Name: DIAMOND SCHMITT ARCHITECTS	Customer Name: BOTHWELL ACCURATE GLAZING
-----------------------------------	--	---	---

oldcastle BuildingEnvelope®

275 Britannia Road East • Mississauga • Ontario • Canada • L4Z2E7
905-890-6970 • oldcastlebe.com

Drawing Name: SECTION DETAIL	
Drawn By: SR	Checked By: NP
Drawn Date: 2026/01/12	Issue No.: 1
Scale: 1"=1"	Release Date: 2026/03/03
Drawing Number: C5-006A	

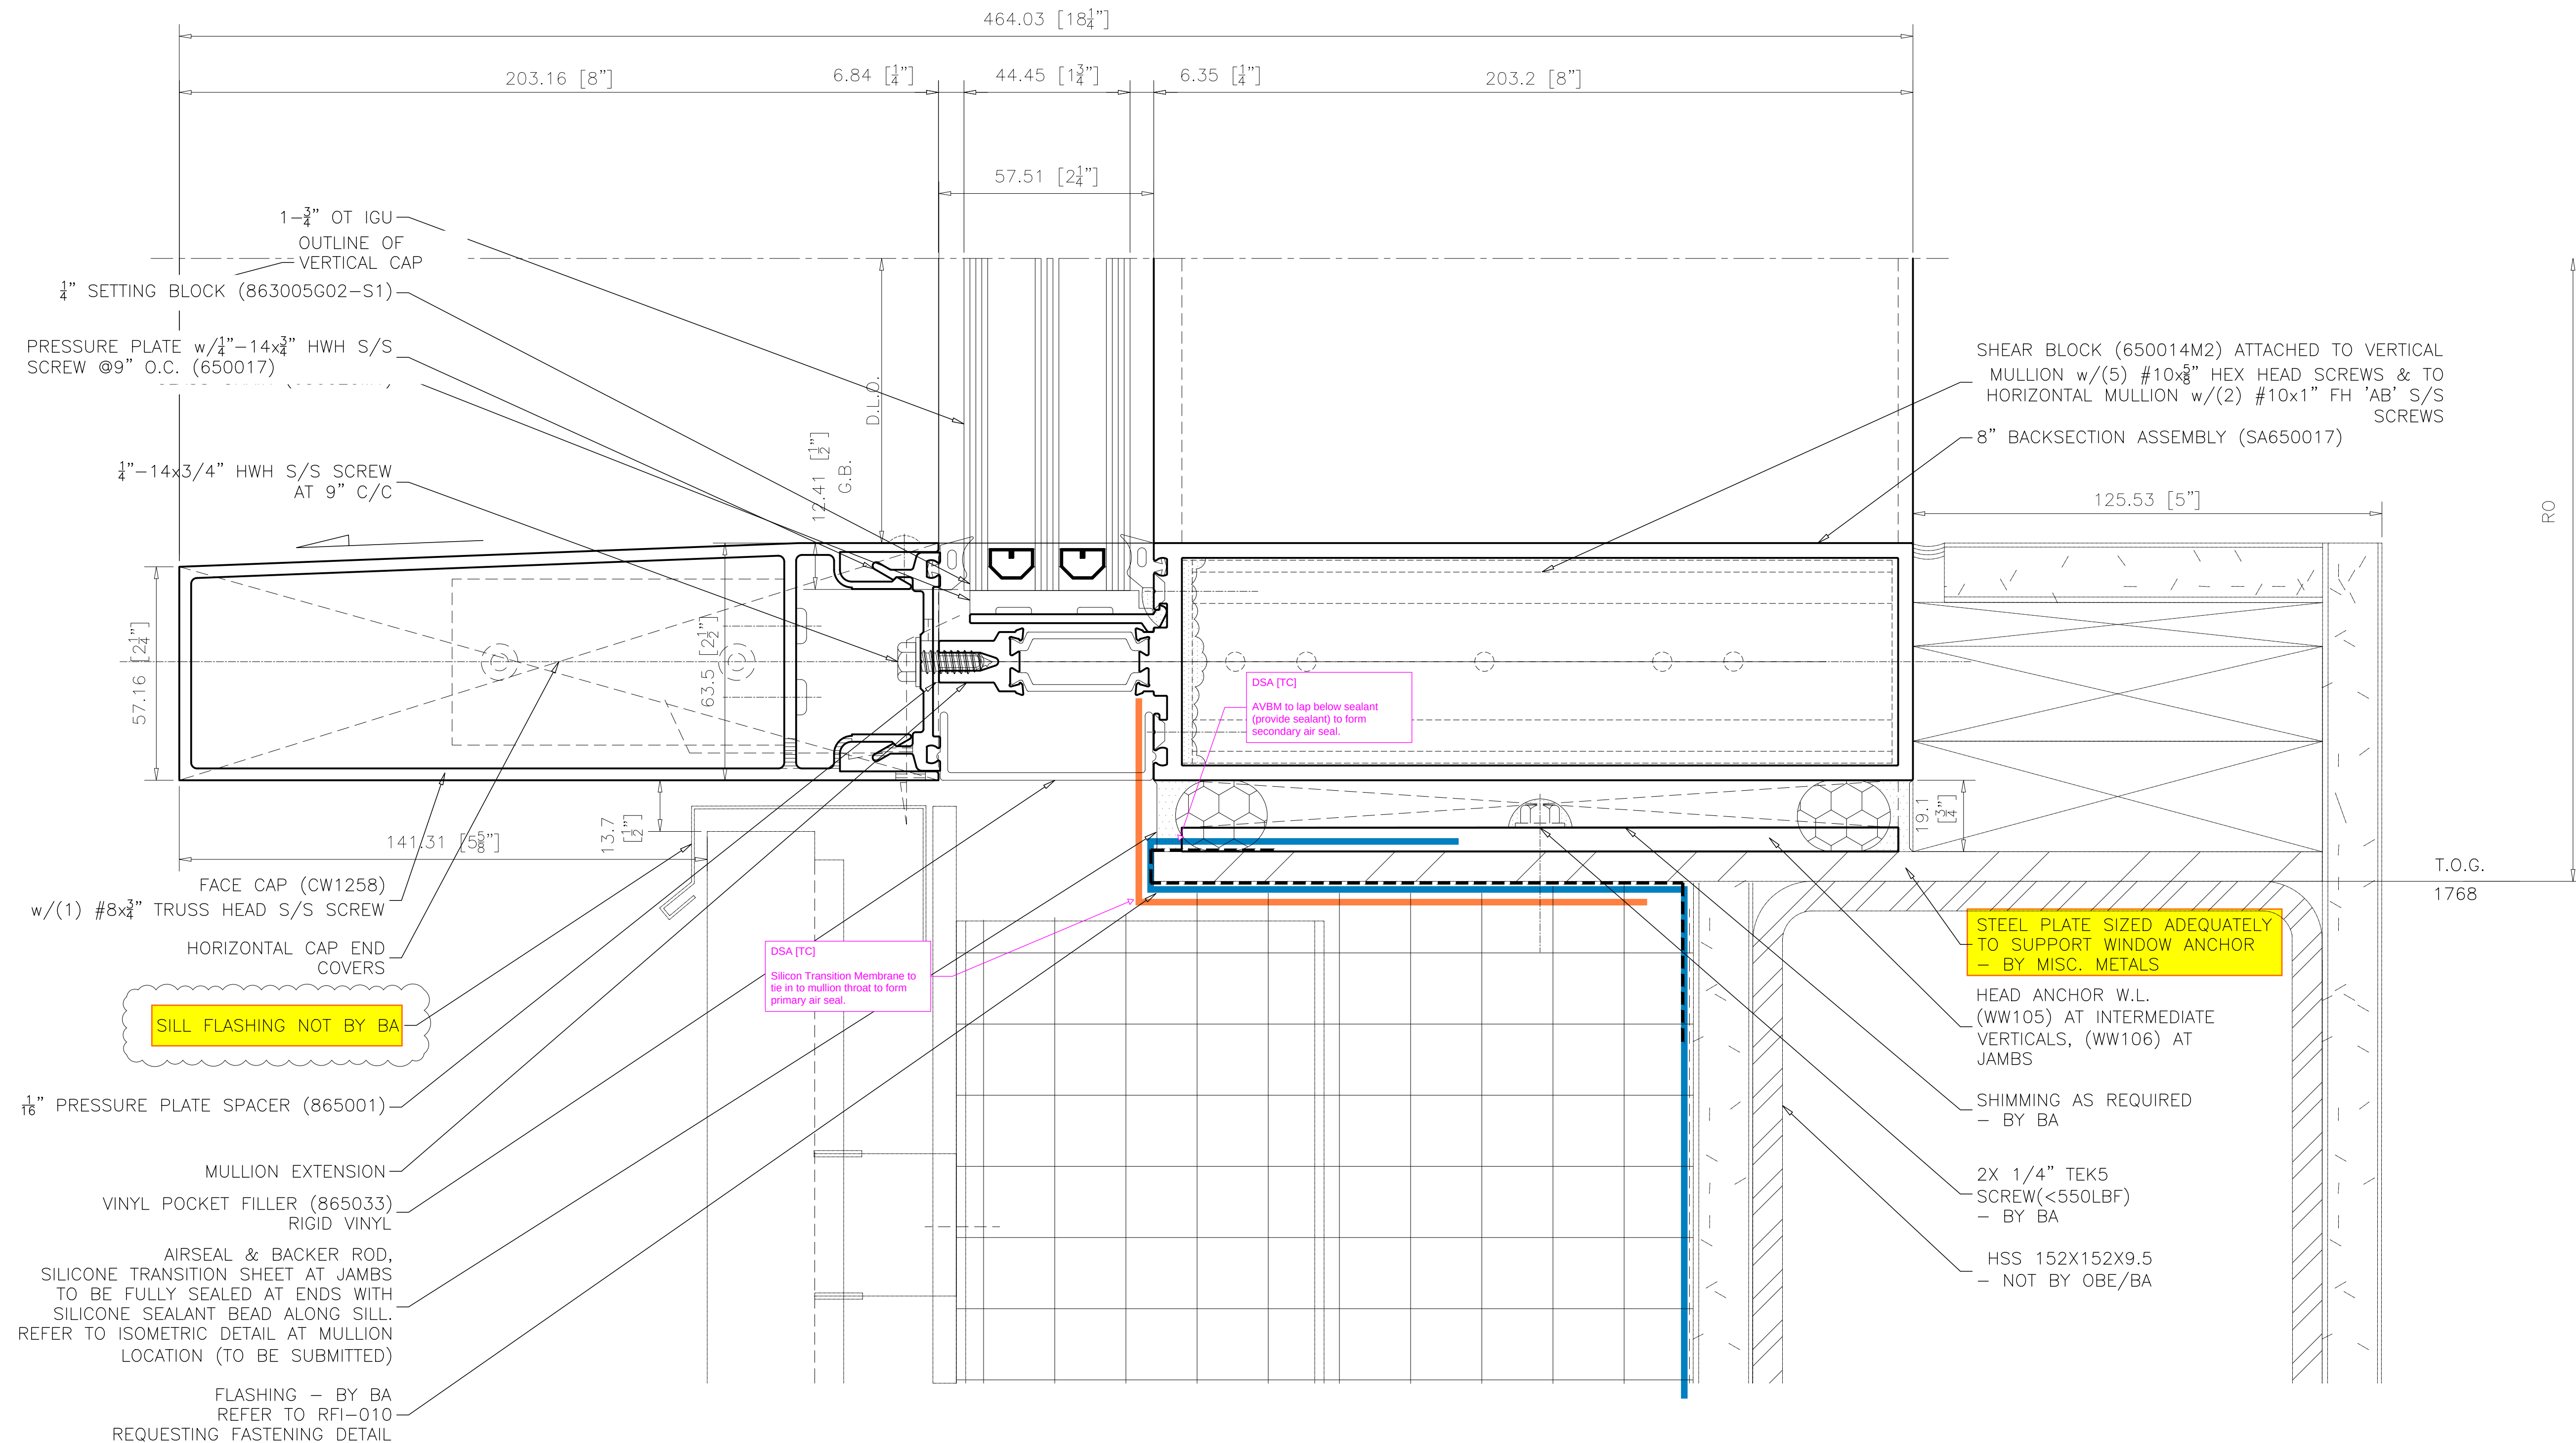

1
C5-007

**SILL HORIZONTAL 8" CAP 8" B.S.
AT VISION GLAZING**

ARCH. REF.: 3/A455

REVISIONS

No.	Description:	Date:	By:
1	Revised per arch. markups received Feb 11/26	03/03/26	SLR

Project Name:
DOCKSTEADER PRPS

Project Location:
BRAMPTON, ONTARIO

Architect Name:
DIAMOND SCHMITT ARCHITECTS

Customer Name:
BOTHWELL ACCURATE GLAZING

oldcastle BuildingEnvelope®


275 Britannia Road East • Mississauga • Ontario • Canada • L4Z2E7
905-890-6970 • oldcastlebe.com

Drawing Name:

SECTION DETAIL

Drawn By: SR	Checked By: NP
Drawn Date: 2026/01/12	Issue No.: 1
Scale: 1"=1"	Release Date: 2026/03/03

Drawing Number:
C5-007

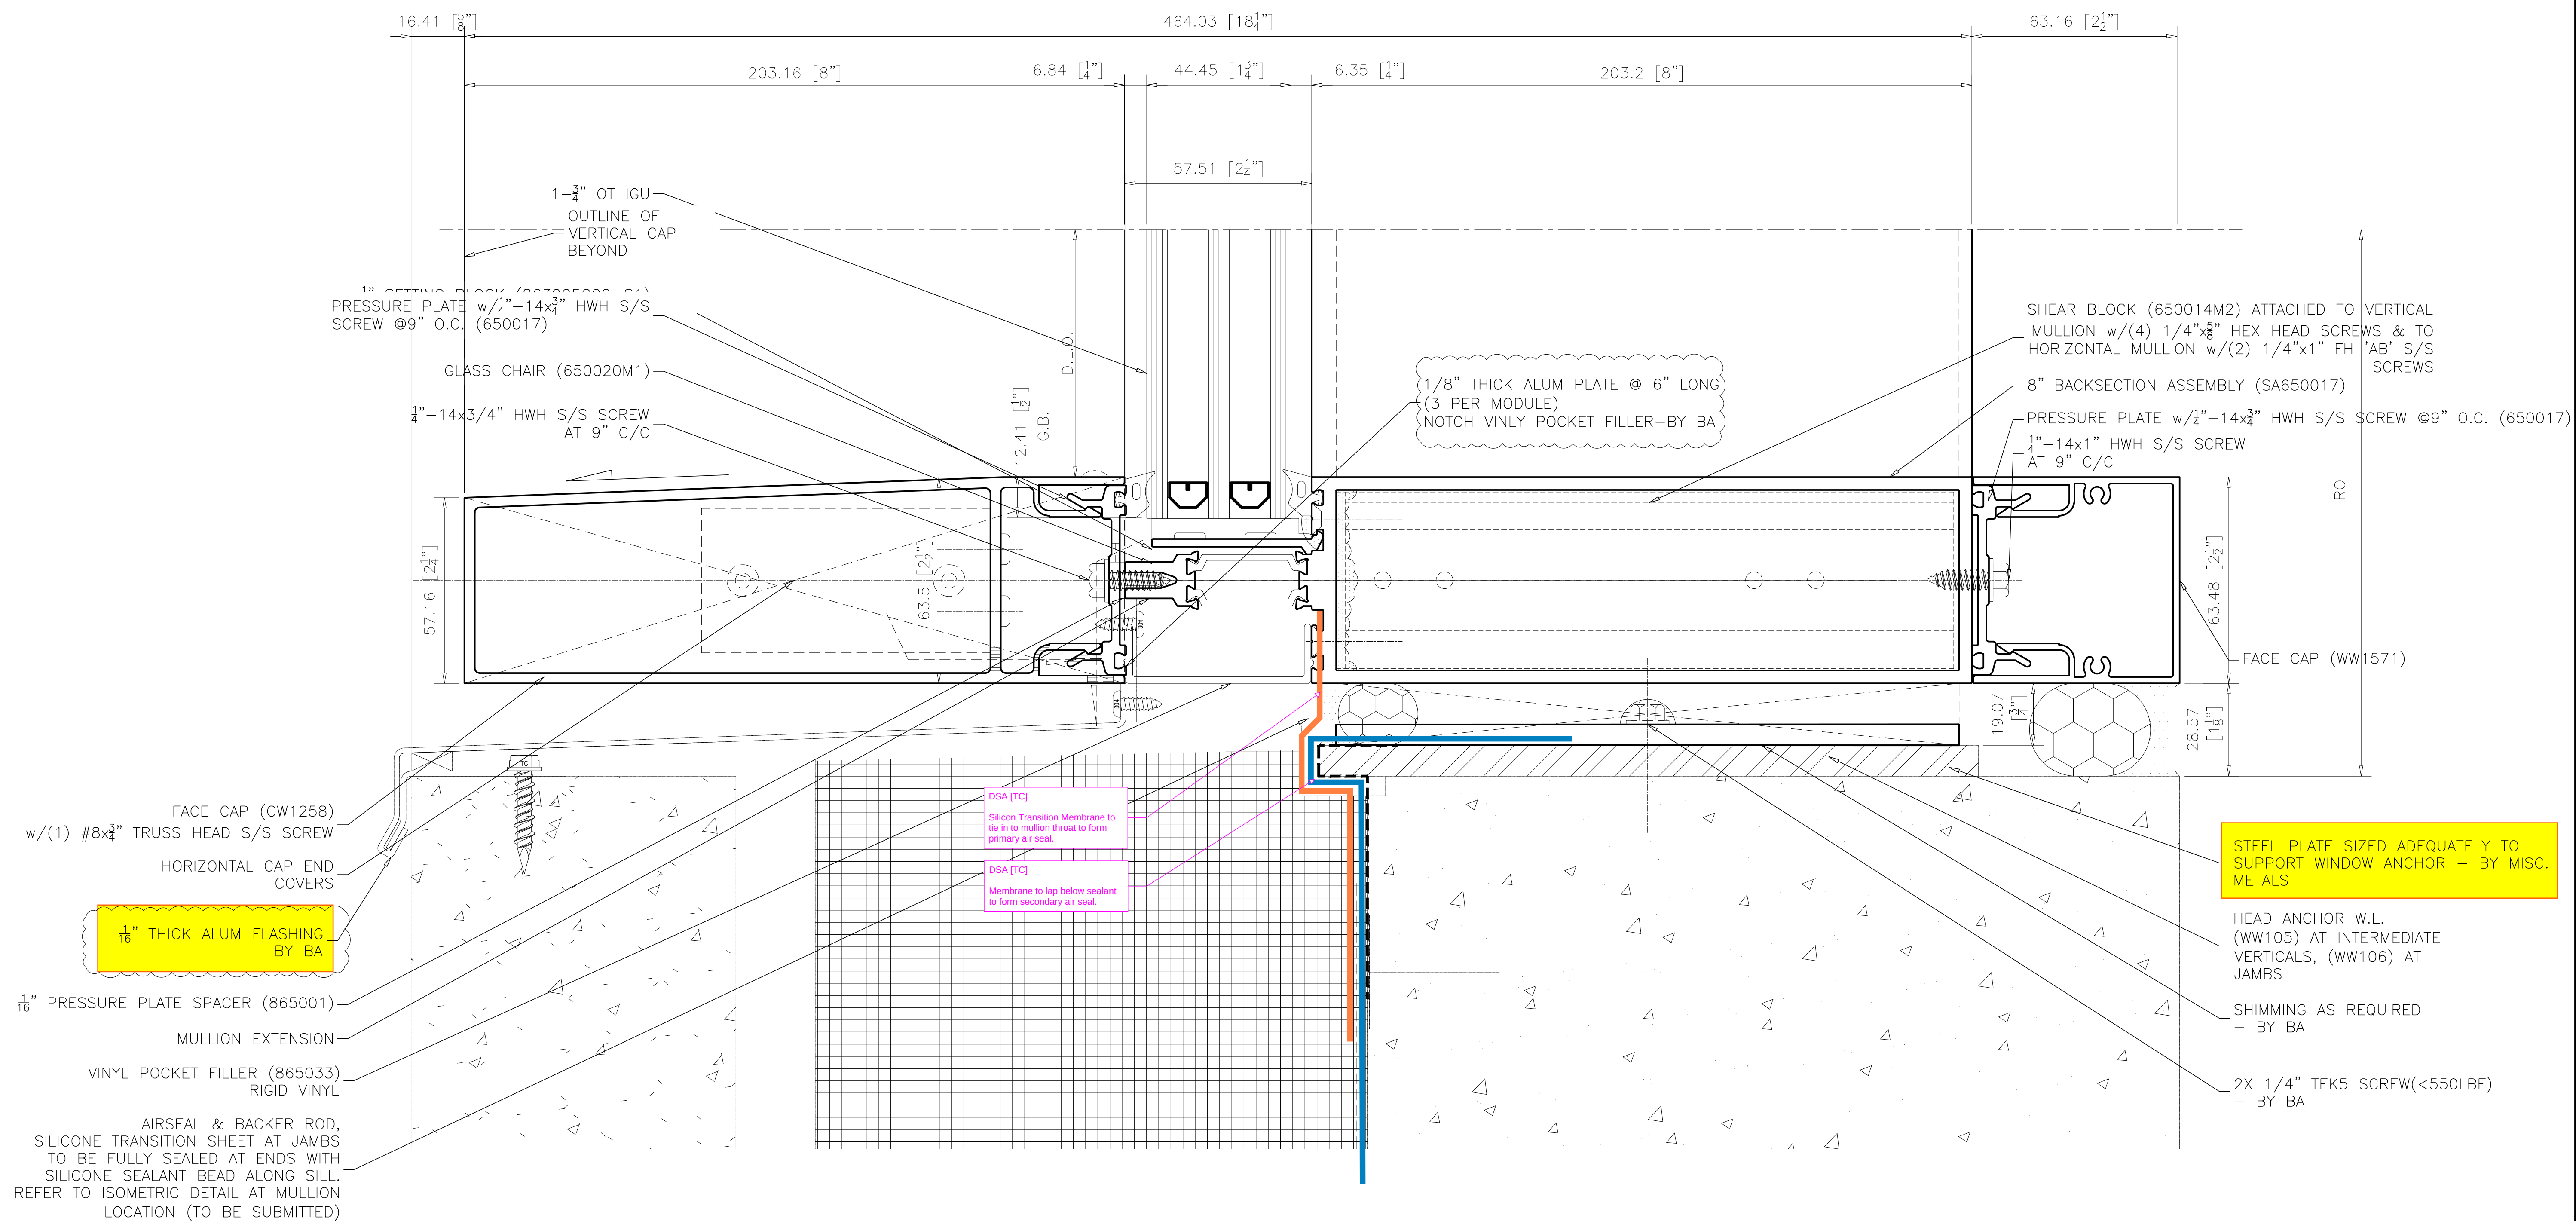

1
C5-007A

SILL HORIZONTAL 8" CAP 8" B.S. AT VISION GLAZING

ARCH. REF.: 2/A451

REVISIONS

No.	Description:	Date:	By:
1	Revised per arch. markups received Feb 11/26	03/03/26	SLR


Project Name:
DOCKSTEADER PRPS

Project Location:
BRAMPTON, ONTARIO

Architect Name:
DIAMOND SCHMITT ARCHITECTS

Customer Name:
BOTHWELL ACCURATE GLAZING

oldcastle BuildingEnvelope®

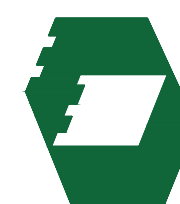

275 Britannia Road East • Mississauga • Ontario • Canada • L4Z2E7
905-890-6970 • oldcastlebe.com


Drawing Name:

SECTION DETAIL

Drawn By: SR	Checked By: NP
Drawn Date: 2026/01/12	Issue No.: 1
Scale: 1"=1"	Release Date: 2026/03/03

Drawing Number:

C5-007A

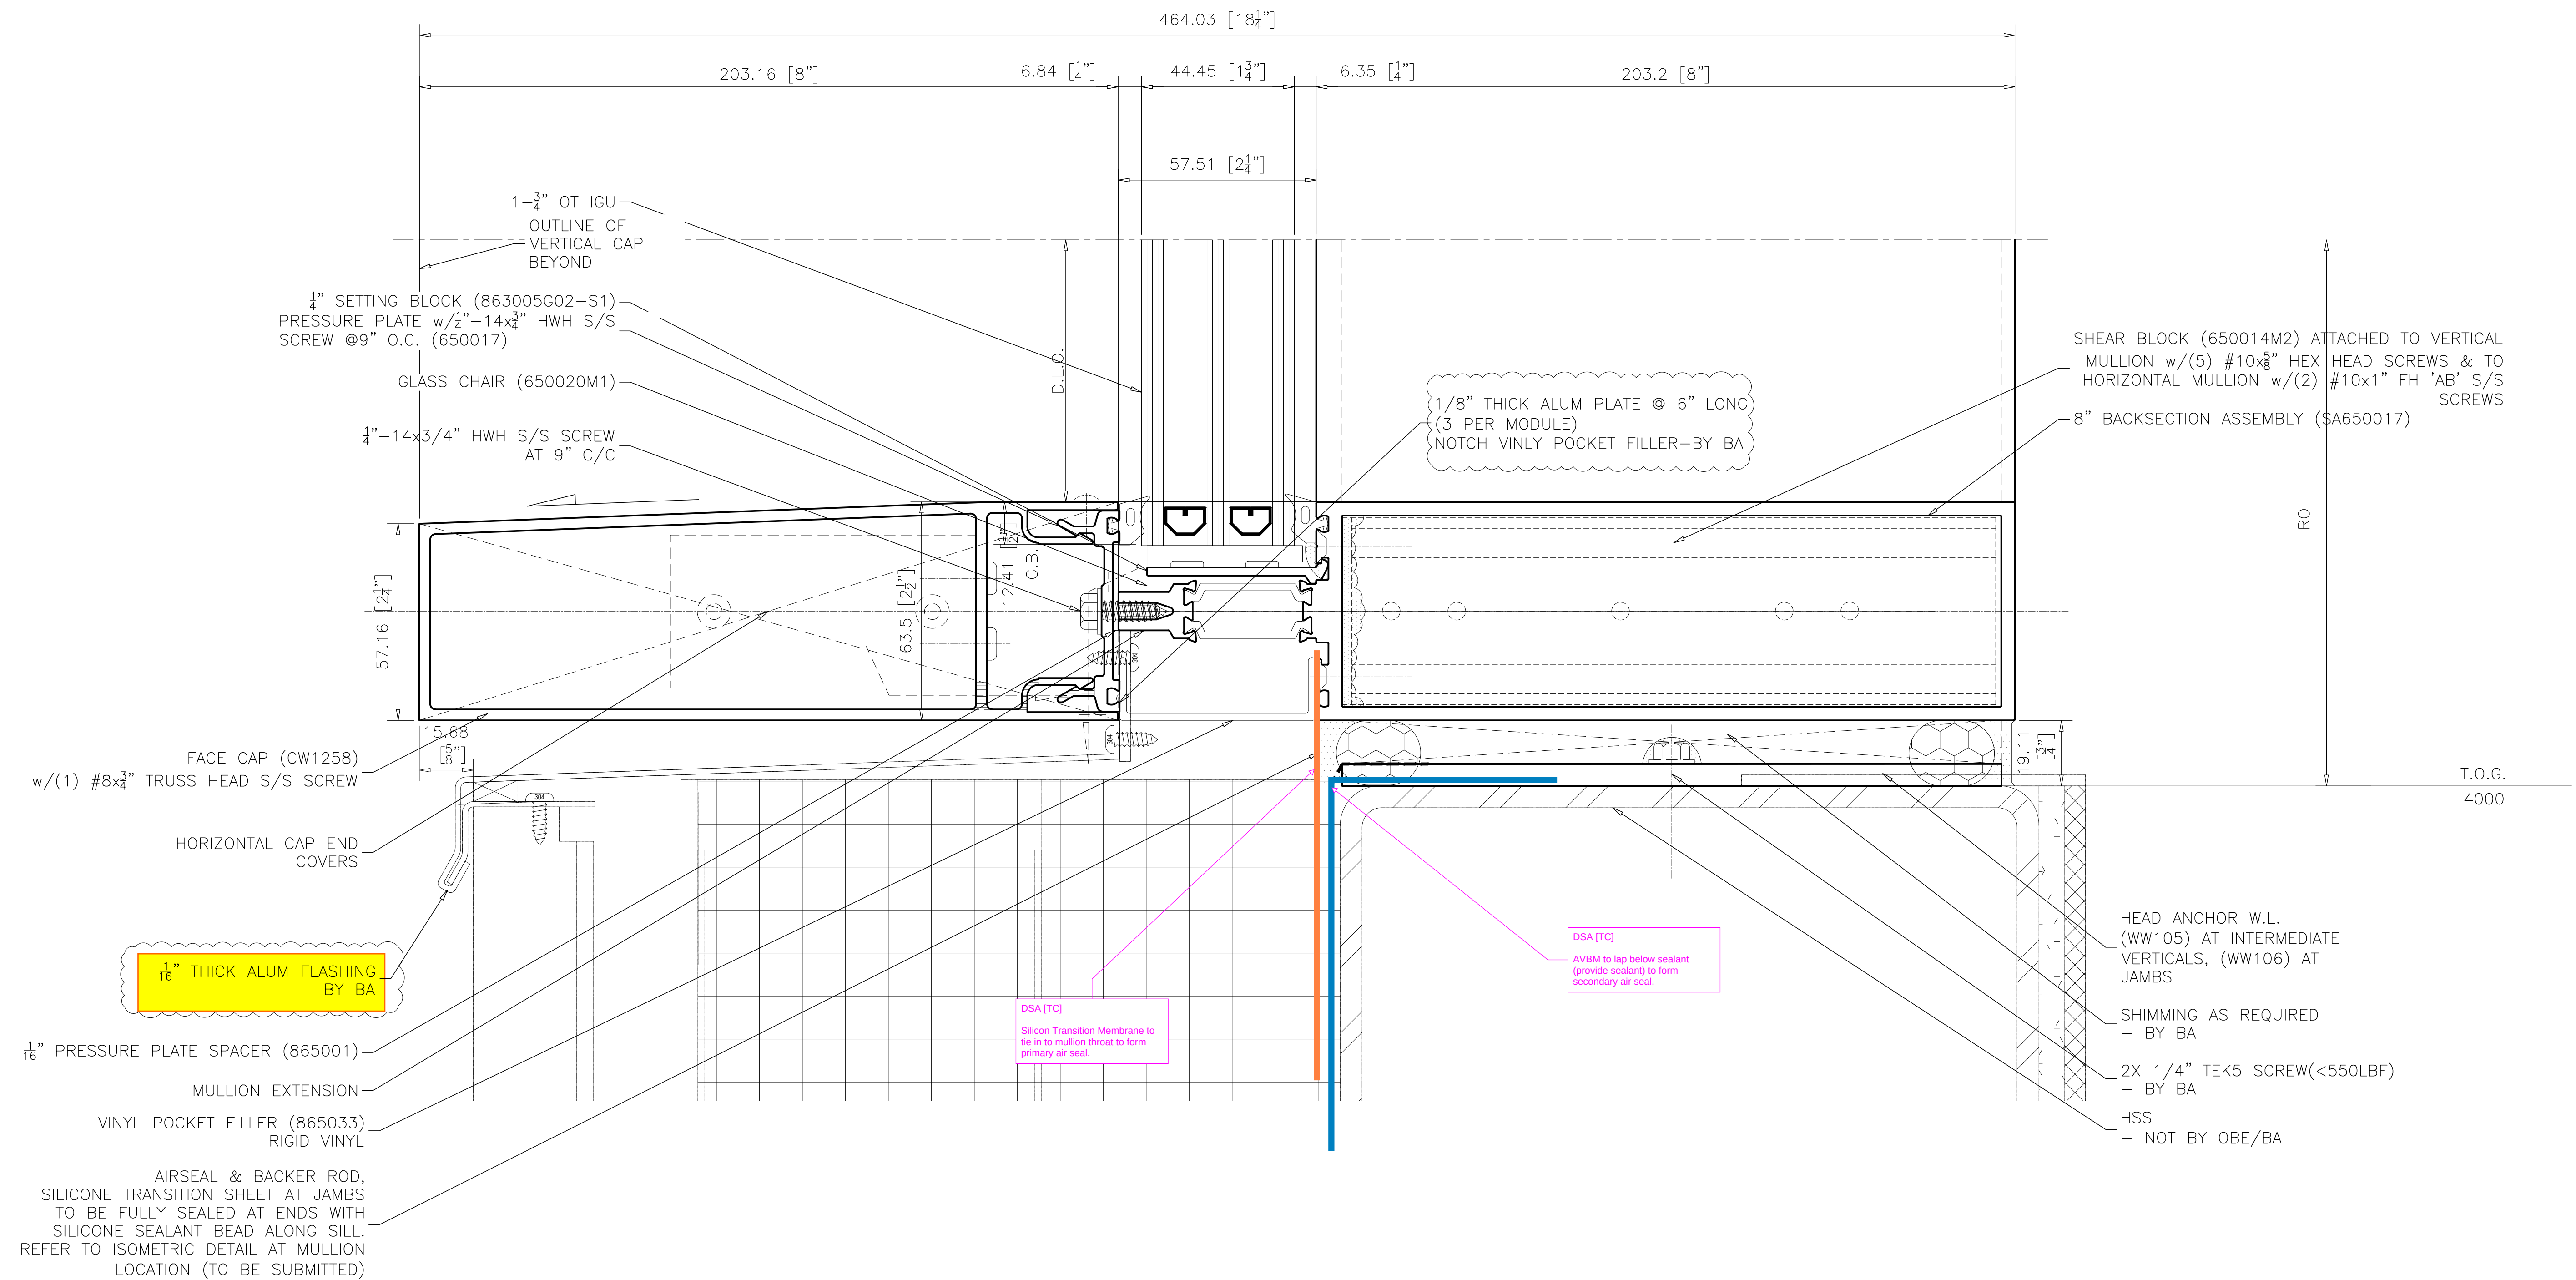

1
C5-007B

SILL HORIZONTAL 8" CAP 8" B.S. AT VISION GLAZING

ARCH. REF.: 3/A452

REVISIONS

No.	Description:	Date:	By:
1	Revised per arch. markups received Feb 11/26	03/03/26	SLR


Project Name:
DOCKSTEADER PRPS

Project Location:
BRAMPTON, ONTARIO

Architect Name:
DIAMOND SCHMITT ARCHITECTS

Customer Name:
BOTHWELL ACCURATE GLAZING

oldcastle BuildingEnvelope®

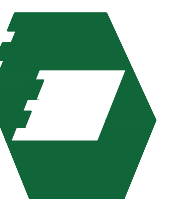

275 Britannia Road East • Mississauga • Ontario • Canada • L4Z2E7
905-890-6970 • oldcastlebe.com

Drawing Name:

SECTION DETAIL

Drawn By:

SR

Drawn Date:

2026/01/12

Scale:

1"=1"

Drawing Number:

Checked By:

NP


Issue No.:

1

Release Date:

2026/03/03

C5-007B

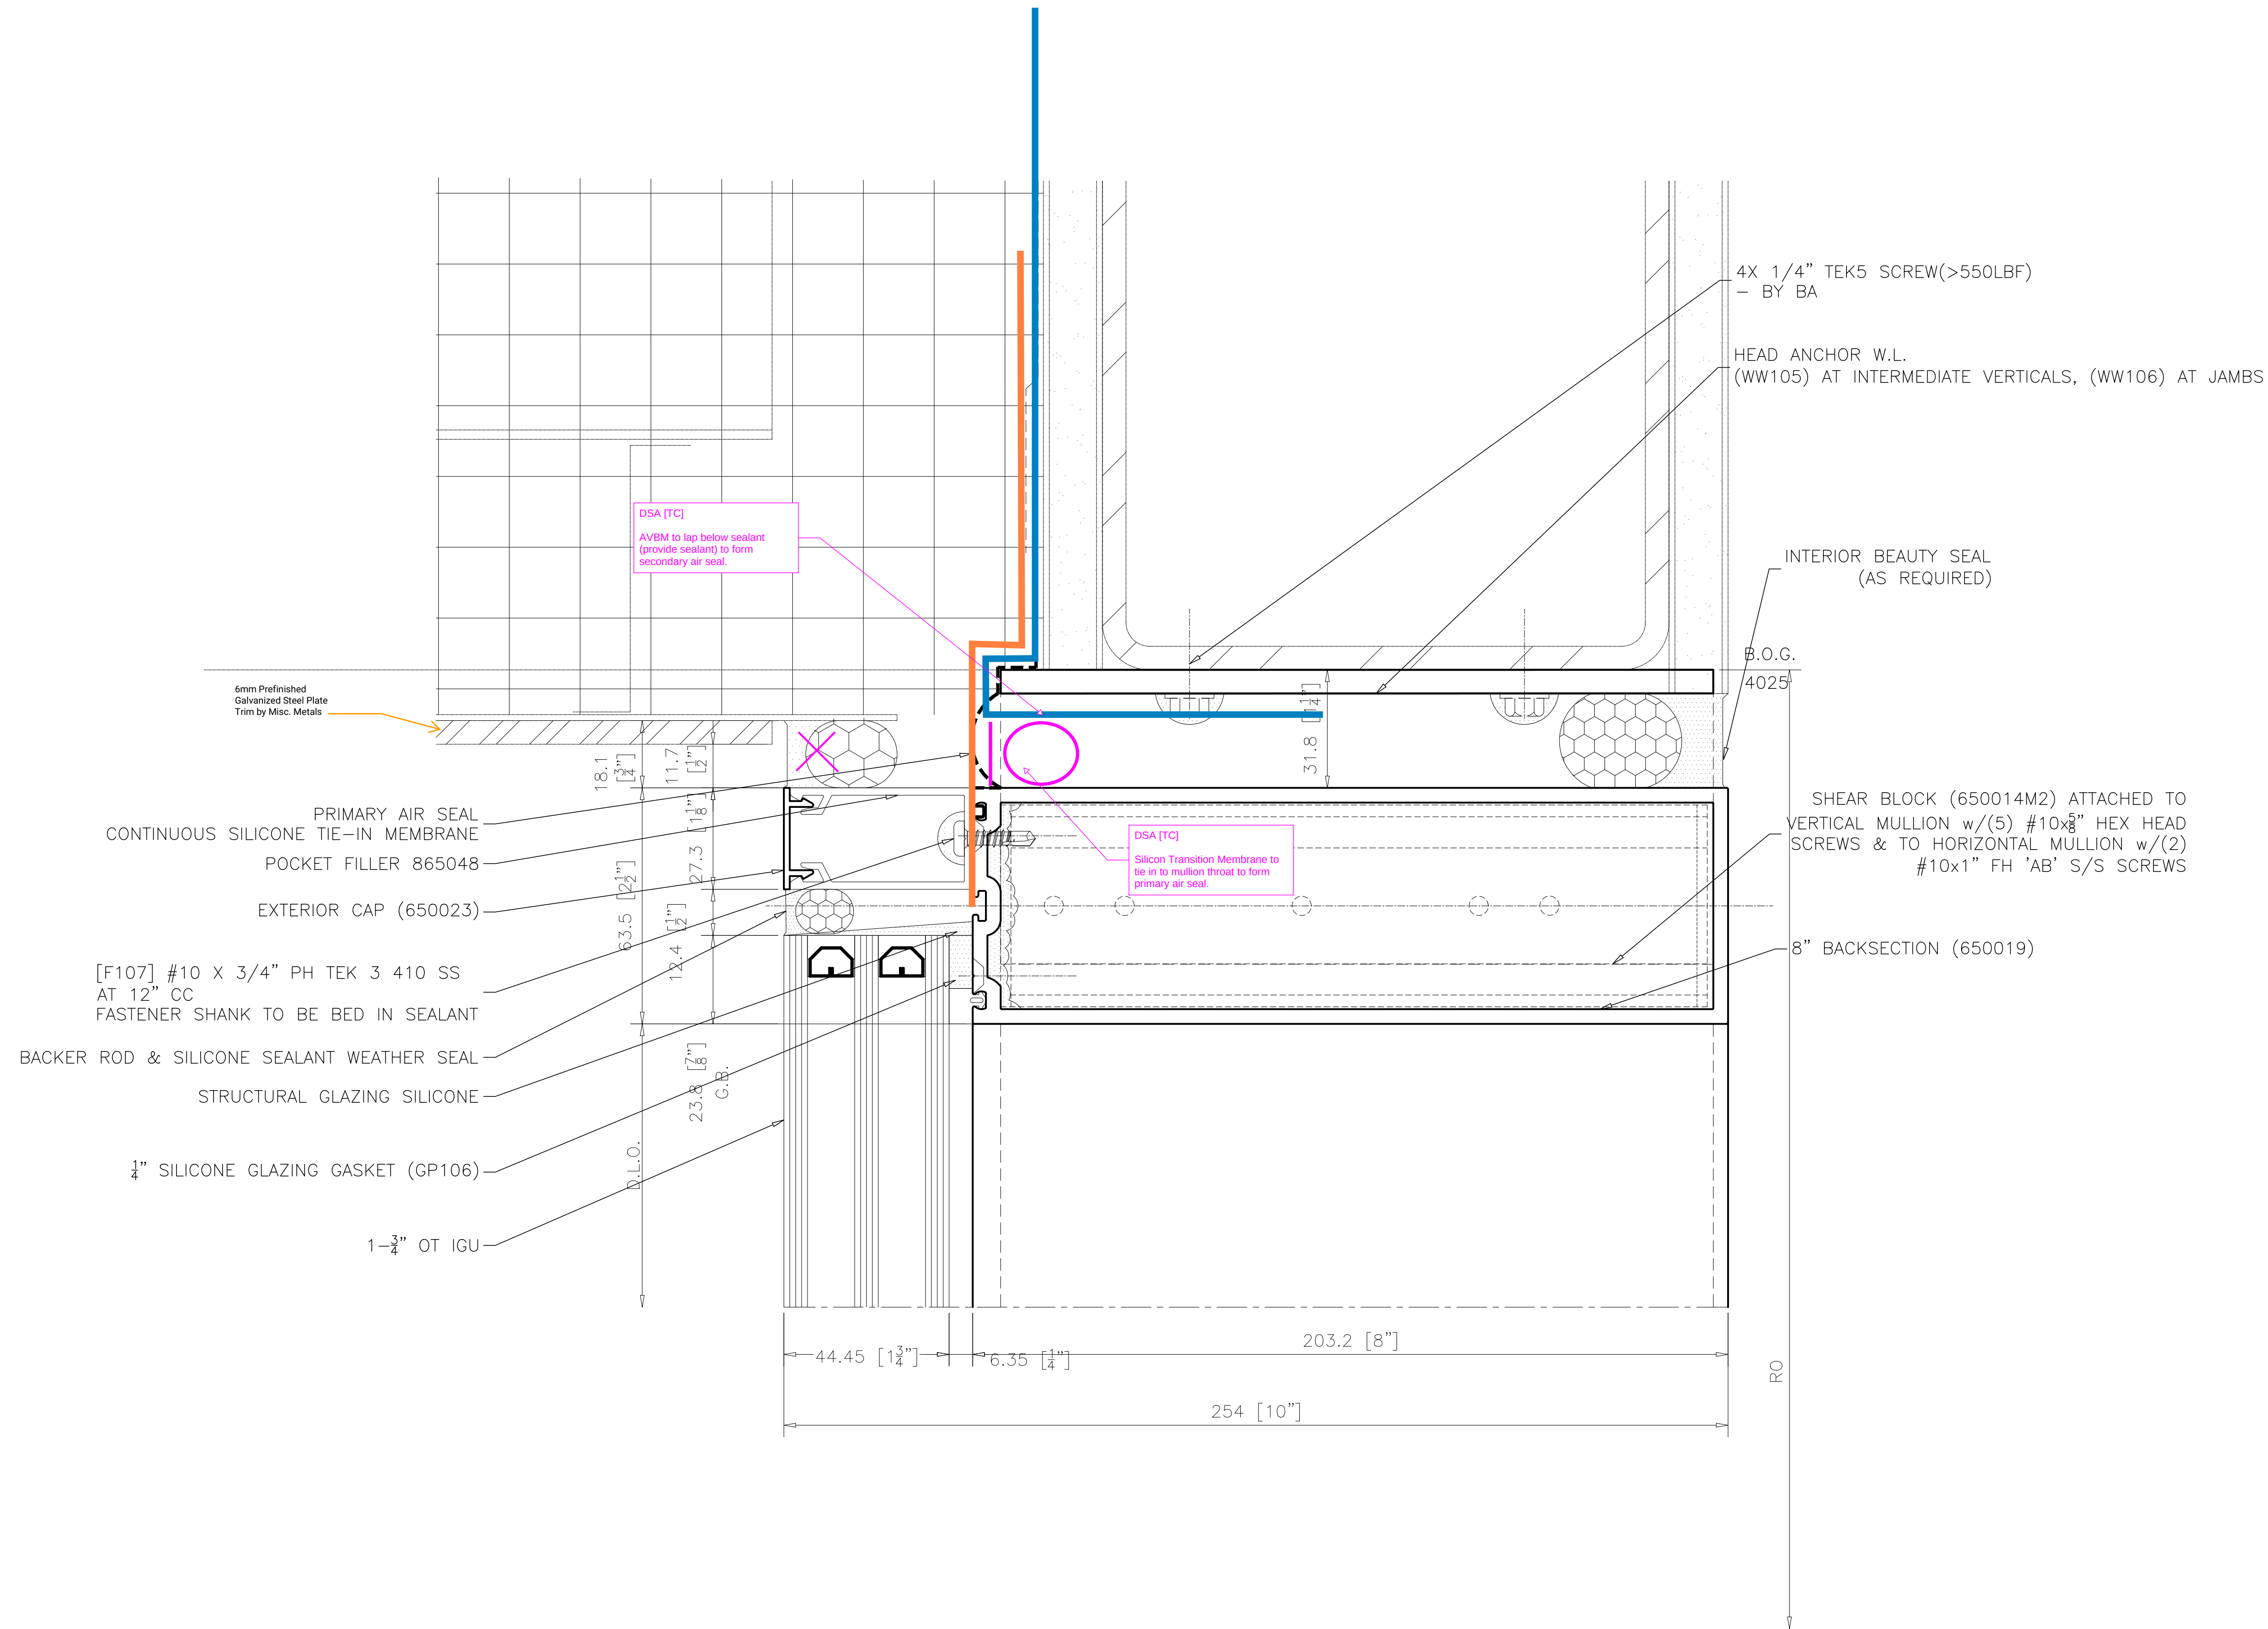

1
C5-008

HEAD HORIZONTAL SSG 8" B.S. AT VISION GLAZING

ARCH. REF.: 6/A551

REVISIONS

No.	Description:	Date:	By:
1	Revised per arch. markups received Feb 11/26	03/03/26	SLR

Project Name:
DOCKSTEADER PRPS

Project Location:
BRAMPTON, ONTARIO

Architect Name:
DIAMOND SCHMITT ARCHITECTS

Customer Name:
BOTHWELL ACCURATE GLAZING



275 Britannia Road East • Mississauga • Ontario • Canada • L4Z2E7
905-890-6970 • oldcastlebe.com

Drawing Name:

SECTION DETAIL

Drawn By: SR	Checked By: NP
Drawn Date: 2026/01/12	Issue No.: 1
Scale: 1"=1"	Release Date: 2026/03/03

Drawing Number: C5-008