


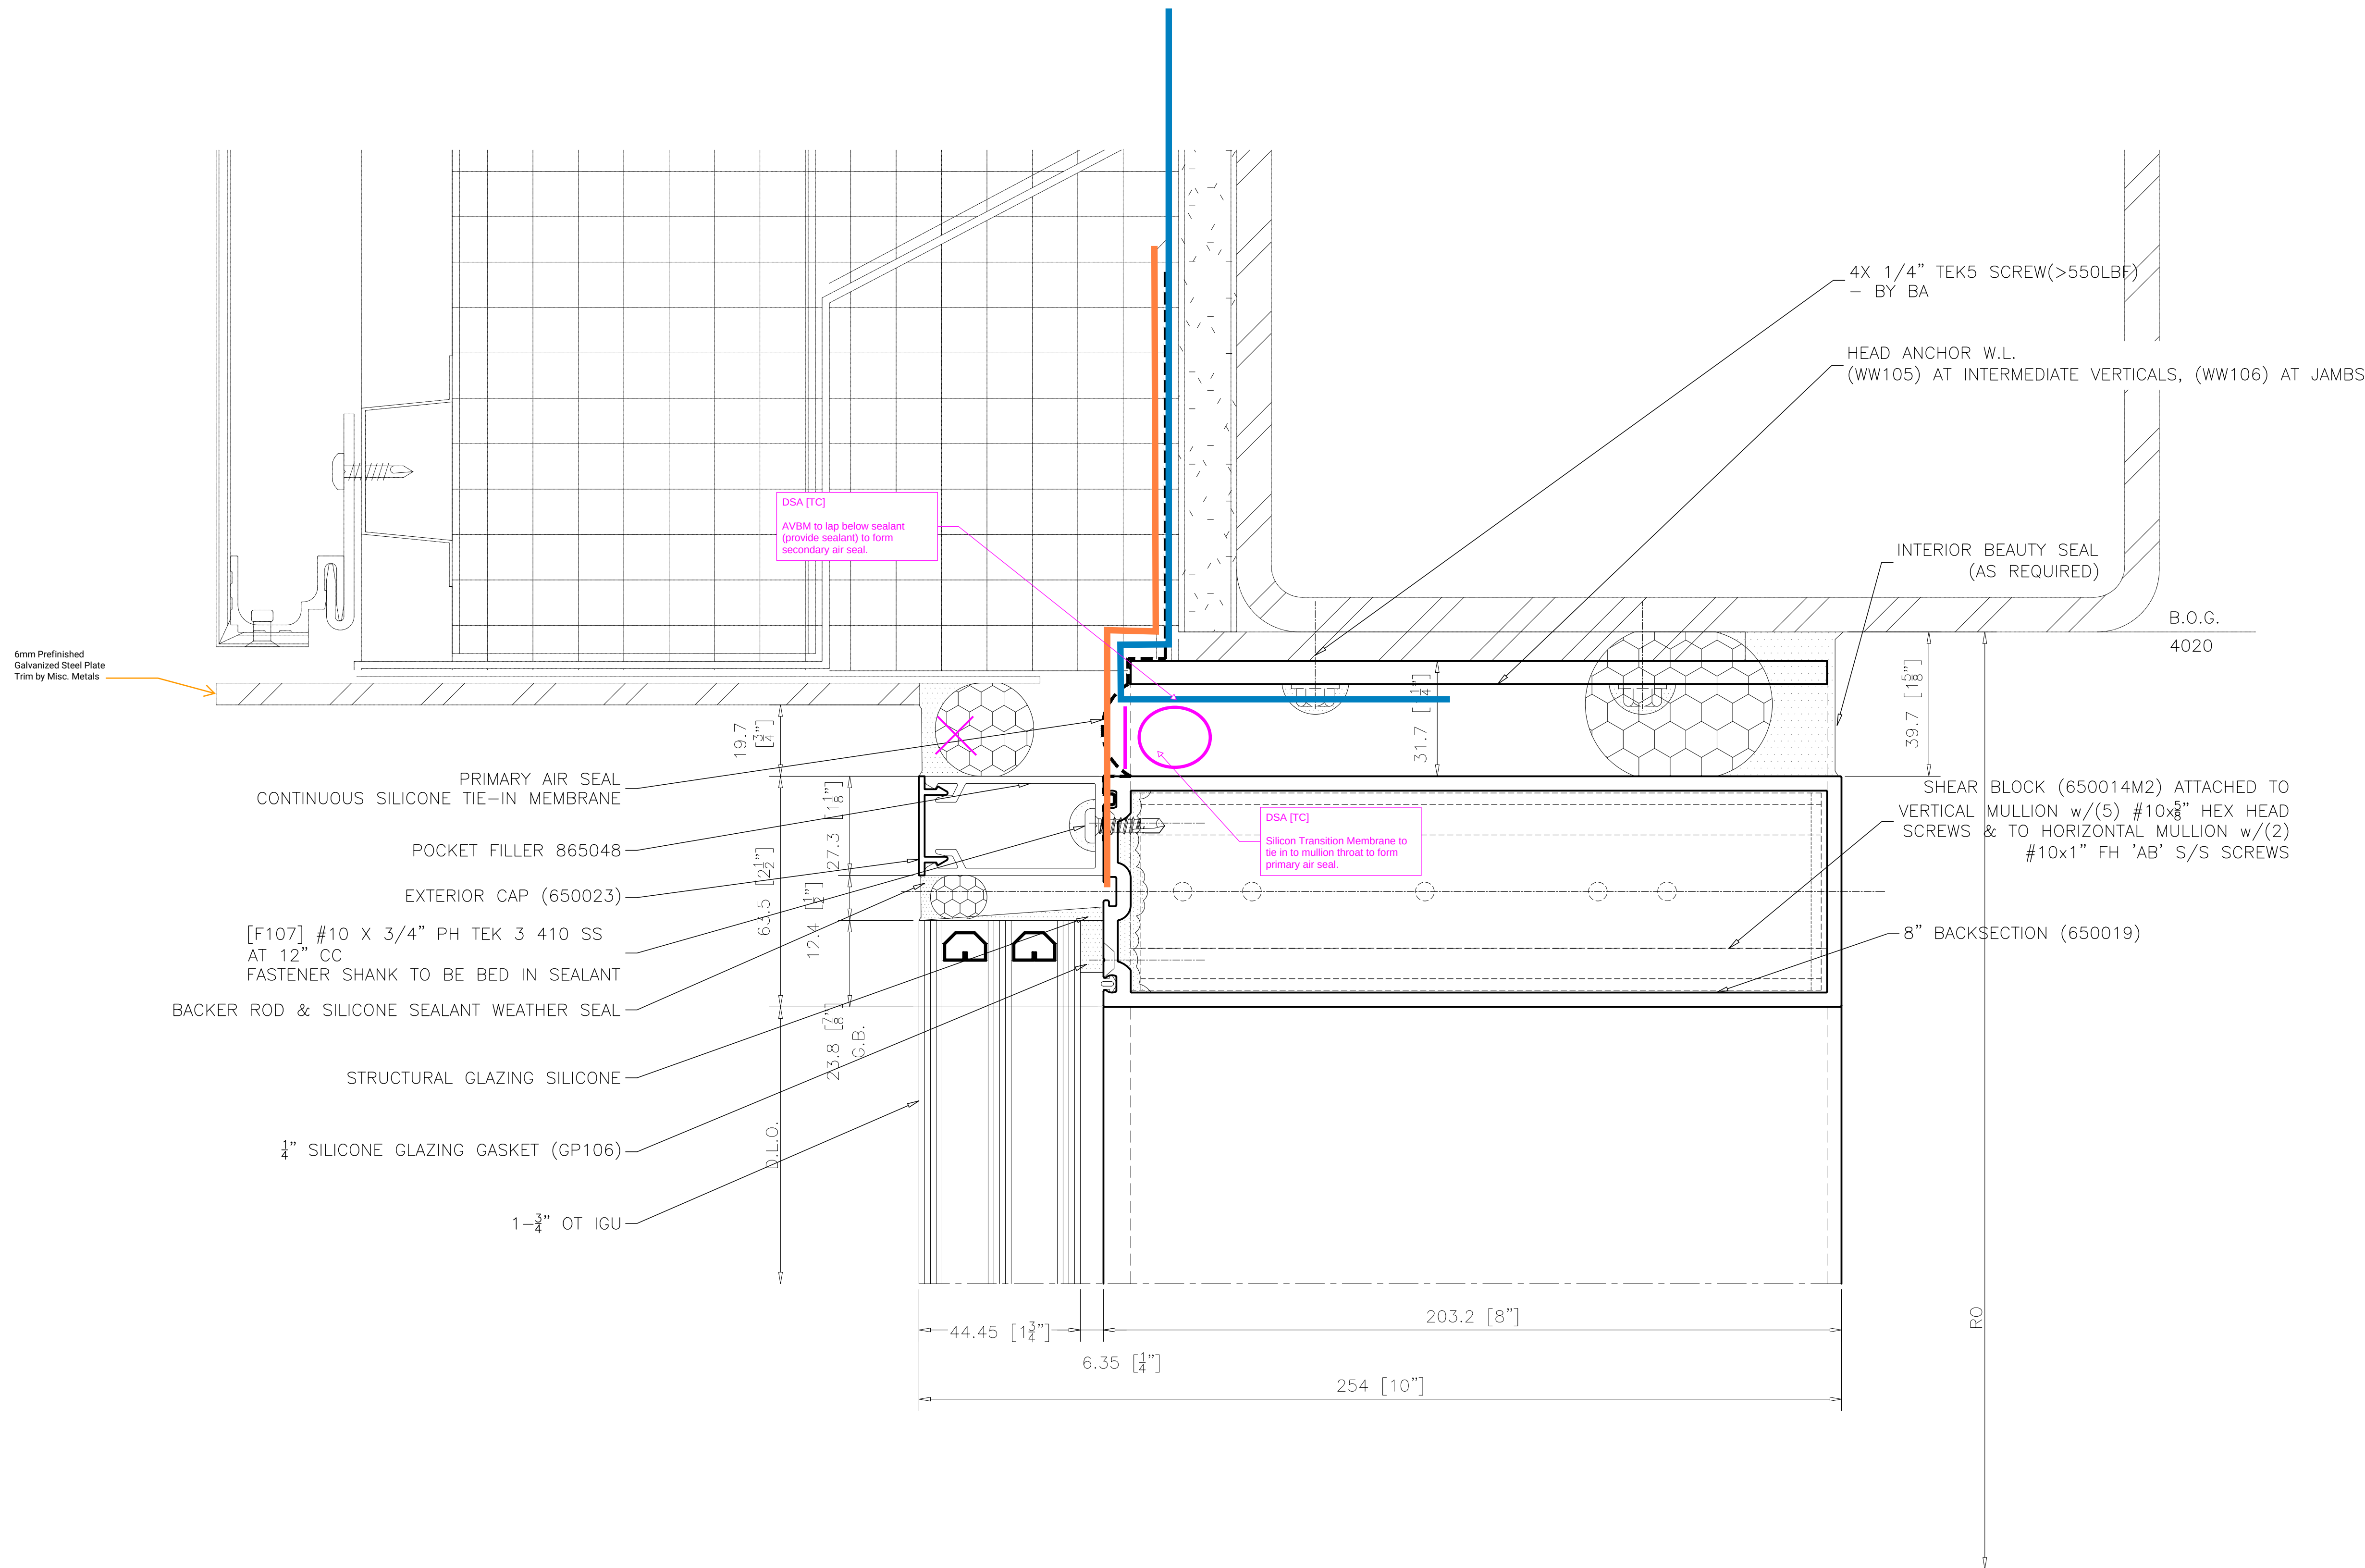

1
C5-008A

HEAD HORIZONTAL SSG 8" B.S.
AT VISION GLAZING

ARCH. REF.: 5/A551


REVISIONS			
No.	Description:	Date:	By:
1	Revised per arch. markups received Feb 11/26	03/03/26	SLR

Project Name: DOCKSTEADER PRPS	Project Location: BRAMPTON, ONTARIO	Architect Name: DIAMOND SCHMITT ARCHITECTS	Customer Name: BOTHWELL ACCURATE GLAZING
-----------------------------------	--	---	---



275 Britannia Road East • Mississauga • Ontario • Canada • L4Z2E7
905-890-6970 • oldcastlebe.com

Drawing Name: SECTION DETAIL	
Drawn By: SR	Checked By: NP
Drawn Date: 2026/01/12	Issue No.: 1
Scale: 1"=1"	Release Date: 2026/03/03
Drawing Number: C5-008A	

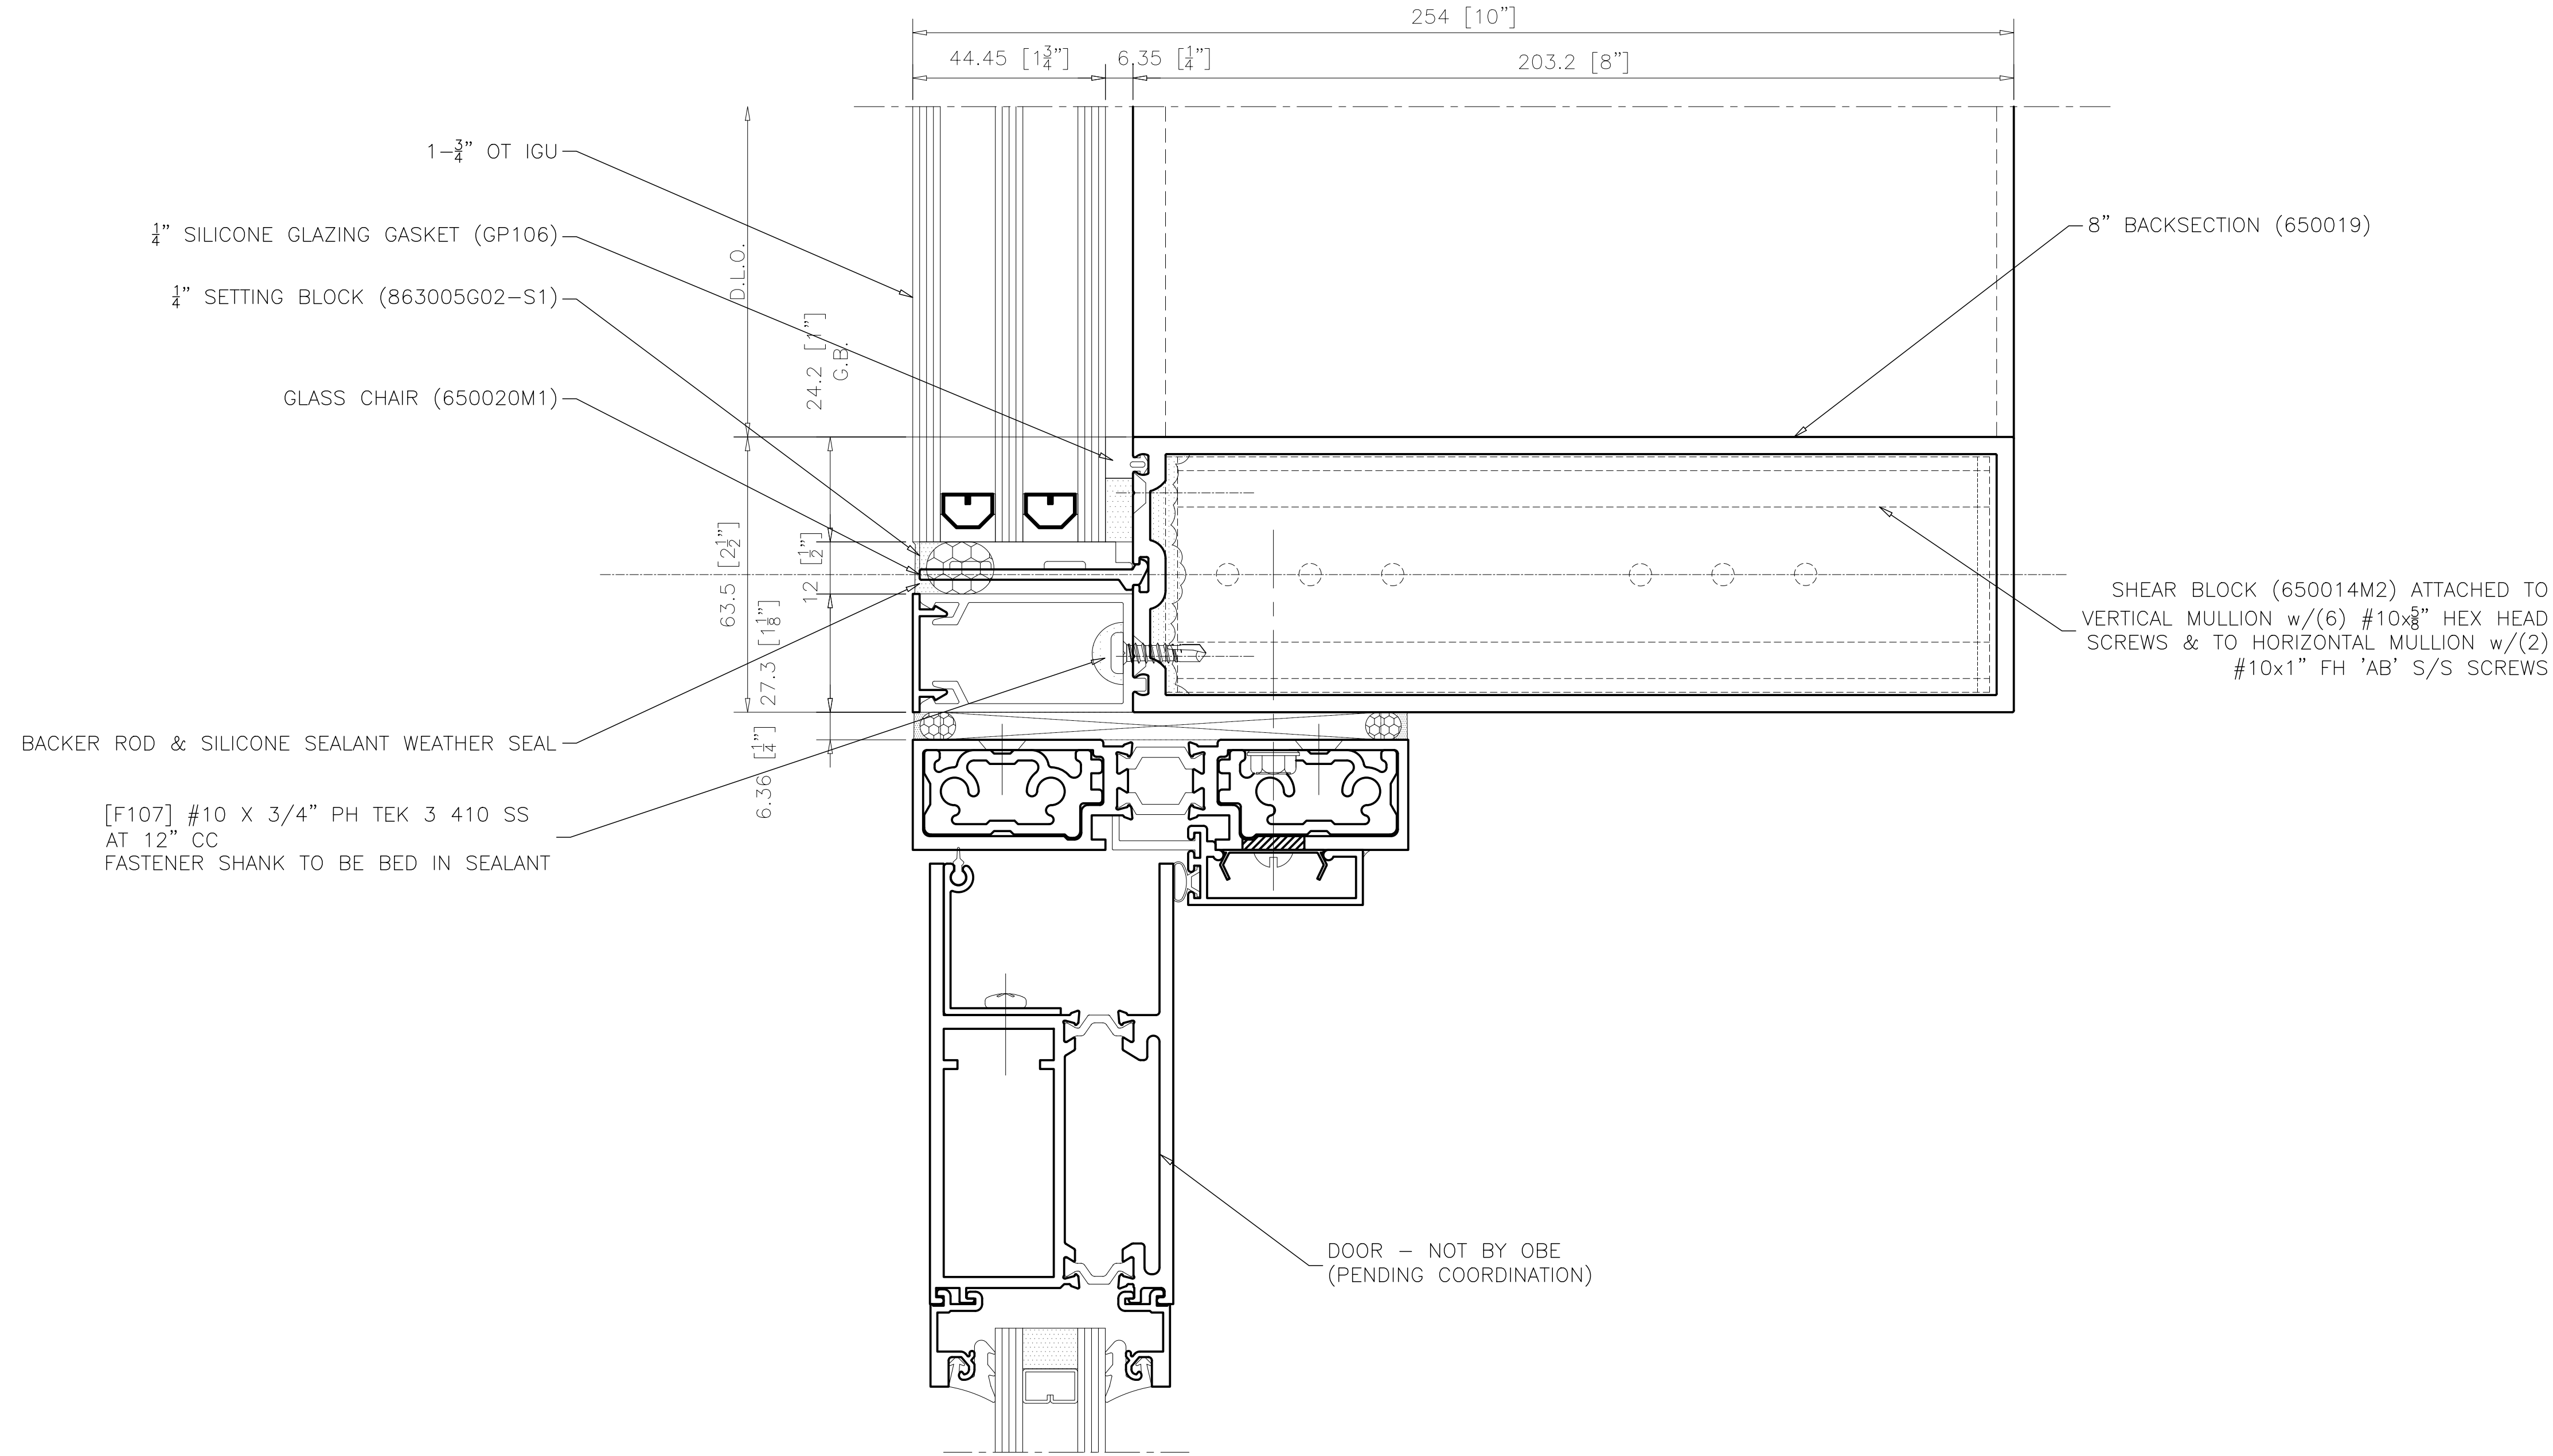


1
C5-009

INT HORIZONTAL SSG 8" B.S.
AT VISION ABOVE DOOR

ARCH. REF.: N/A


REVISIONS			
No.	Description:	Date:	By:
1	Revised per arch. markups received Feb 11/26	03/03/26	SLR

Project Name: DOCKSTEADER PRPS	Project Location: BRAMPTON, ONTARIO	Architect Name: DIAMOND SCHMITT ARCHITECTS	Customer Name: BOTHWELL ACCURATE GLAZING
-----------------------------------	--	---	---

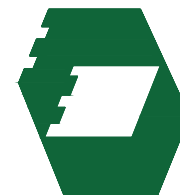**Oldcastle** BuildingEnvelope®

275 Britannia Road East • Mississauga • Ontario • Canada • L4Z2E7
905-890-6970 • oldcastlebe.com

Drawing Name: SECTION DETAIL	
Drawn By: SR	Checked By: NP
Drawn Date: 2026/01/12	Issue No.: 1
Scale: 1"=1"	Release Date: 2026/03/03
Drawing Number: C5-009	

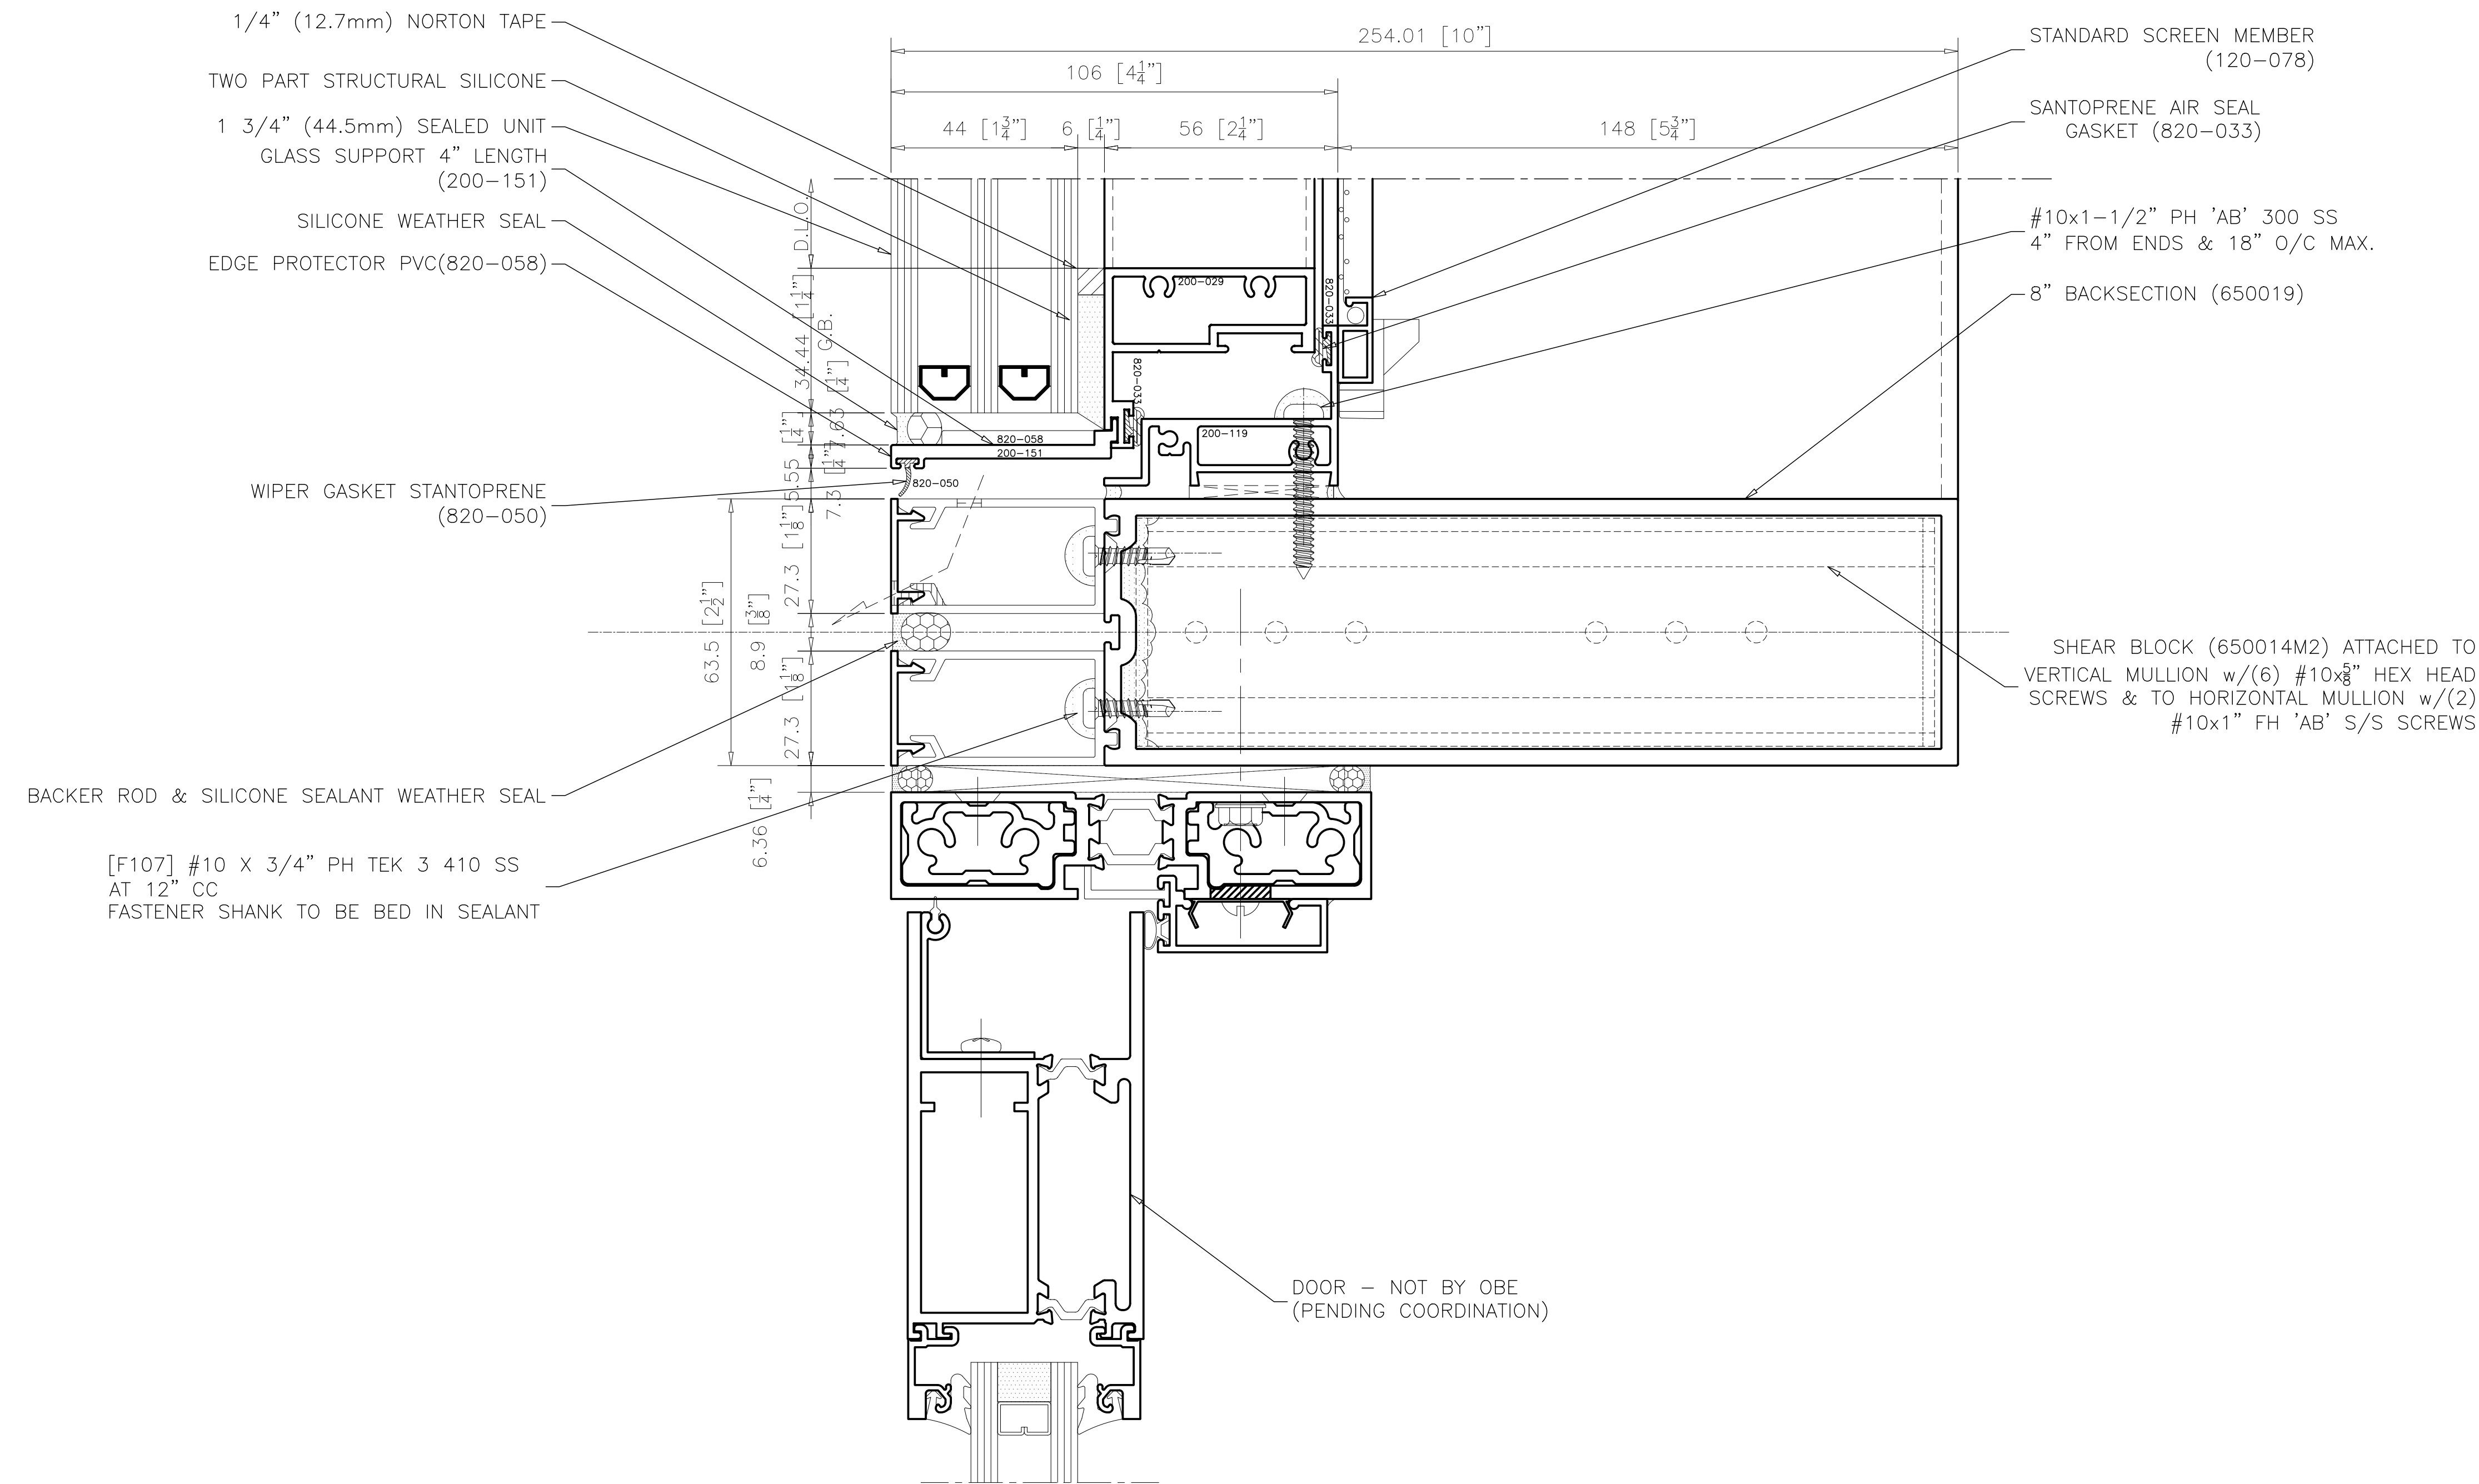

1
C5-009A

INT HORIZONTAL SSG 8" B.S.
AT VENT ABOVE DOOR

ARCH. REF.: 6/A451 SIM

REVISIONS


No.	Description:	Date:	By:
1	Revised per arch. markups received Feb 11/26	03/03/26	SLR

Project Name:
DOCKSTEADER PRPS

Project Location:
BRAMPTON, ONTARIO

Architect Name:
DIAMOND SCHMITT ARCHITECTS

Customer Name:
BOTHWELL ACCURATE GLAZING

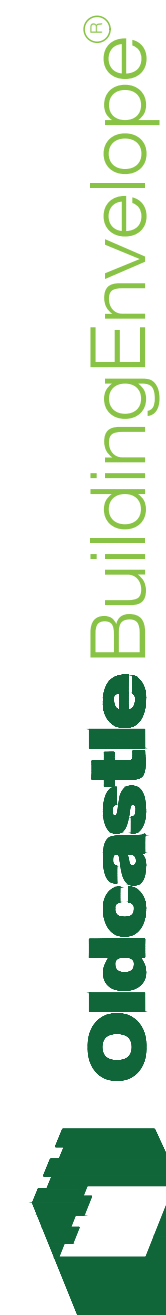


275 Britannia Road East • Mississauga • Ontario • Canada • L4Z2E7
905-890-6970 • oldcastlebe.com

Drawing Name:
SECTION DETAIL

Drawn By: SR	Checked By: NP
Drawn Date: 2026/01/12	Issue No.: 1
Scale: 1"=1"	Release Date: 2026/03/03

Drawing Number:
C5-009A

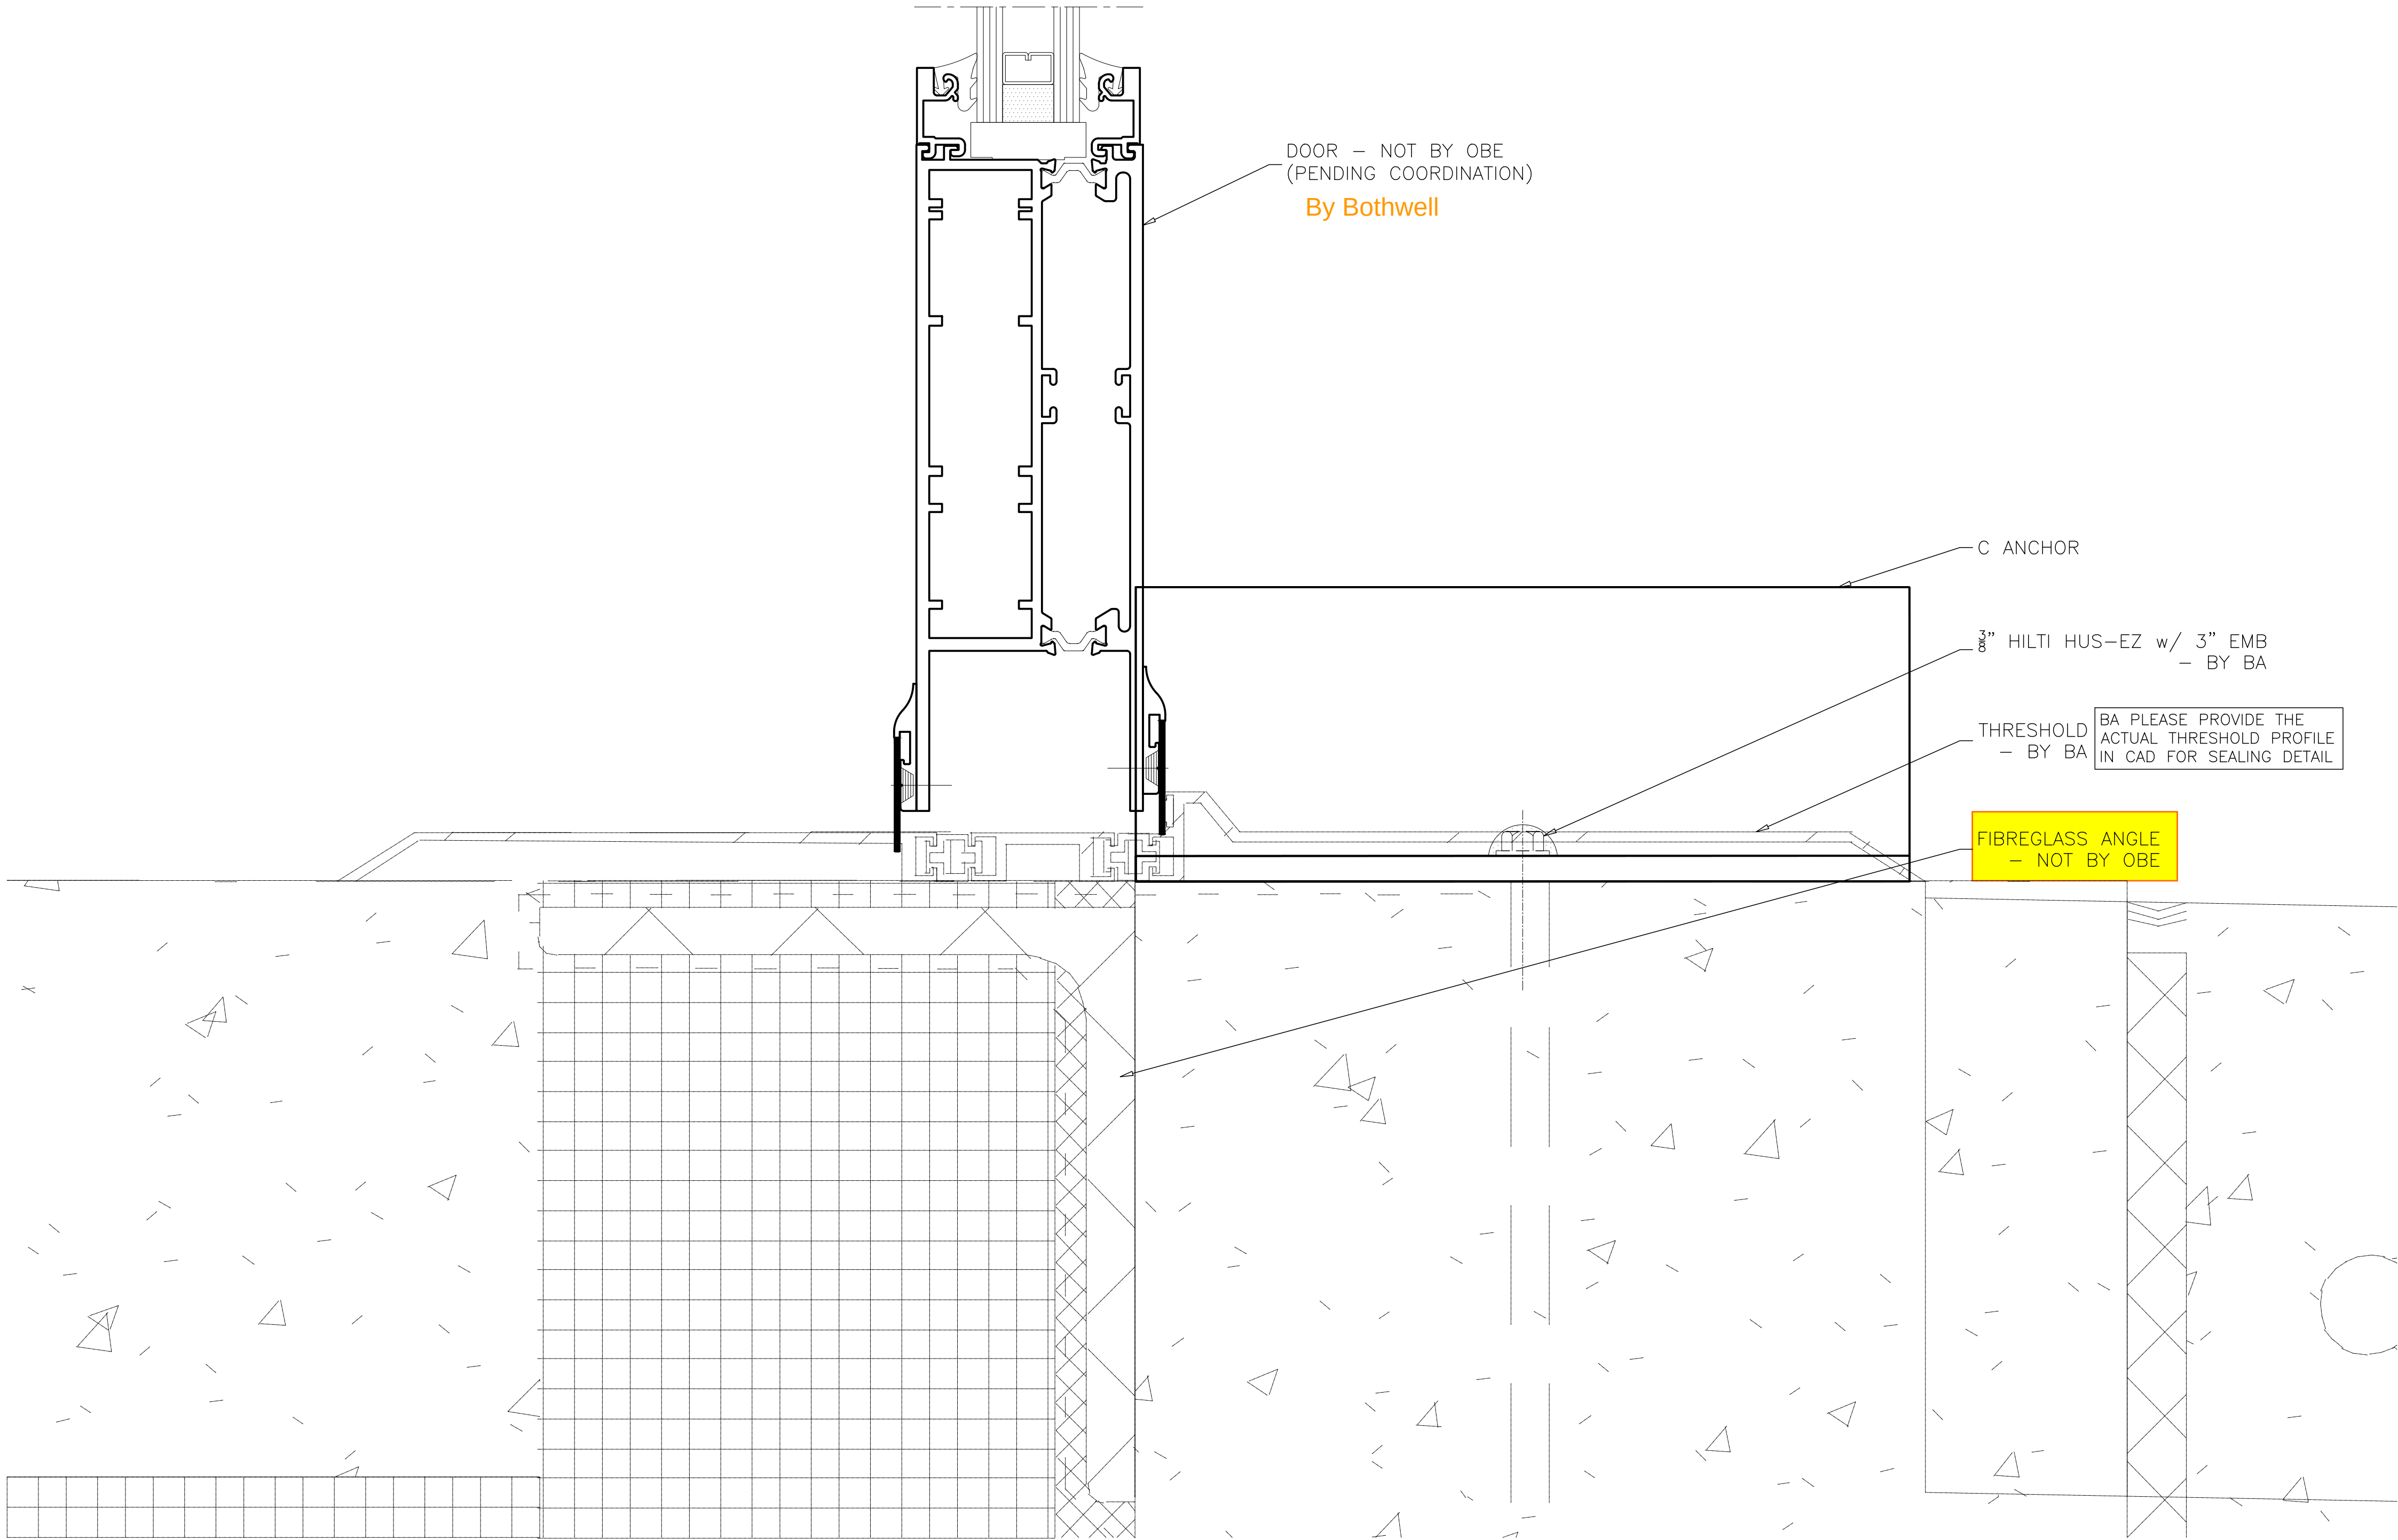

1
C5-010

SILL HORIZONTAL SSG 8" B.S.
AT DOOR
ARCH. REF.: 8/A561


REVISIONS			
No.	Description:	Date:	By:
1	Revised per arch. markups received Feb 11/26	03/03/26	SLR

Project Name: DOCKSTEADER PRPS	Project Location: BRAMPTON, ONTARIO	Architect Name: DIAMOND SCHMITT ARCHITECTS	Customer Name: BOTHWELL ACCURATE GLAZING
-----------------------------------	--	---	---



275 Britannia Road East • Mississauga • Ontario • Canada • L4Z2E7
905-890-6970 • oldcastlebe.com

Drawing Name: SECTION DETAIL	
Drawn By: SR	Checked By: NP
Drawn Date: 2026/01/12	Issue No.: 1
Scale: 1"=1"	Release Date: 2026/03/03
Drawing Number: C5-010	

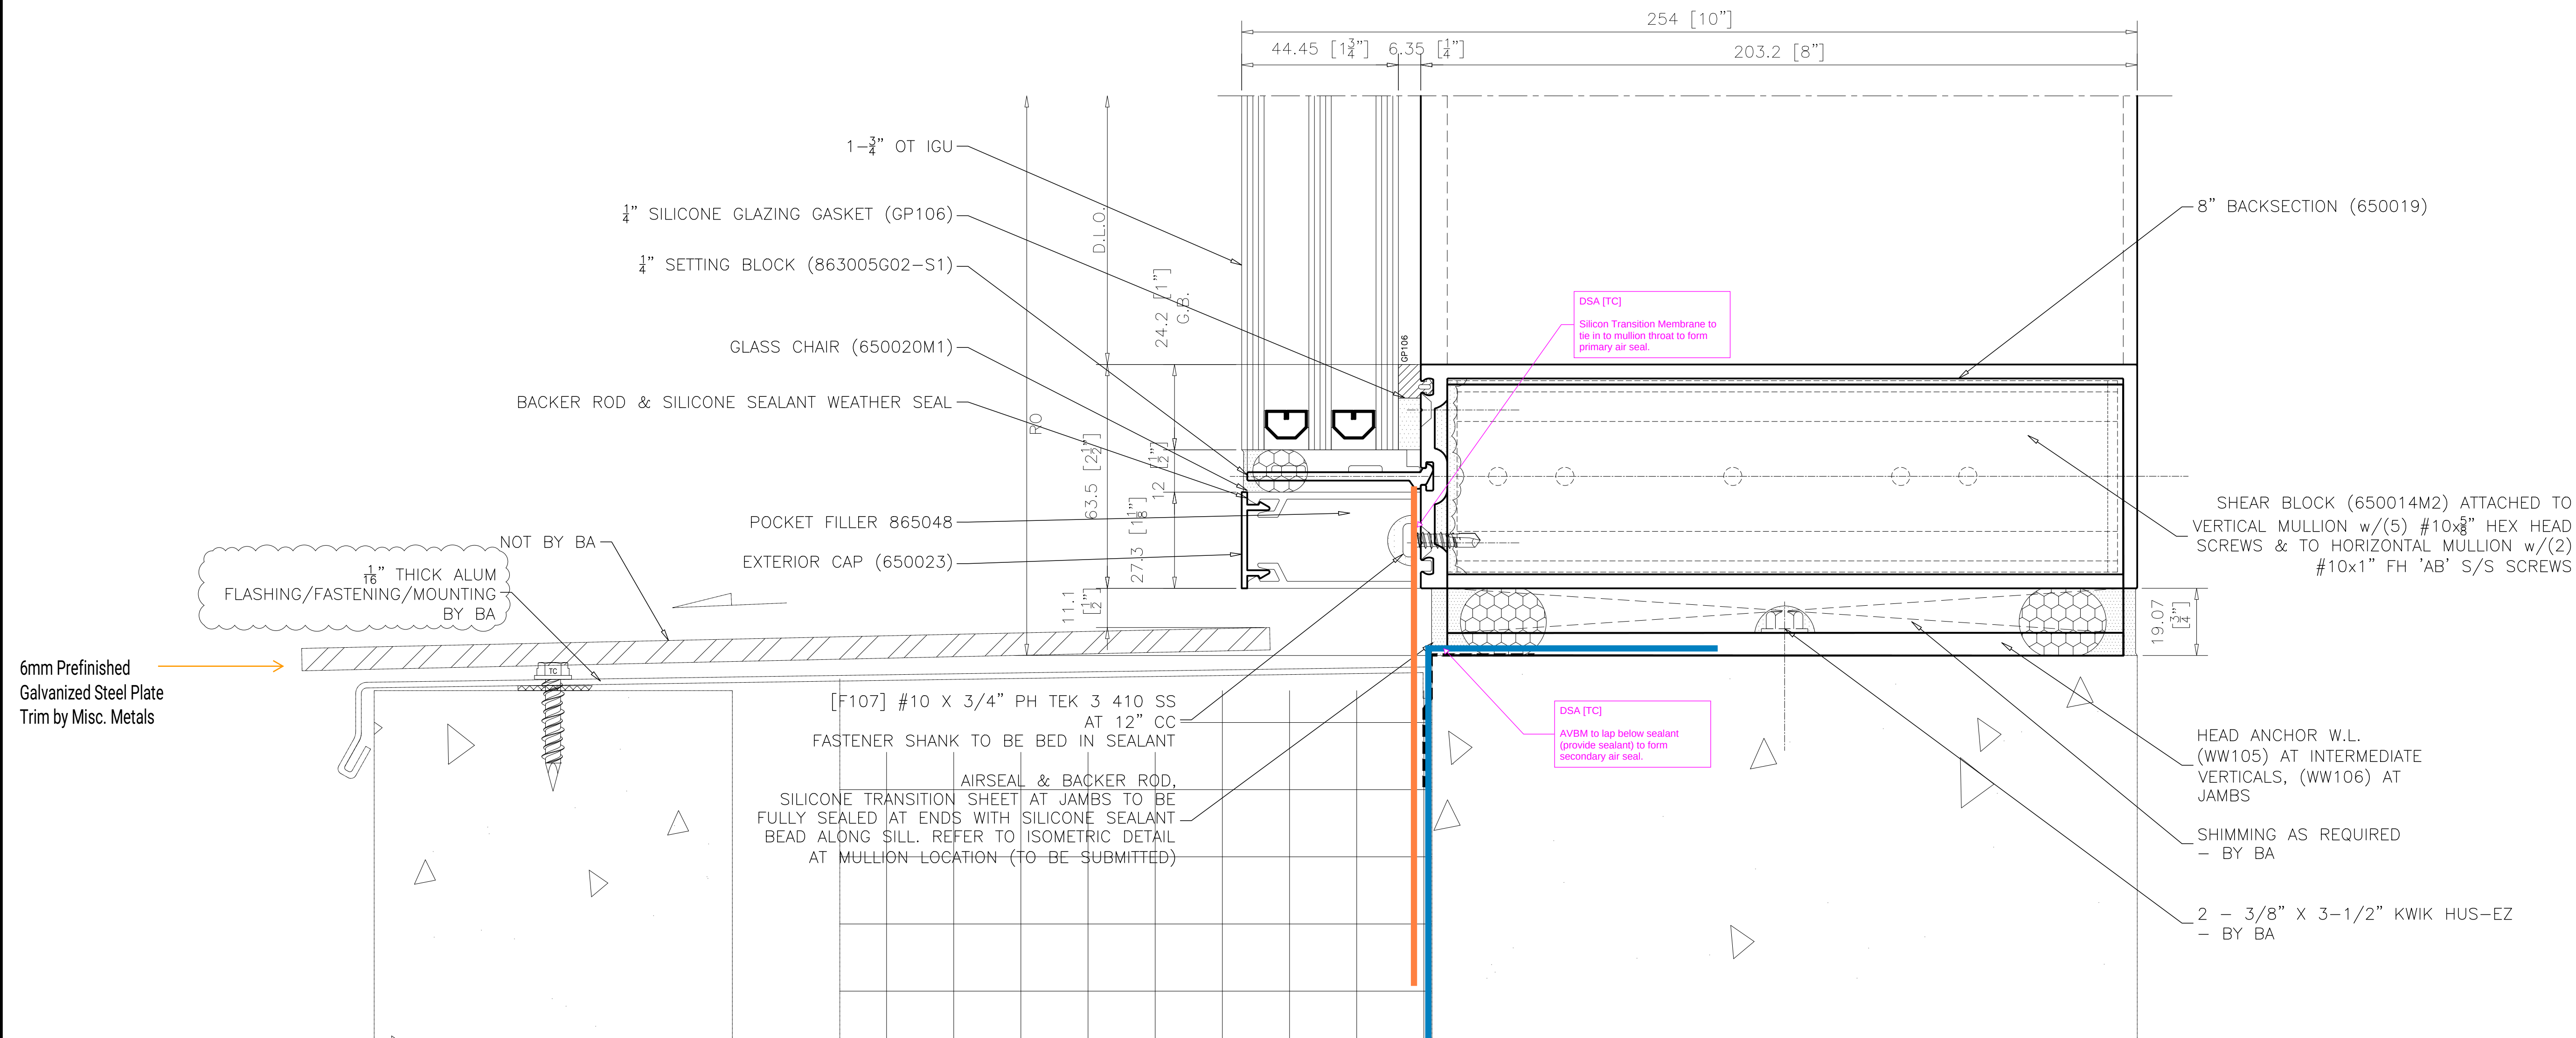

SILL HORIZONTAL SSG 8" B.S. AT VISION

ARCH. REF.: 6/A551

1
C5-011

REVISIONS

No.	Description:	Date:	By:
1	Revised per arch. markups received Feb 11/26	03/03/26	SLR

Project Name:
DOCKSTEADER PRPS

Project Location:
BRAMPTON, ONTARIO

Architect Name:
DIAMOND SCHMITT ARCHITECTS

Customer Name:
BOTHWELL ACCURATE GLAZING

oldcastle BuildingEnvelope®

275 Britannia Road East • Mississauga • Ontario • Canada • L4Z2E7
905-890-6970 • oldcastlebe.com

Drawing Name:

SECTION DETAIL

Drawn By: SR

Checked By: NP

Drawn Date: 2026/01/12

Issue No.: 1

Scale: 1"=1"

Release Date: 2026/03/03


Drawing Number: C5-011



 **Oldcastle** BuildingEnvelope®

275 Britannia Road East • Mississauga • Ontario • Canada • L4Z2E7
905-890-6970 • oldcastlebe.com

Drawing Name:	
SECTION DETAIL	
Drawn By: SR	Checked By: NP
Drawn Date: 2026/01/12	Issue No.: 1
Scale: 1"=1"	Release Date: 2026/03/03
Drawing Number:	C5-012

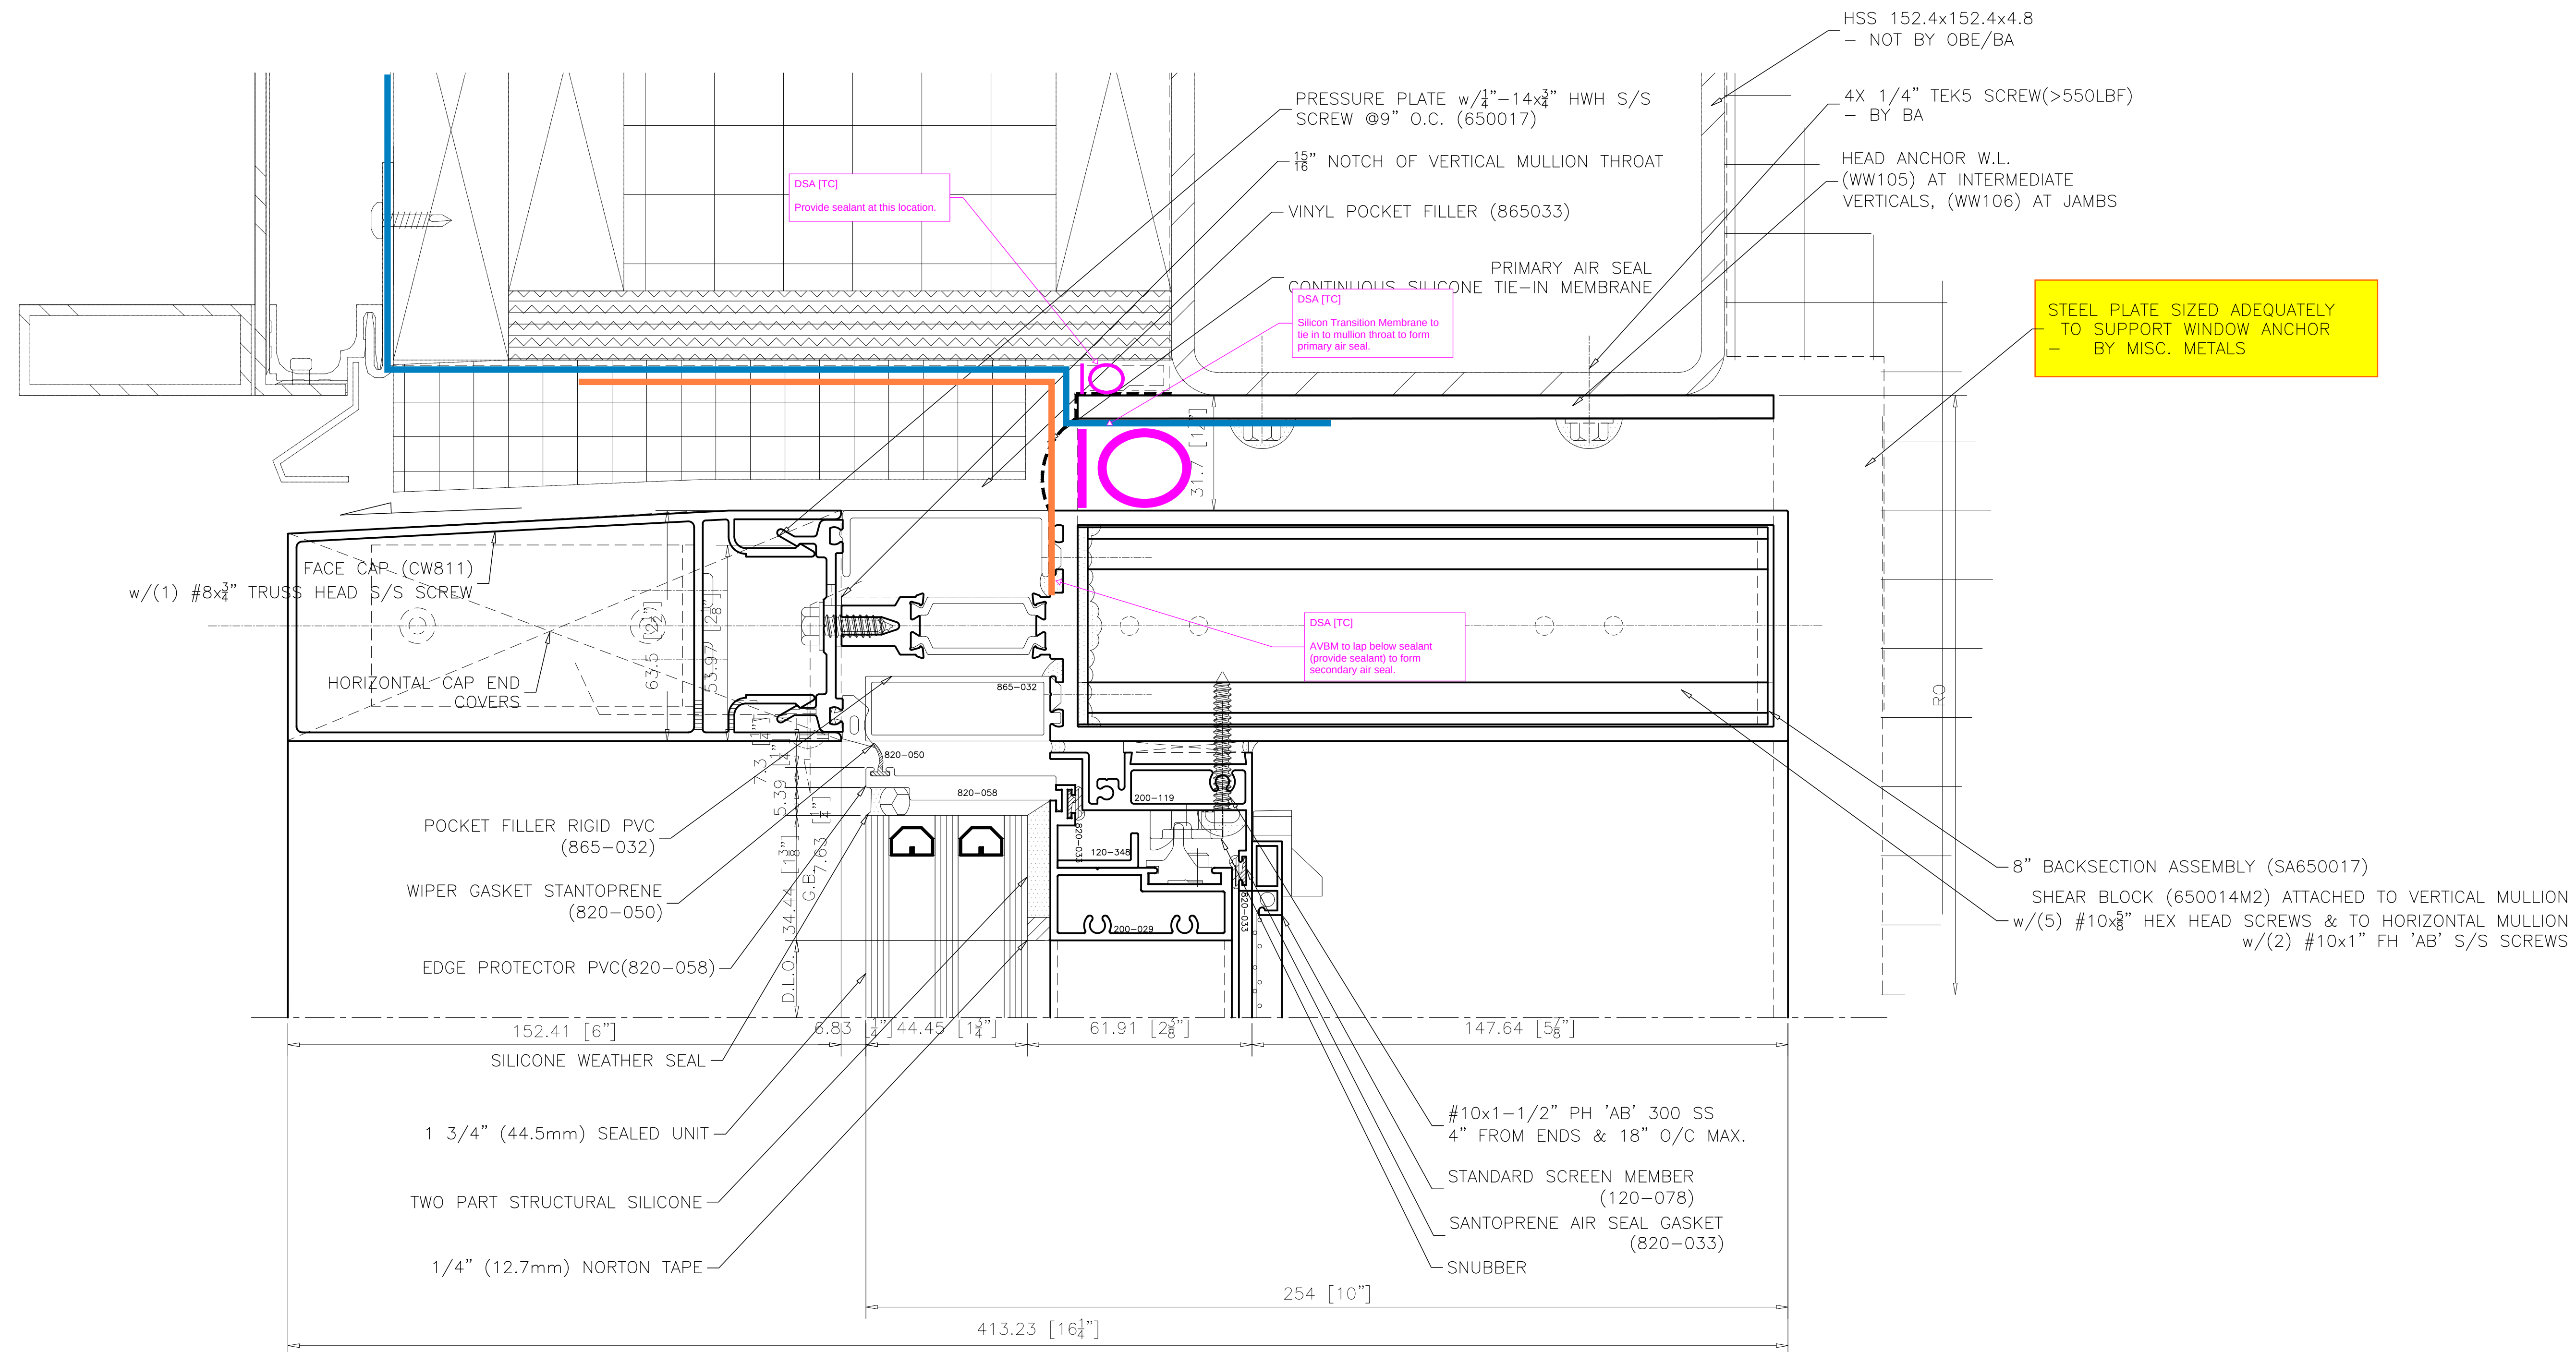

1 HEAD HORIZONTAL 6" CAP 8" B.S. AT VENT

C5-012B ARCH. REF.: 3/A551

REVISIONS

No.	Description:	Date:	By:
1	Revised per arch. markups received Feb 11/26	03/03/26	SLR

Project Name:
DOCKSTEADER PRPS

Project Location:
BRAMPTON, ONTARIO

Architect Name:
DIAMOND SCHMITT ARCHITECTS

Customer Name:
BOTHWELL ACCURATE GLAZING




275 Britannia Road East • Mississauga • Ontario • Canada • L4Z2E7
905-890-6970 • oldcastlebe.com

Drawing Name:

SECTION DETAIL

Drawn By: SR	Checked By: NP
Drawn Date: 2026/01/12	Issue No.: 1
Scale: 1"=1"	Release Date: 2026/03/03
Drawing Number:	C5-012B

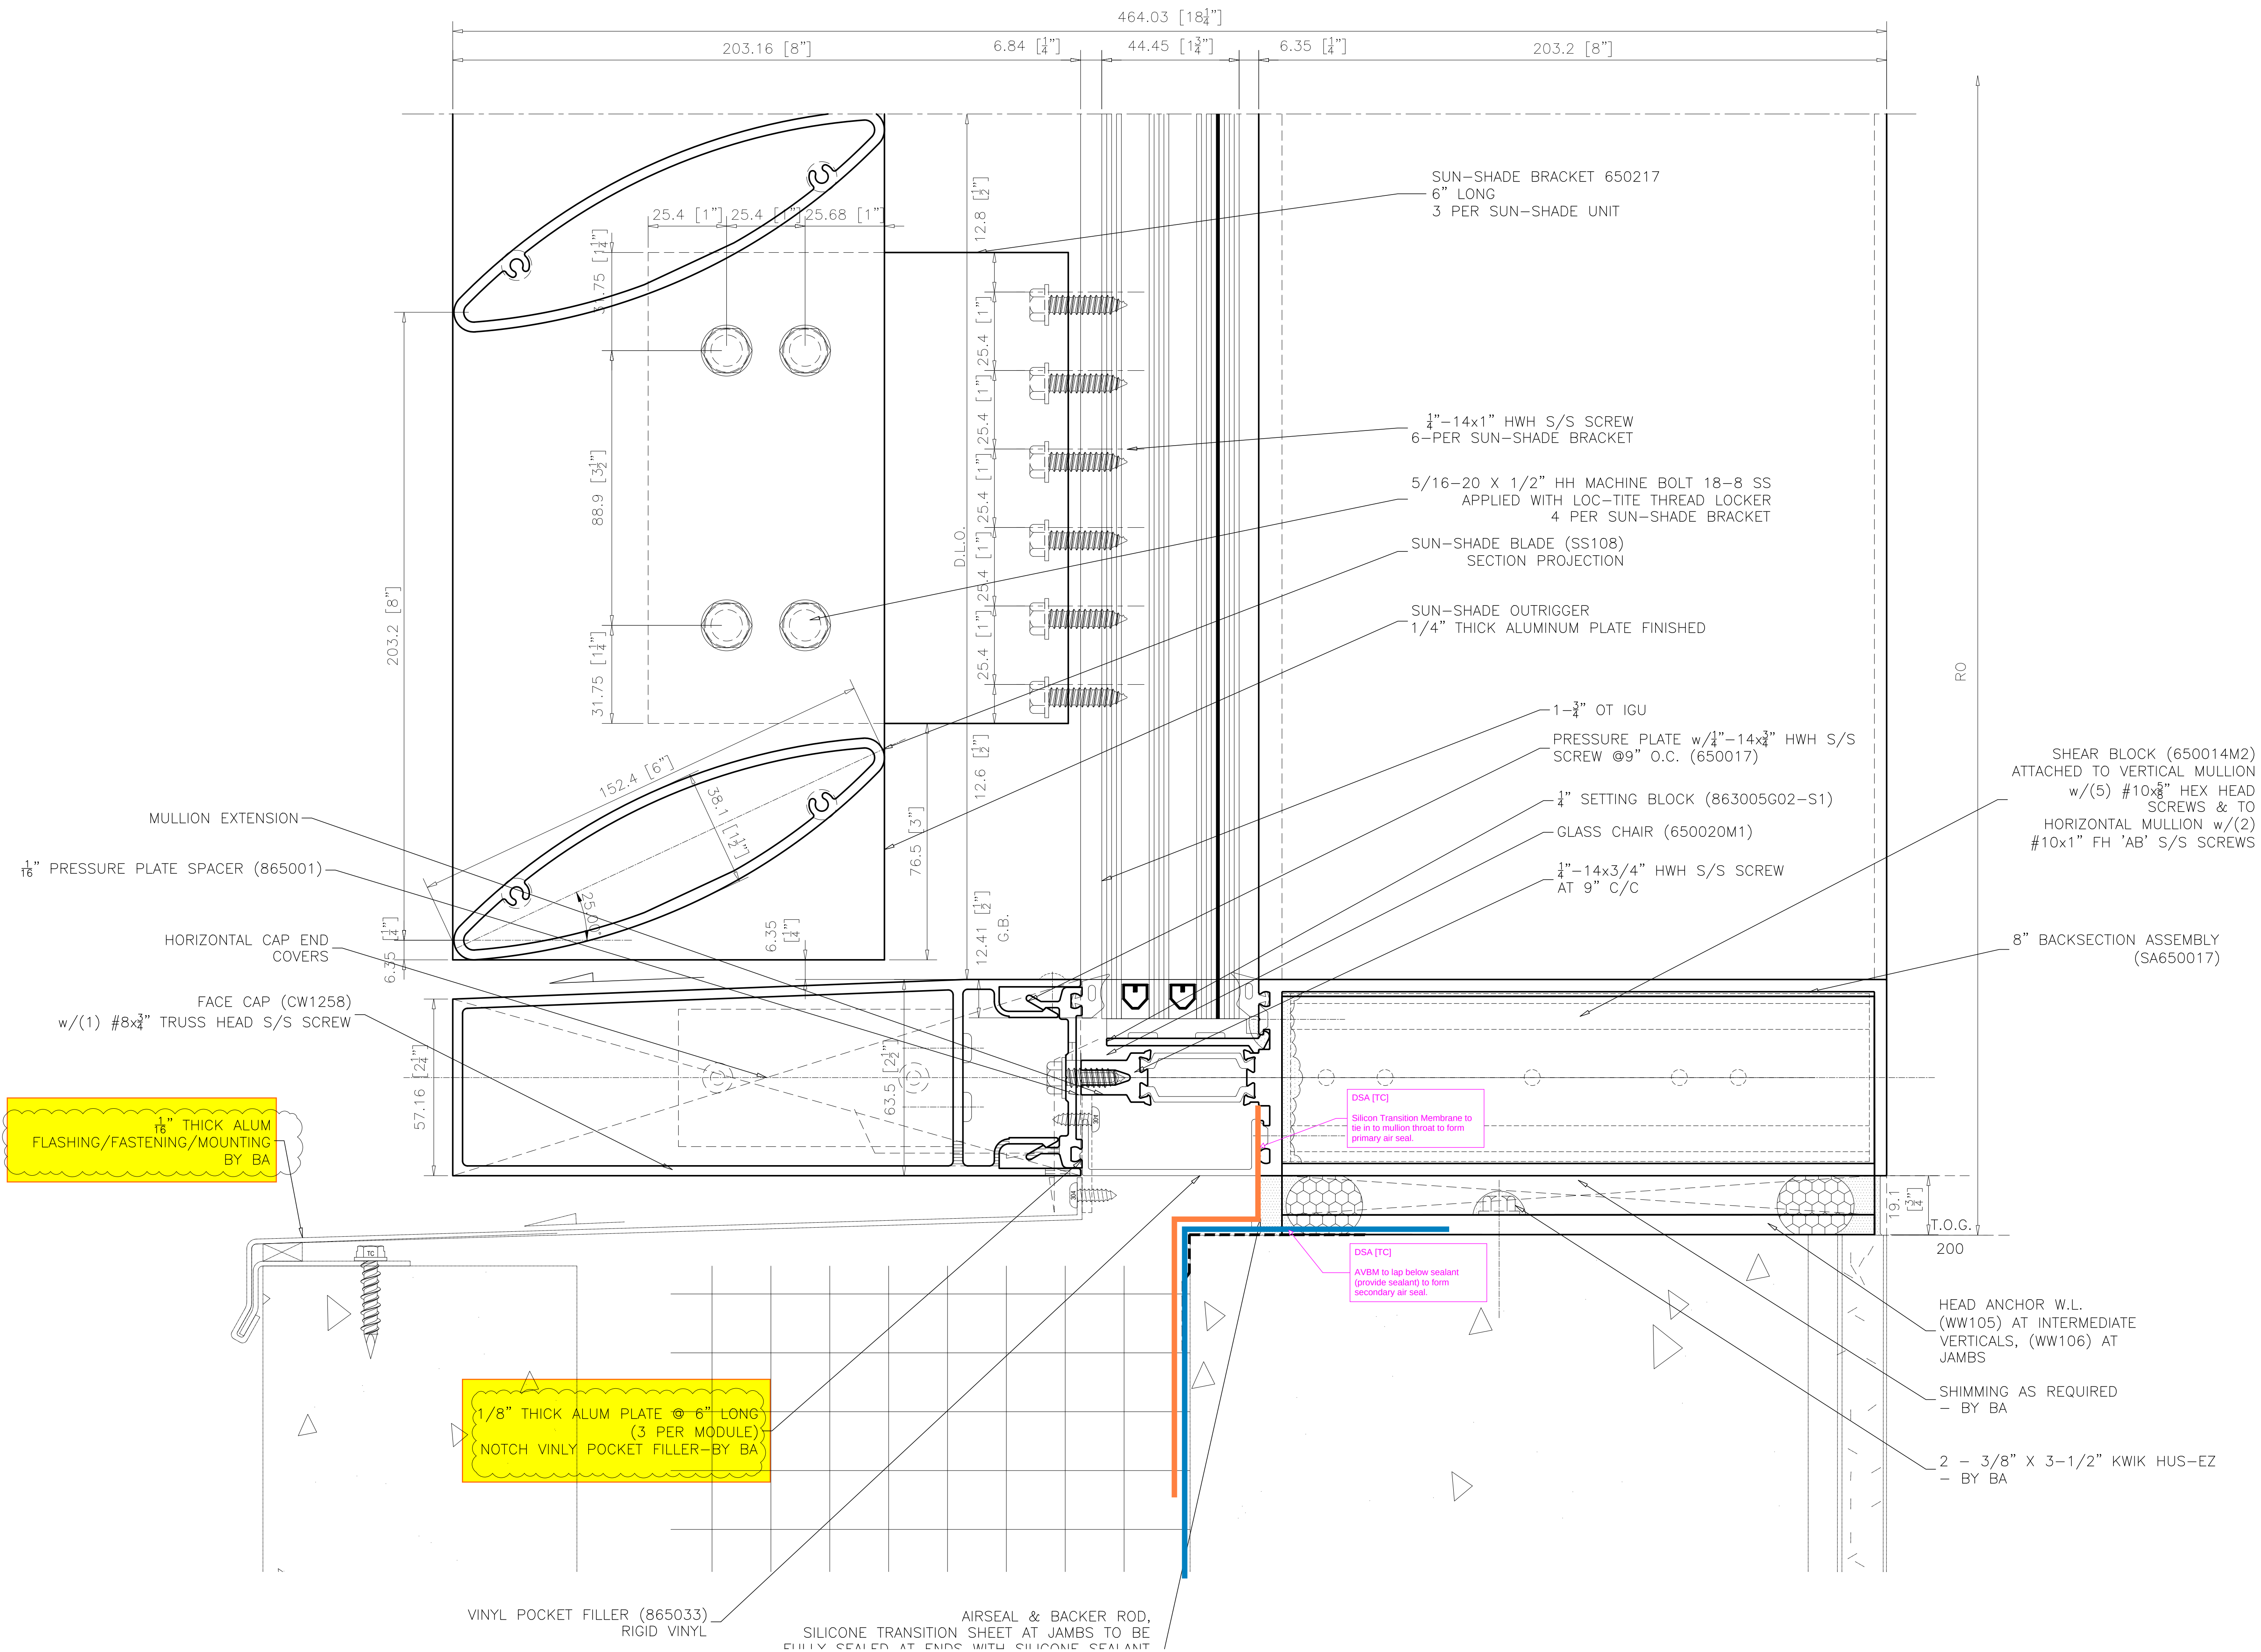

**SILL HORIZONTAL 8" CAP 8" B.S.
AT VISION GLAZING W/ SUNSHADE**

1
C5-013

ARCH. REF.: 1/A551

REVISIONS

No.	Description:	Date:	By:
1	Revised per arch. markups received Feb 11/26	03/03/26	SLR

Project Name:
DOCKSTEADER PRPS

Project Location:
BRAMPTON, ONTARIO

Architect Name:
DIAMOND SCHMITT ARCHITECTS

Customer Name:
BOTHWELL ACCURATE GLAZING



275 Britannia Road East • Mississauga • Ontario • Canada • L4Z2E7
905-890-6970 • oldcastlebe.com

Drawing Name:

SECTION DETAIL

Drawn By: SR

Checked By: NP

Drawn Date: 2026/01/12


Issue No.: 1

Scale: 1"=1"

Release Date: 2026/03/03

Drawing Number:

C5-013

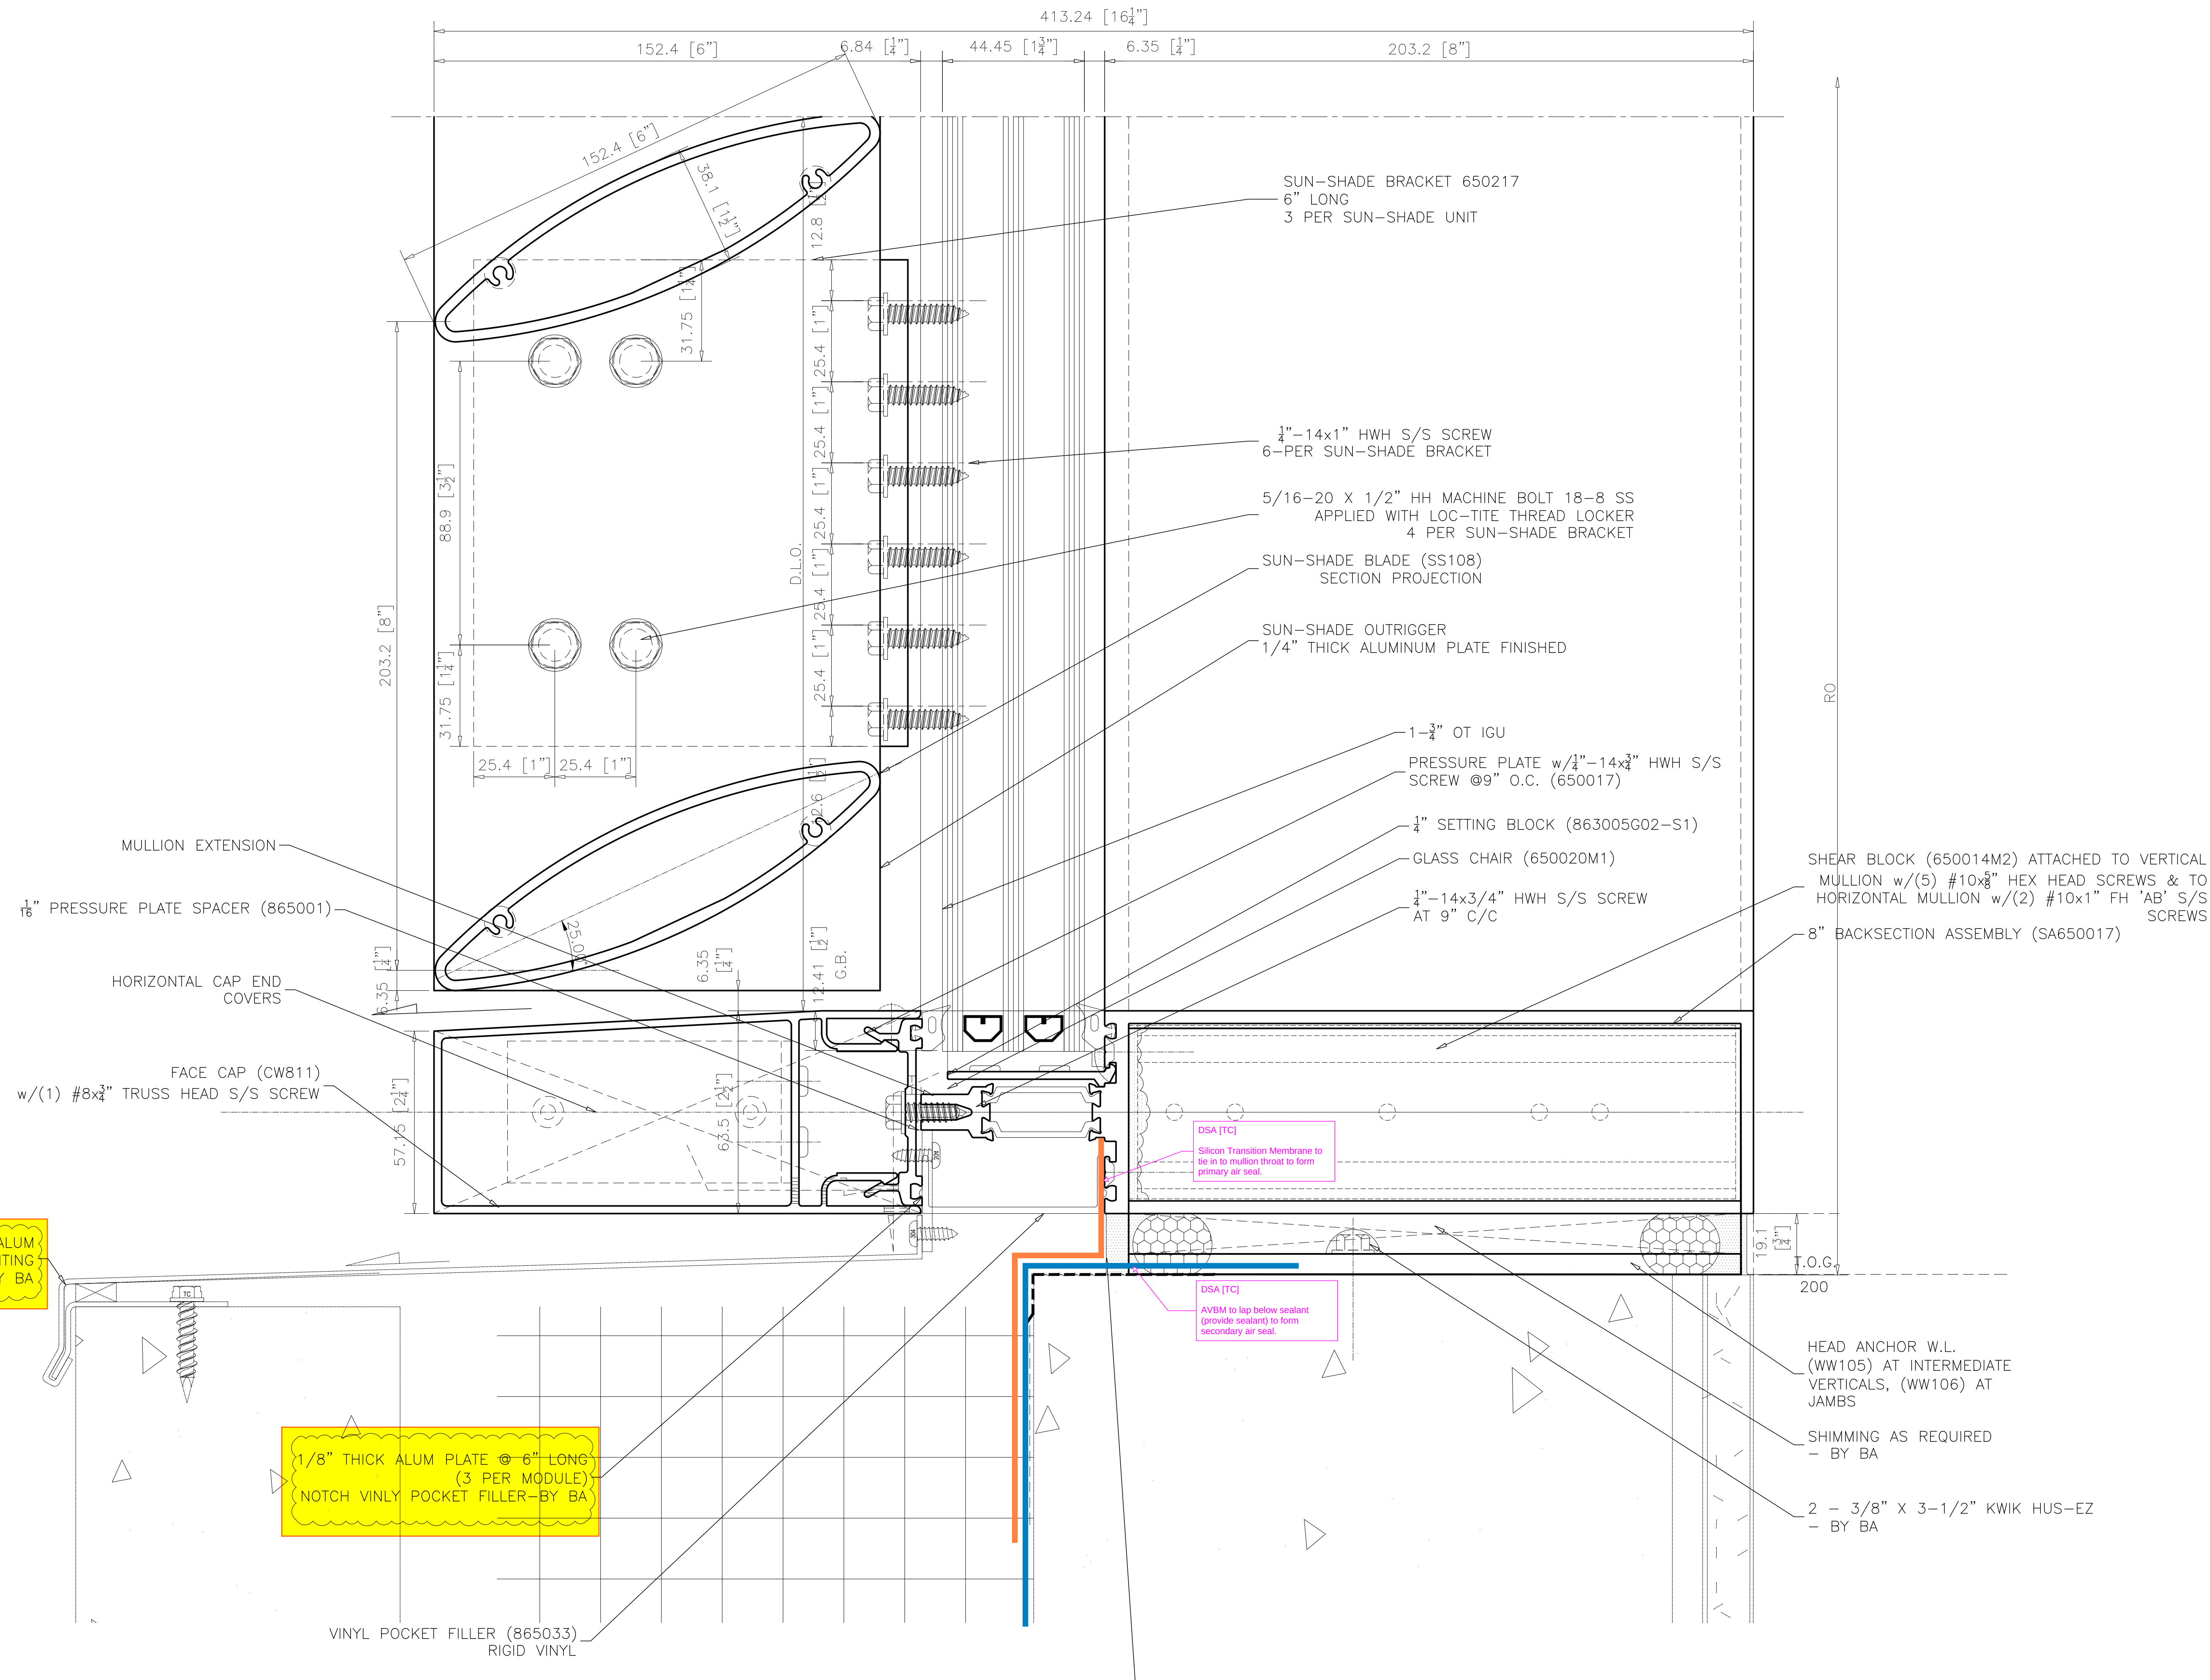

**SILL HORIZONTAL 6" CAP 8" B.S.
AT VISION GLAZING W/ SUNSHADE**

1
C5-013A ARCH. REF.: 1/A551

REVISIONS

No.	Description:	Date:	By:
1	Revised per arch. markups received Feb 11/26	03/03/26	SLR


Project Name:
DOCKSTEADER PRPS

Project Location:
BRAMPTON, ONTARIO

Architect Name:
DIAMOND SCHMITT ARCHITECTS

Customer Name:
BOTHWELL ACCURATE GLAZING

oldcastle BuildingEnvelope®

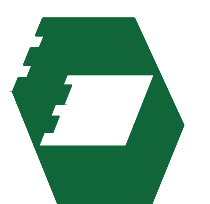


275 Britannia Road East • Mississauga • Ontario • Canada • L4Z2E7
905-890-6970 • oldcastlebe.com

Drawing Name:
SECTION DETAIL

Drawn By: SR	Checked By: NP
Drawn Date: 2026/01/12	Issue No.: 1
Scale: 1"=1"	Release Date: 2026/03/03

Drawing Number:
C5-013A

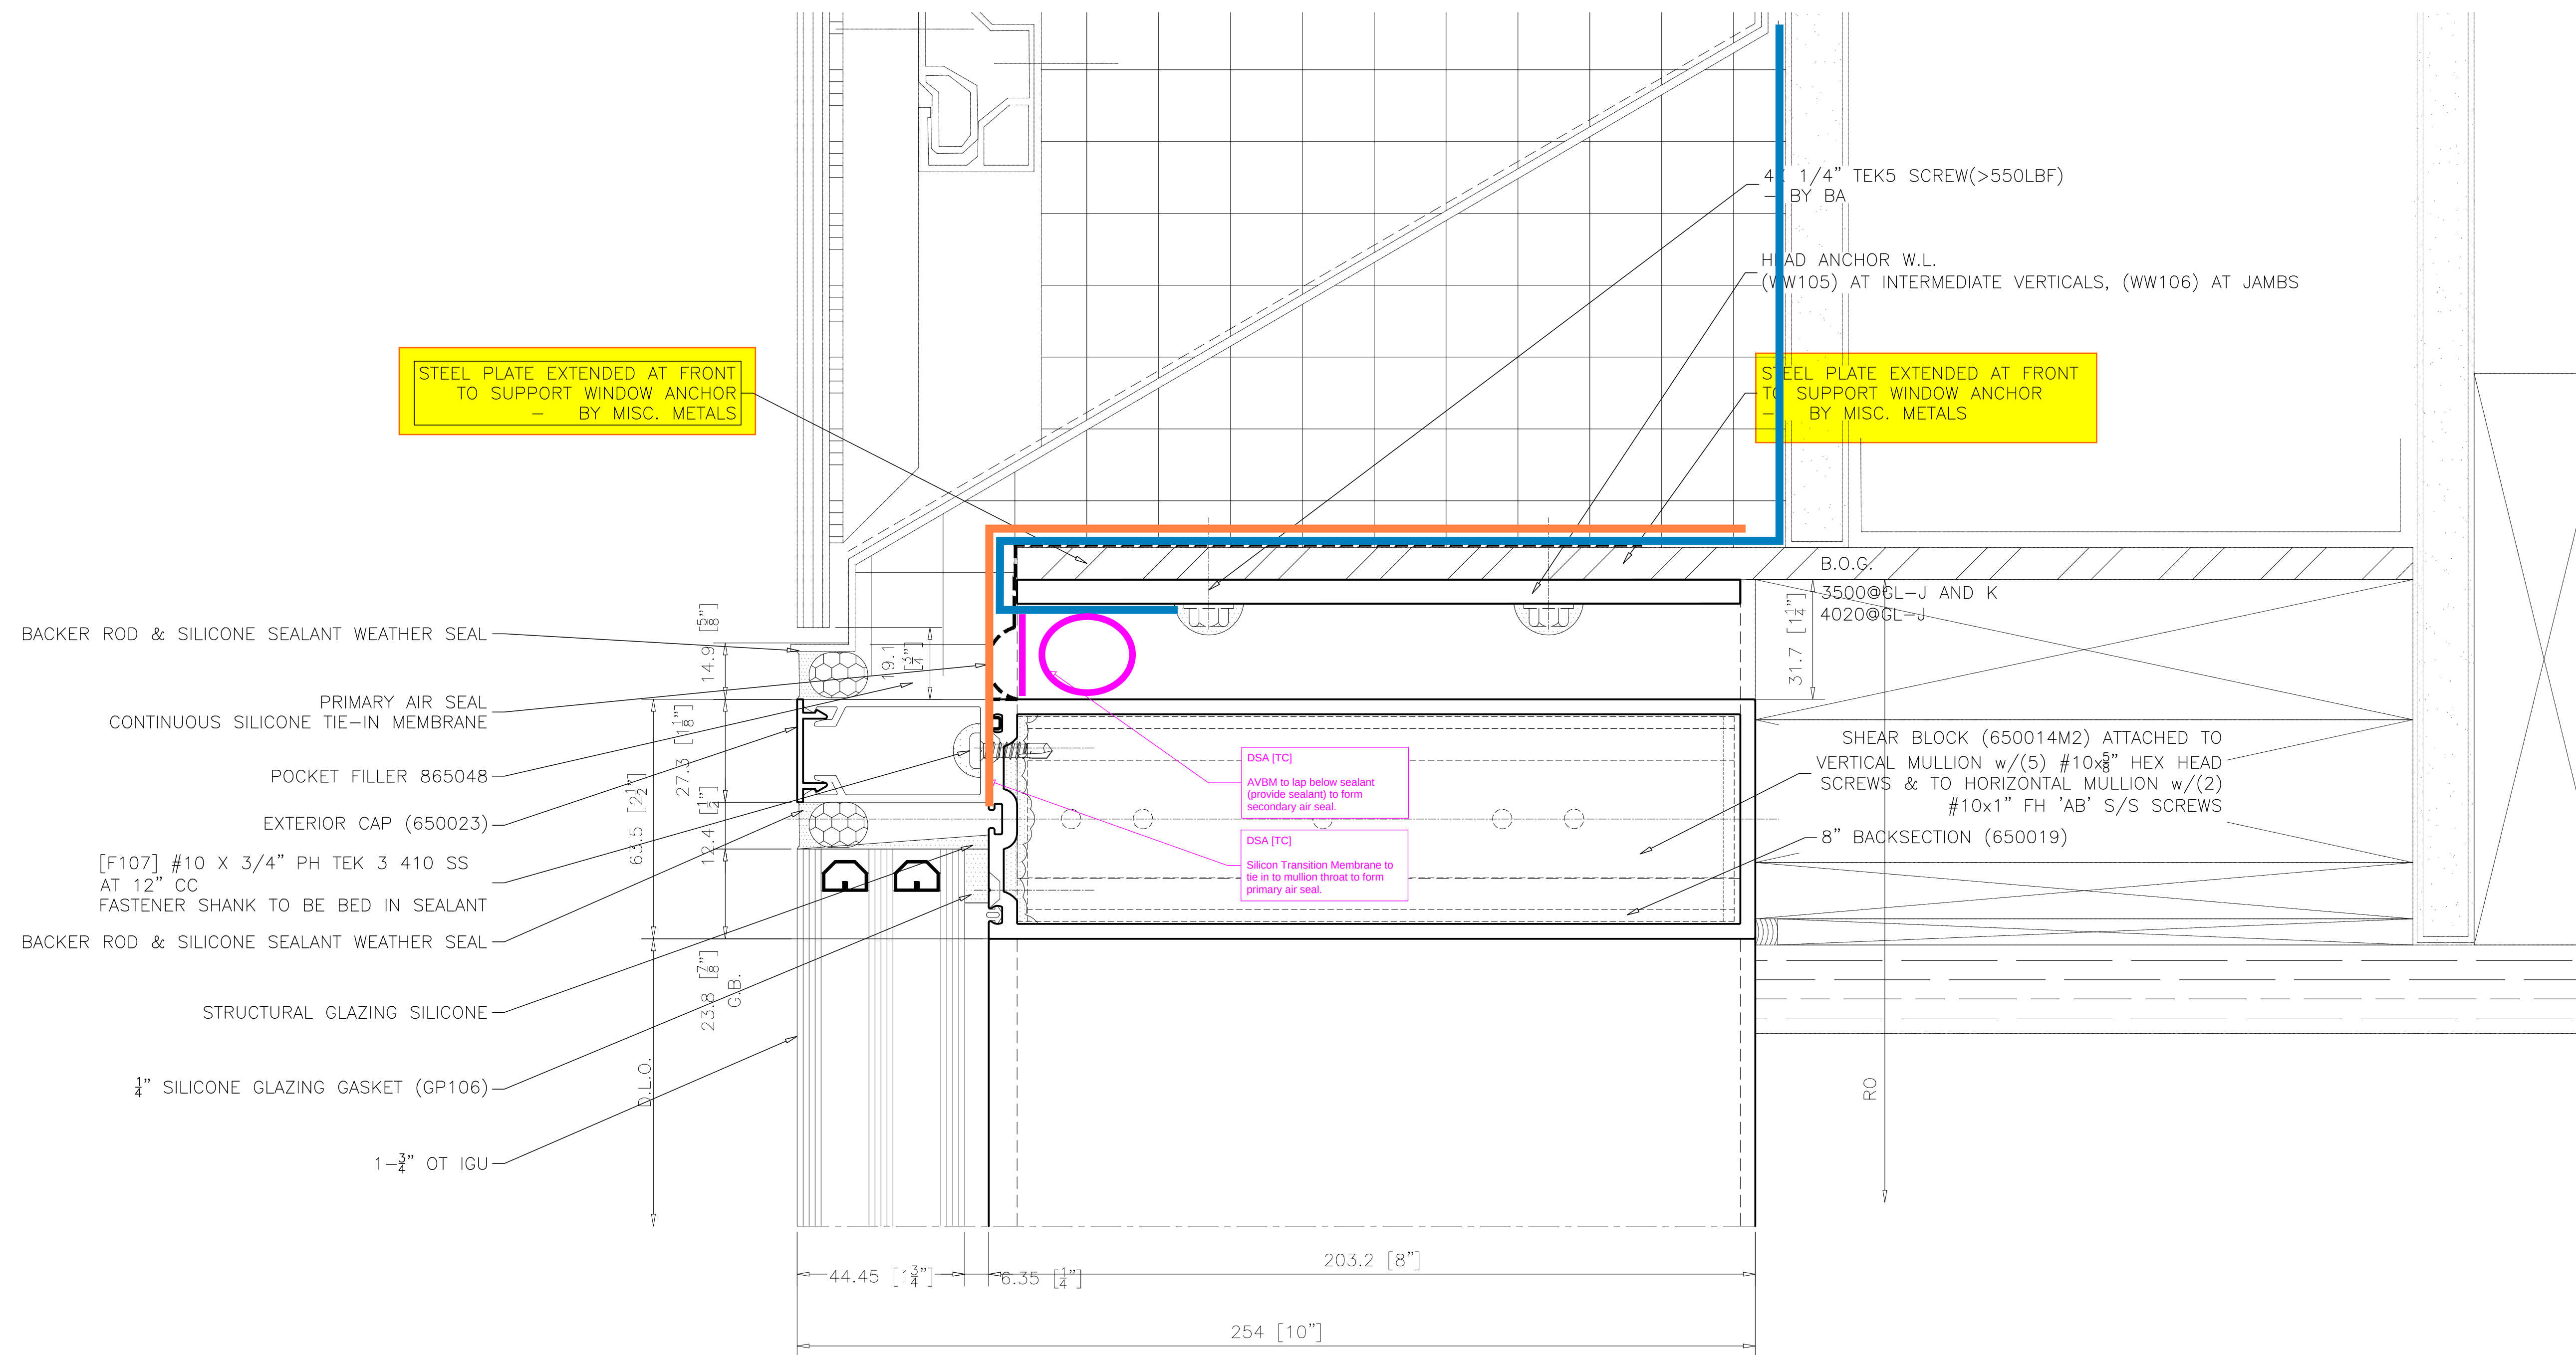

1
C5-014

**HEAD HORIZONTAL SSG 8" B.S.
AT VISION GLAZING GL1A**

ARCH. REF.: 6/A451 SIM

REVISIONS


No.	Description:	Date:	By:
1	Revised per arch. markups received Feb 11/26	03/03/26	SLR

Project Name:
DOCKSTEADER PRPS

Project Location:
BRAMPTON, ONTARIO

Architect Name:
DIAMOND SCHMITT ARCHITECTS

Customer Name:
BOTHWELL ACCURATE GLAZING

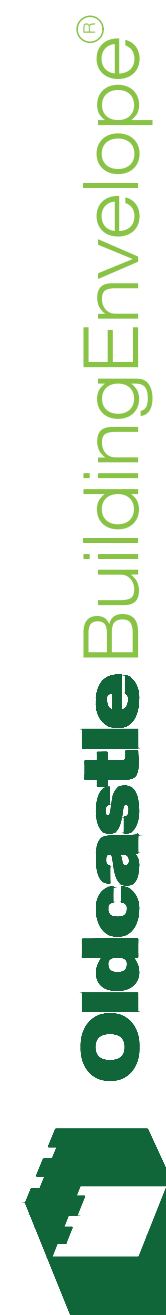


275 Britannia Road East • Mississauga • Ontario • Canada • L4Z2E7
905-890-6970 • oldcastlebe.com

Drawing Name:

SECTION DETAIL

Drawn By: SR	Checked By: NP
Drawn Date: 2026/01/12	Issue No.: 1
Scale: 1"=1"	Release Date: 2026/03/03

Drawing Number: **C5-014**

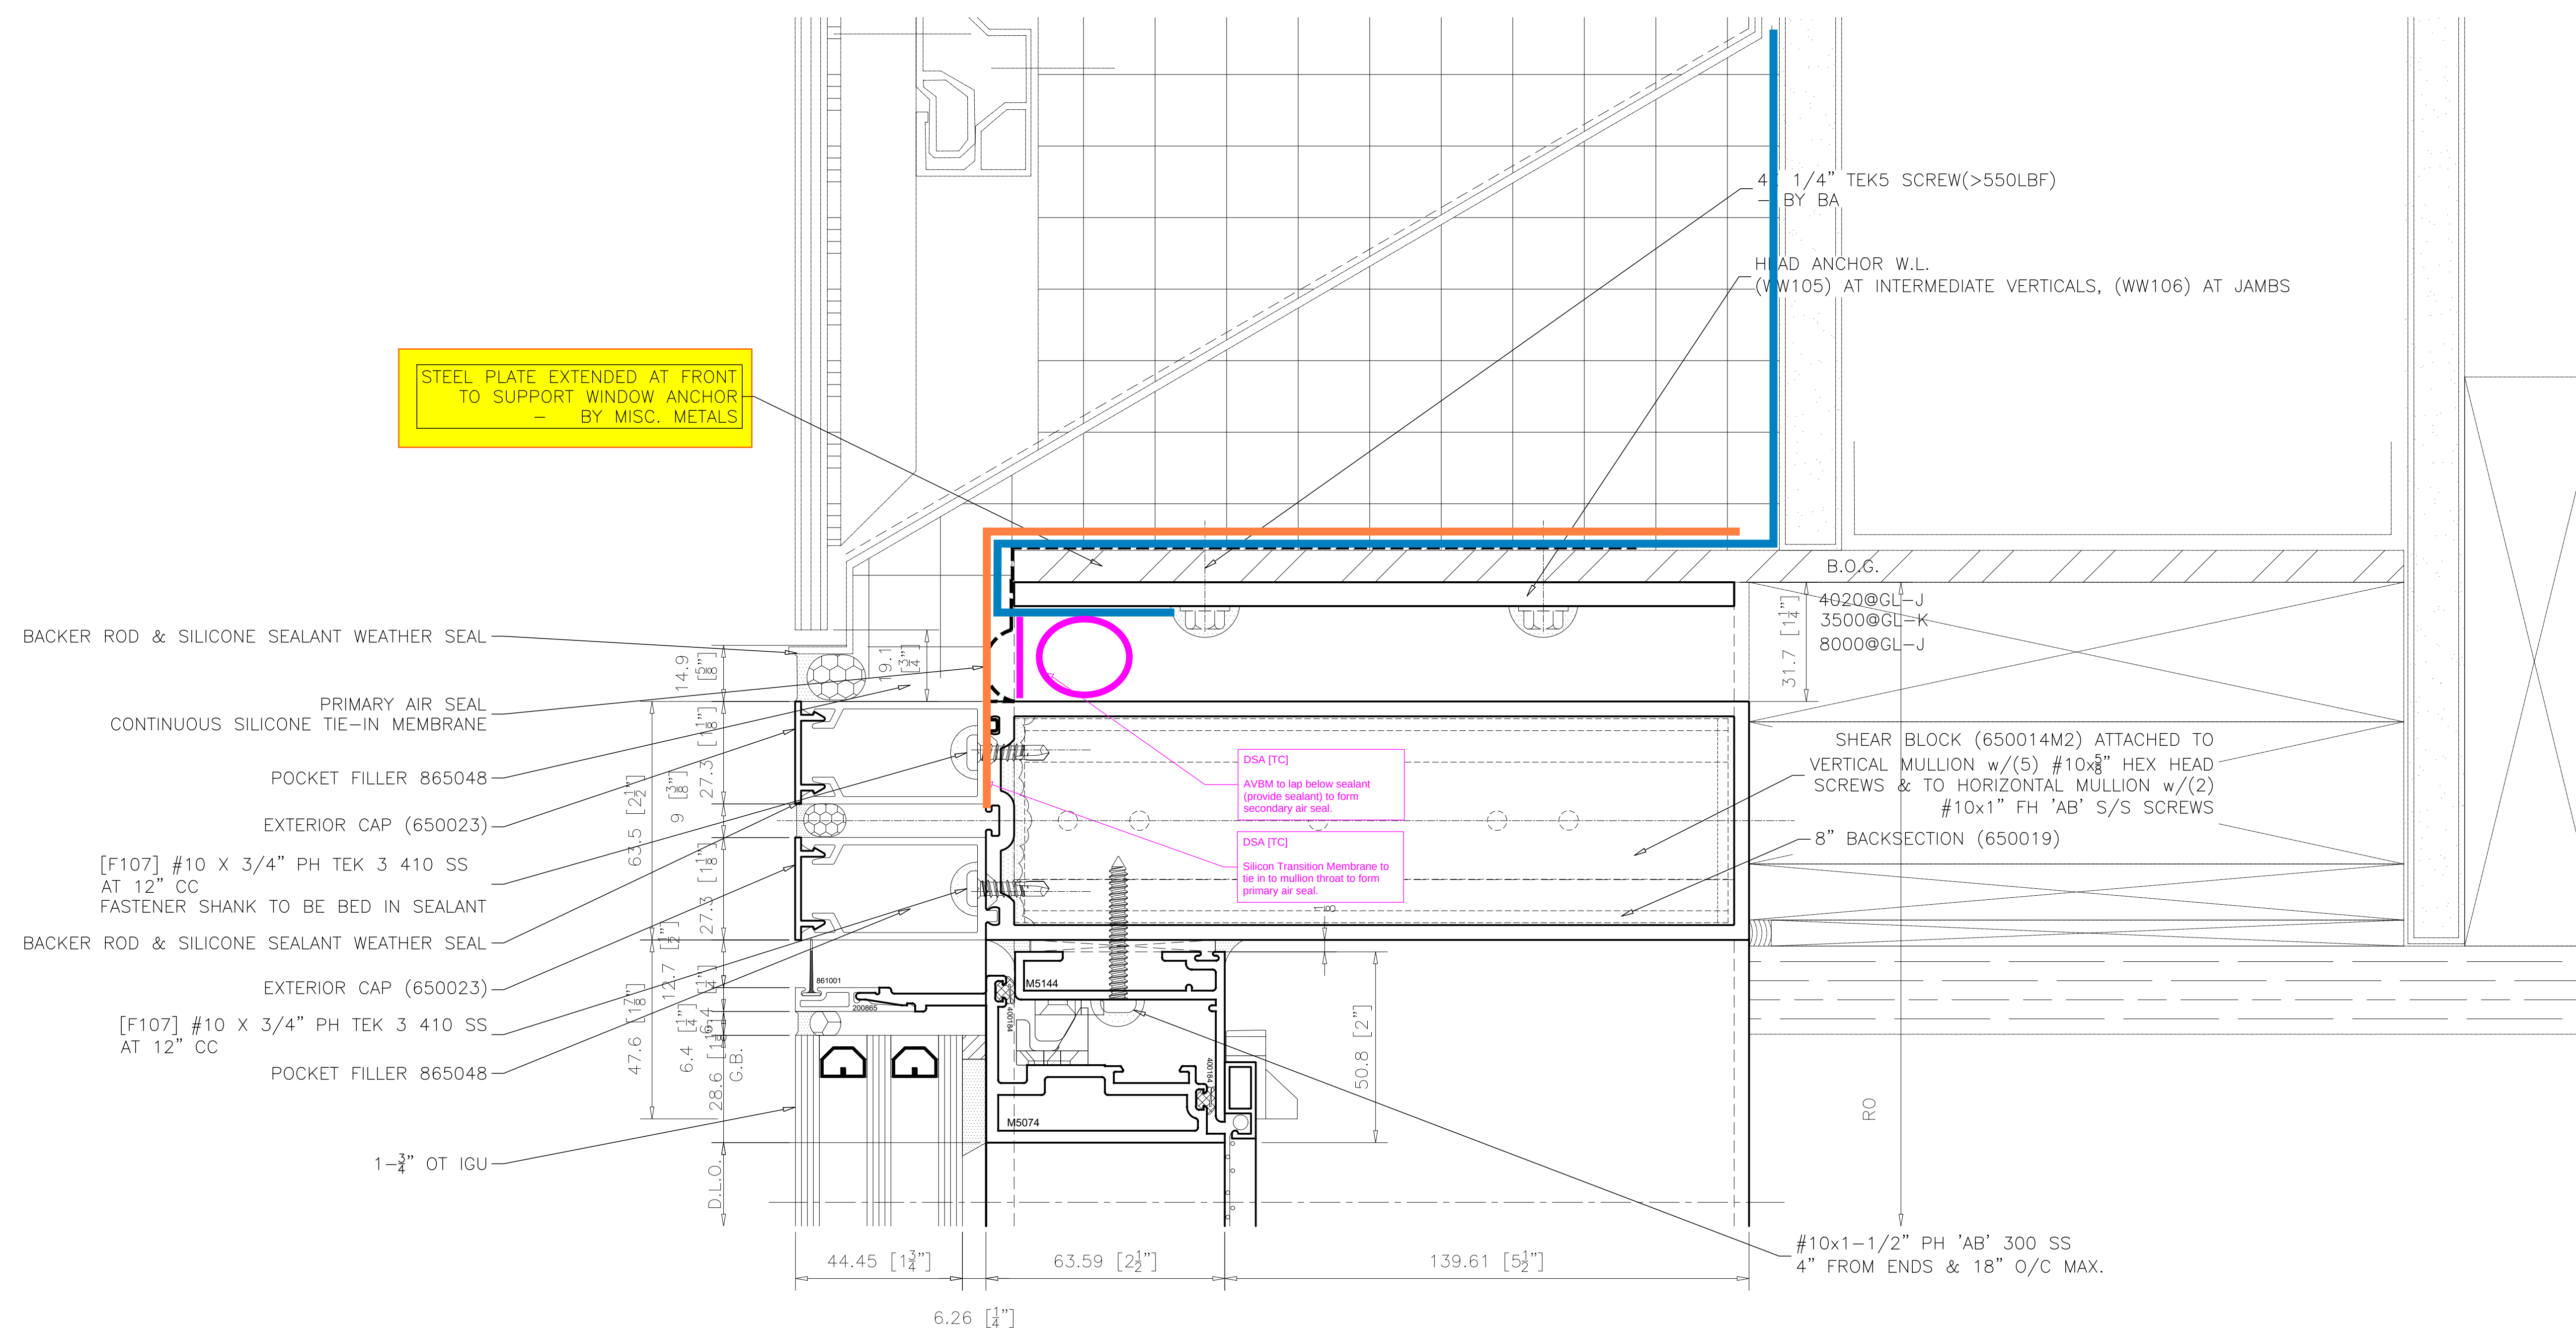

1
C5-014A

HEAD HORIZONTAL SSG 8" B.S.
AT VENT

ARCH. REF.: 6/A451 SIM


REVISIONS			
No.	Description:	Date:	By:
1	Revised per arch. markups received Feb 11/26	03/03/26	SLR

Project Name: DOCKSTEADER PRPS	Project Location: BRAMPTON, ONTARIO	Architect Name: DIAMOND SCHMITT ARCHITECTS	Customer Name: BOTHWELL ACCURATE GLAZING
-----------------------------------	--	---	---



275 Britannia Road East • Mississauga • Ontario • Canada • L4Z2E7
905-890-6970 • oldcastlebe.com

Drawing Name: SECTION DETAIL	
Drawn By: SR	Checked By: NP
Drawn Date: 2026/01/12	Issue No.: 1
Scale: 1"=1"	Release Date: 2026/03/03
Drawing Number: C5-014A	

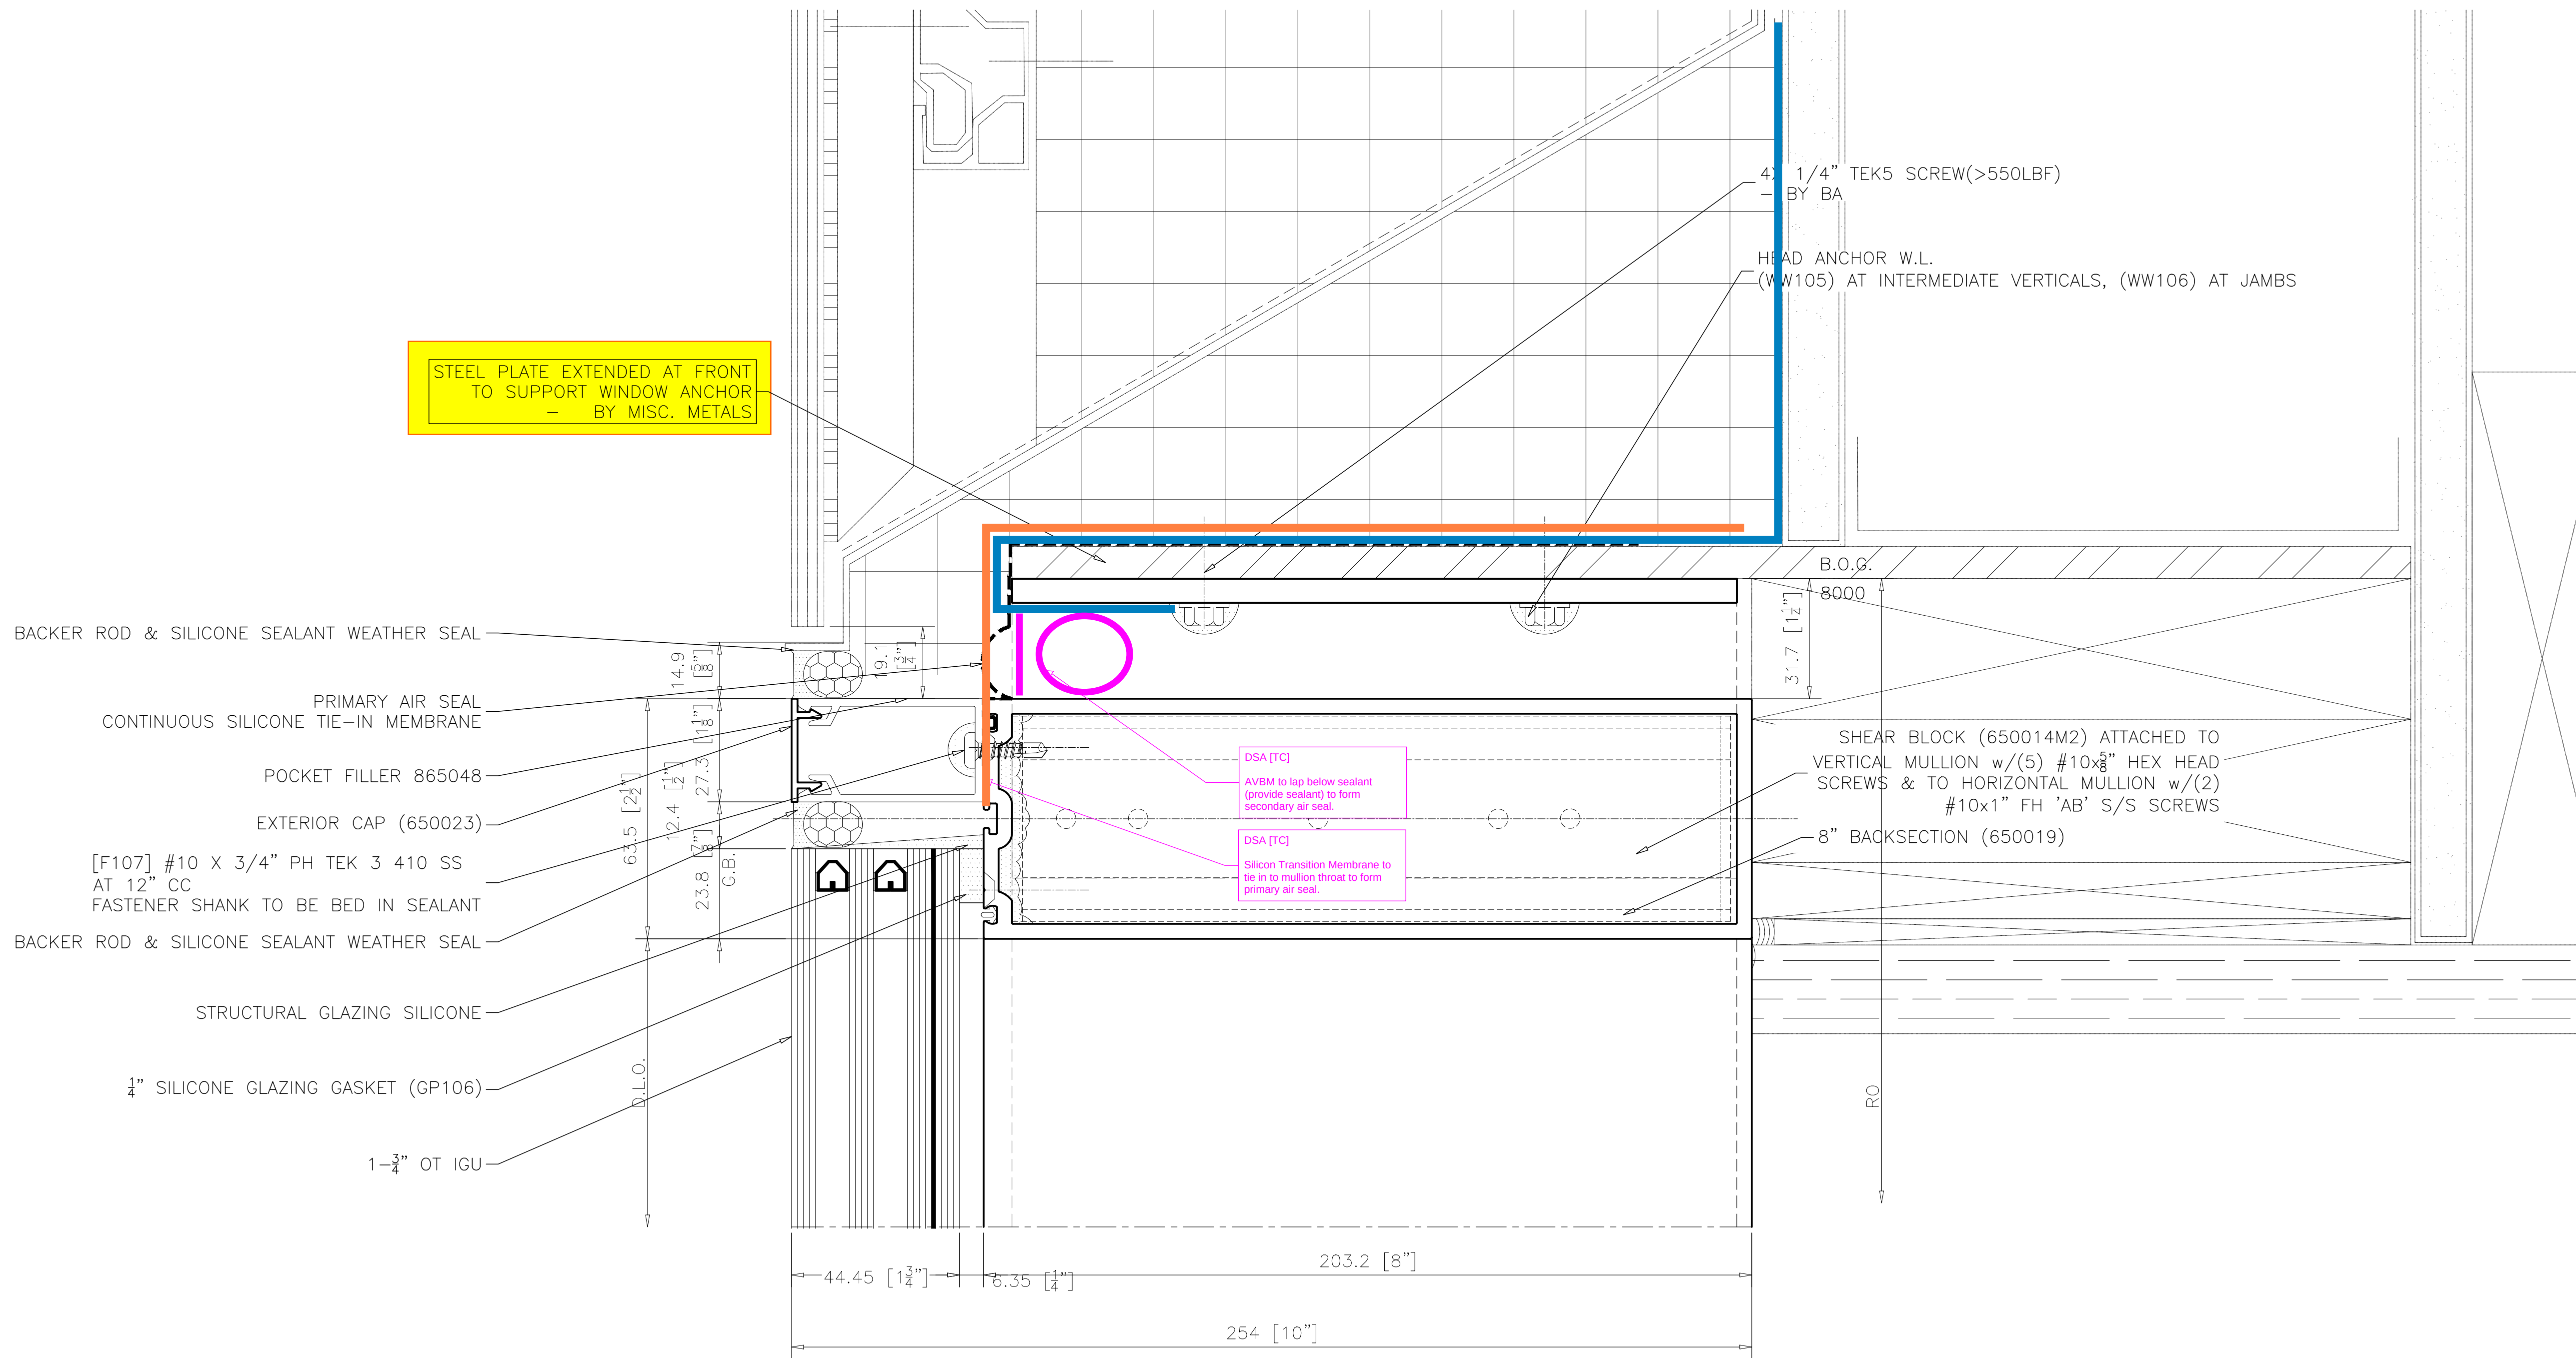

1
C5-014B

**HEAD HORIZONTAL SSG 8" B.S.
AT VISION GLAZING GL1B**

ARCH. REF.: 6/A451 SIM

REVISIONS

No.	Description:	Date:	By:
1	Revised per arch. markups received Feb 11/26	03/03/26	SLR

Project Name:
DOCKSTEADER PRPS

Project Location:
BRAMPTON, ONTARIO

Architect Name:
DIAMOND SCHMITT ARCHITECTS

Customer Name:
BOTHWELL ACCURATE GLAZING



275 Britannia Road East • Mississauga • Ontario • Canada • L4Z2E7
905-890-6970 • oldcastlebe.com

Drawing Name:

SECTION DETAIL

Drawn By: SR

Checked By: NP


Drawn Date: 2026/01/12

Issue No.: 1

Scale: 1"=1"

Release Date: 2026/03/03

Drawing Number: C5-014B

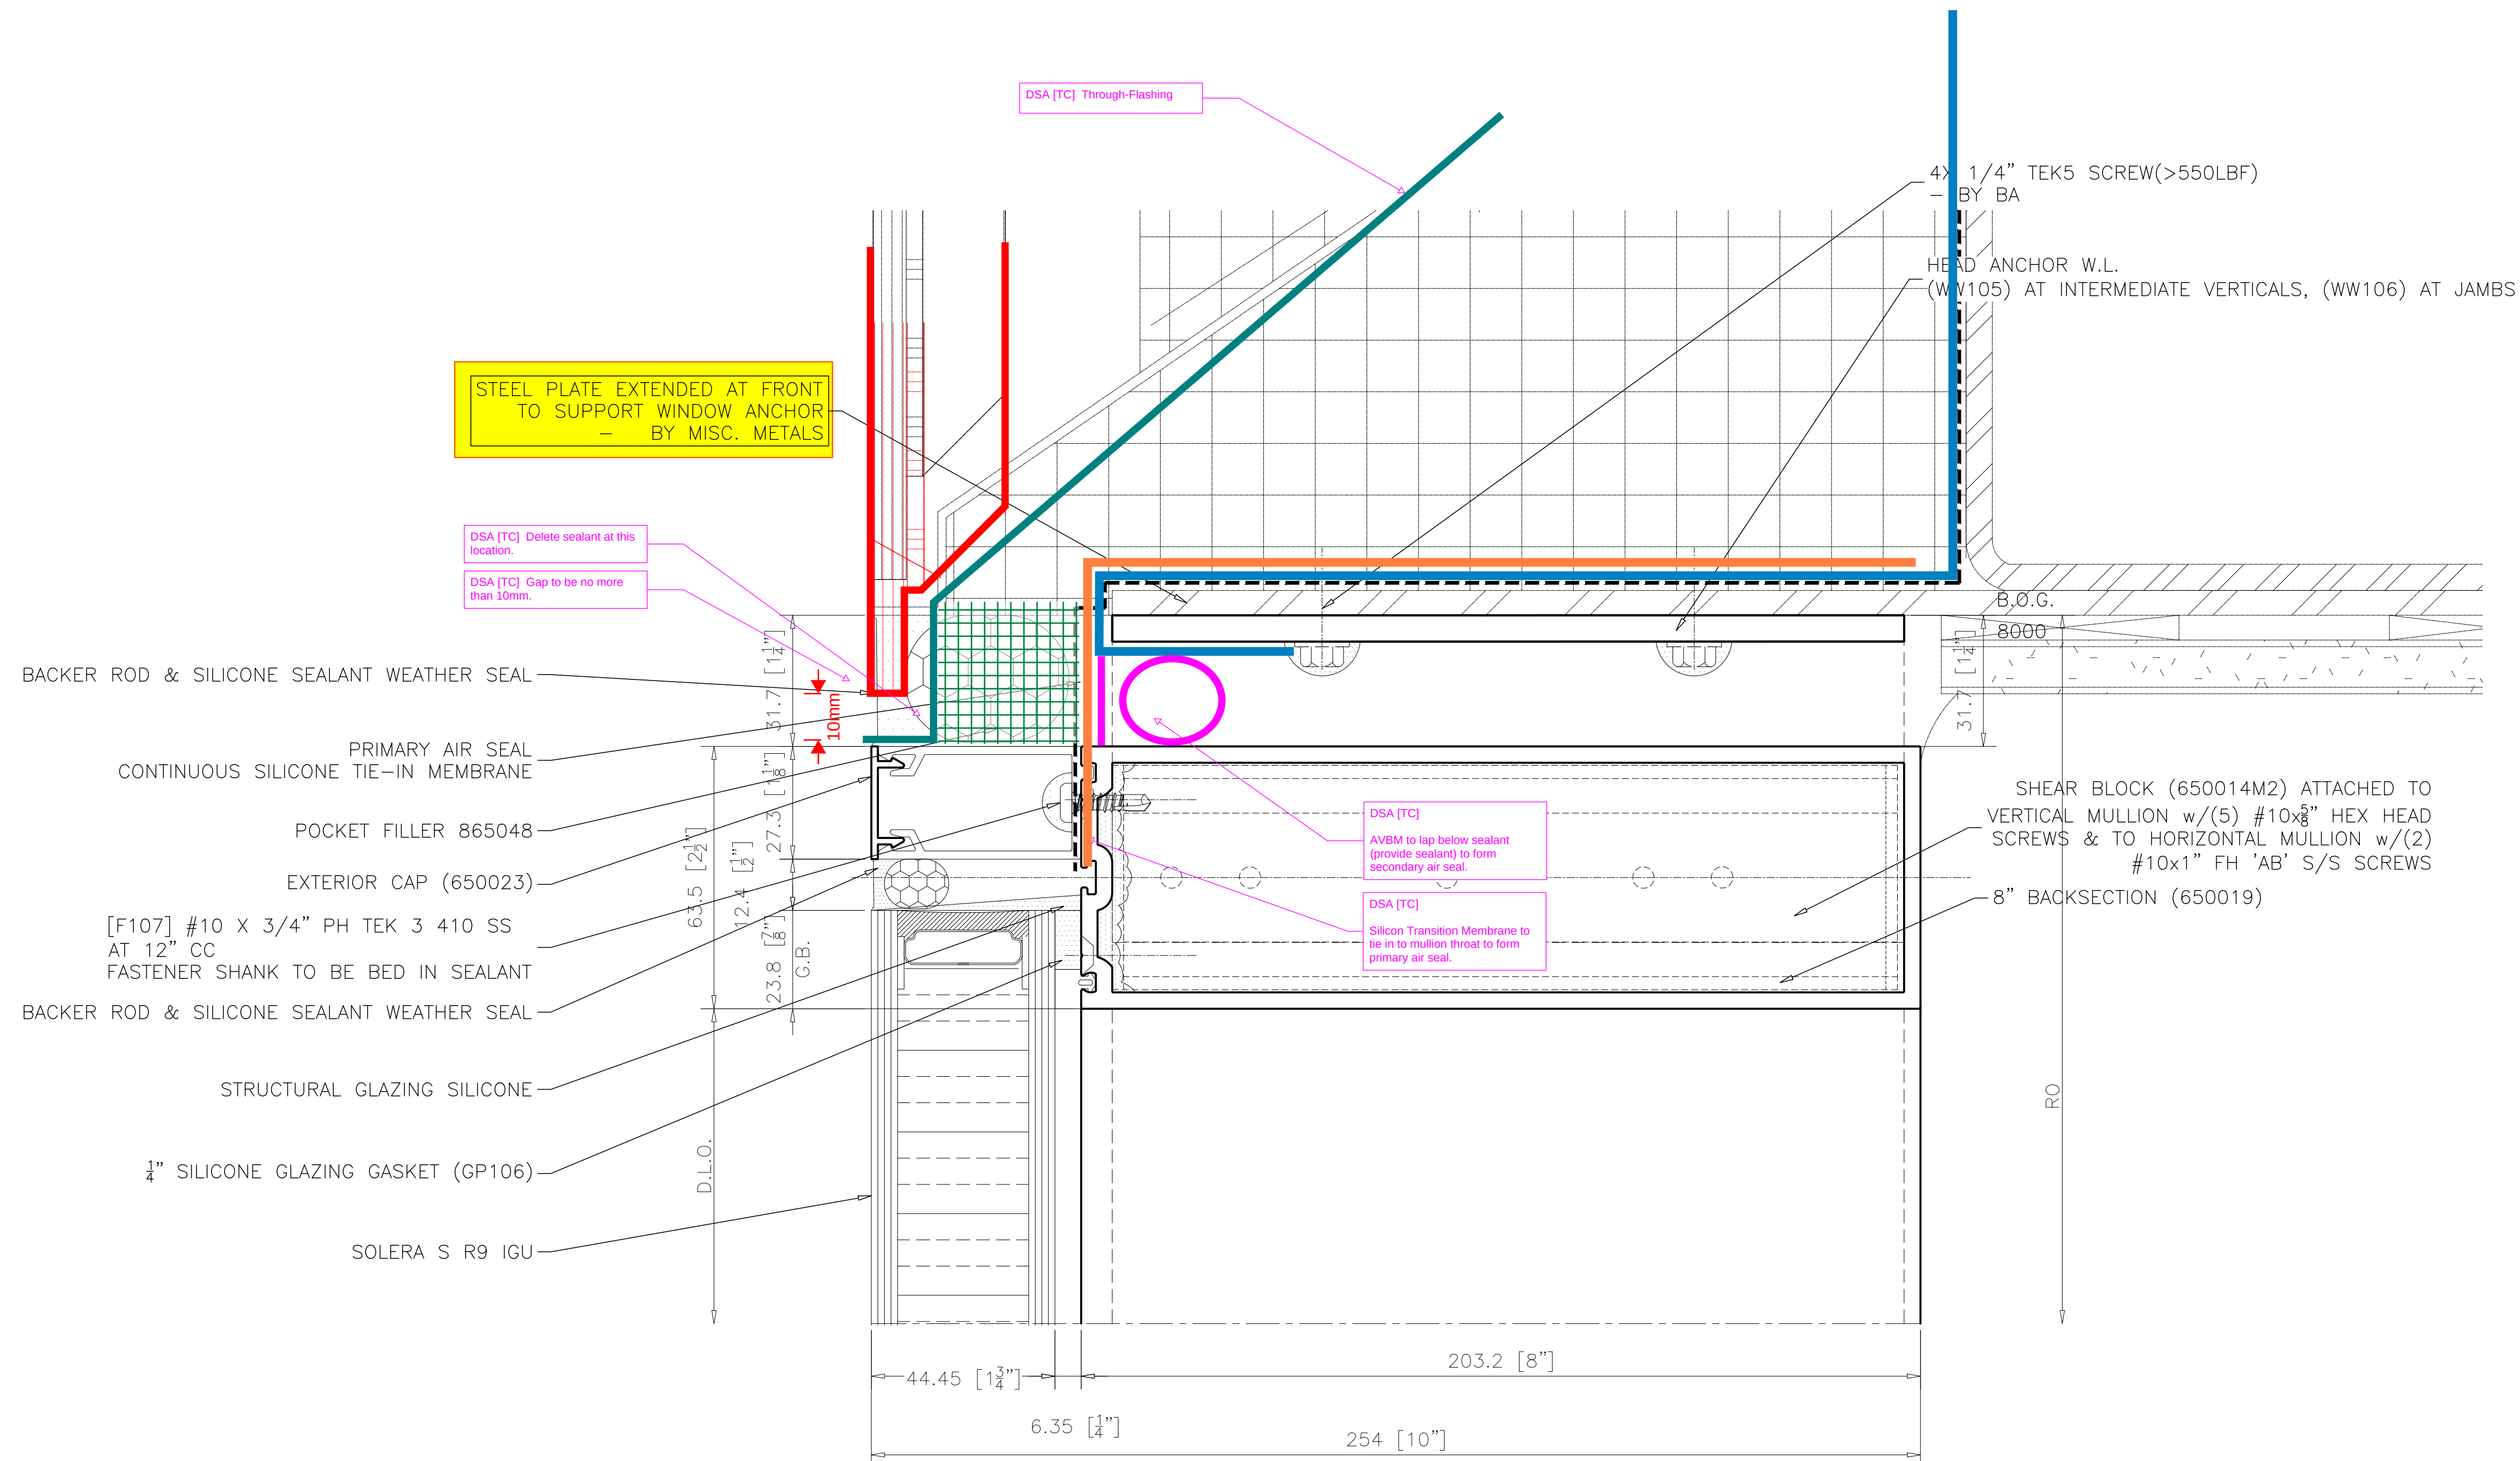

1
C5-014C

**HEAD HORIZONTAL SSG 8" B.S.
AT SOLERA GLAZING**

ARCH. REF.: 2/A453

REVISIONS

No.	Description:	Date:	By:
1	Revised per arch. markups received Feb 11/26	03/03/26	SLR

Project Name:
DOCKSTEADER PRPS

Project Location:
BRAMPTON, ONTARIO

Architect Name:
DIAMOND SCHMITT ARCHITECTS

Customer Name:
BOTHWELL ACCURATE GLAZING




275 Britannia Road East • Mississauga • Ontario • Canada • L4Z2E7
905-890-6970 • oldcastlebe.com

Drawing Name:

SECTION DETAIL

Drawn By: SR	Checked By: NP
Drawn Date: 2026/01/12	Issue No.: 1
Scale: 1"=1"	Release Date: 2026/03/03
Drawing Number:	C5-014C

DAS [TC] - This detail is not accepted. And SI will be issued with an updated architectural detail.

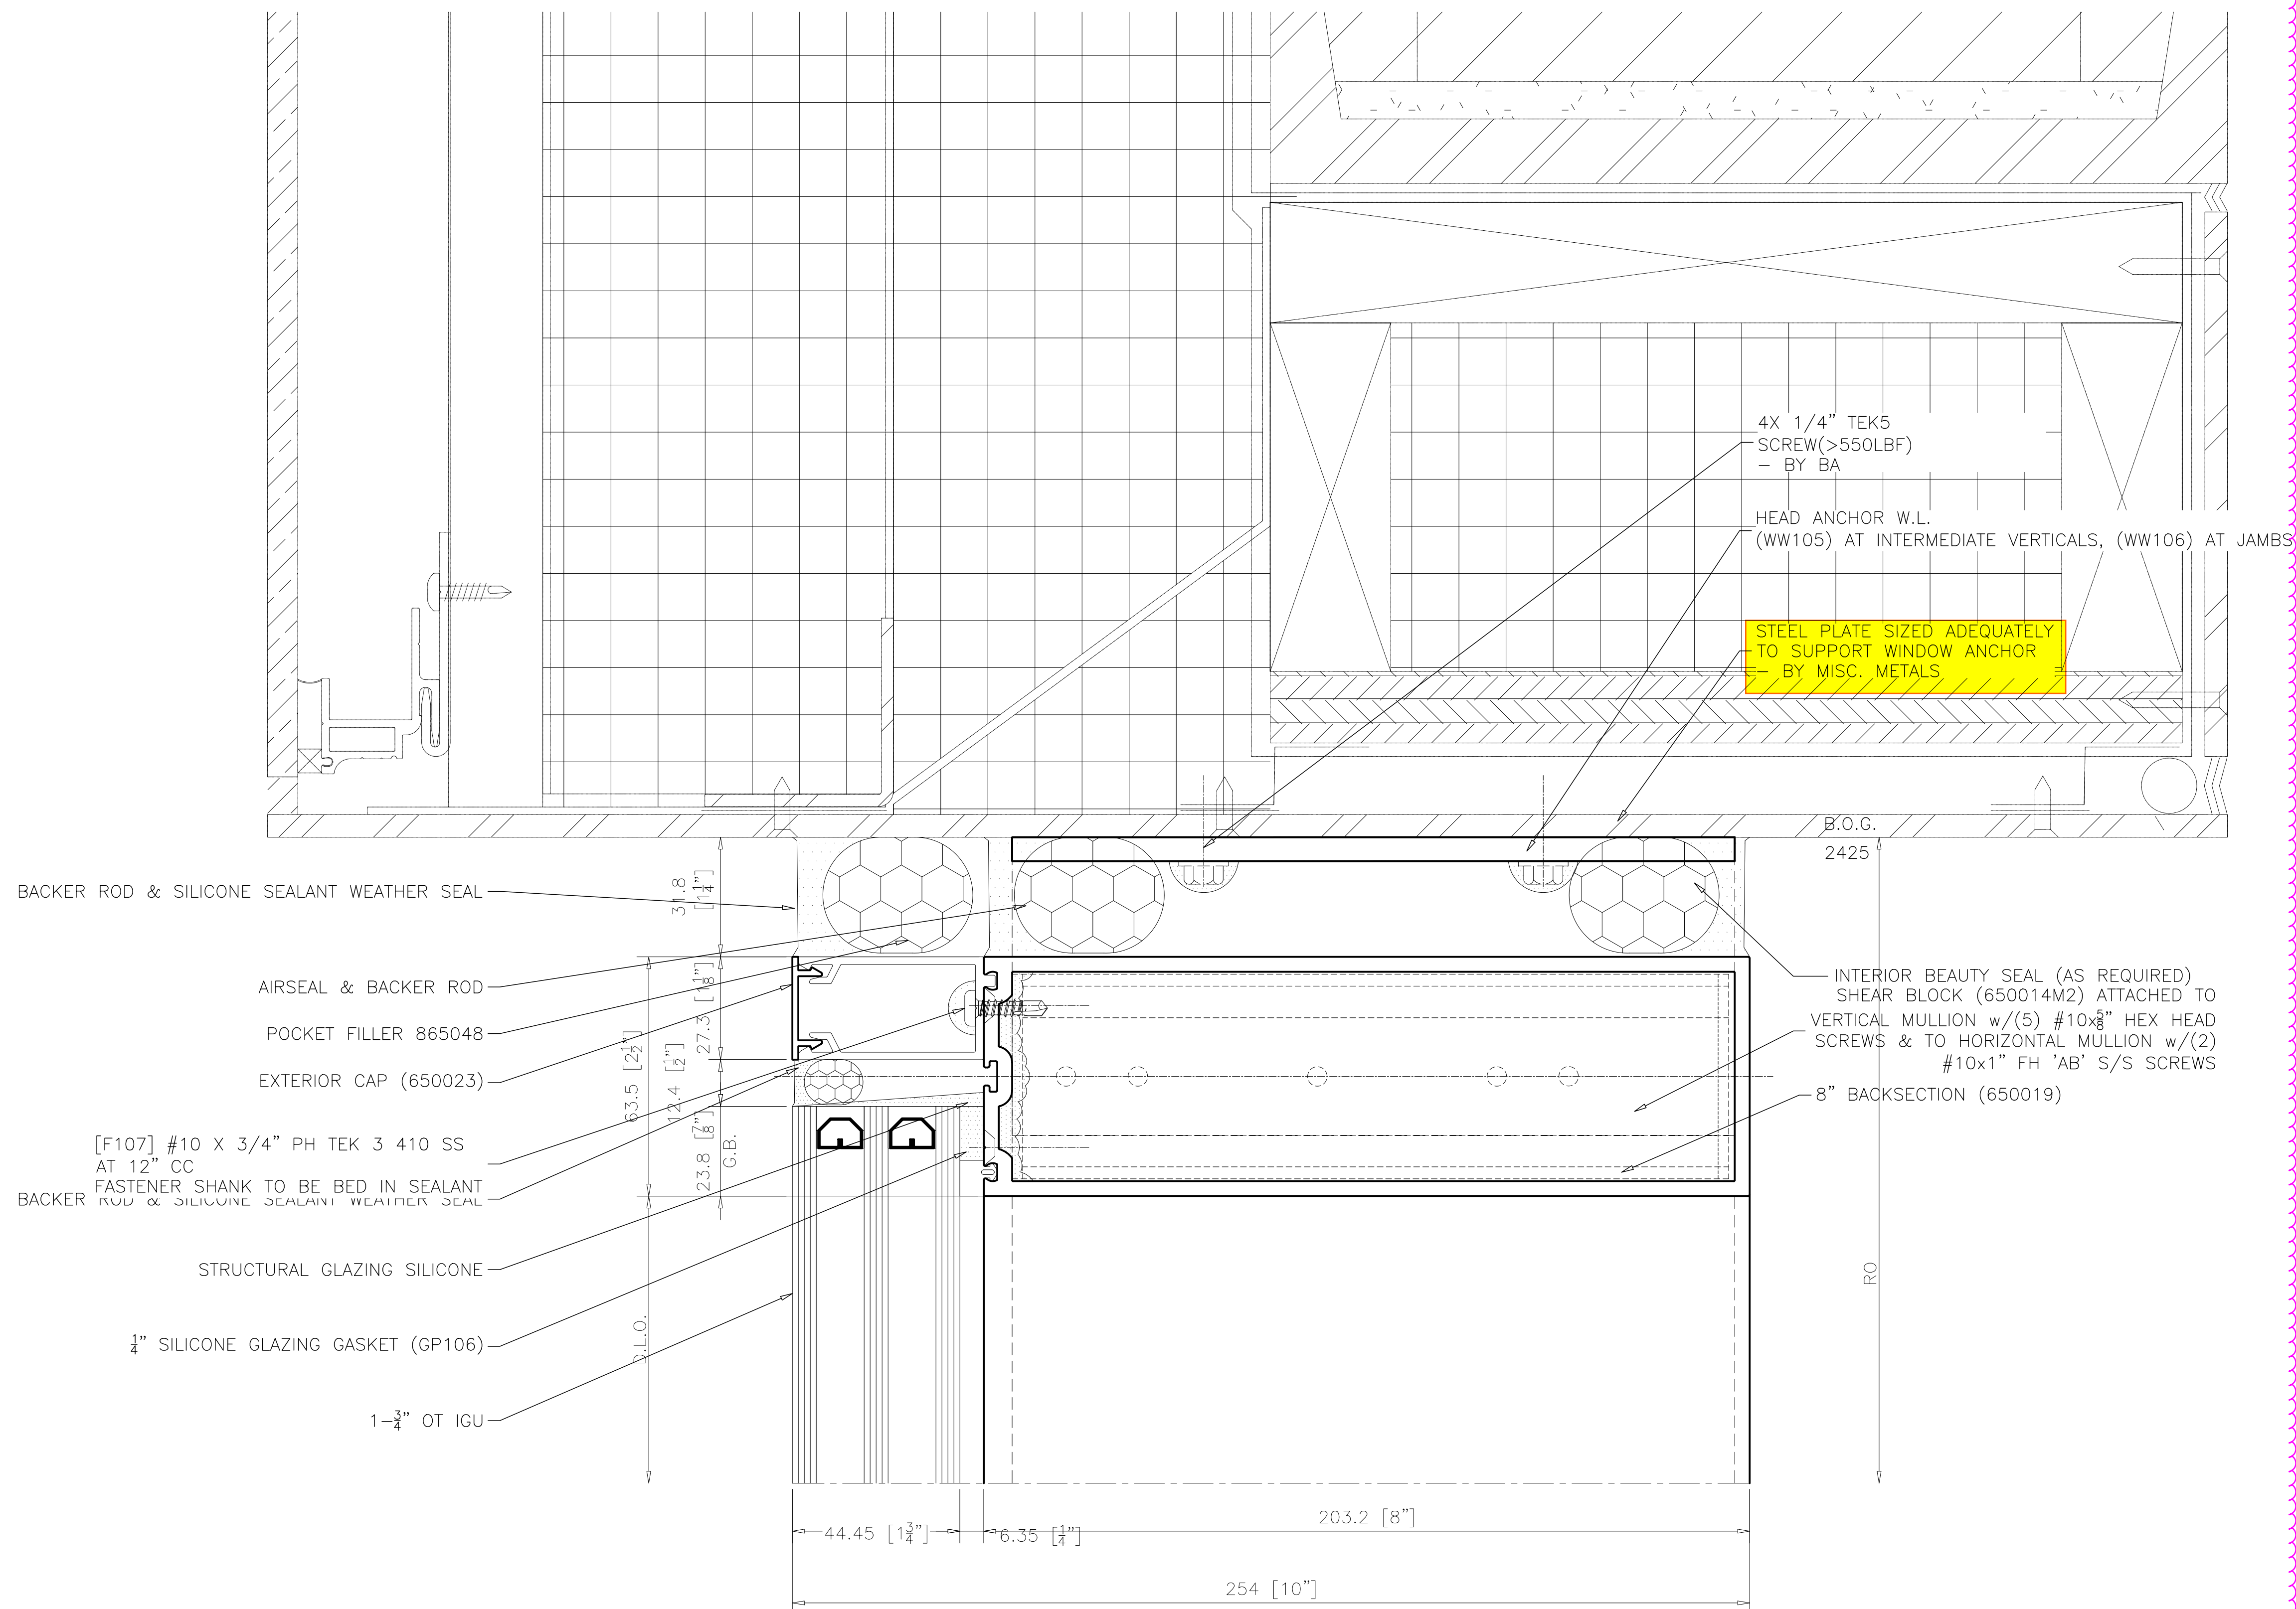

**HEAD HORIZONTAL SSG 8" B.S.
AT SOLERA GLAZING**

1
C5-014D

ARCH. REF.: 6/A451 SIM

REVISIONS

No.	Description:	Date:	By:
1	Revised per arch. markups received Feb 11/26	03/03/26	SLR

Project Name:
DOCKSTEADER PRPS

Project Location:
BRAMPTON, ONTARIO

Architect Name:
DIAMOND SCHMITT ARCHITECTS

Customer Name:
BOTHWELL ACCURATE GLAZING




275 Britannia Road East • Mississauga • Ontario • Canada • L4Z2E7
905-890-6970 • oldcastlebe.com

Drawing Name:

SECTION DETAIL

Drawn By: SR	Checked By: NP
Drawn Date: 2026/01/12	Issue No.: 1
Scale: 1"=1"	Release Date: 2026/03/03

Drawing Number: **C5-014D**

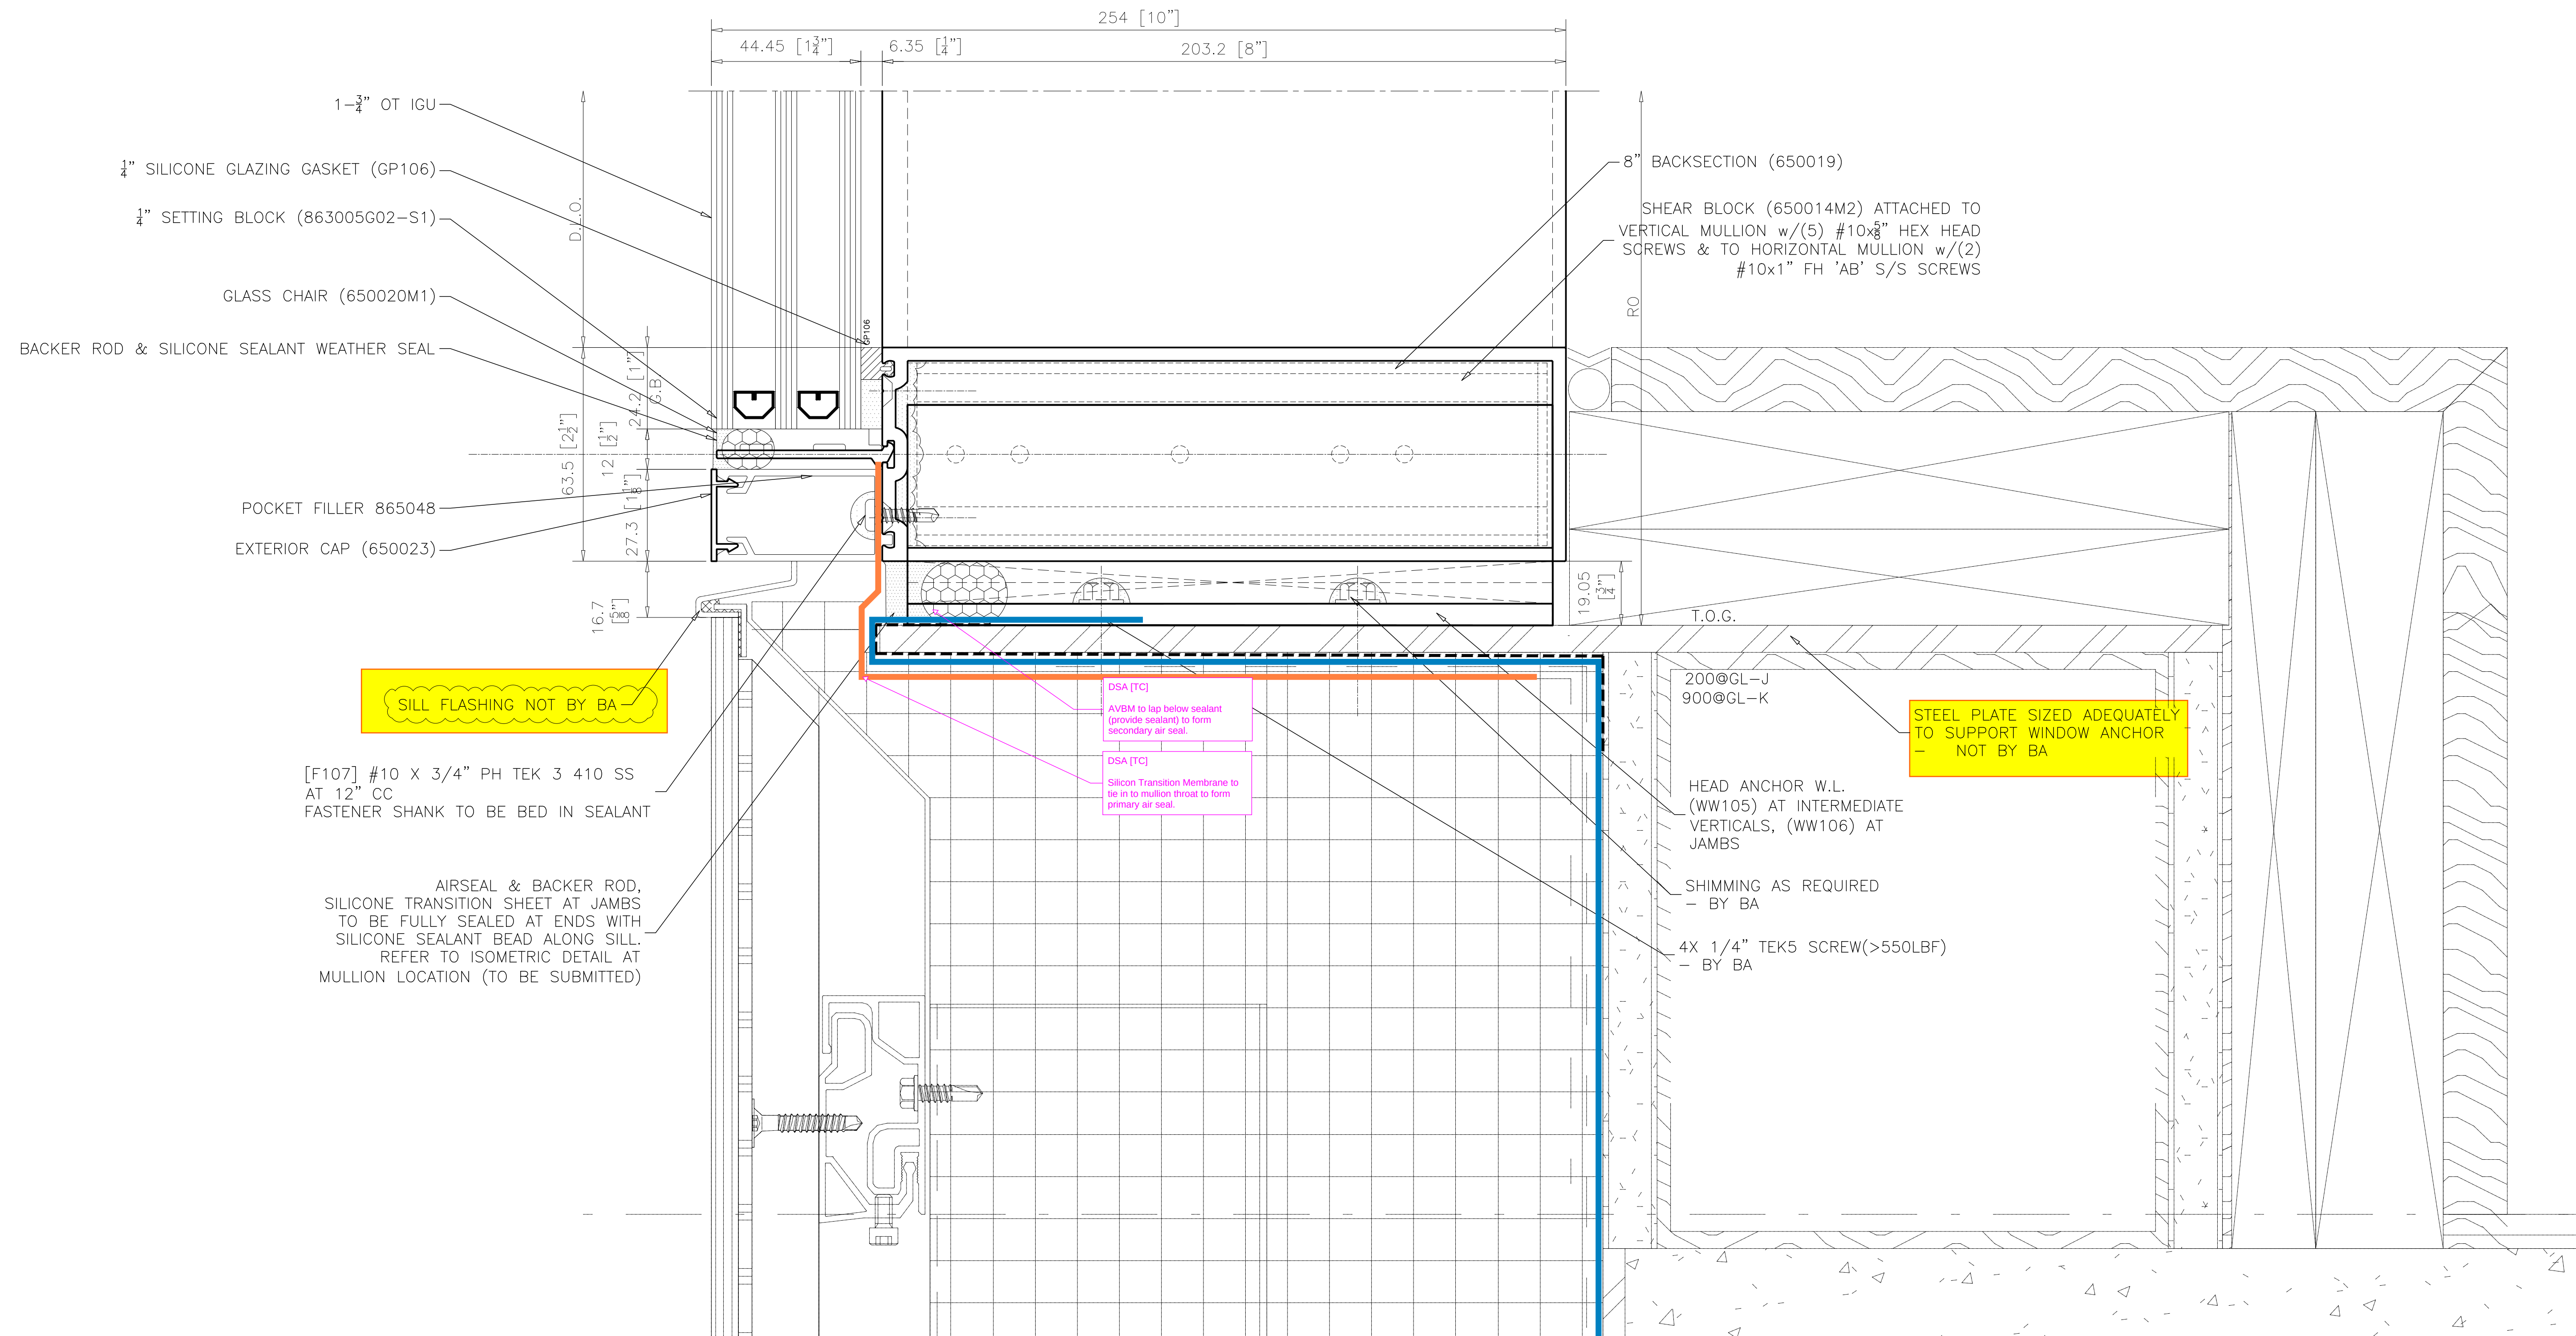

**SILL HORIZONTAL SSG 8" B.S.
AT VISION GLAZING GL1A**

1
C5-015

ARCH. REF.: 5/A451

REVISIONS

No.	Description:	Date:	By:
1	Revised per arch. markups received Feb 11/26	03/03/26	SLR

Project Name:
DOCKSTEADER PRPS

Project Location:
BRAMPTON, ONTARIO

Architect Name:
DIAMOND SCHMITT ARCHITECTS

Customer Name:
BOTHWELL ACCURATE GLAZING




275 Britannia Road East • Mississauga • Ontario • Canada • L4Z2E7
905-890-6970 • oldcastlebe.com

Drawing Name:

SECTION DETAIL

Drawn By: SR	Checked By: NP
Drawn Date: 2026/01/12	Issue No.: 1
Scale: 1"=1"	Release Date: 2026/03/03

Drawing Number: **C5-015**

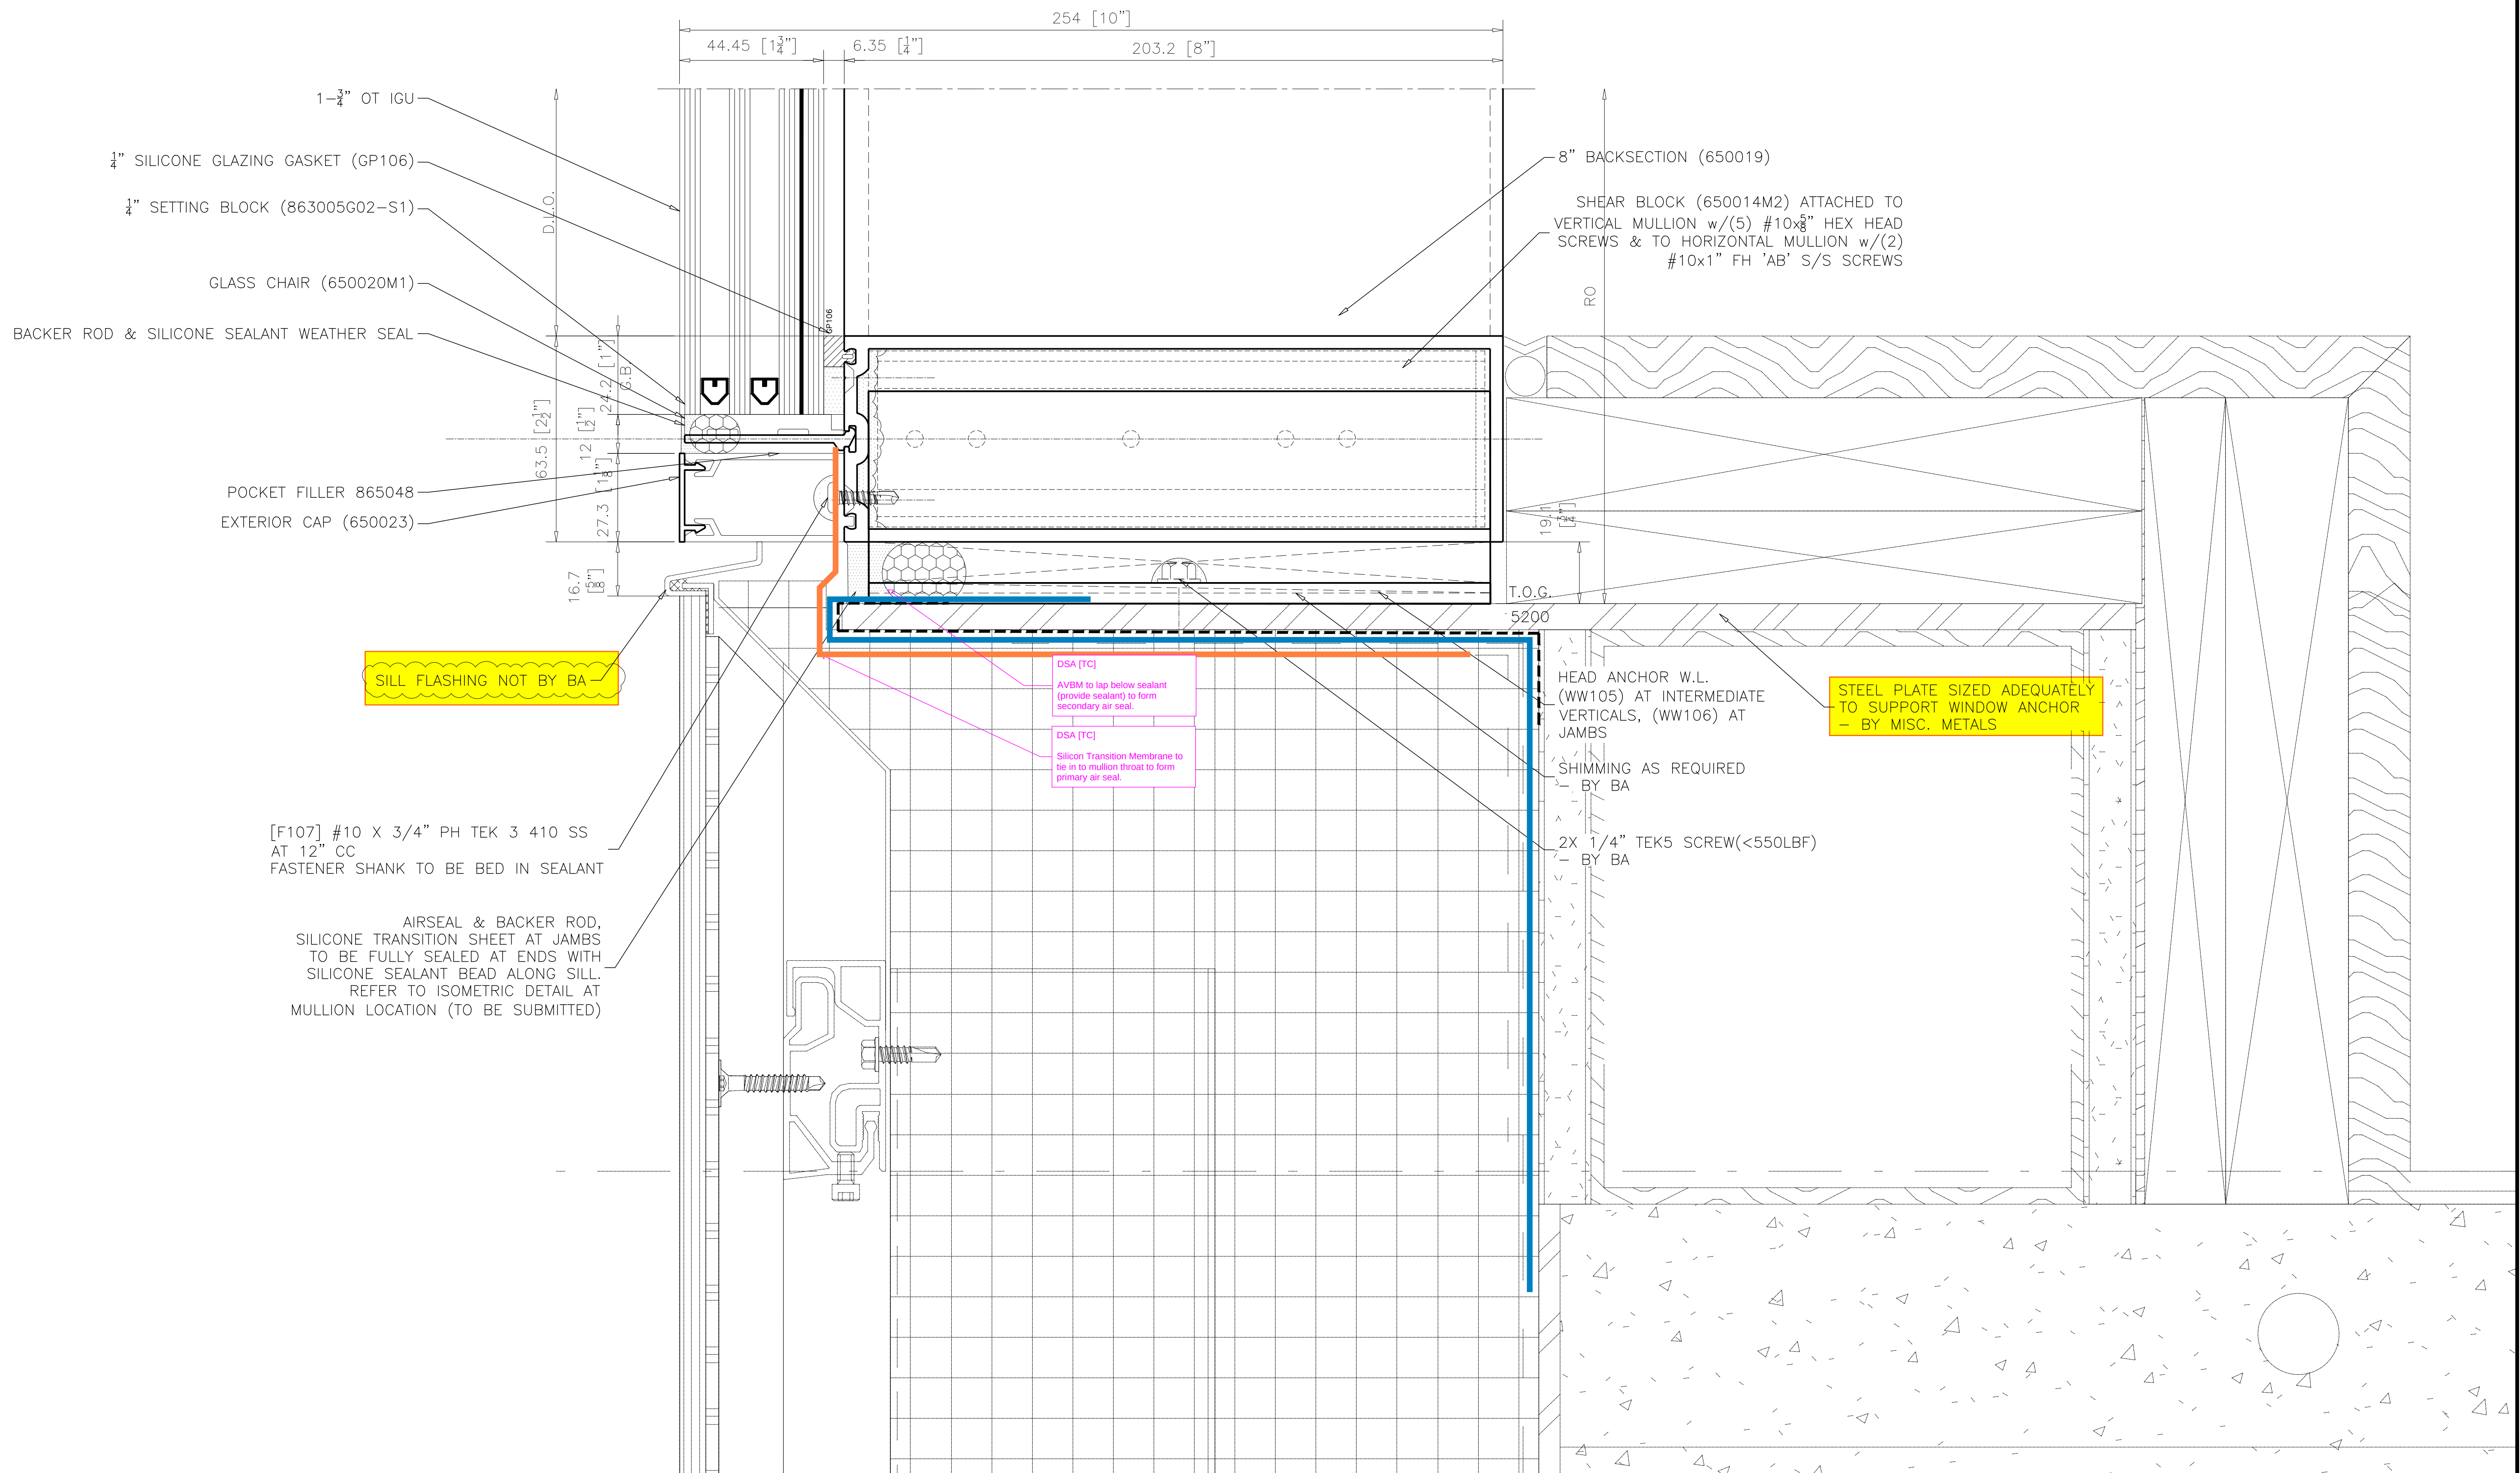

**SILL HORIZONTAL SSG 8" B.S.
AT VISION GLAZING GL1B**

1
C5-015A

ARCH. REF.: 5/A451


REVISIONS			
No.	Description:	Date:	By:
1	Revised per arch. markups received Feb 11/26	03/03/26	SLR

Project Name: DOCKSTEADER PRPS	Project Location: BRAMPTON, ONTARIO	Architect Name: DIAMOND SCHMITT ARCHITECTS	Customer Name: BOTHWELL ACCURATE GLAZING
-----------------------------------	--	---	---



275 Britannia Road East • Mississauga • Ontario • Canada • L4Z2E7
905-890-6970 • oldcastlebe.com

Drawing Name: SECTION DETAIL	
Drawn By: SR	Checked By: NP
Drawn Date: 2026/01/12	Issue No.: 1
Scale: 1"=1"	Release Date: 2026/03/03
Drawing Number: C5-015A	

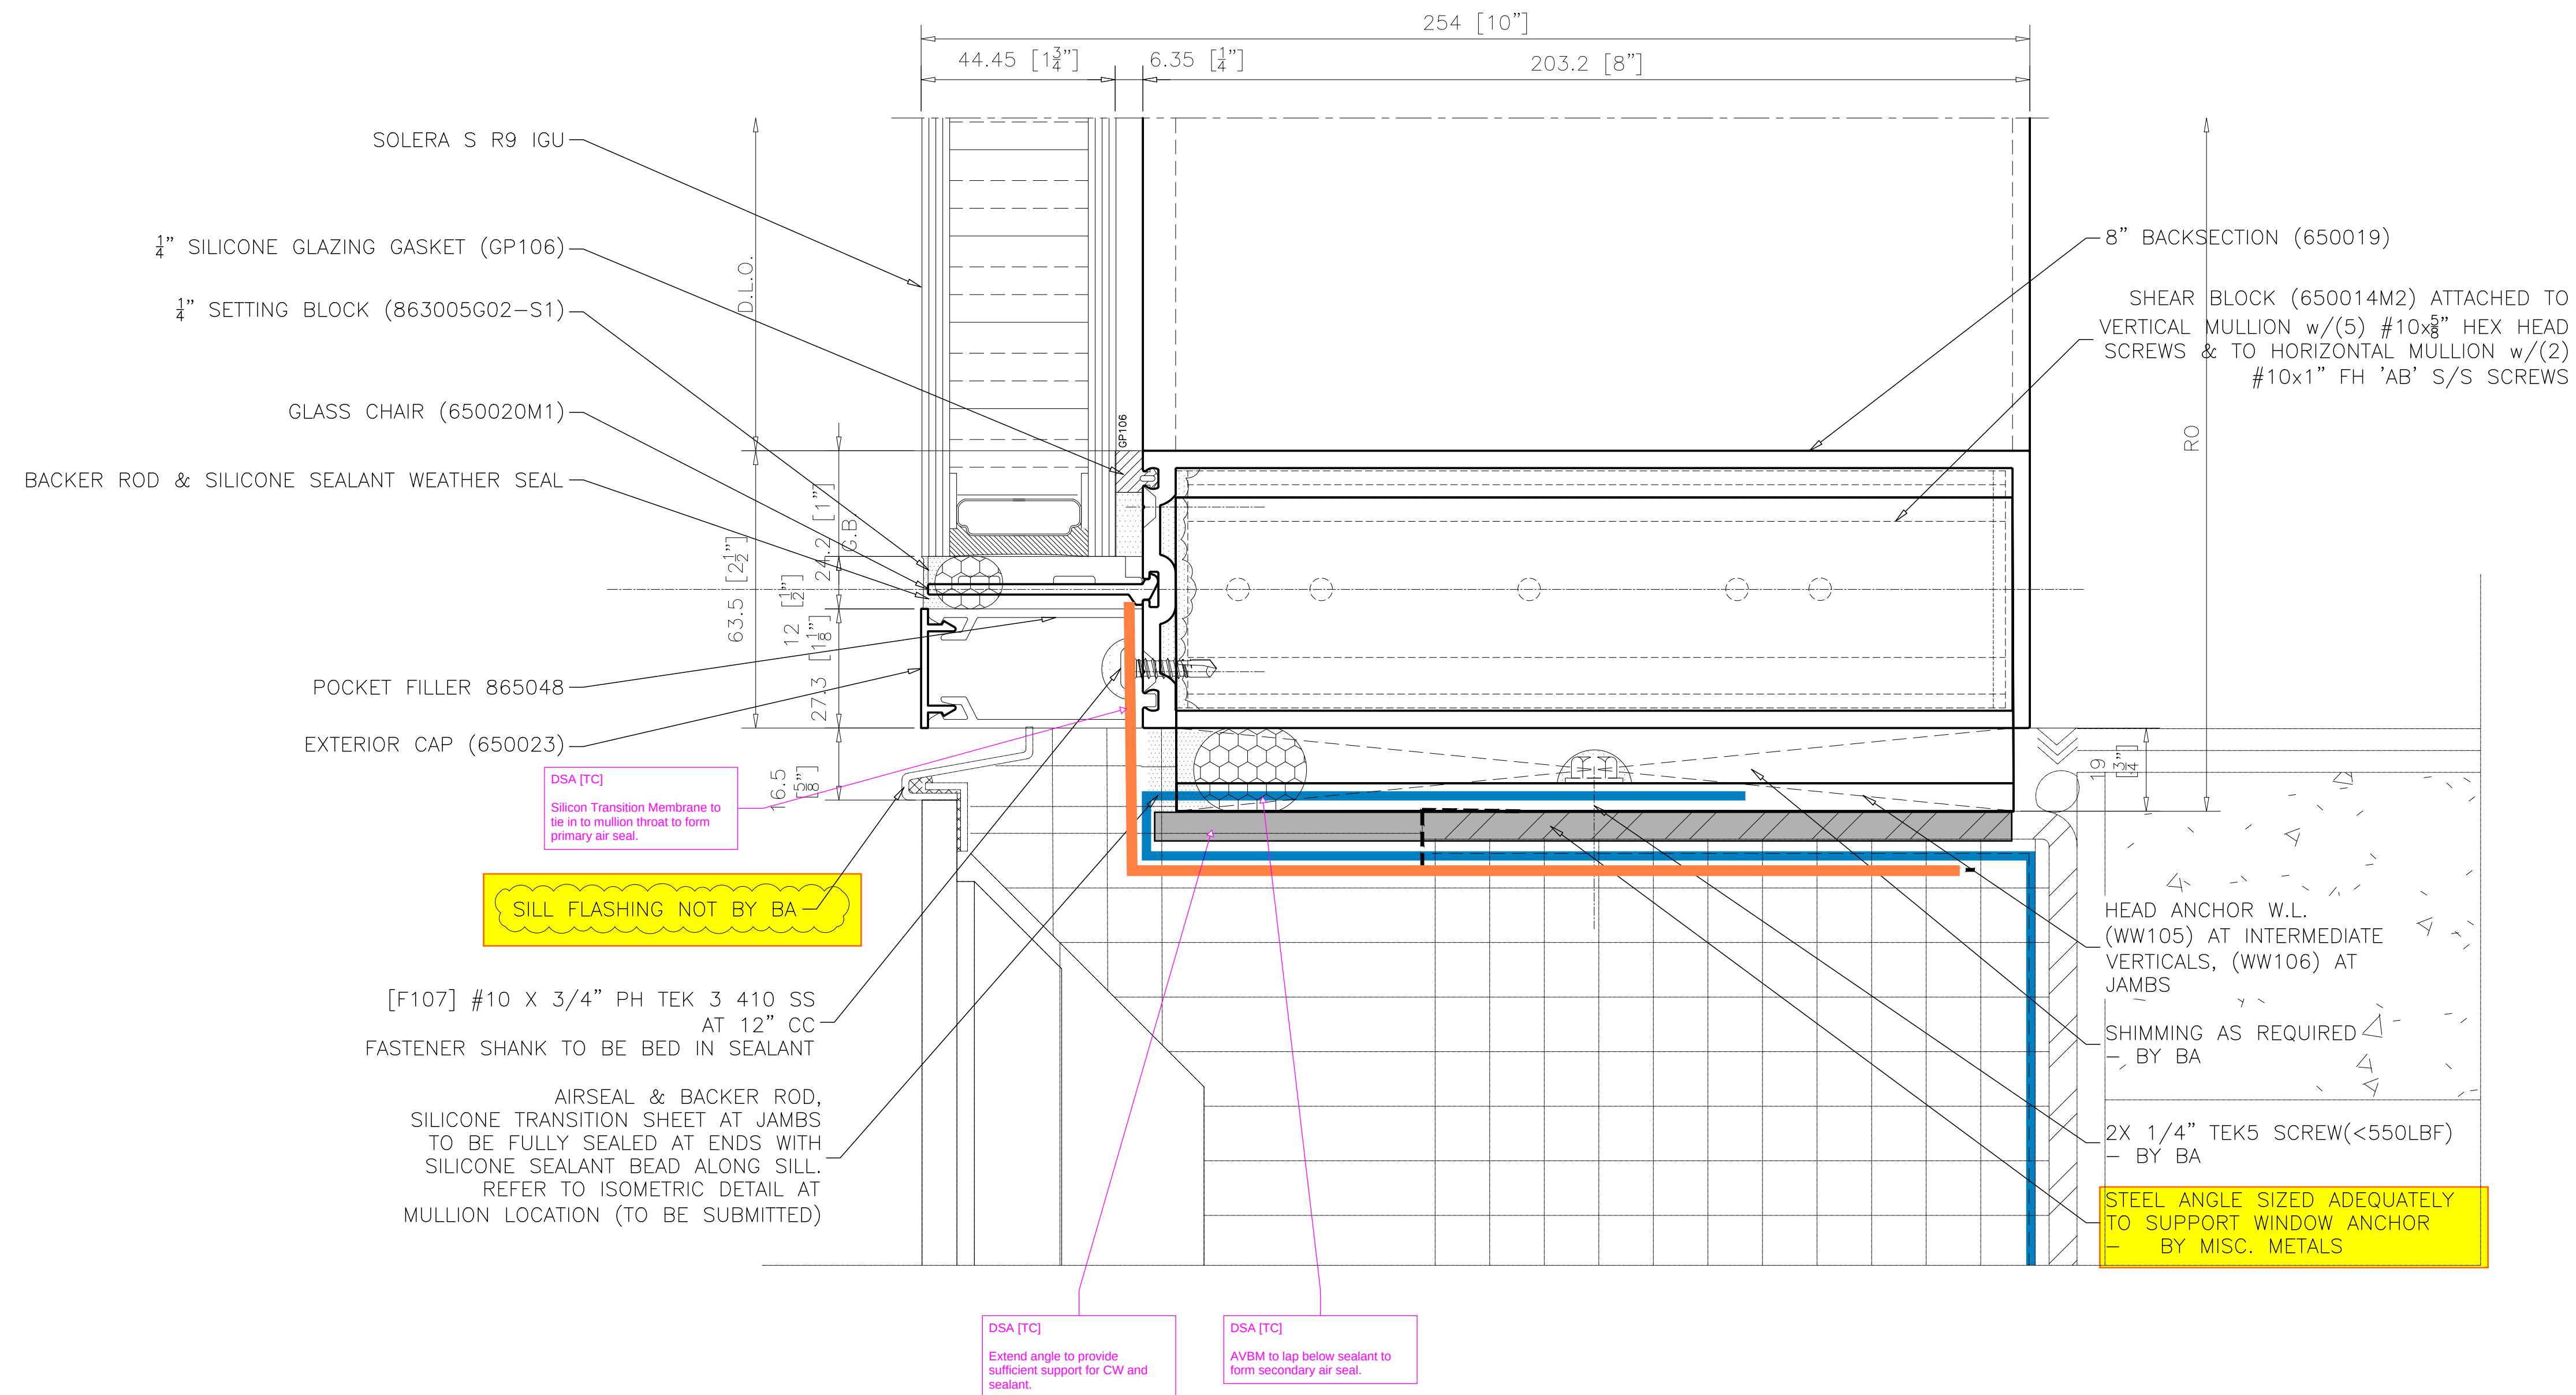

**SILL HORIZONTAL SSG 8" B.S.
AT SOLERA GLAZING**

1
C5-015B ARCH. REF.: 2/A453

REVISIONS

No.	Description:	Date:	By:
1	Revised per arch. markups received Feb 11/26	03/03/26	SLR

Project Name:
DOCKSTEADER PRPS

Project Location:
BRAMPTON, ONTARIO

Architect Name:
DIAMOND SCHMITT ARCHITECTS

Customer Name:
BOTHWELL ACCURATE GLAZING




275 Britannia Road East • Mississauga • Ontario • Canada • L4Z2E7
905-890-6970 • oldcastlebe.com

Drawing Name:

SECTION DETAIL

Drawn By: SR	Checked By: NP
Drawn Date: 2026/01/12	Issue No.: 1
Scale: 1"=1"	Release Date: 2026/03/03

Drawing Number: C5-015B

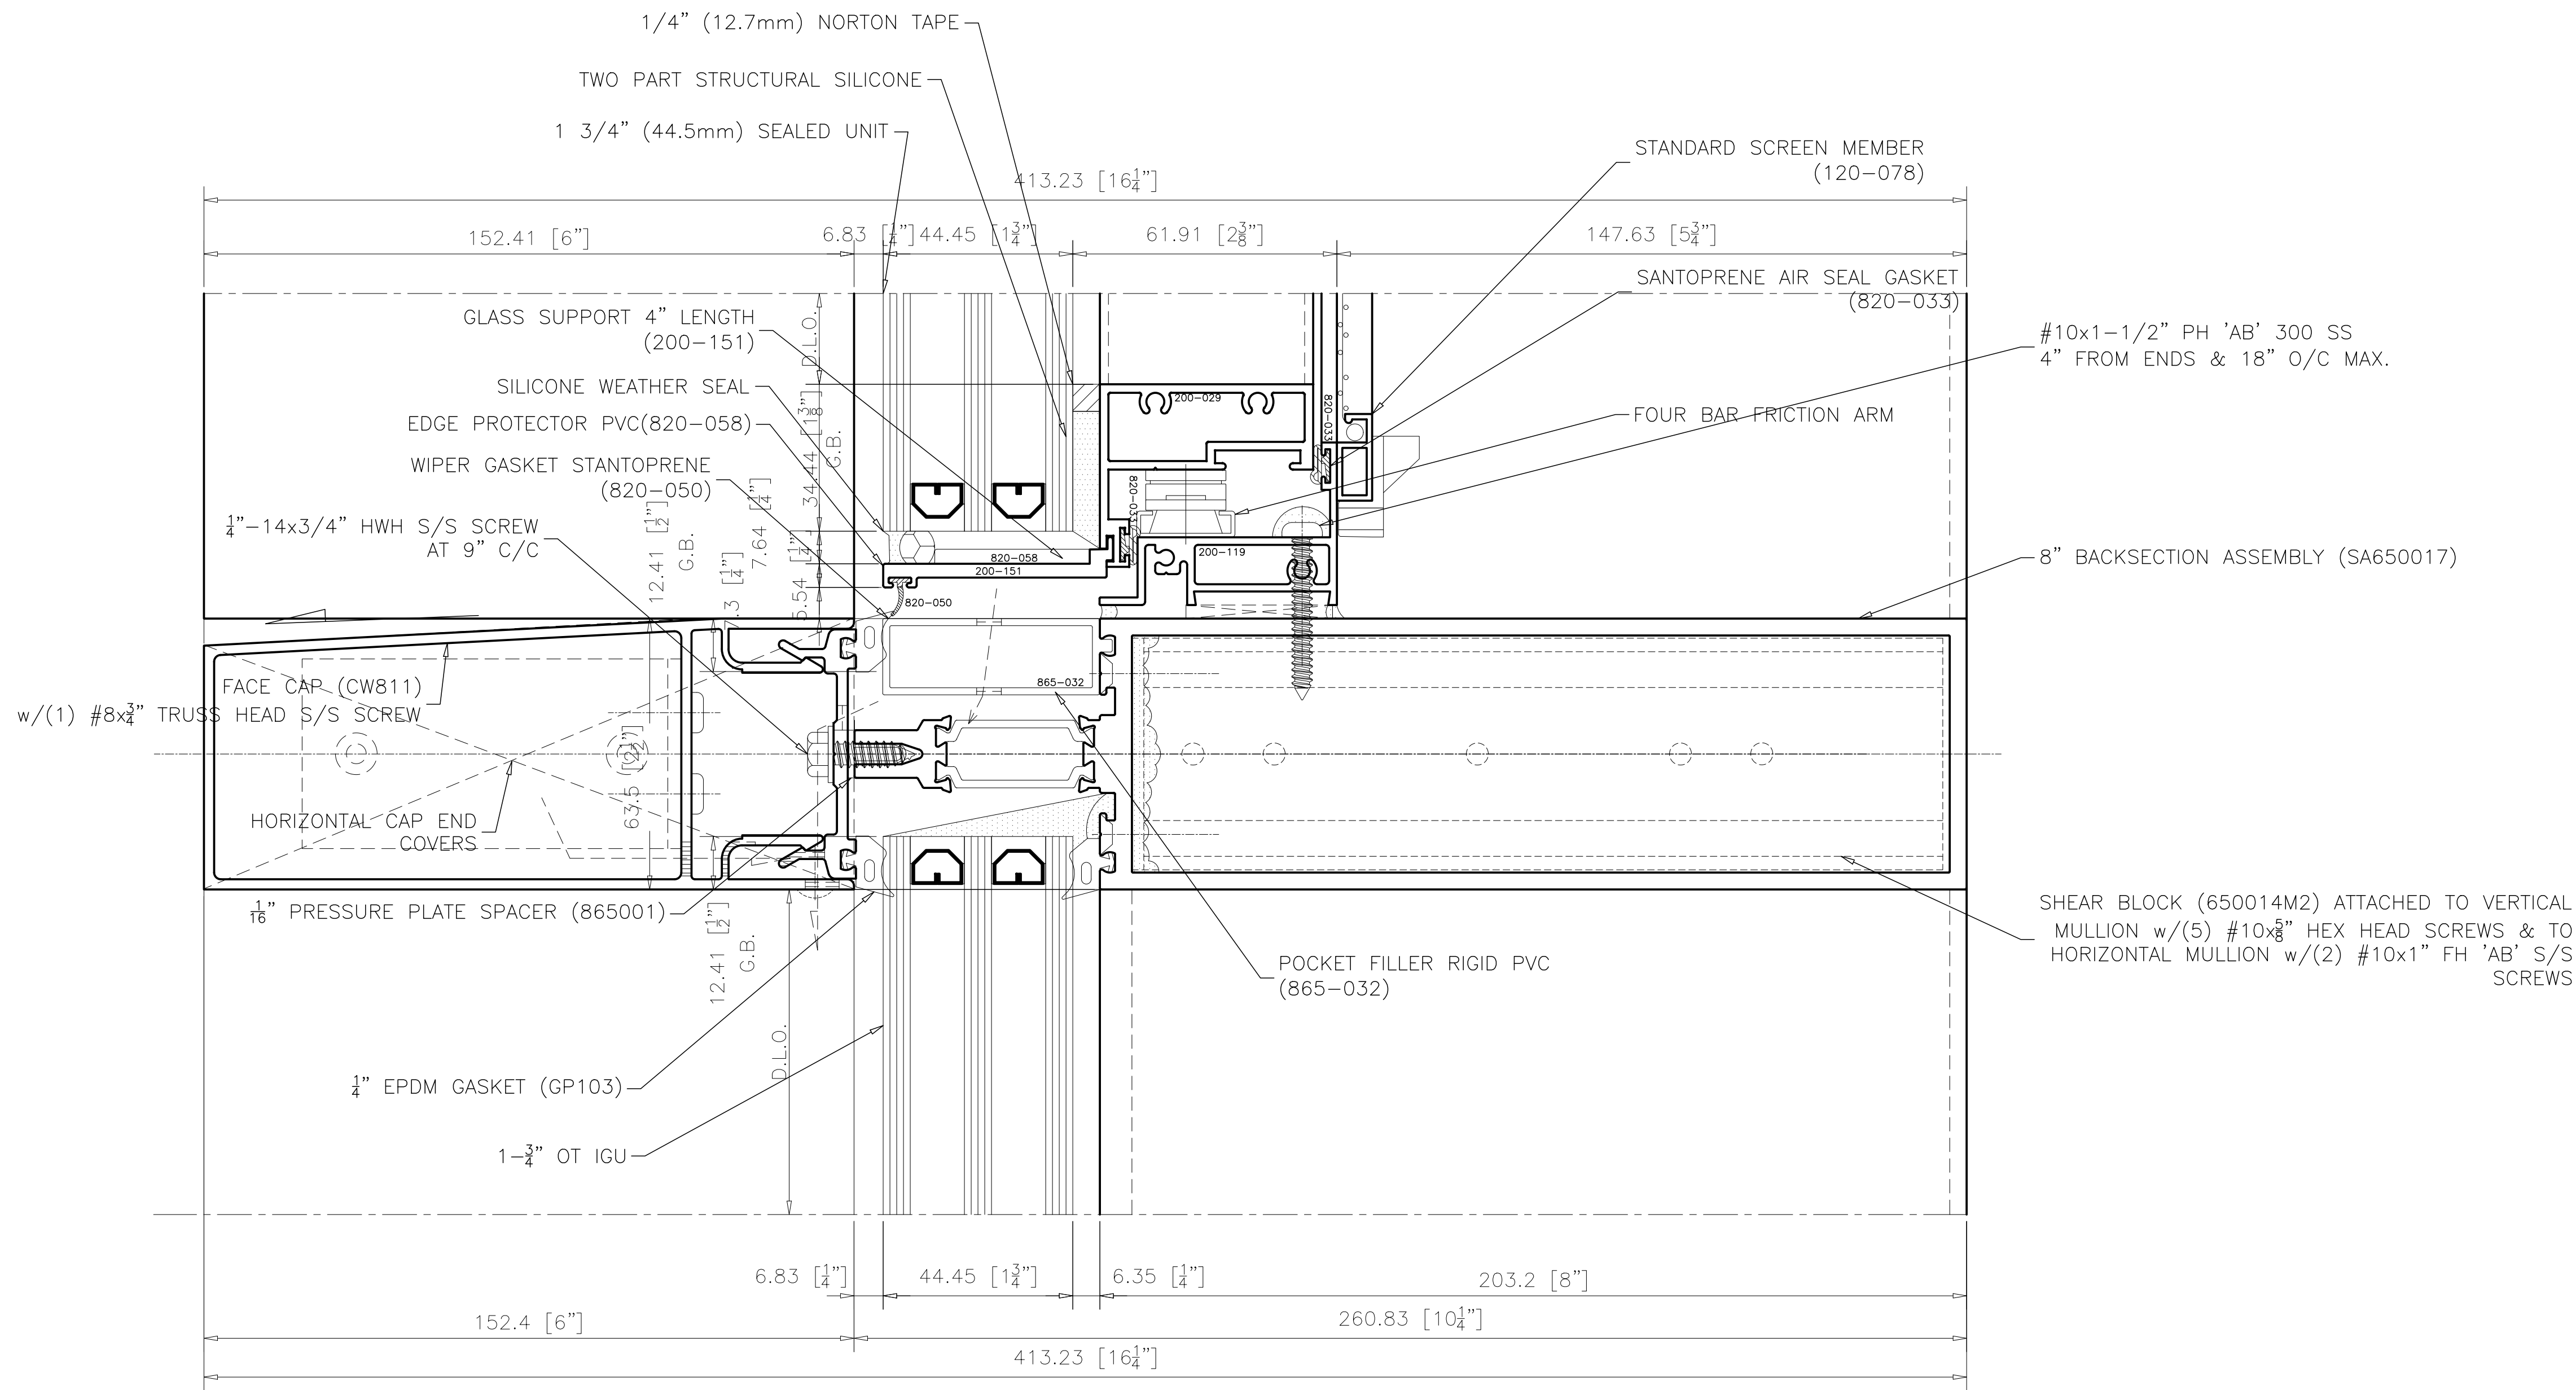

1
C5-016

INT. HORIZONTAL 6" CAP 8" B.S.
AT VENT OVER VISION GLAZING

ARCH. REF.: N/A

REVISIONS

No.	Description:	Date:	By:
1	Revised per arch. markups received Feb 11/26	03/03/26	SLR

Project Name:
DOCKSTEADER PRPS

Project Location:
BRAMPTON, ONTARIO

Architect Name:
DIAMOND SCHMITT ARCHITECTS

Customer Name:
BOTHWELL ACCURATE GLAZING




275 Britannia Road East • Mississauga • Ontario • Canada • L4Z2E7
905-890-6970 • oldcastlebe.com

Drawing Name:

SECTION DETAIL

Drawn By: SR	Checked By: NP
Drawn Date: 2026/01/12	Issue No.: 1
Scale: 1"=1"	Release Date: 2026/03/03

Drawing Number:
C5-016

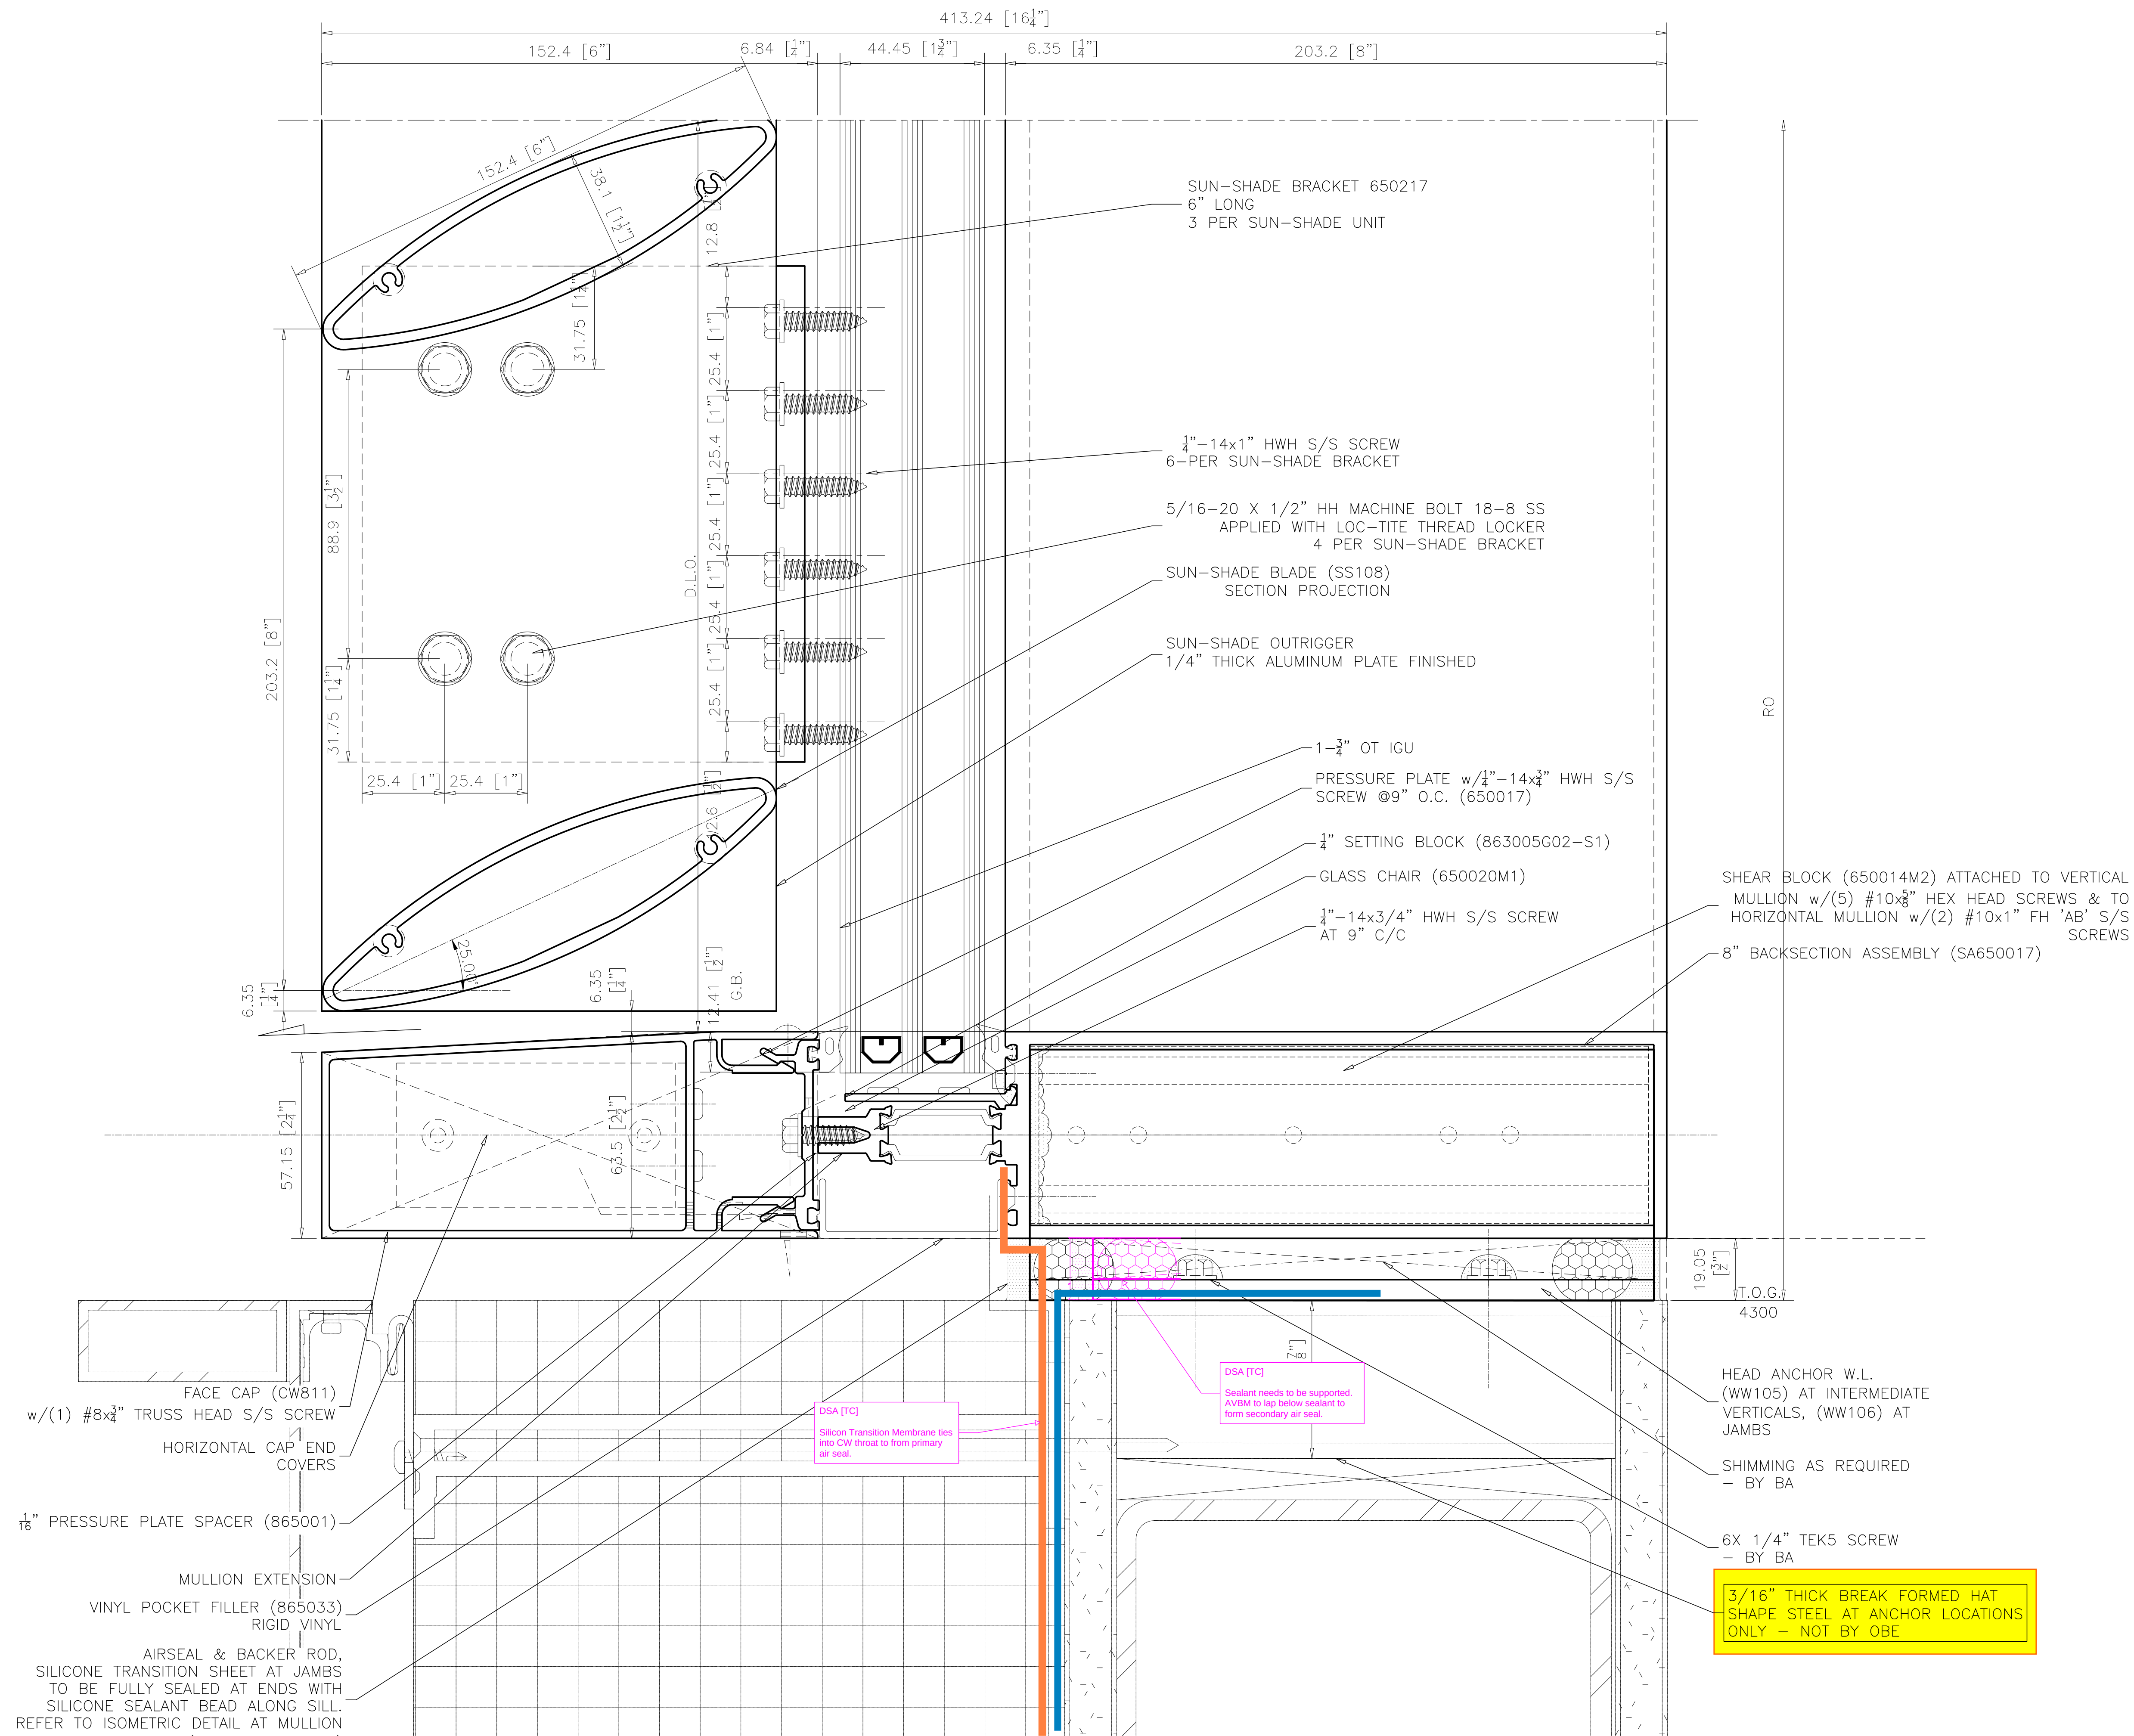

1
C5-017

**SILL HORIZONTAL 6" CAP 8" B.S.
AT VISION GLAZING**

ARCH. REF.: 2/A551

REVISIONS			
No.	Description:	Date:	By:
1	Revised per arch. markups received Feb 11/26	03/03/26	SLR

Project Name: DOCKSTEADER PRPS	Project Location: BRAMPTON, ONTARIO	Architect Name: DIAMOND SCHMITT ARCHITECTS	Customer Name: BOTHWELL ACCURATE GLAZING
-----------------------------------	--	---	---

oldcastle BuildingEnvelope®

275 Britannia Road East • Mississauga • Ontario • Canada • L4Z2E7
905-890-6970 • oldcastlebe.com

Drawing Name: SECTION DETAIL	
Drawn By: SR	Checked By: NP
Drawn Date: 2026/01/12	Issue No.: 1
Scale: 1"=1"	Release Date: 2026/03/03
Drawing Number: C5-017	