


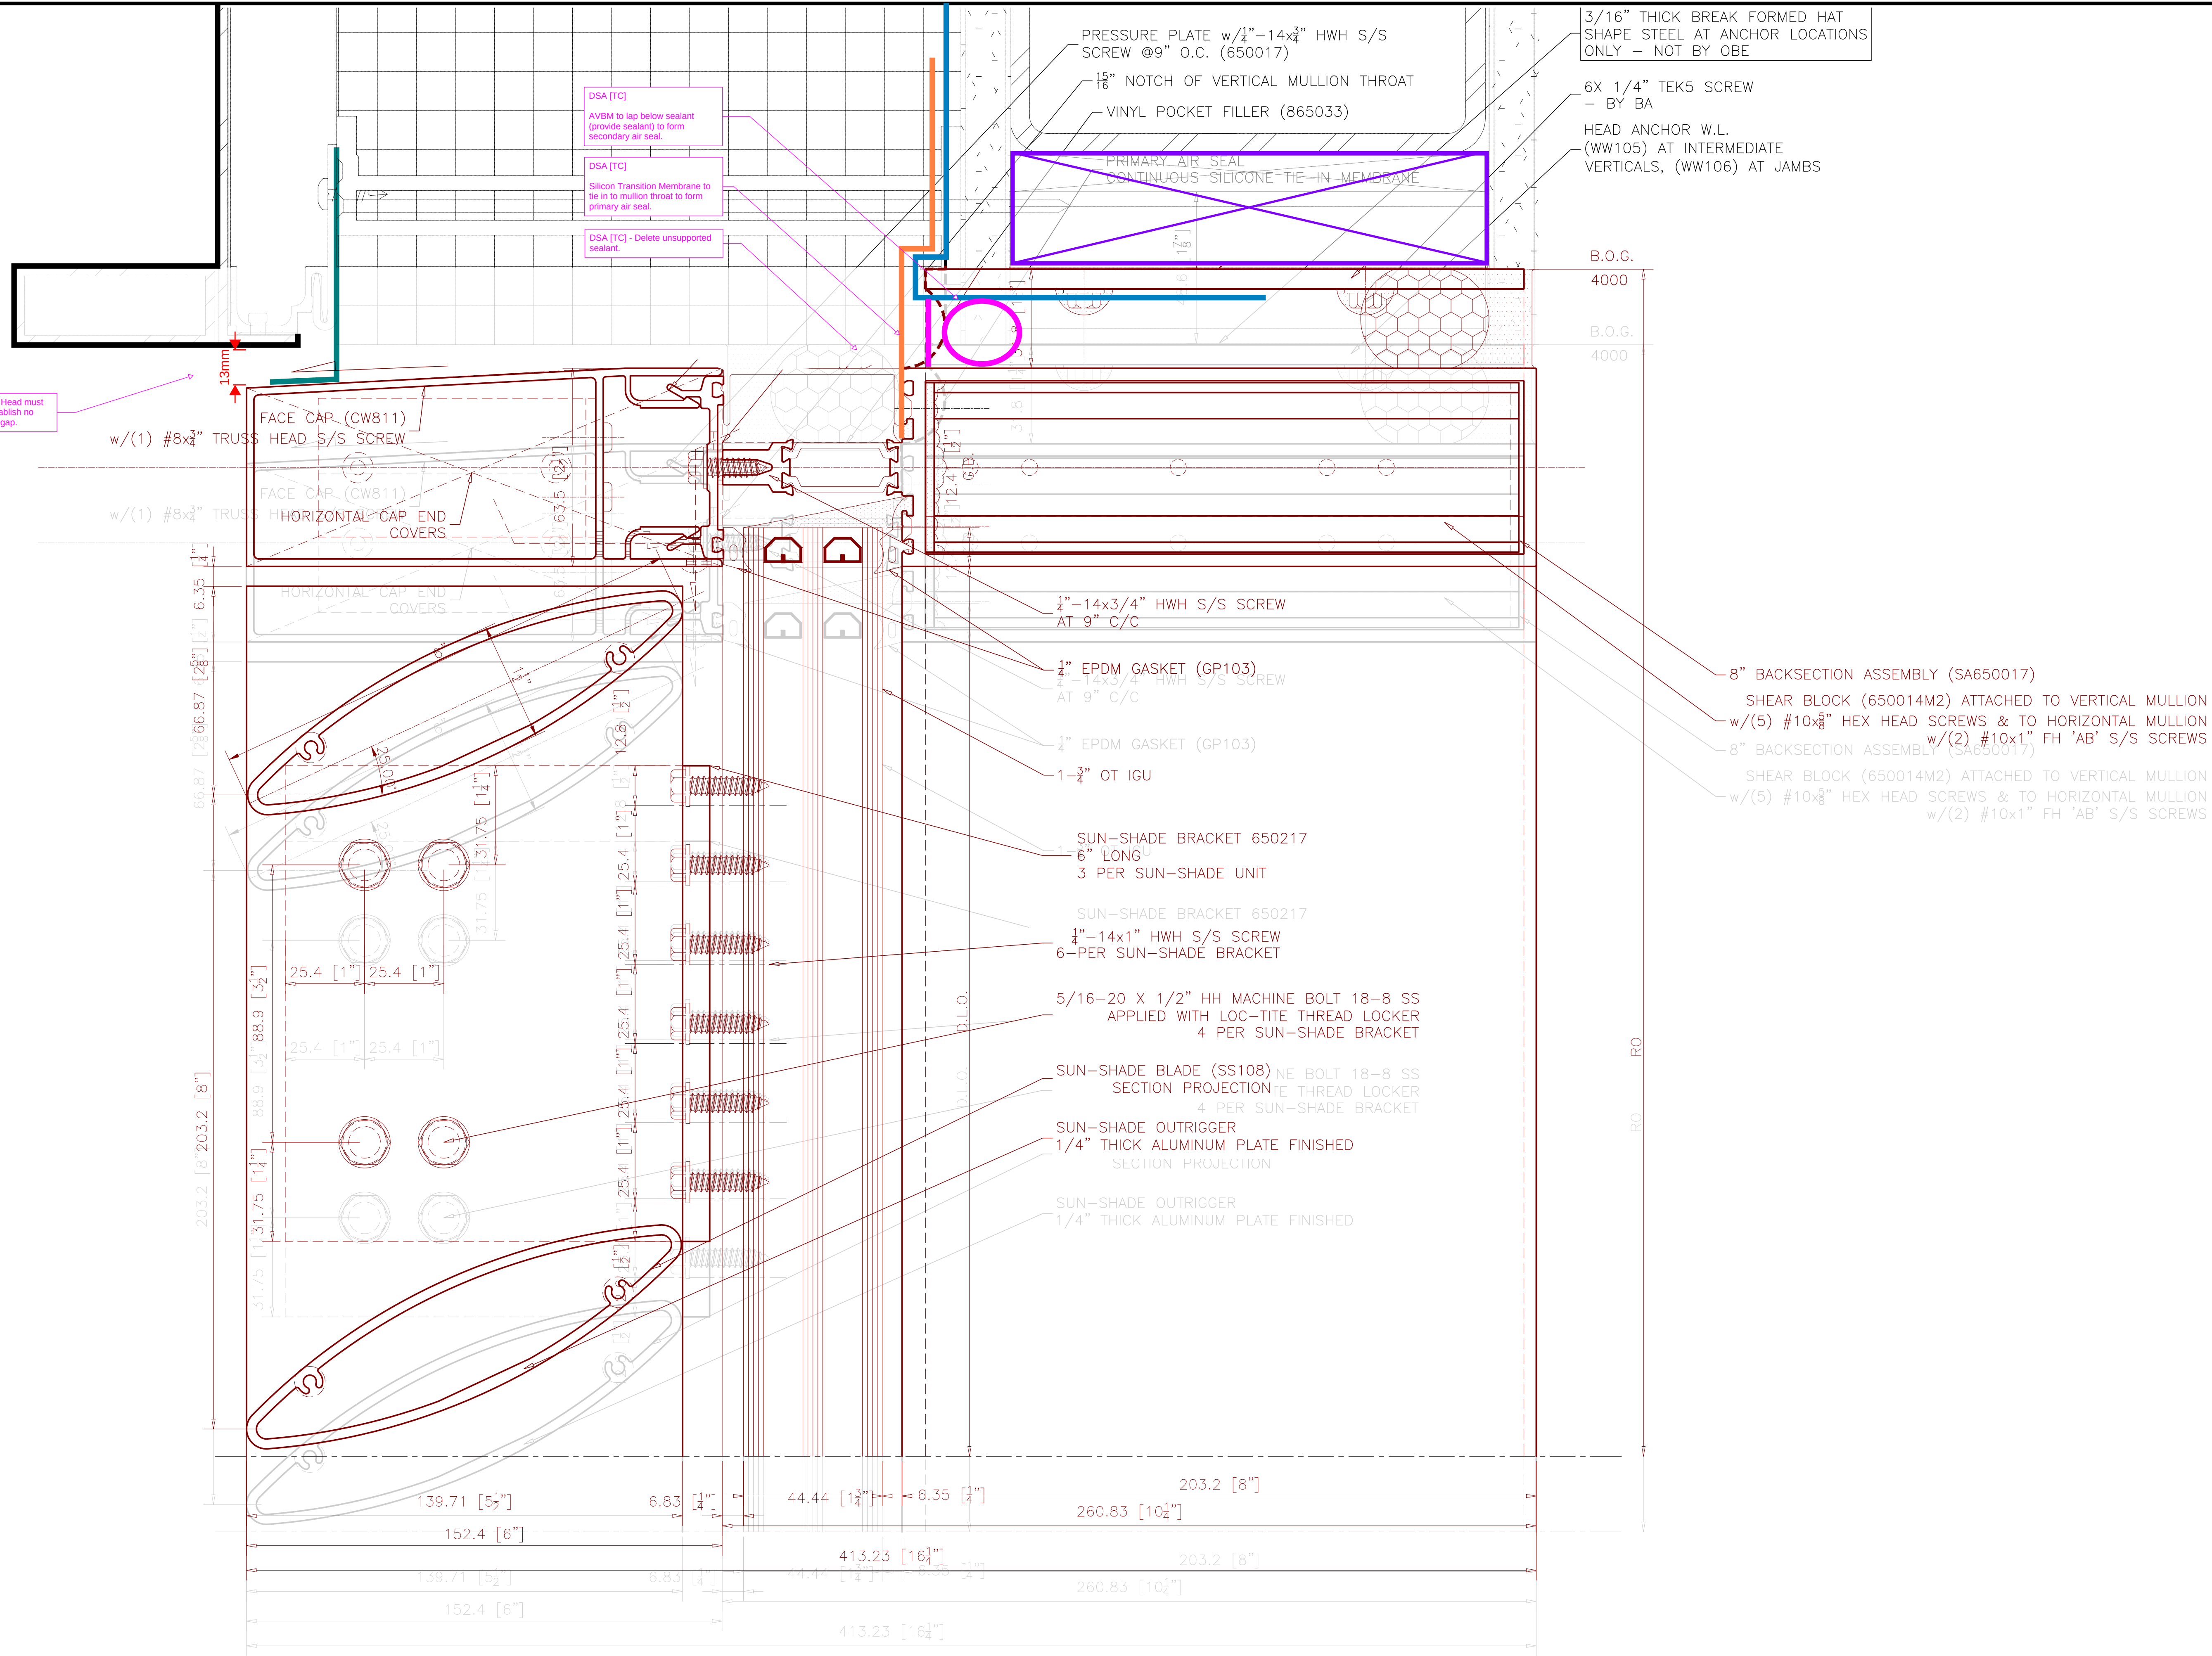

1
C5-018

**HEAD HORIZONTAL 6" CAP 8" B.S.
AT VISION GLAZING**

ARCH. REF.: 2/A551


REVISIONS		
No.	Description:	Date: By:
1	Revised per arch. markups received Feb 11/26	03/03/26 SLR

Project Name: DOCKSTEADER PRPS	Project Location: BRAMPTON, ONTARIO	Architect Name: DIAMOND SCHMITT ARCHITECTS	Customer Name: BOTHWELL ACCURATE GLAZING
-----------------------------------	--	---	---



275 Britannia Road East • Mississauga • Ontario • Canada • L4Z2E7
905-890-6970 • oldcastlebe.com

Drawing Name: SECTION DETAIL	
Drawn By: SR	Checked By: NP
Drawn Date: 2026/01/12	Issue No.: 1
Scale: 1"=1'	Release Date: 2026/03/03
Drawing Number: C5-018	

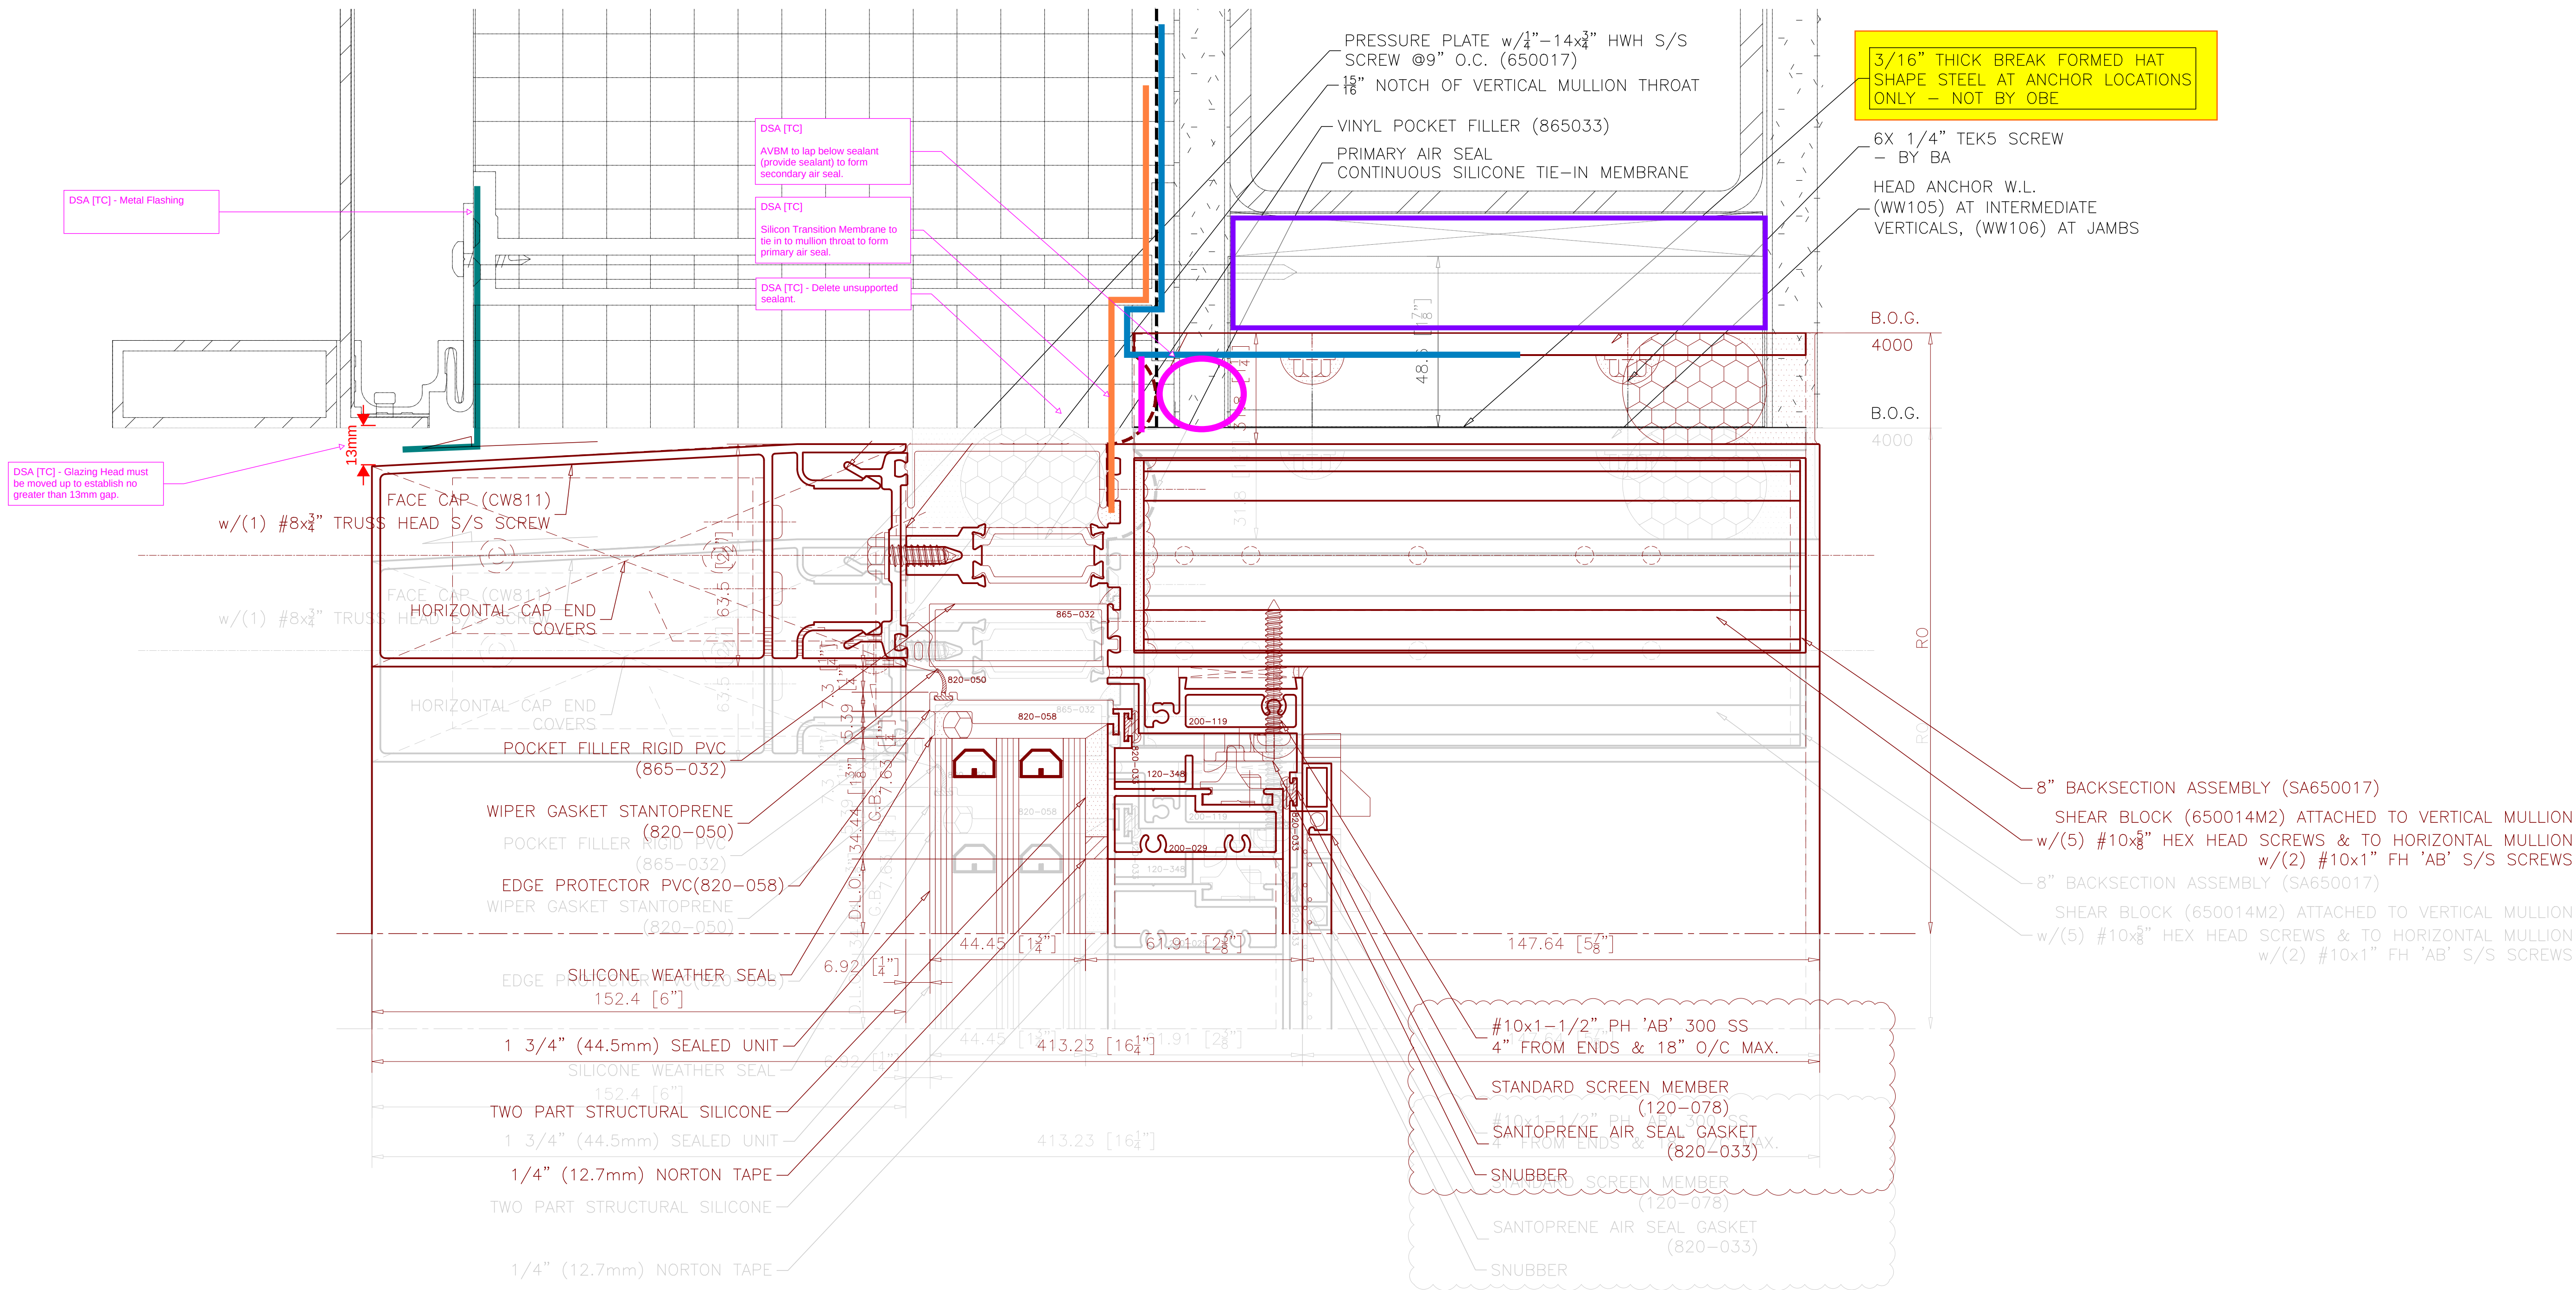

1
C5-018A

**HEAD HORIZONTAL 6" CAP 8" B.S.
AT VENT**

ARCH. REF.: 2/A551

REVISIONS

No.	Description:	Date:	By:
1	Revised per arch. markups received Feb 11/26	03/03/26	SLR

Project Name:
DOCKSTEADER PRPS

Project Location:
BRAMPTON, ONTARIO

Architect Name:
DIAMOND SCHMITT ARCHITECTS

Customer Name:
BOTHWELL ACCURATE GLAZING




275 Britannia Road East • Mississauga • Ontario • Canada • L4Z2E7
905-890-6970 • oldcastlebe.com

Drawing Name:

SECTION DETAIL

Drawn By: SR	Checked By: NP
Drawn Date: 2026/01/12	Issue No.: 1
Scale: 1"=1'	Release Date: 2026/03/03

Drawing Number:
C5-018A

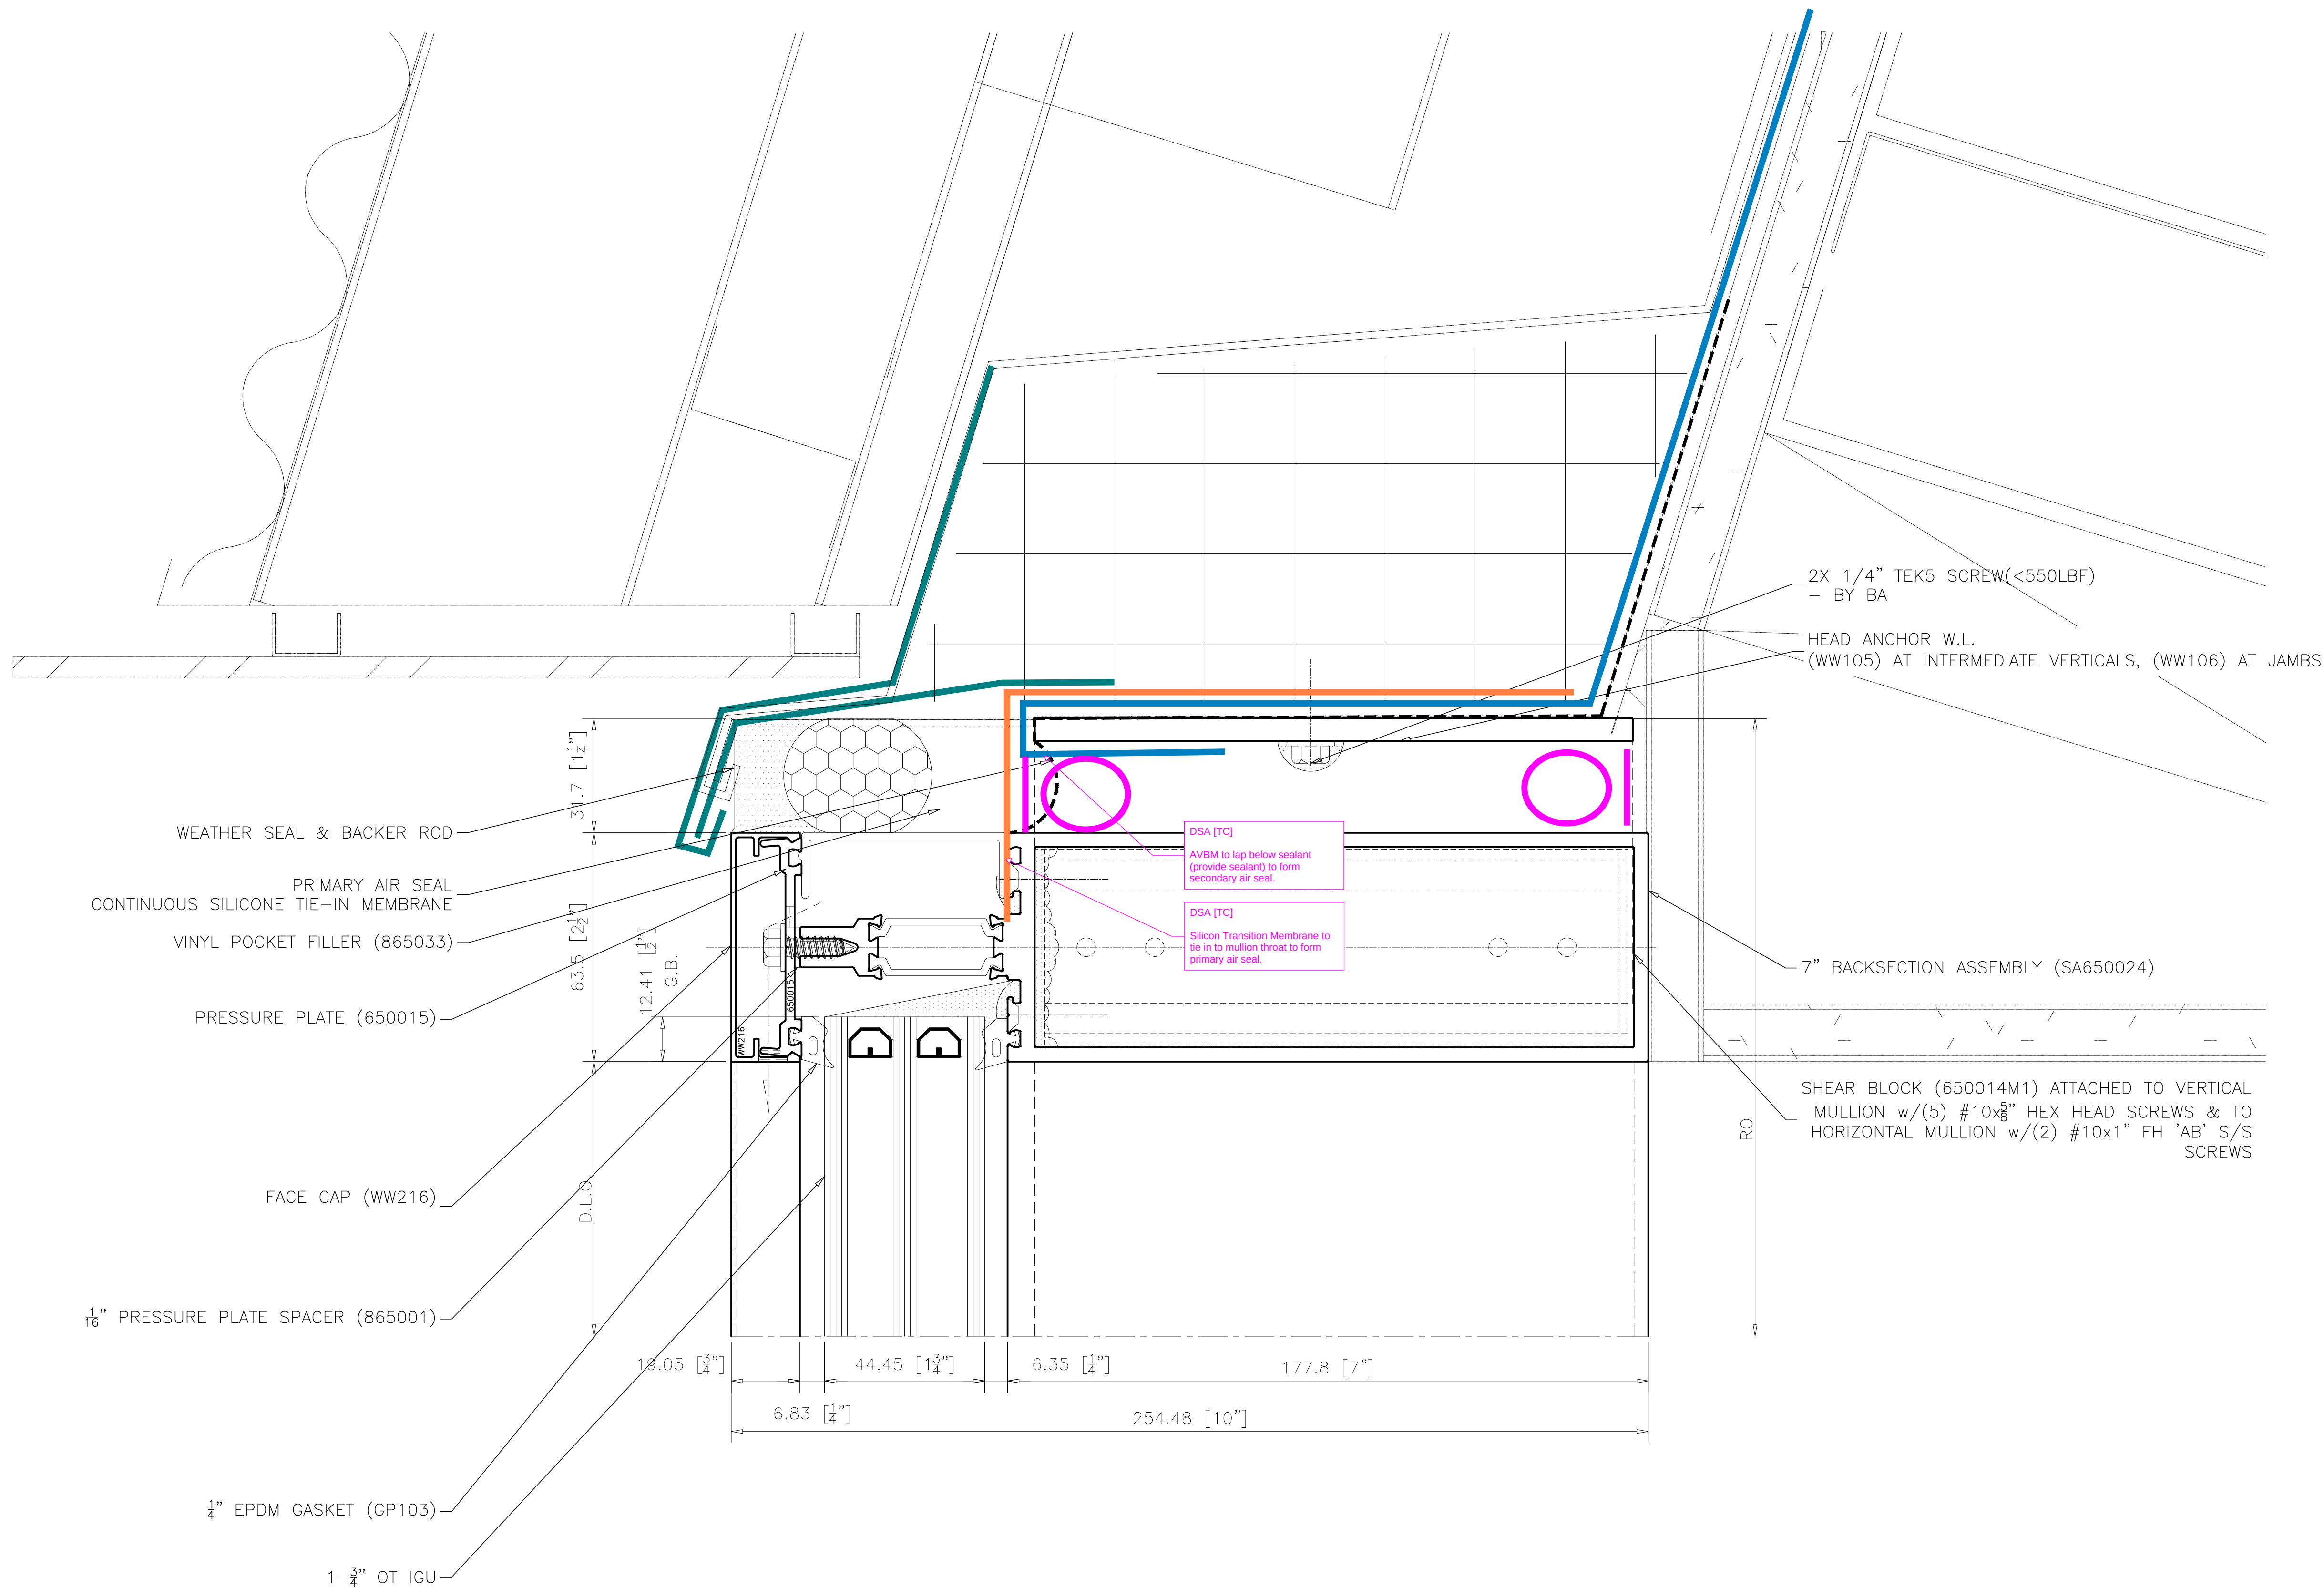

1
C5-019 HEAD HORIZONTAL 3/4" CAP 7" B.S.
AT VISION GLAZING
ARCH. REF.: 3/A553


REVISIONS			
No.	Description:	Date:	By:
1	Revised per arch. markups received Feb 11/26	03/03/26	SLR

Project Name: DOCKSTEADER PRPS	Project Location: BRAMPTON, ONTARIO	Architect Name: DIAMOND SCHMITT ARCHITECTS	Customer Name: BOTHWELL ACCURATE GLAZING
-----------------------------------	--	---	---

oldcastle BuildingEnvelope®

275 Britannia Road East • Mississauga • Ontario • Canada • L4Z2E7
905-890-6970 • oldcastlebe.com

Drawing Name: SECTION DETAIL	
Drawn By: SR	Checked By: NP
Drawn Date: 2026/01/12	Issue No.: 1
Scale: 1"=1"	Release Date: 2026/03/03
Drawing Number: C5-019	

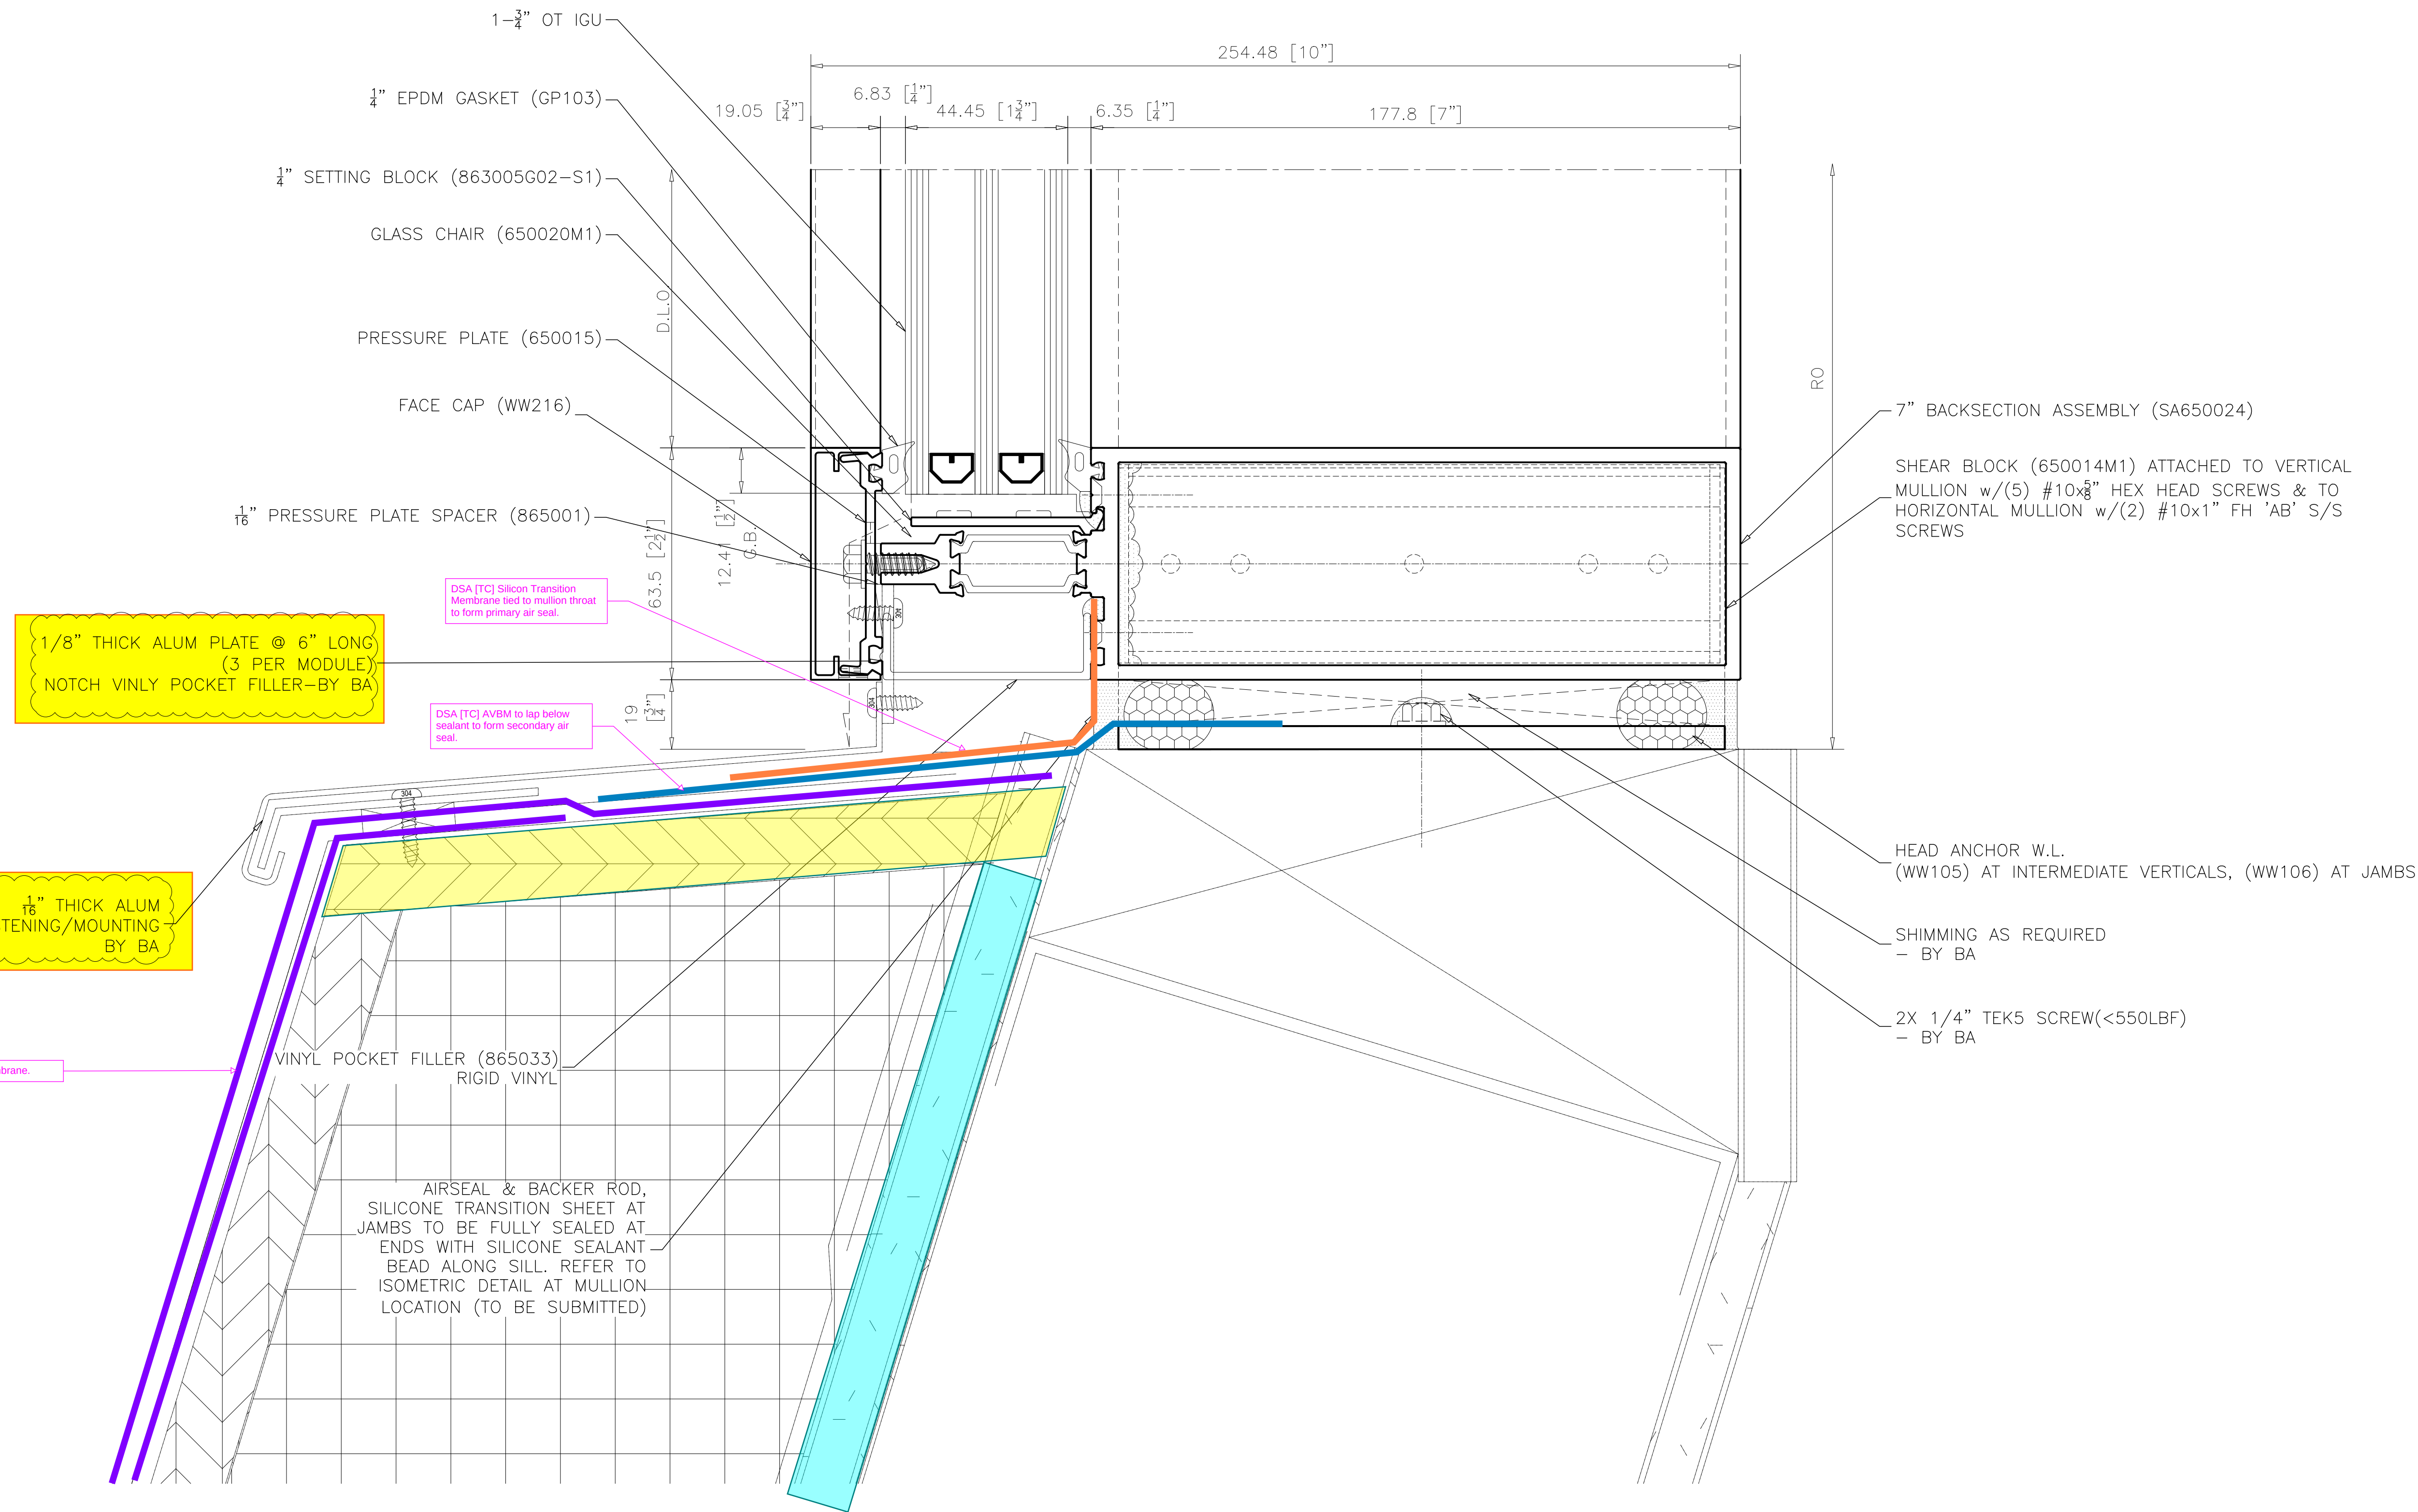

1
C5-020

**SILL HORIZONTAL 3/4" CAP 7" B.S.
AT VISION GLAZING**

ARCH. REF.: 3/A553

REVISIONS

No.	Description:	Date:	By:
1	Revised per arch. markups received Feb 11/26	03/03/26	SLR

Project Name:
DOCKSTEADER PRPS

Project Location:
BRAMPTON, ONTARIO

Architect Name:
DIAMOND SCHMITT ARCHITECTS

Customer Name:
BOTHWELL ACCURATE GLAZING




275 Britannia Road East • Mississauga • Ontario • Canada • L4Z2E7
905-890-6970 • oldcastlebe.com

Drawing Name:

SECTION DETAIL

Drawn By: SR	Checked By: NP
Drawn Date: 2026/01/12	Issue No.: 1
Scale: 1"=1"	Release Date: 2026/03/03

Drawing Number:
C5-020

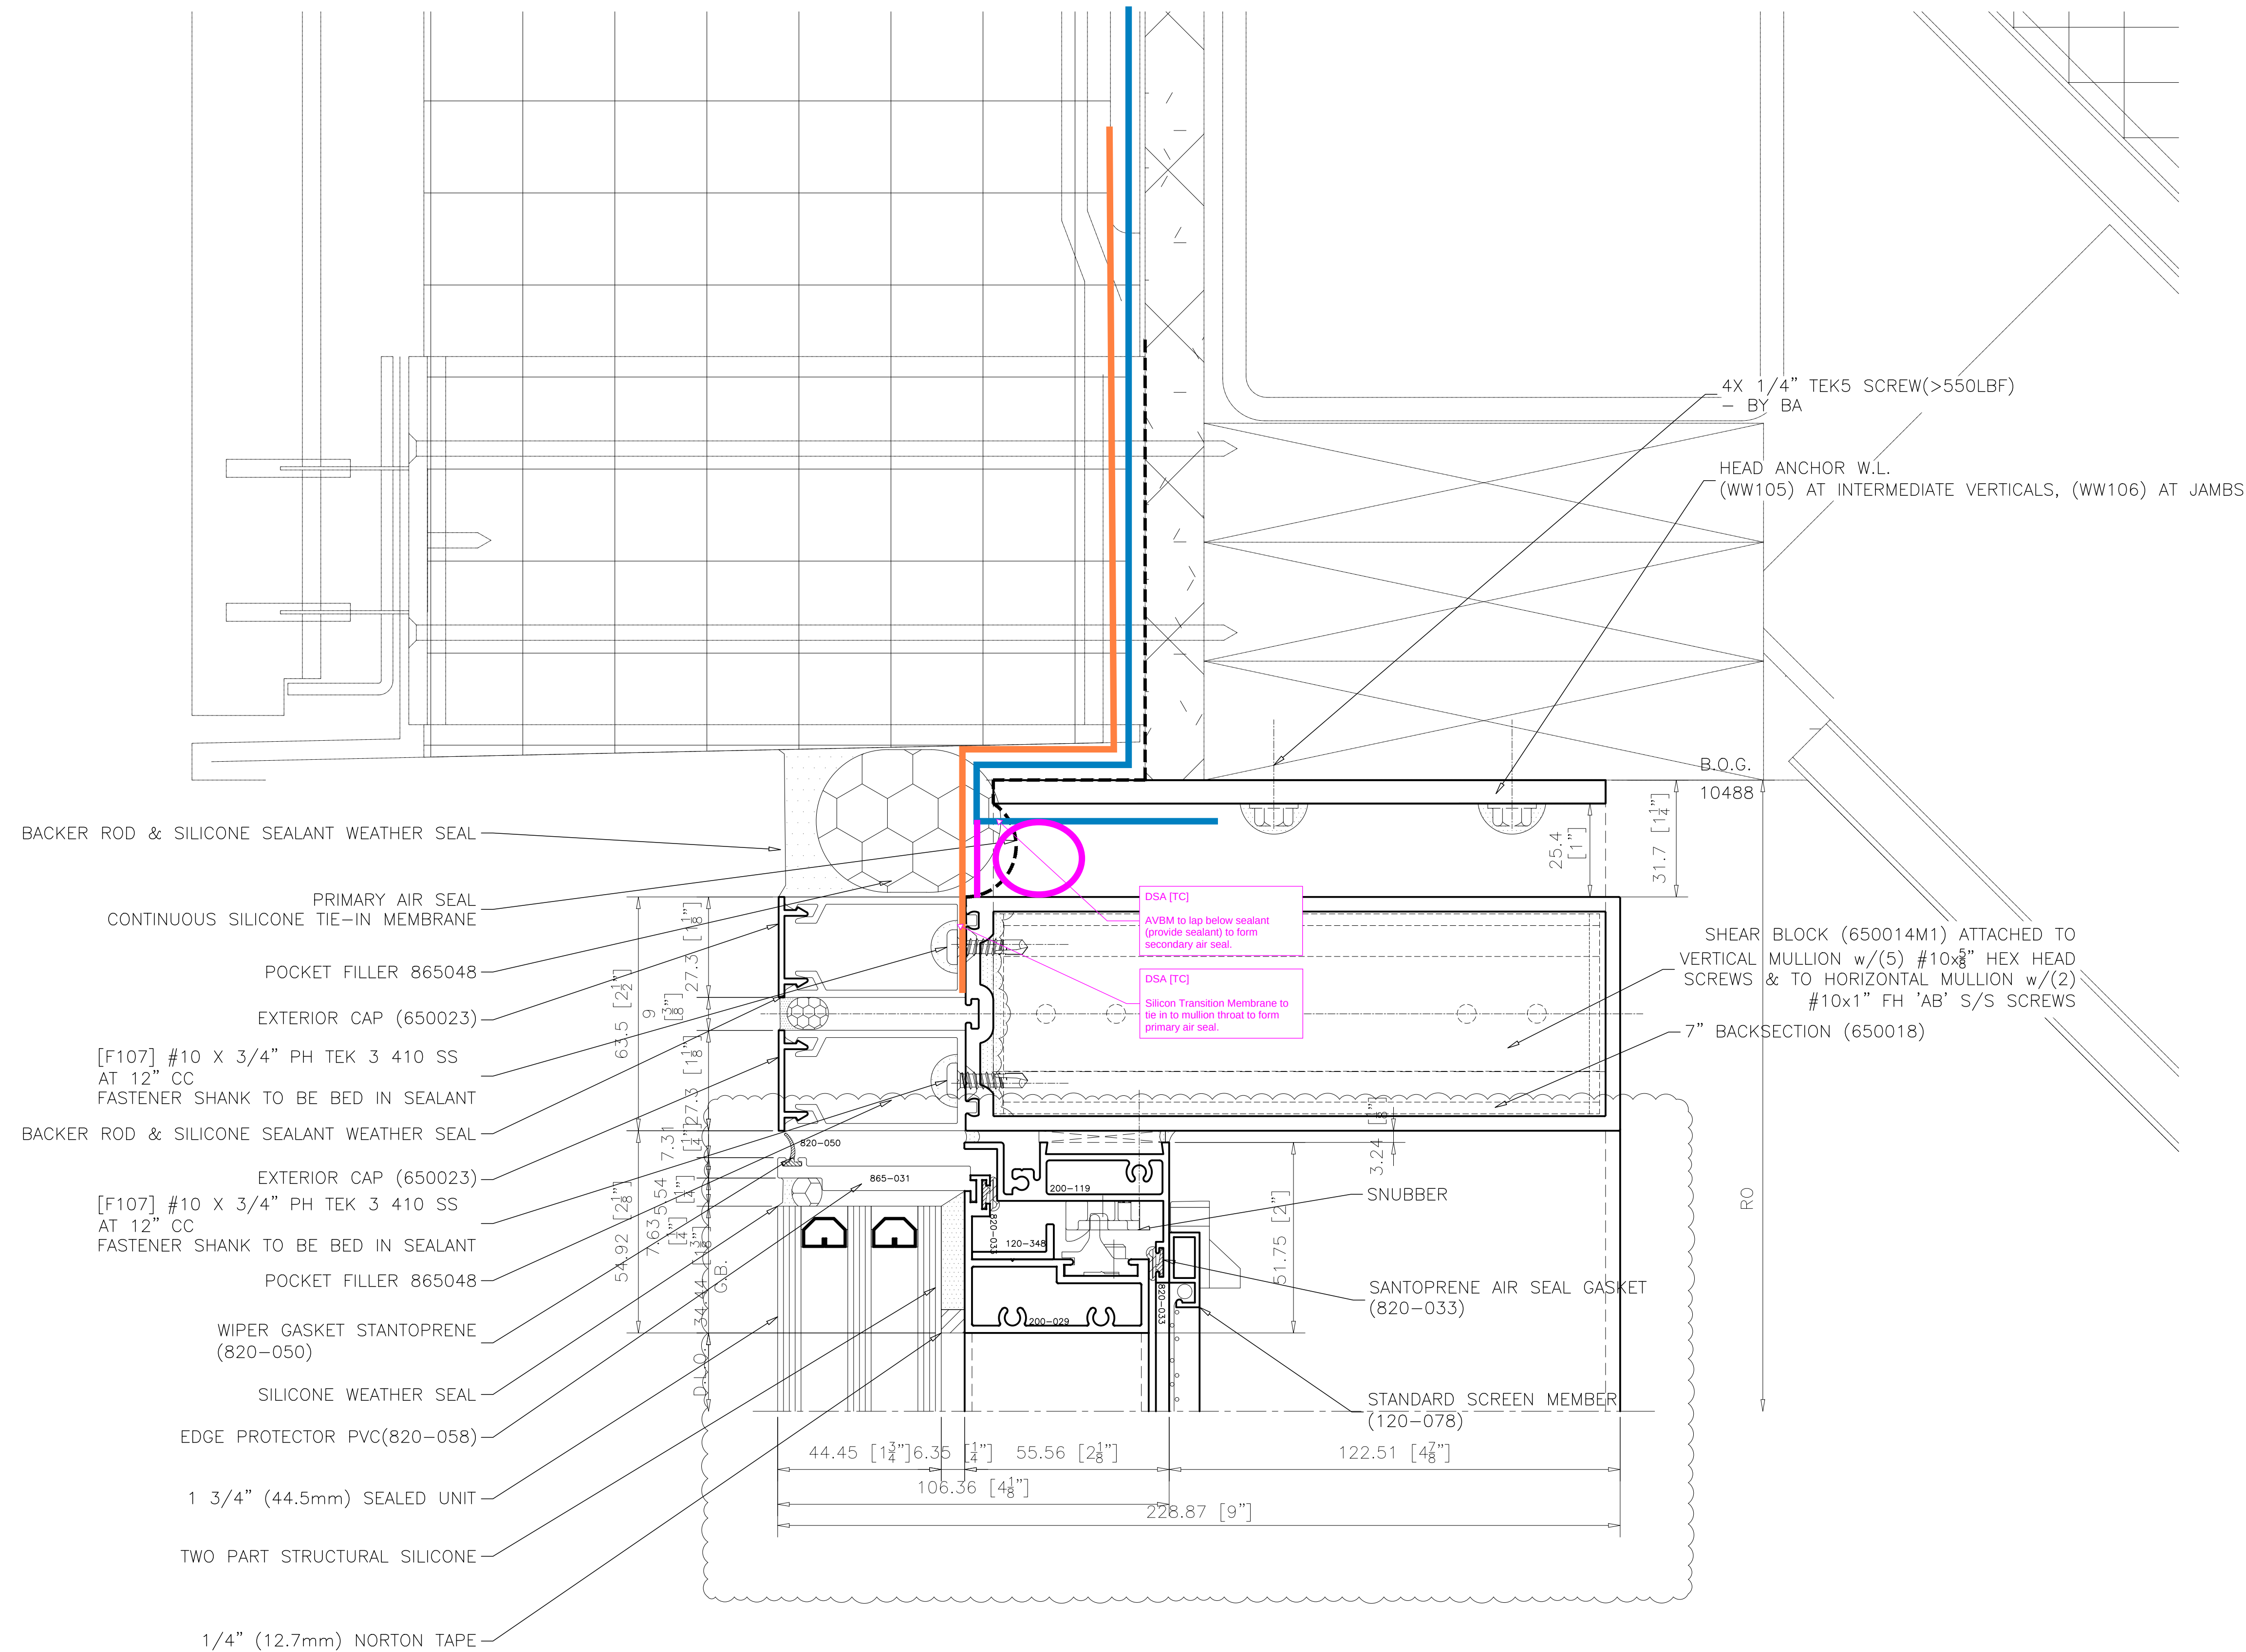

HEAD HORIZONTAL SSG 7" B.S.
AT VENT

1
C5-021

ARCH. REF.: 3/A552

REVISIONS

No.	Description:	Date:	By:
1	Revised per arch. markups received Feb 11/26	03/03/26	SLR

Project Name:
DOCKSTEADER PRPS

Project Location:
BRAMPTON, ONTARIO

Architect Name:
DIAMOND SCHMITT ARCHITECTS

Customer Name:
BOTHWELL ACCURATE GLAZING




275 Britannia Road East • Mississauga • Ontario • Canada • L4Z2E7
905-890-6970 • oldcastlebe.com

Drawing Name:

SECTION DETAIL

Drawn By: SR	Checked By: NP
Drawn Date: 2026/01/12	Issue No.: 1
Scale: 1"=1"	Release Date: 2026/03/03

Drawing Number:
C5-021

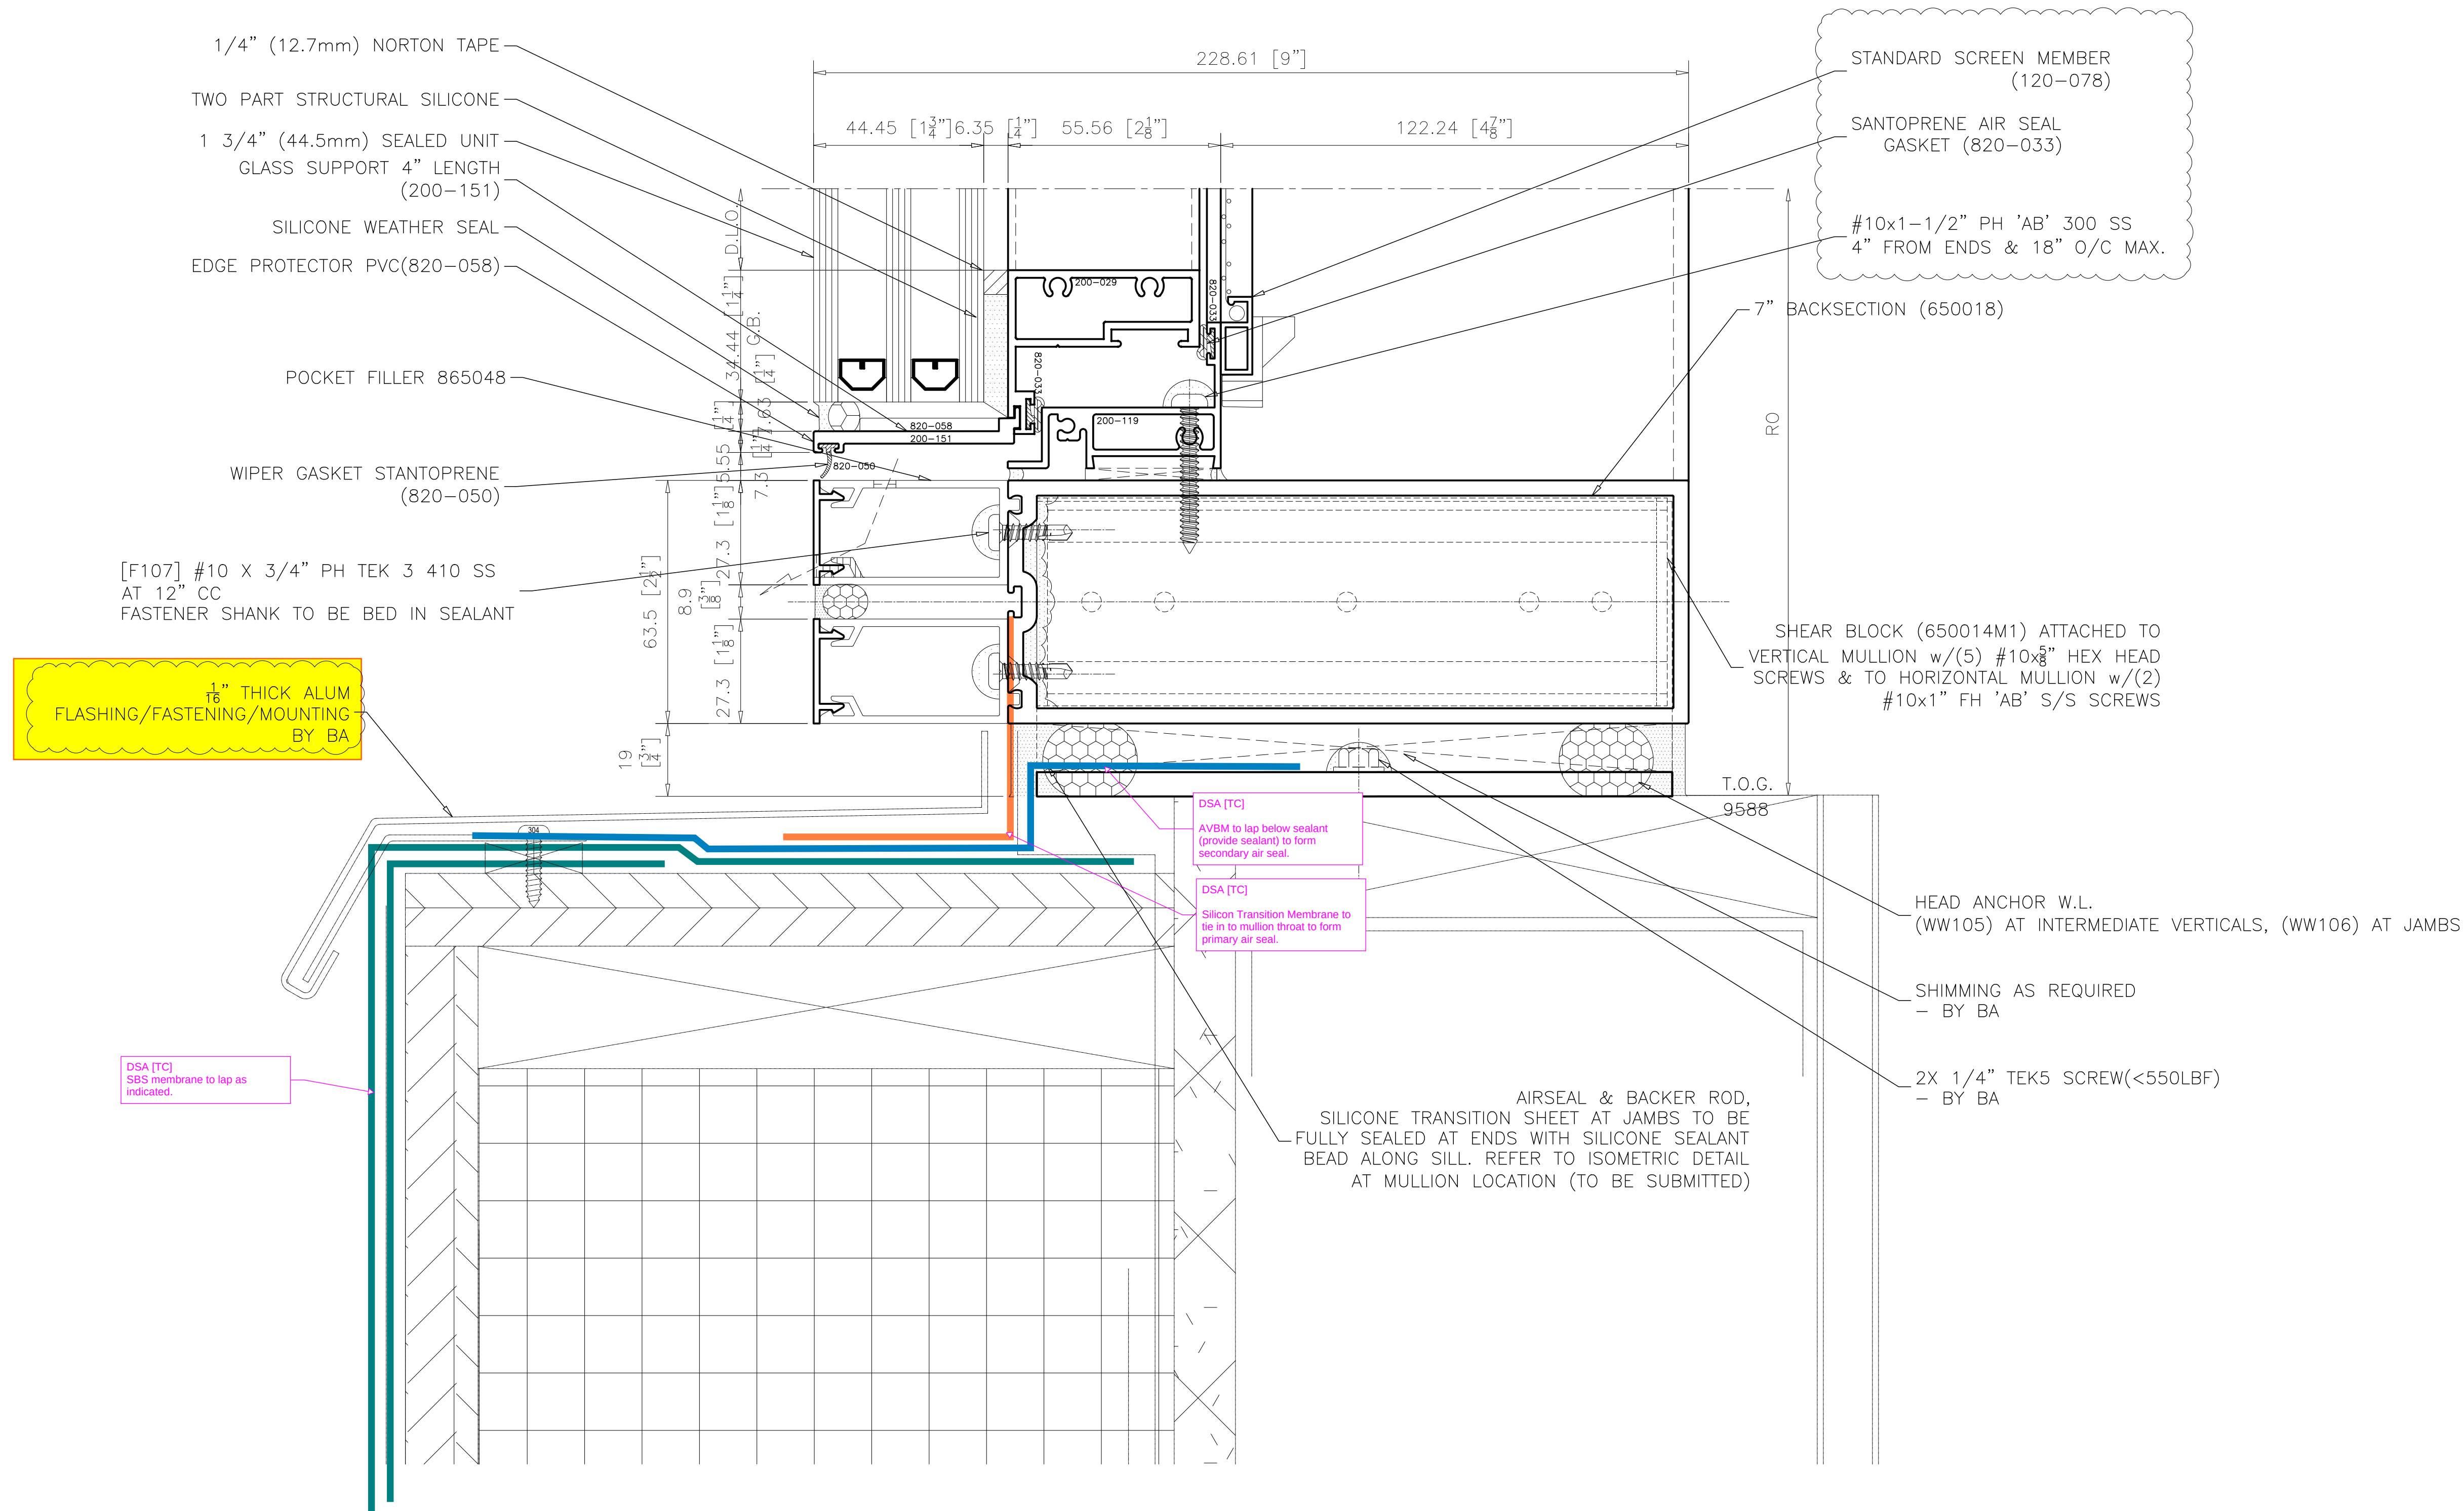


**SILL HORIZONTAL SSG 7" B.S.
AT VENT**
ARCH. REF.: 3/A552

REVISIONS


No.	Description:	Date:	By:
1	Revised per arch. markups received Feb 11/26	03/03/26	SLR

Project Name: DOCKSTEADER PRPS	Project Location: BRAMPTON, ONTARIO	Architect Name: DIAMOND SCHMITT ARCHITECTS	Customer Name: BOTHWELL ACCURATE GLAZING
-----------------------------------	--	---	---

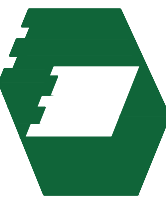**Oldcastle BuildingEnvelope®**

275 Britannia Road East • Mississauga • Ontario • Canada • L4Z2E7
905-890-6970 • oldcastlebe.com

Drawing Name: SECTION DETAIL	
Drawn By: SR	Checked By: NP
Drawn Date: 2026/01/12	Issue No.: 1
Scale: 1"=1"	Release Date: 2026/03/03
Drawing Number: C5-022	

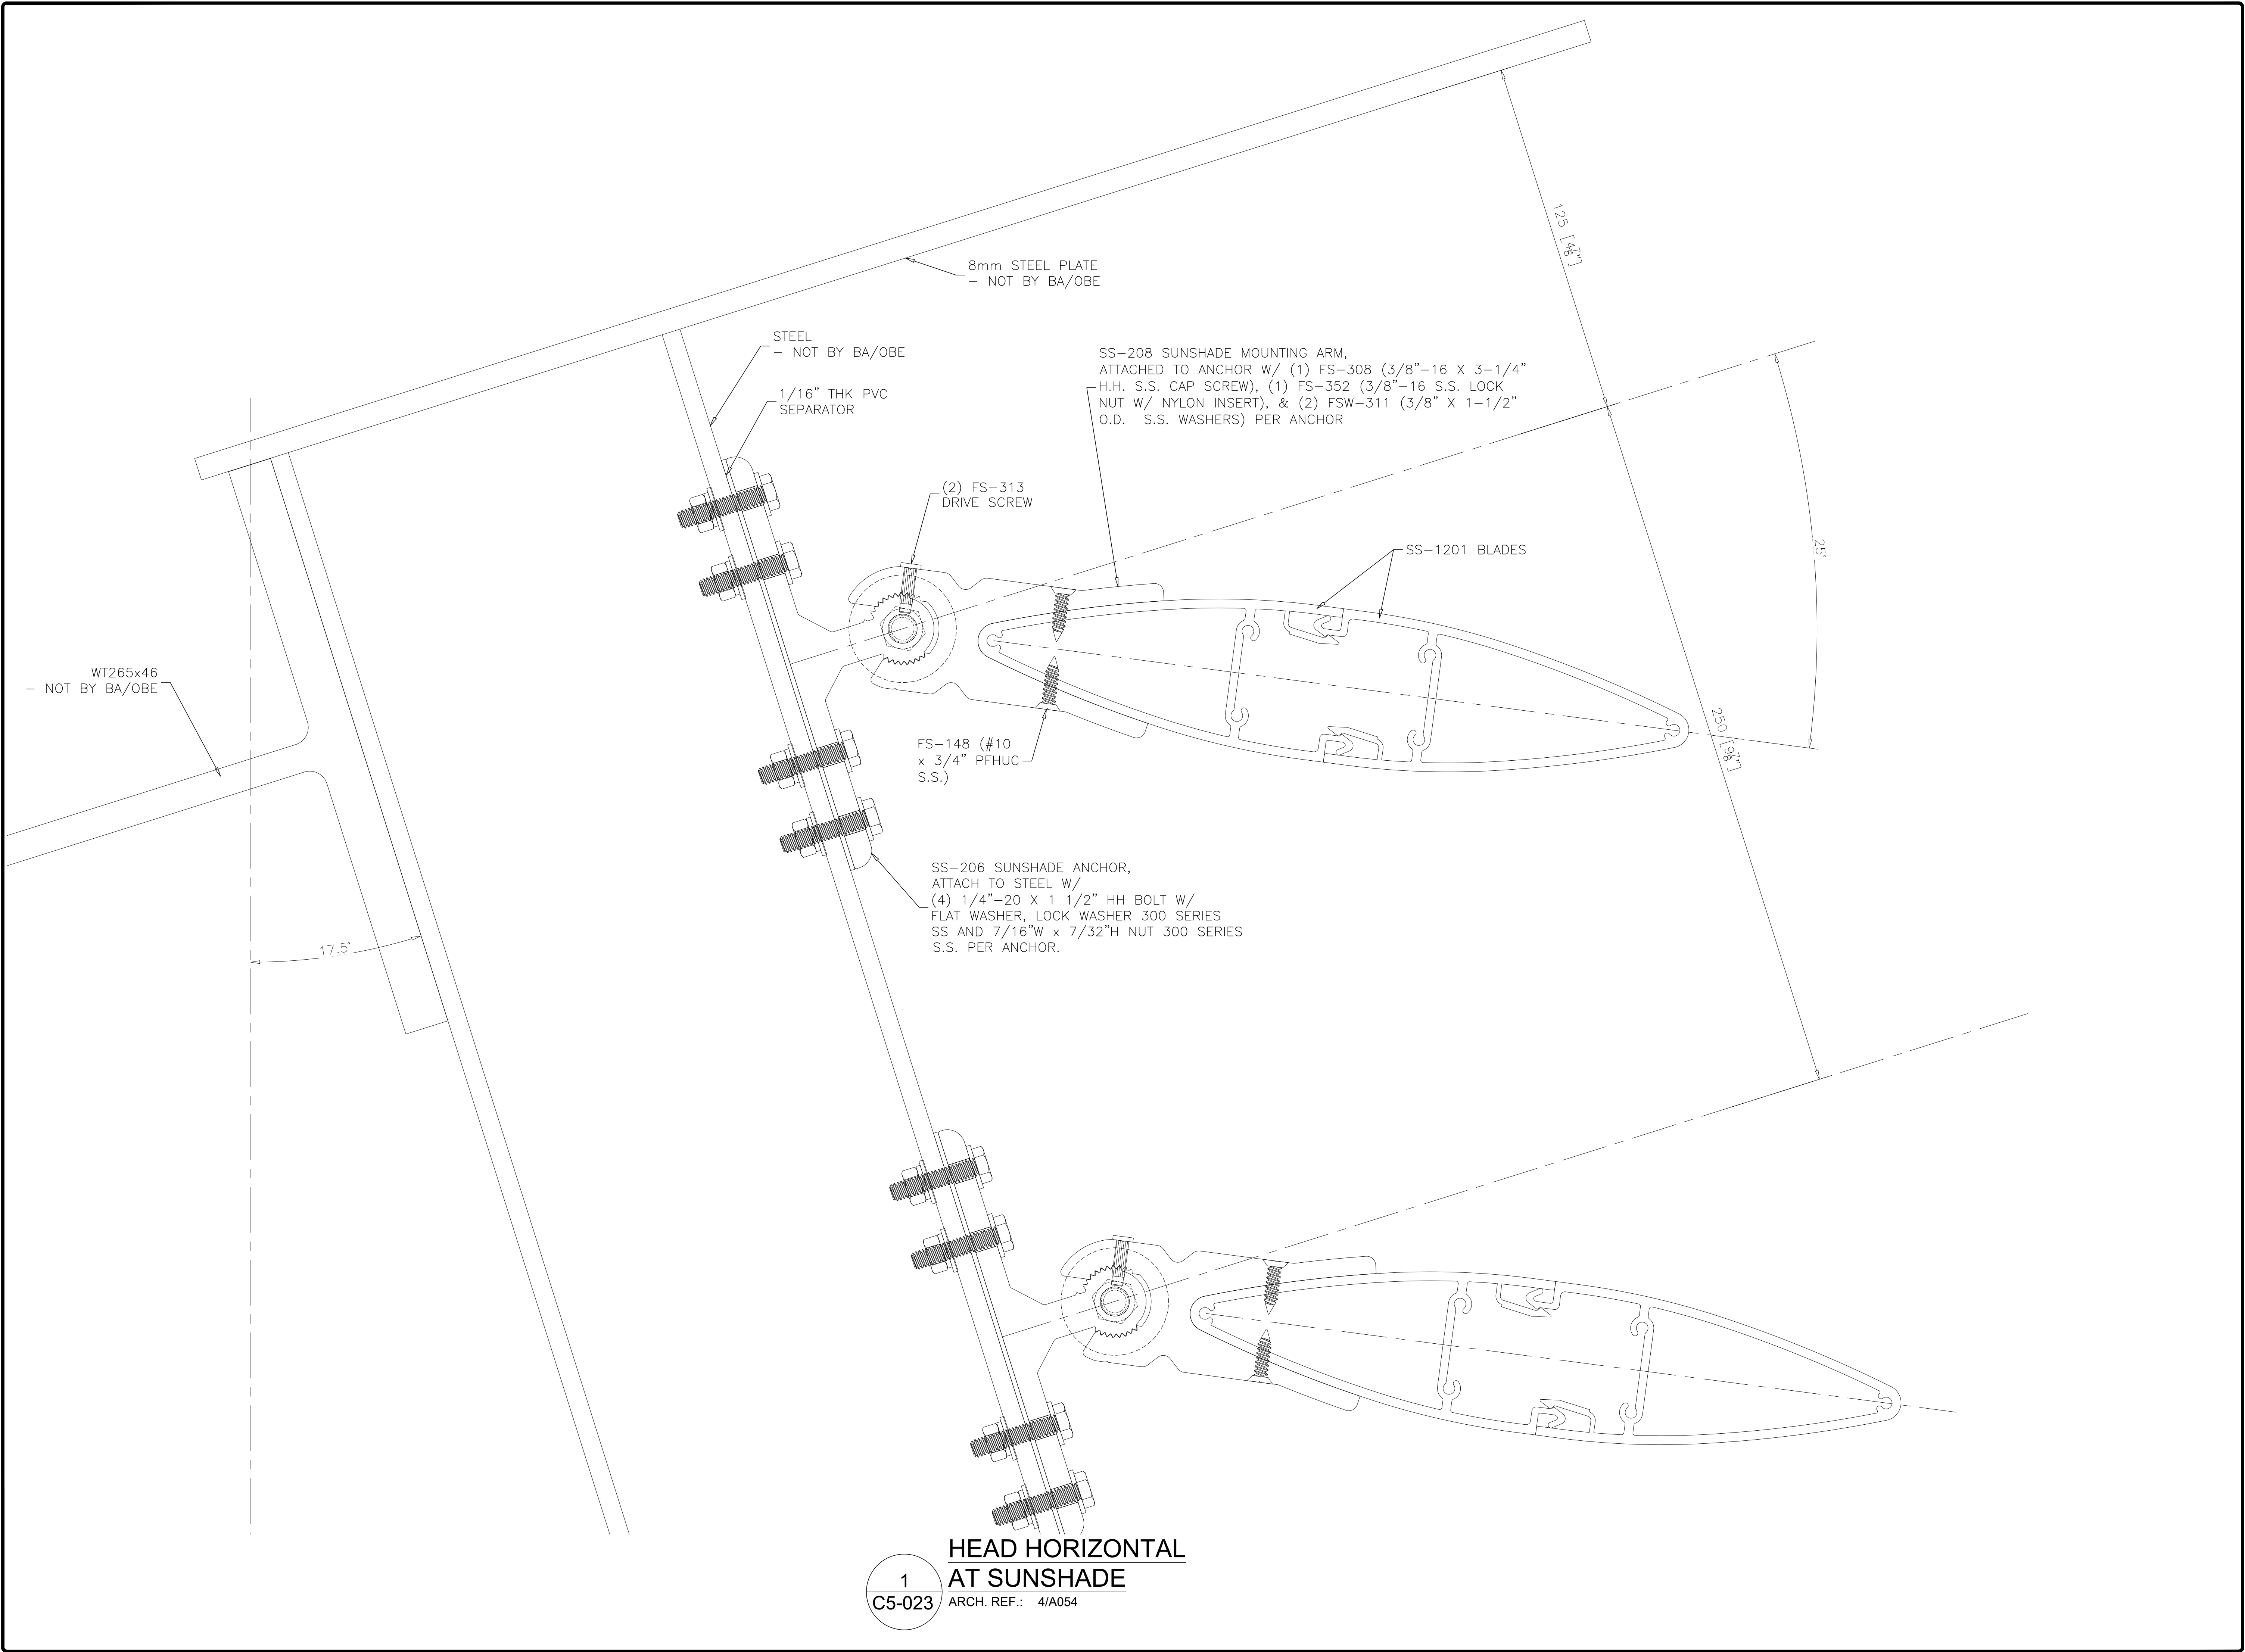

1
C5-023

**HEAD HORIZONTAL
AT SUNSHADE**

ARCH. REF.: 4/A054


REVISIONS			
No.	Description:	Date:	By:
1	Revised per arch. markups received Feb 11/26	03/03/26	SLR

Project Name: DOCKSTEADER PRPS		Project Location: BRAMPTON, ONTARIO	
Architect Name: DIAMOND SCHMITT ARCHITECTS		Customer Name: BOTHWELL ACCURATE GLAZING	



275 Britannia Road East • Mississauga • Ontario • Canada • L4Z2E7
905-890-6970 • oldcastlebe.com

Drawing Name: SECTION DETAIL	
Drawn By: SR	Checked By: NP
Drawn Date: 2026/01/12	Issue No.: 1
Scale: 1"=1"	Release Date: 2026/03/03
Drawing Number: C5-023	

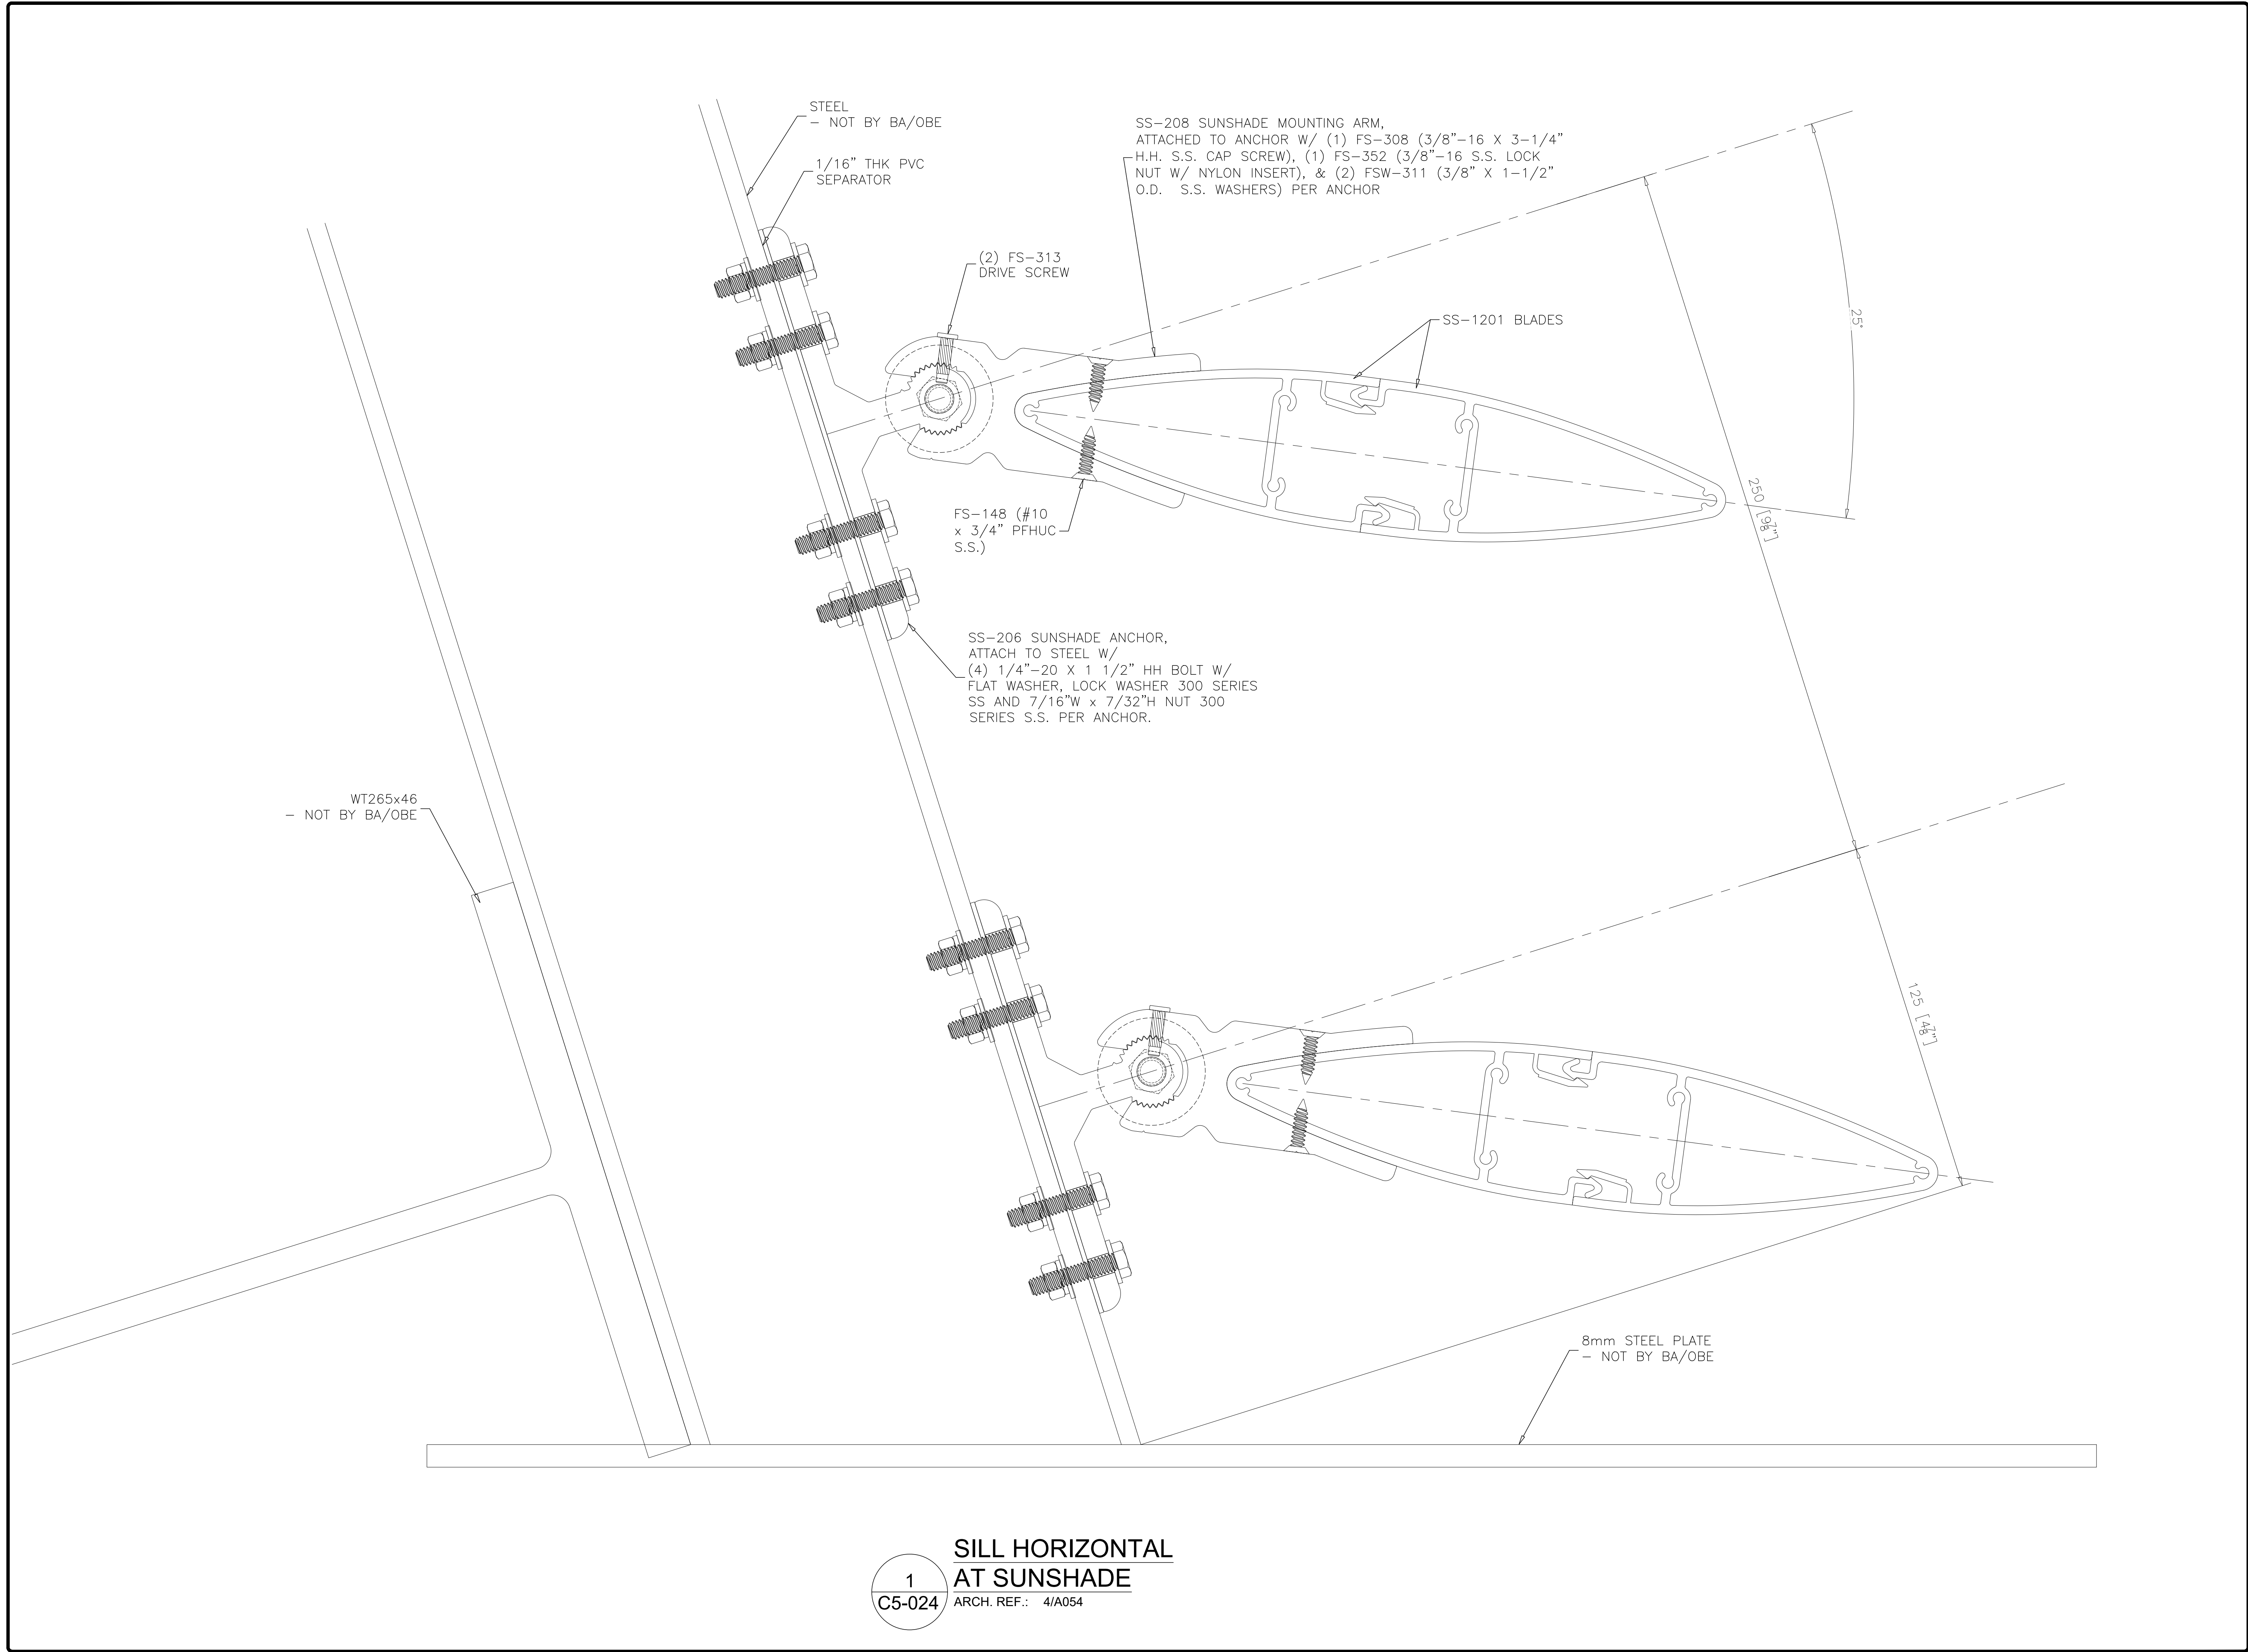


REVISIONS			
No.	Description:	Date:	By:
1	Revised per arch. markups received Feb 11/26	03/03/26	SLR

Project Name: DOCKSTEADER PRPS	Project Location: BRAMPTON, ONTARIO	Architect Name: DIAMOND SCHMITT ARCHITECTS	Customer Name: BOTHWELL ACCURATE GLAZING
-----------------------------------	--	---	---



275 Britannia Road East • Mississauga • Ontario • Canada • L4Z2E7
905-890-6970 • oldcastlebe.com

Drawing Name: SECTION DETAIL	
Drawn By: SR	Checked By: NP
Drawn Date: 2026/01/12	Issue No.: 1
Scale: 1"=1"	Release Date: 2026/03/03
Drawing Number: C5-024	

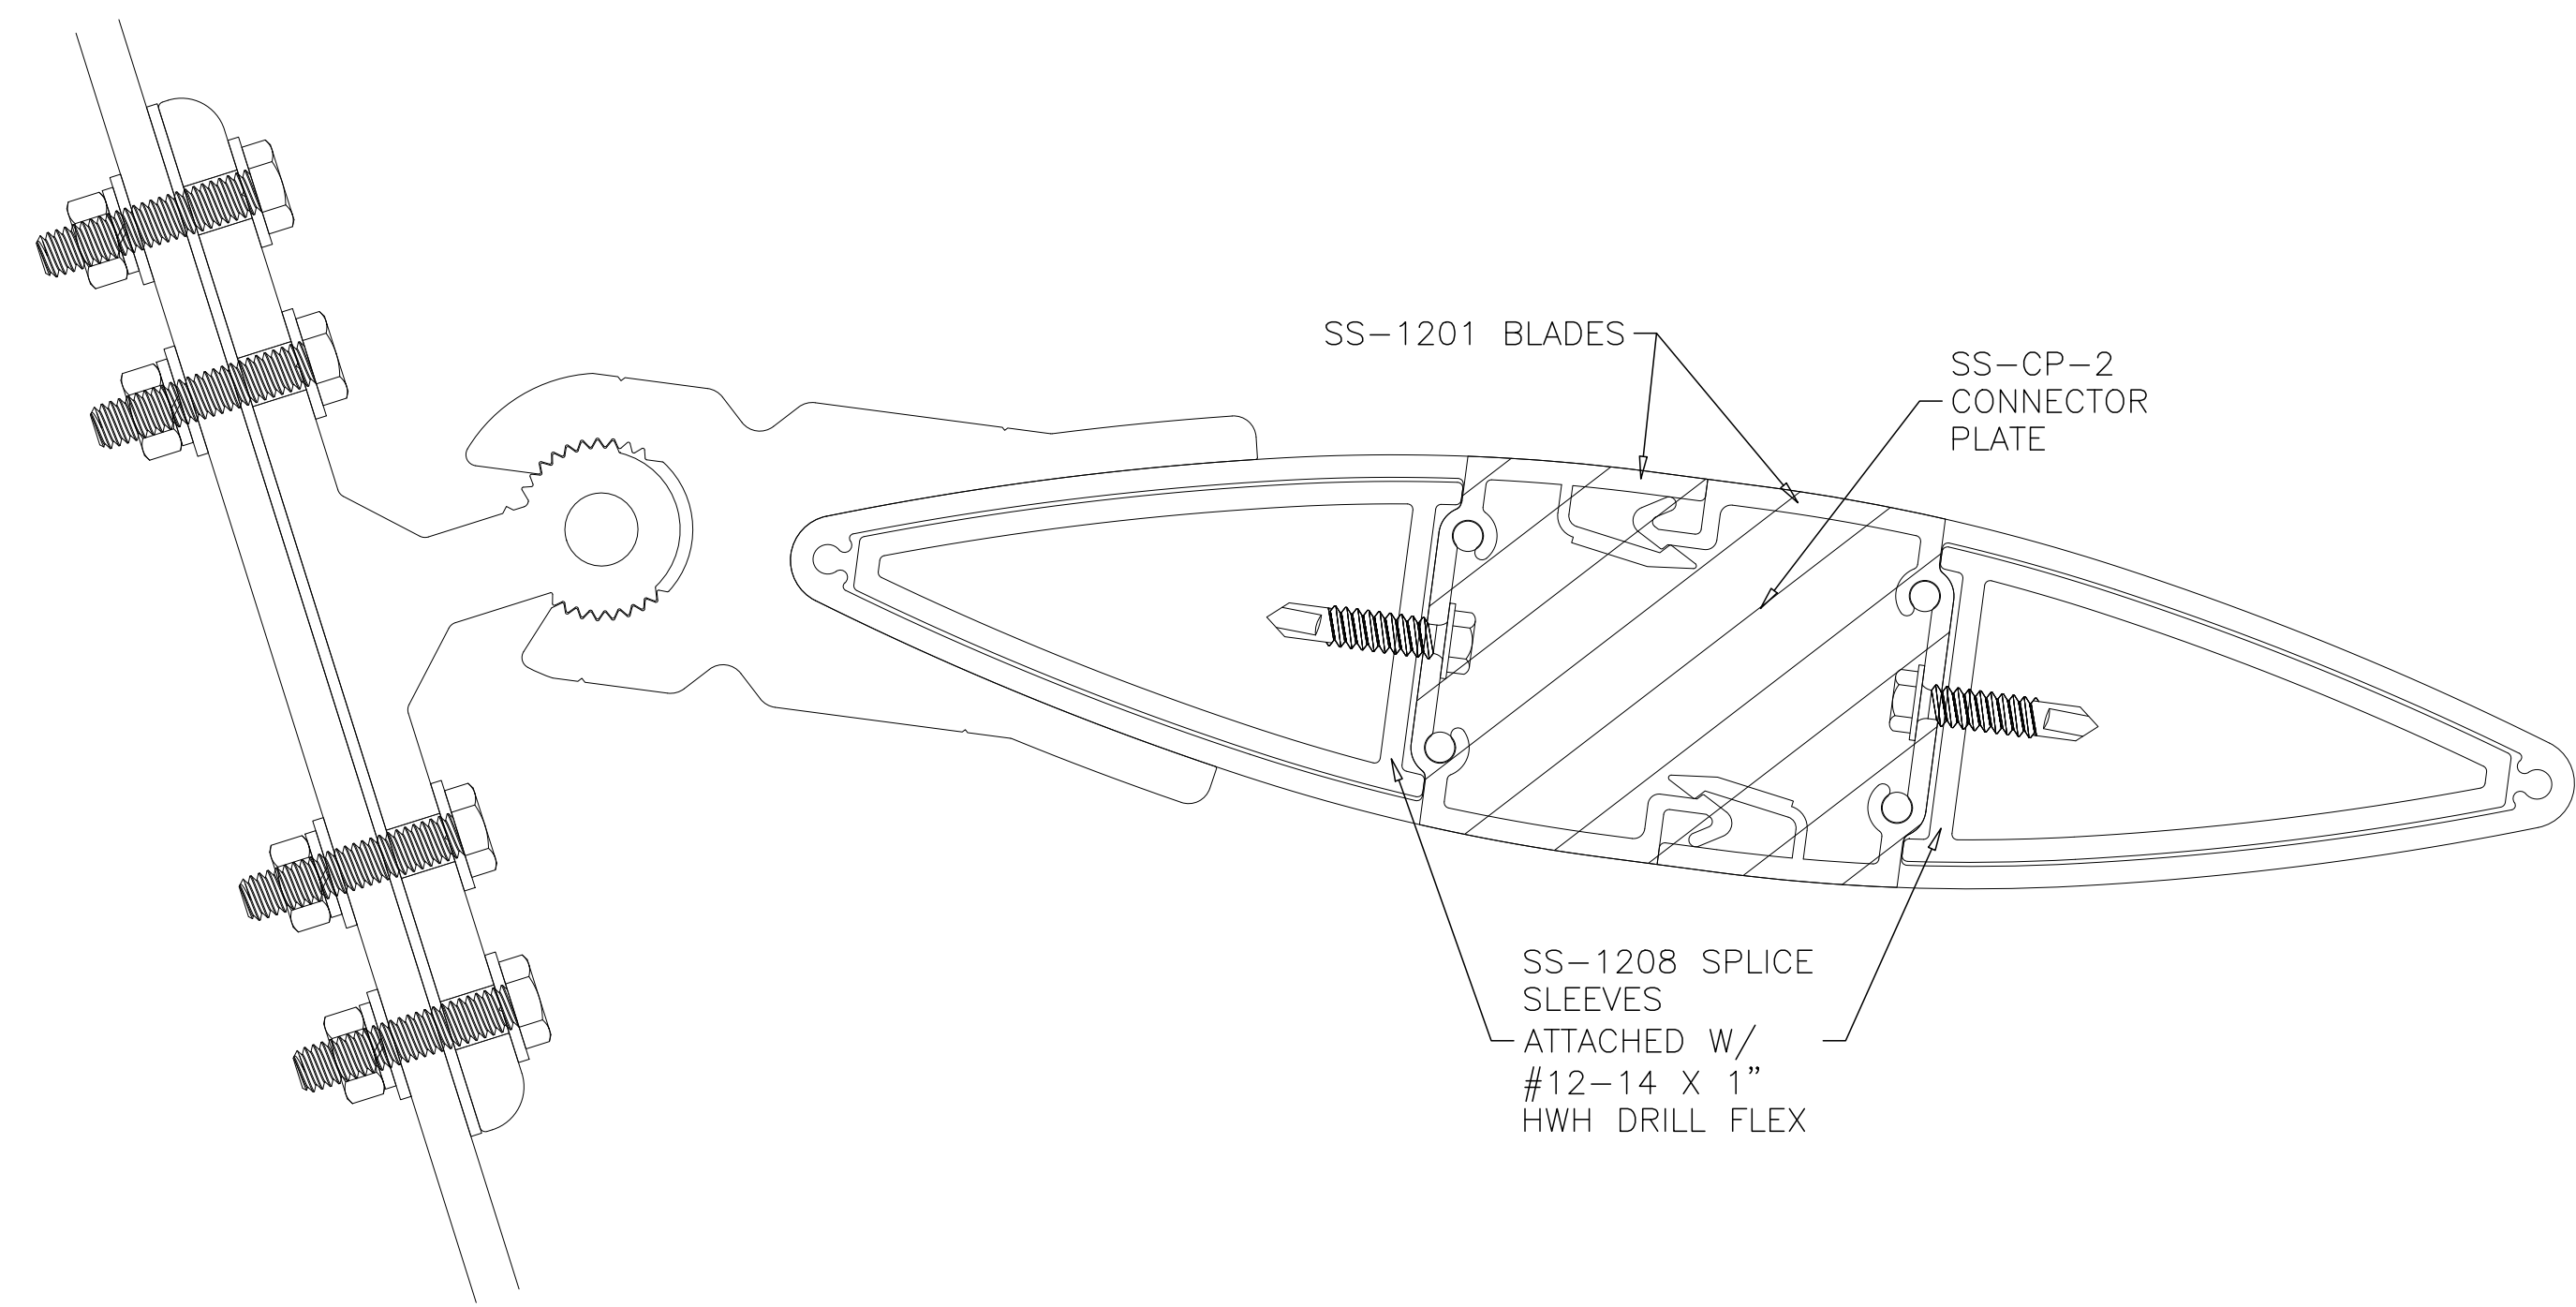

1

C5-025

SUNSHADE HORIZONTAL
AT SPLICE

ARCH. REF.: N/A

REVISIONS			
No.	Description:	Date:	By:
1	Revised per arch. markups received Feb 11/26	03/03/26	SLR

Project Name: DOCKSTEADER PRPS	Project Location: BRAMPTON, ONTARIO	Architect Name: DIAMOND SCHMITT ARCHITECTS	Customer Name: BOTHWELL ACCURATE GLAZING
-----------------------------------	--	---	---



275 Britannia Road East • Mississauga • Ontario • Canada • L4Z2E7
905-890-6970 • oldcastlebe.com

Drawing Name: SECTION DETAIL	
Drawn By: SR	Checked By: NP
Drawn Date: 2026/01/12	Issue No.: 1
Scale: 1"=1"	Release Date: 2026/03/03
Drawing Number: C5-025	